
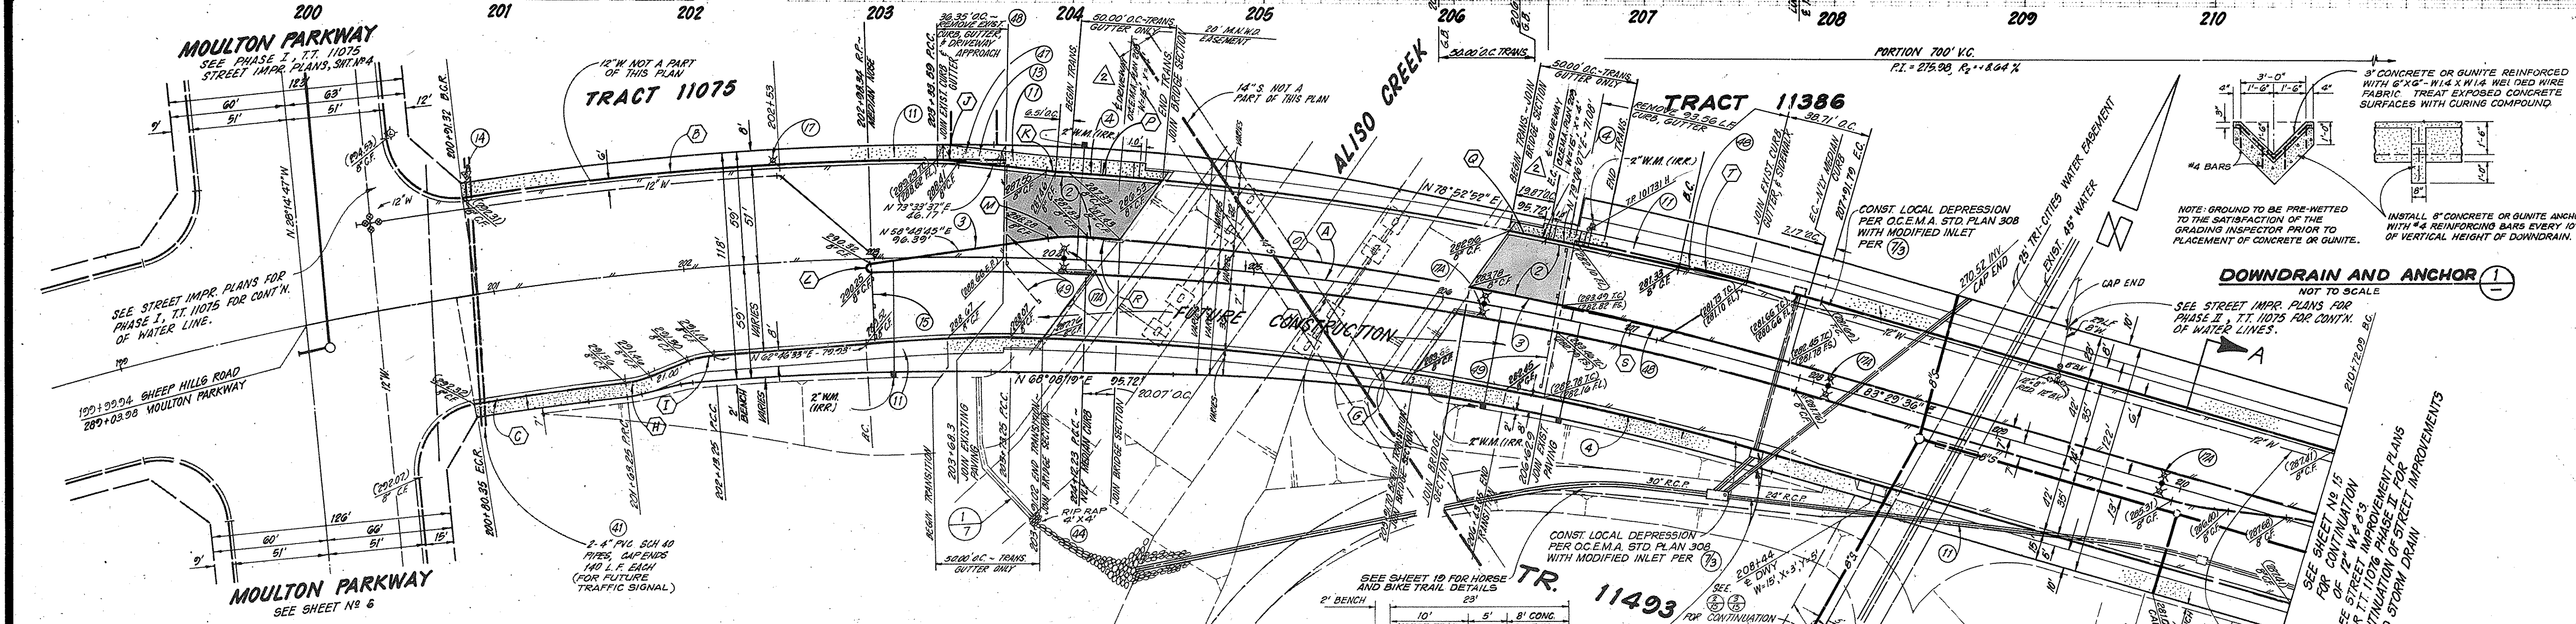


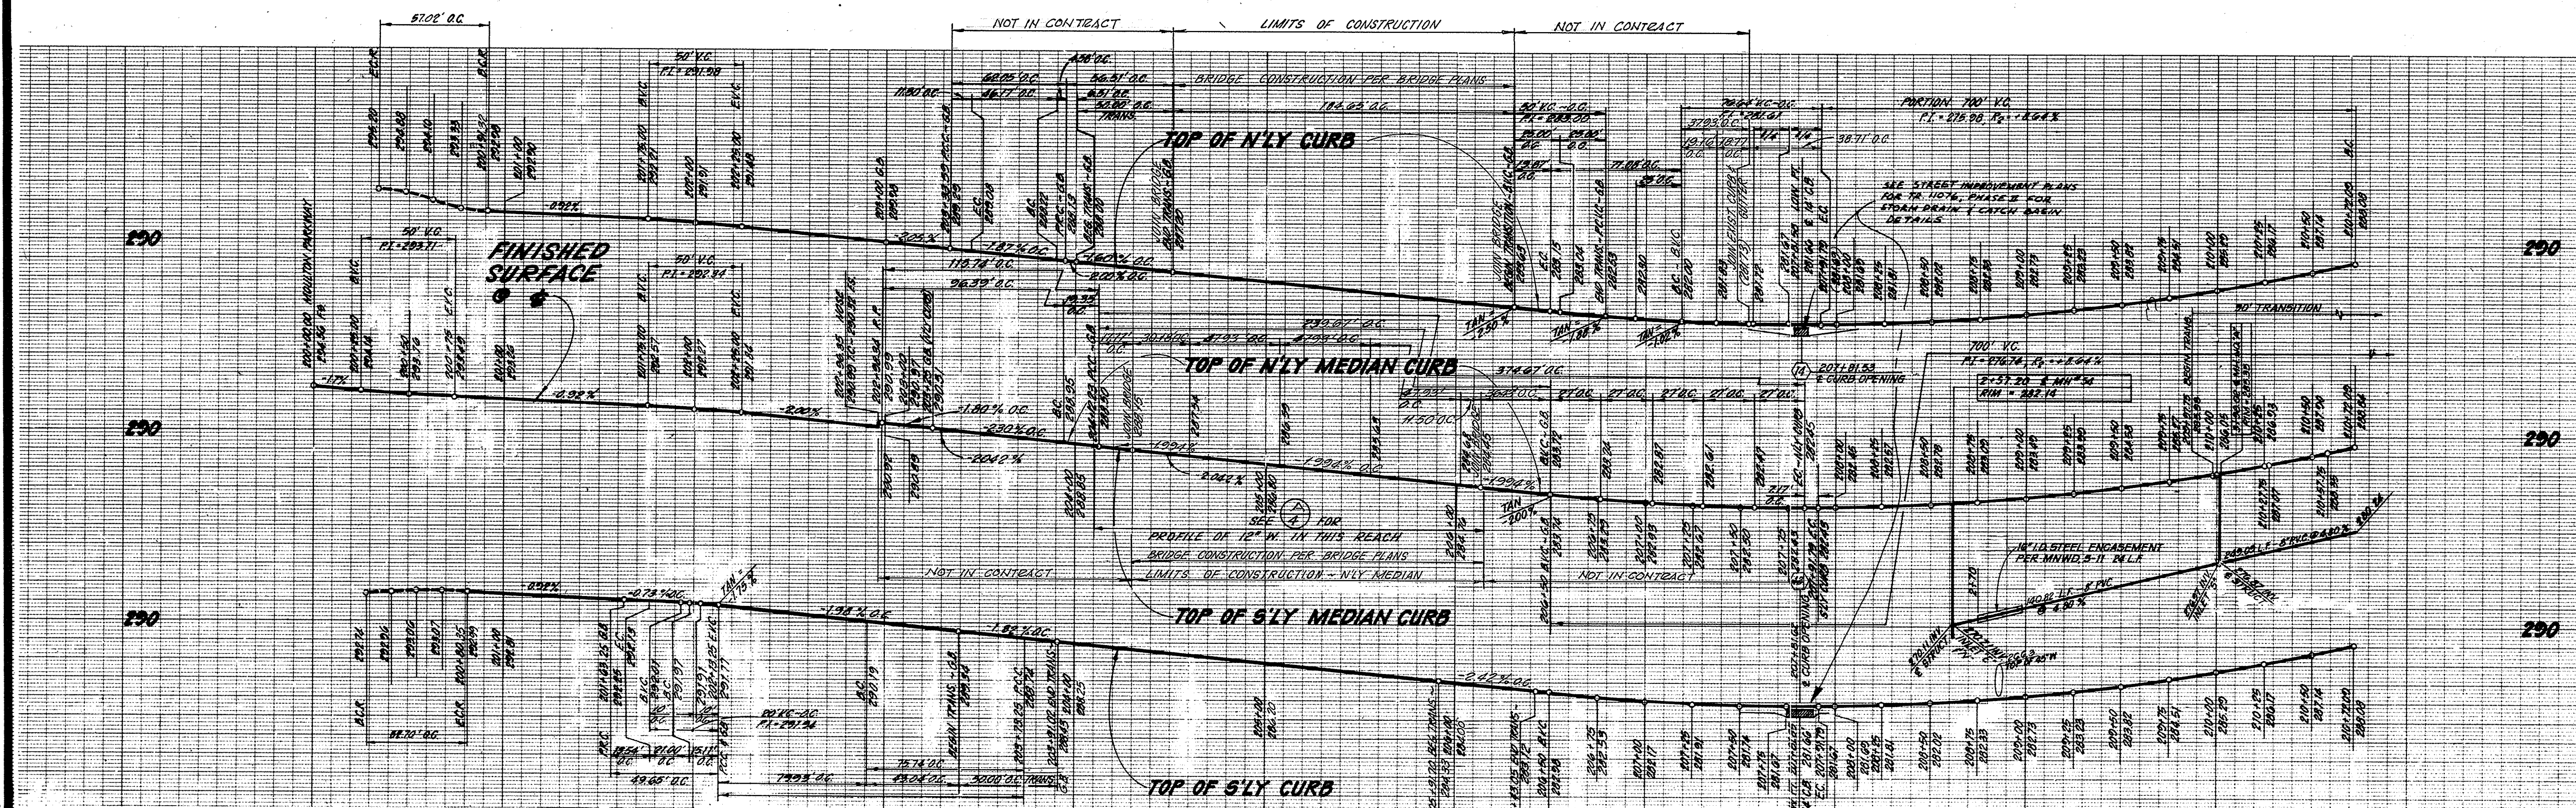

REMOVAL QUANTITIES

ITEM	AMOUNT	UNIT
1. REMOVE EXIST. CONC. DRIVEWAY APPROACH	248	SF
2. REMOVE EXIST. CONC. CURB OR CURB & GUTTER	121	LF
3. REMOVE EXIST. TIMBER BARRICADE	152	LF

CONSTRUCTION NOTES

1. INSTALL STREET LIGHTS PER O.C.E.M.A. STD. PLAN NO. 411, DOUBLE ST. LIGHT.
2. INSTALL STREET LIGHTS PER O.C.E.M.A. STD. PLAN NO. 411, SINGLE ST. LIGHT.
3. CONST. CONC. DRIVEWAY APPROACH PER O.C.E.M.A. STD. PLAN NO. 209.
4. CONST. TIMBER BARRICADE TYPE III PER O.C.E.M.A. STD. PLAN NO. 404.
5. CONST. SIDEWALK PER O.C.E.M.A. STD. PLAN NO. 205.
6. CONST. CURB ONLY TYPE 24" (8" C.F.) PER O.C.E.M.A. STD. PLAN NO. 201.
7. CONST. A.C./A.B. 5C-250 PRIME COAT AND SEAL COAT.

SECTION A-A
NOT TO SCALE

STATION	17+18.39	17+31.13	17+44.00	17+56.84	18+09.68	18+22.52	18+35.36	18+48.20	18+61.04	18+73.88	18+86.72	18+99.56	19+12.40	19+25.24	19+38.08	19+50.92	19+63.76	19+76.60	19+89.44	20+02.28	20+15.12	20+27.96	20+40.80	20+53.64	20+66.48	20+79.32	20+92.16	21+05.00	21+17.84	21+30.68	21+43.52	21+56.36	21+69.20	21+82.04	21+94.88	22+07.72	22+20.56	22+33.40	22+46.24	22+59.08	22+71.92	22+84.76	22+97.60	23+10.44	23+23.28	23+36.12	23+48.96	23+61.80	23+74.64	23+87.48	24+00.32	24+13.16	24+26.00	24+38.84	24+51.68	24+64.52	24+77.36	24+90.20	25+03.04	25+15.88	25+28.72	25+41.56	25+54.40	25+67.24	25+80.08	25+92.92	26+05.76	26+18.60	26+31.44	26+44.28	26+57.12	26+69.96	26+82.80	26+95.64	27+08.48	27+21.32	27+34.16	27+47.00	27+59.84	27+72.68	27+85.52	27+98.36	28+11.20	28+24.04	28+36.88	28+49.72	28+62.56	28+75.40	28+88.24	29+01.08	29+13.92	29+26.76	29+39.60	29+52.44	29+65.28	29+78.12	29+90.96	30+03.80	30+16.64	30+29.48	30+42.32	30+55.16	30+68.00	30+80.84	30+93.68	31+06.52	31+19.36	31+32.20	31+45.04	31+57.88	31+70.72	31+83.56	31+96.40	32+09.24	32+22.08	32+34.92	32+47.76	32+60.60	32+73.44	32+86.28	32+99.12	33+11.96	33+24.80	33+37.64	33+50.48	33+63.32	33+76.16	33+89.00	34+01.84	34+14.68	34+27.52	34+40.36	34+53.20	34+66.04	34+78.88	34+91.72	35+04.56	35+17.40	35+30.24	35+43.08	35+55.92	35+68.76	35+81.60	35+94.44	36+07.28	36+20.12	36+32.96	36+45.80	36+58.64	36+71.48	36+84.32	36+97.16	37+10.00	37+22.84	37+35.68	37+48.52	37+61.36	37+74.20	37+87.04	38+00.00
1	17+18.39	17+31.13	17+44.00	17+56.84	18+09.68	18+22.52	18+35.36	18+48.20	18+61.04	18+73.88	18+86.72	18+99.56	19+12.40	19+25.24	19+38.08	19+50.92	19+63.76	19+76.60	19+89.44	20+02.28	20+15.12	20+27.96	20+40.80	20+53.64	20+66.48	20+79.32	20+92.16	21+05.00	21+17.84	21+30.68	21+43.52	21+56.36	21+69.20	21+82.04	21+94.88	22+07.72	22+20.56	22+33.40	22+46.24	22+59.08	22+71.92	22+84.76	22+97.60	23+10.44	23+23.28	23+36.12	23+48.96	23+61.80	23+74.64	23+87.48	24+00.32	24+13.16	24+26.00	24+38.84	24+51.68	24+64.52	24+77.36	24+90.20	25+03.04	25+15.88	25+28.72	25+41.56	25+54.40	25+67.24	25+80.08	25+92.92	26+05.76	26+18.60	26+31.44	26+44.28	26+57.12	26+69.96	26+82.80	26+95.64	27+08.48	27+21.32	27+34.16	27+47.00	27+59.84	27+72.68	27+85.52	27+98.36	28+11.20	28+24.04	28+36.88	28+49.72	28+62.56	28+75.40	28+88.24	29+01.08	29+13.92	29+26.76	29+39.60	29+52.44	29+65.28	29+78.12	29+90.96	30+03.80	30+16.64	30+29.48	30+42.32	30+55.16	30+68.00	30+80.84	30+93.68	31+06.52	31+19.36	31+32.20	31+45.04	31+57.88	31+70.72	31+83.56	31+96.40	32+09.24	32+22.08	32+34.92	32+47.76	32+60.60	32+73.44	32+86.28	32+99.12	33+11.96	33+24.80	33+37.64	33+50.48	33+63.32	33+76.16	33+89.00	34+01.84	34+14.68	34+27.52	34+40.36	34+53.20	34+66.04	34+78.88	34+91.72	35+04.56	35+17.40	35+30.24	35+43.08	35+55.92	35+68.76	35+81.60	35+94.44	36+07.28	36+20.12	36+32.96	36+45.80	36+58.64	36+71.48	36+84.32	36+97.16	37+10.00	37+22.84	37+35.68	37+48.52	37+61.36	37+74.20	37+87.04	38+00.00

Jack G. Raub Company
Engineering & Planning
P.O. Box 507 - 125 Baker Street - Costa Mesa, California 92626
(714) 761-2800

PLAN AND PROFILE FOR THE IMPROVEMENT OF
SHEEP HILLS ROAD
STA. 200+00.00 TO STA. 210+72.09
SHEEP HILLS ROAD BRIDGE
ACROSS ALISO CREEK

SHEET
2
OF 17
213040

CONSTRUCTION NOTES

1. INSTALL STREET LIGHTS PER O.C.E.M.A. STD. PLAN NO. 411, DOUBLE ST. LIGHT.
2. INSTALL STREET LIGHTS PER O.C.E.M.A. STD. PLAN NO. 411, SINGLE ST. LIGHT.
3. CONST. CONC. DRIVEWAY APPROACH PER O.C.E.M.A. STD. PLAN NO. 209.
4. CONST. TIMBER BARRICADE TYPE III PER O.C.E.M.A. STD. PLAN NO. 404.
5. CONST. SIDEWALK PER O.C.E.M.A. STD. PLAN NO. 205.
6. CONST. CURB ONLY TYPE 24" (8" C.F.) PER O.C.E.M.A. STD. PLAN NO. 201.
7. CONST. A.C./A.B. 5C-250 PRIME COAT AND SEAL COAT.

REVISIONS

NO.	DATE	BY	REVISION DESCRIPTION
1	11/18/84	JGR	"AS-BUILT"
2	11/18/84	JGR	COUNTY PLAN CHECK CORRECTION
3	11/18/84	JGR	FINAL COUNTY PLAN CHECK CORRECTION

PROFILES

NO.	DATE	BY	REVISION DESCRIPTION
1	11/18/84	JGR	"AS-BUILT"
2	11/18/84	JGR	COUNTY PLAN CHECK CORRECTION
3	11/18/84	JGR	FINAL COUNTY PLAN CHECK CORRECTION

DR. 5 (13985)