


**MOULTON PARKWAY**  
SEE PHASE I  
T.T. 11075 ST. IMP. PLANS

FUTURE SHEEP HILLS ROAD

**DETAIL "A"**  
RAISED MEDIAN MARKING

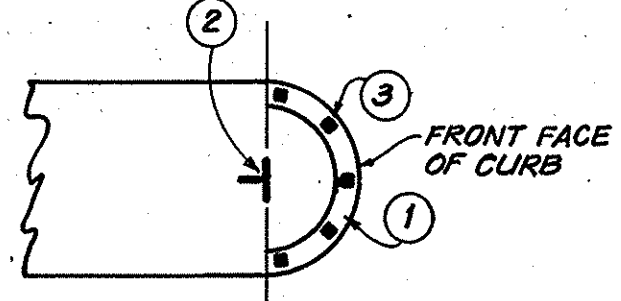

**NOTES: DETAIL "A"**

1. PAINT MEDIAN NOSE WITH WHITE "SCOTCHLITE" BRAND REFLECTIVE LIQUID, CODE 7216 OR EQUAL.
2. INSTALL FLEXIBLE VERTICAL TYPE "K" MARKER, R7 R10 OR TYPE "N" IN TELESAR POST AS INDICATED ON PLAN.
3. INSTALL YELLOW REFLECTIVE MARKING ON FRONT FACE OF MEDIAN CURB NOSE - 5 STRIPS (4"x6") OR 3M #5871 HIGH INTENSITY GRADE SCOTCH LITE HIGH TACK ADHESIVE OR EQUAL.

**SIGNING & STRIPING NOTES**

- 22 - TRAFFIC WARNING SIGNS
- 23 - TRAFFIC REGULATORY SIGNS
- 24 - STENCIL CONTROL INFORMATION
- 25 - 12" SOLID WHITE STRIPE
- 26 - 8" SOLID WHITE STRIPE
- 27 - 4" SOLID WHITE STRIPE
- 28 - 4" SOLID YELLOW STRIPE
- 29 - 4" DASHED YELLOW CENTERLINE STRIPE PER DETAIL
- 30 - 4" SOLID DOUBLE YELLOW STRIPE
- 31 - 60' PARABOLIC MEDIAN FLARE PER O.C.E.M.A. STD. PLAN NO. 116
- 32 - 90' MEDIAN TRANSITION PER O.C.E.M.A. STD. PLAN NO. 115
- 33 - LEFT TURN IN ONLY MEDIAN TRANSITION PER O.C.E.M.A. STD. PLAN NO. 118
- 34 - PAINT RED CURB
- 35 - 6" SOLID WHITE STRIPE
- 36 - INSTALL TIMBER BARRICADE, TYPE III PER O.C.E.M.A. STD. PLAN NO. 404, W/TYPE N-2.

**4" DASHED YELLOW CENTERLINE STRIPE**  
NOT TO SCALE

**SHEEP HILLS ROAD**

**NOTE: SHEEP HILLS ROAD WILL BE STRIPED WHEN CONSTRUCTION OF BRIDGE AT ALISO CREEK IS COMPLETED**

**SHEEP HILLS ROAD SIGNING & STRIPING PLAN**  
(NOT IN CONTRACT)

**Jack G. Raub Company**  
Engineering & Planning  
P.O. Box 5090 • 125 Baker Street • Costa Mesa, California 92626  
(714) 751-2500

| DATE     | BY     | REVISION DESCRIPTION               | APPD | DATE | CRD |
|----------|--------|------------------------------------|------|------|-----|
| 11/15/85 | M.D.C. | "AS-BUILT"                         |      |      |     |
| 11/16/85 | M.D.C. | FINAL COUNTY PLAN CHECK CORRECTION |      |      |     |
|          |        |                                    |      |      |     |
|          |        |                                    |      |      |     |

|                                            |  |                         |
|--------------------------------------------|--|-------------------------|
| <b>TRAFFIC STRIPING AND SIGNING PLAN</b>   |  | <b>SHEET 3</b><br>OF 17 |
| SHEEP HILLS ROAD BRIDGE ACROSS ALISO CREEK |  | 213040                  |