

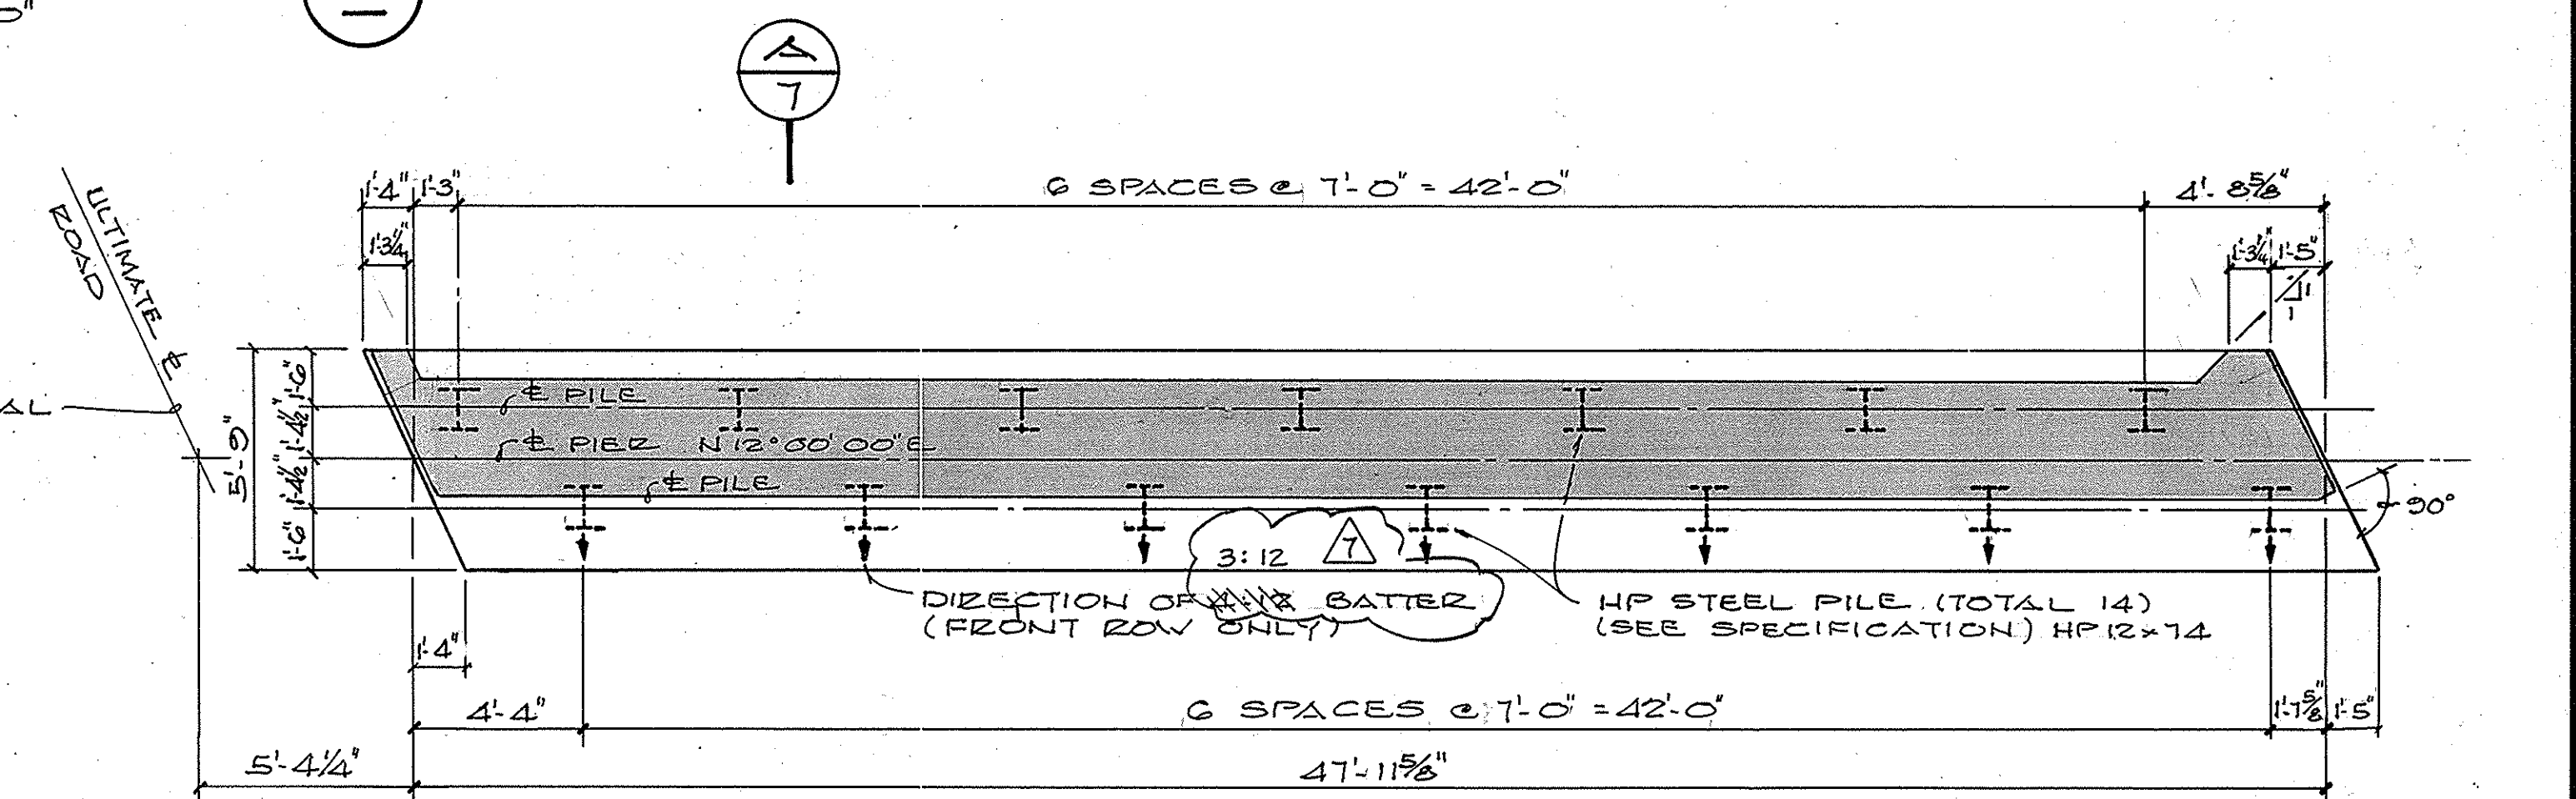
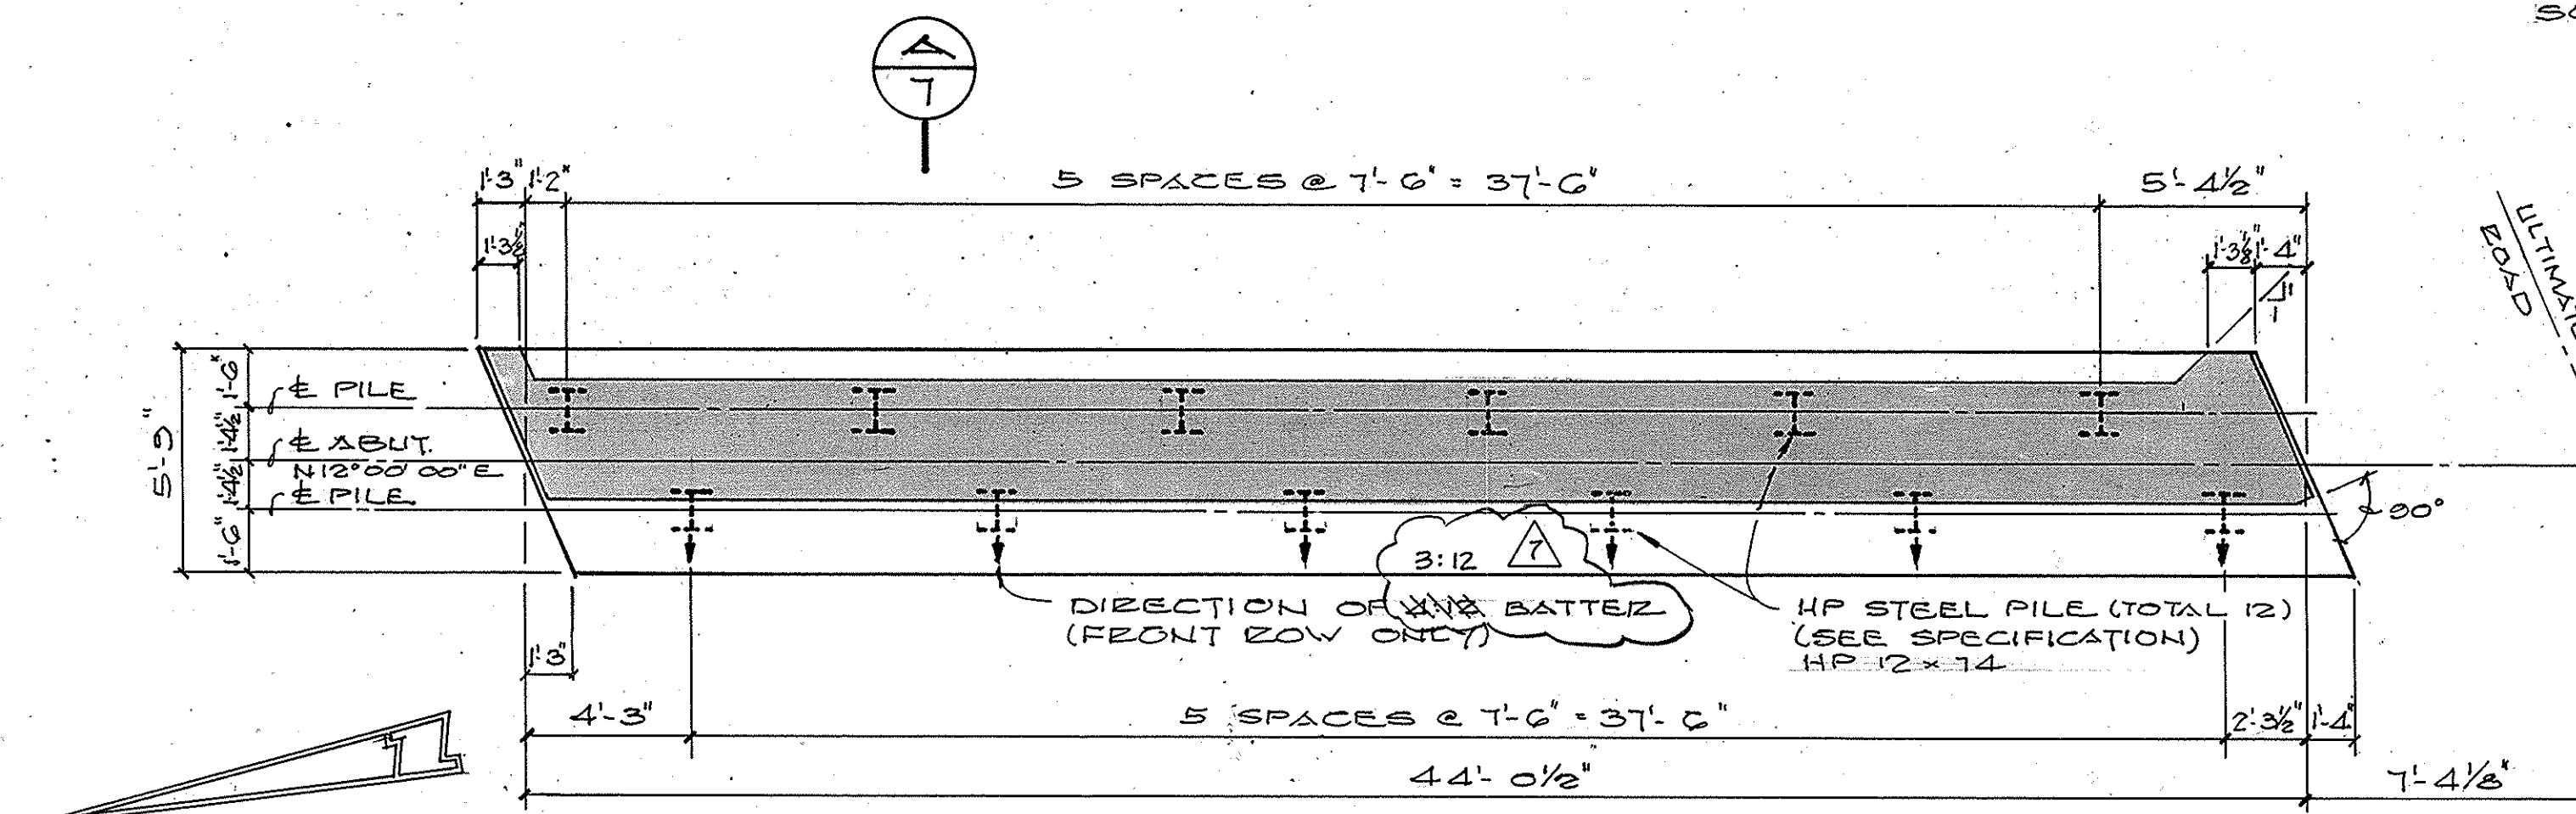
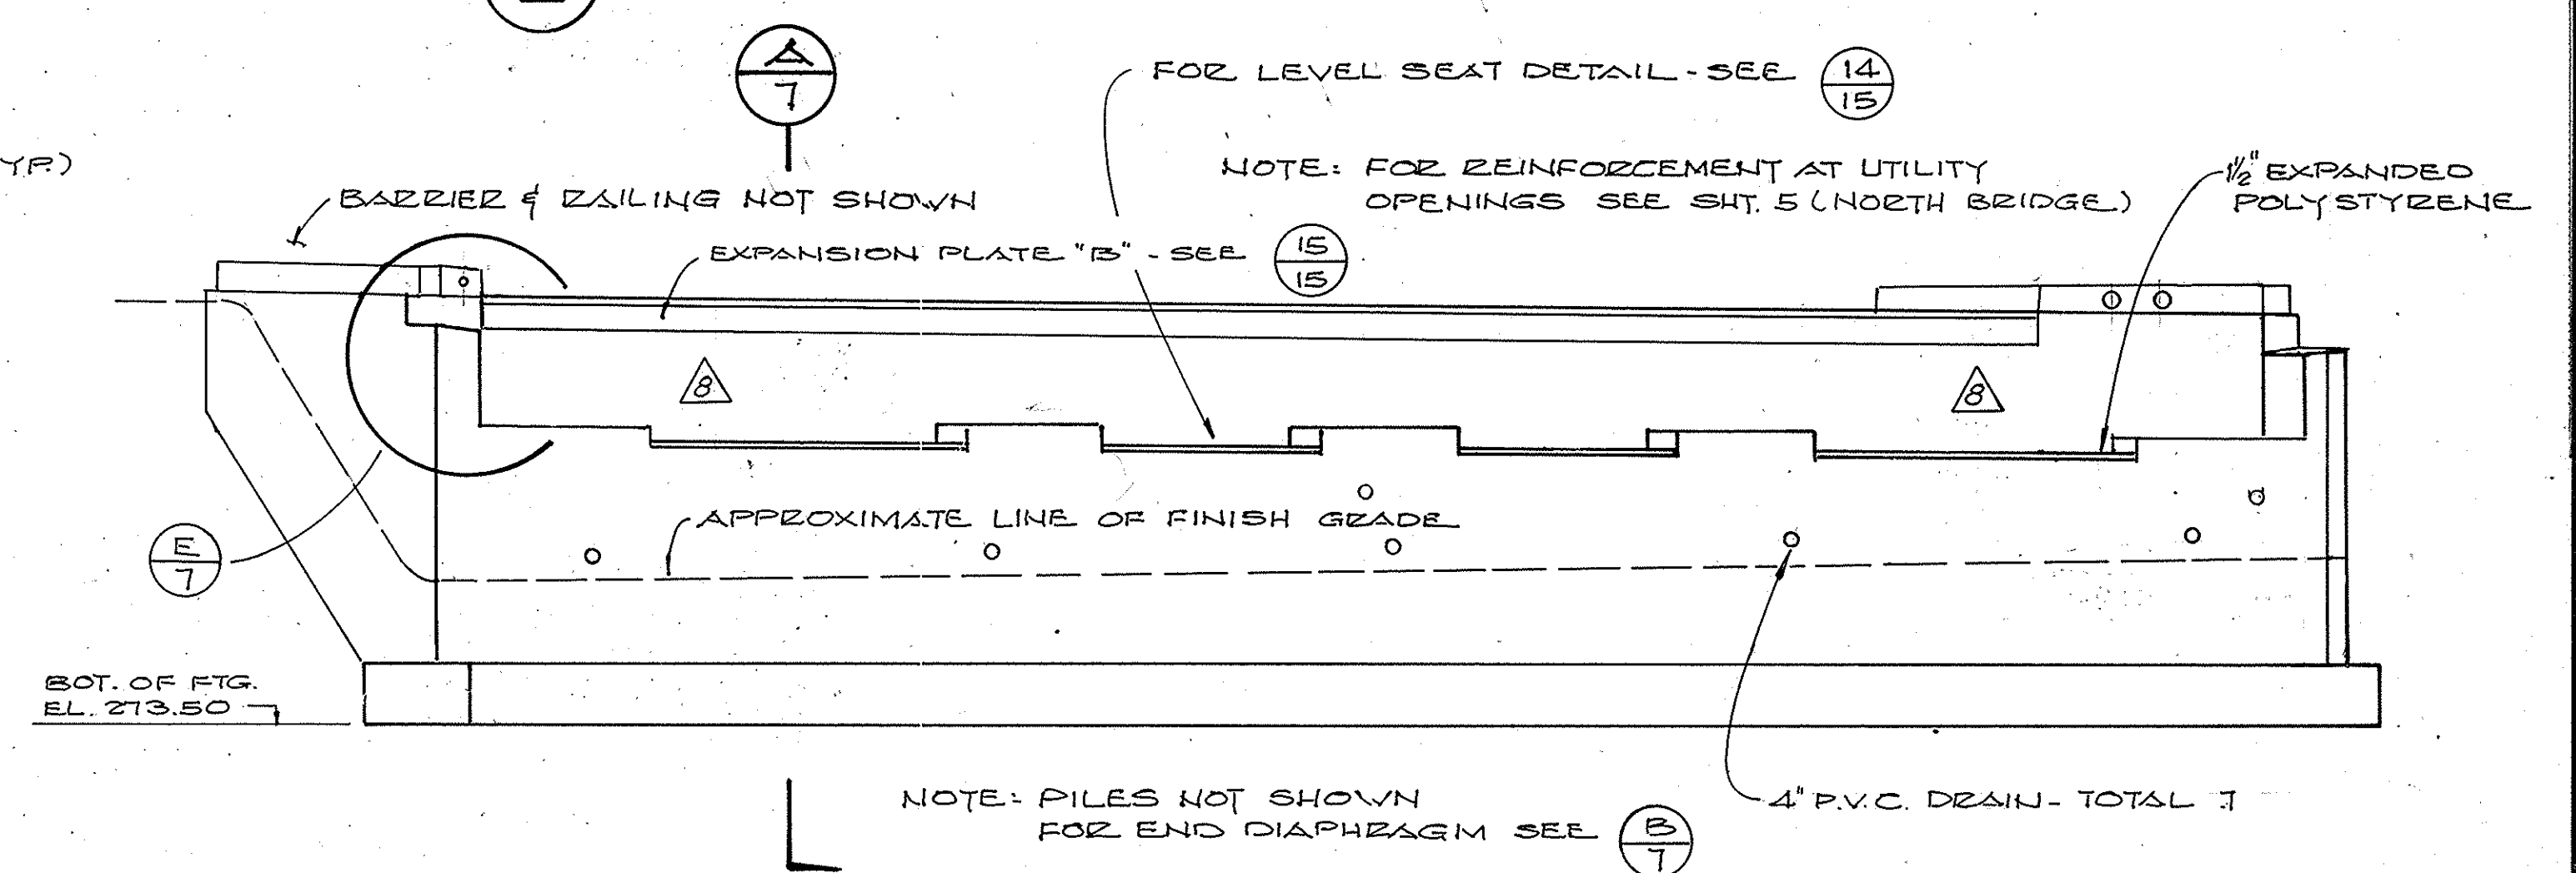


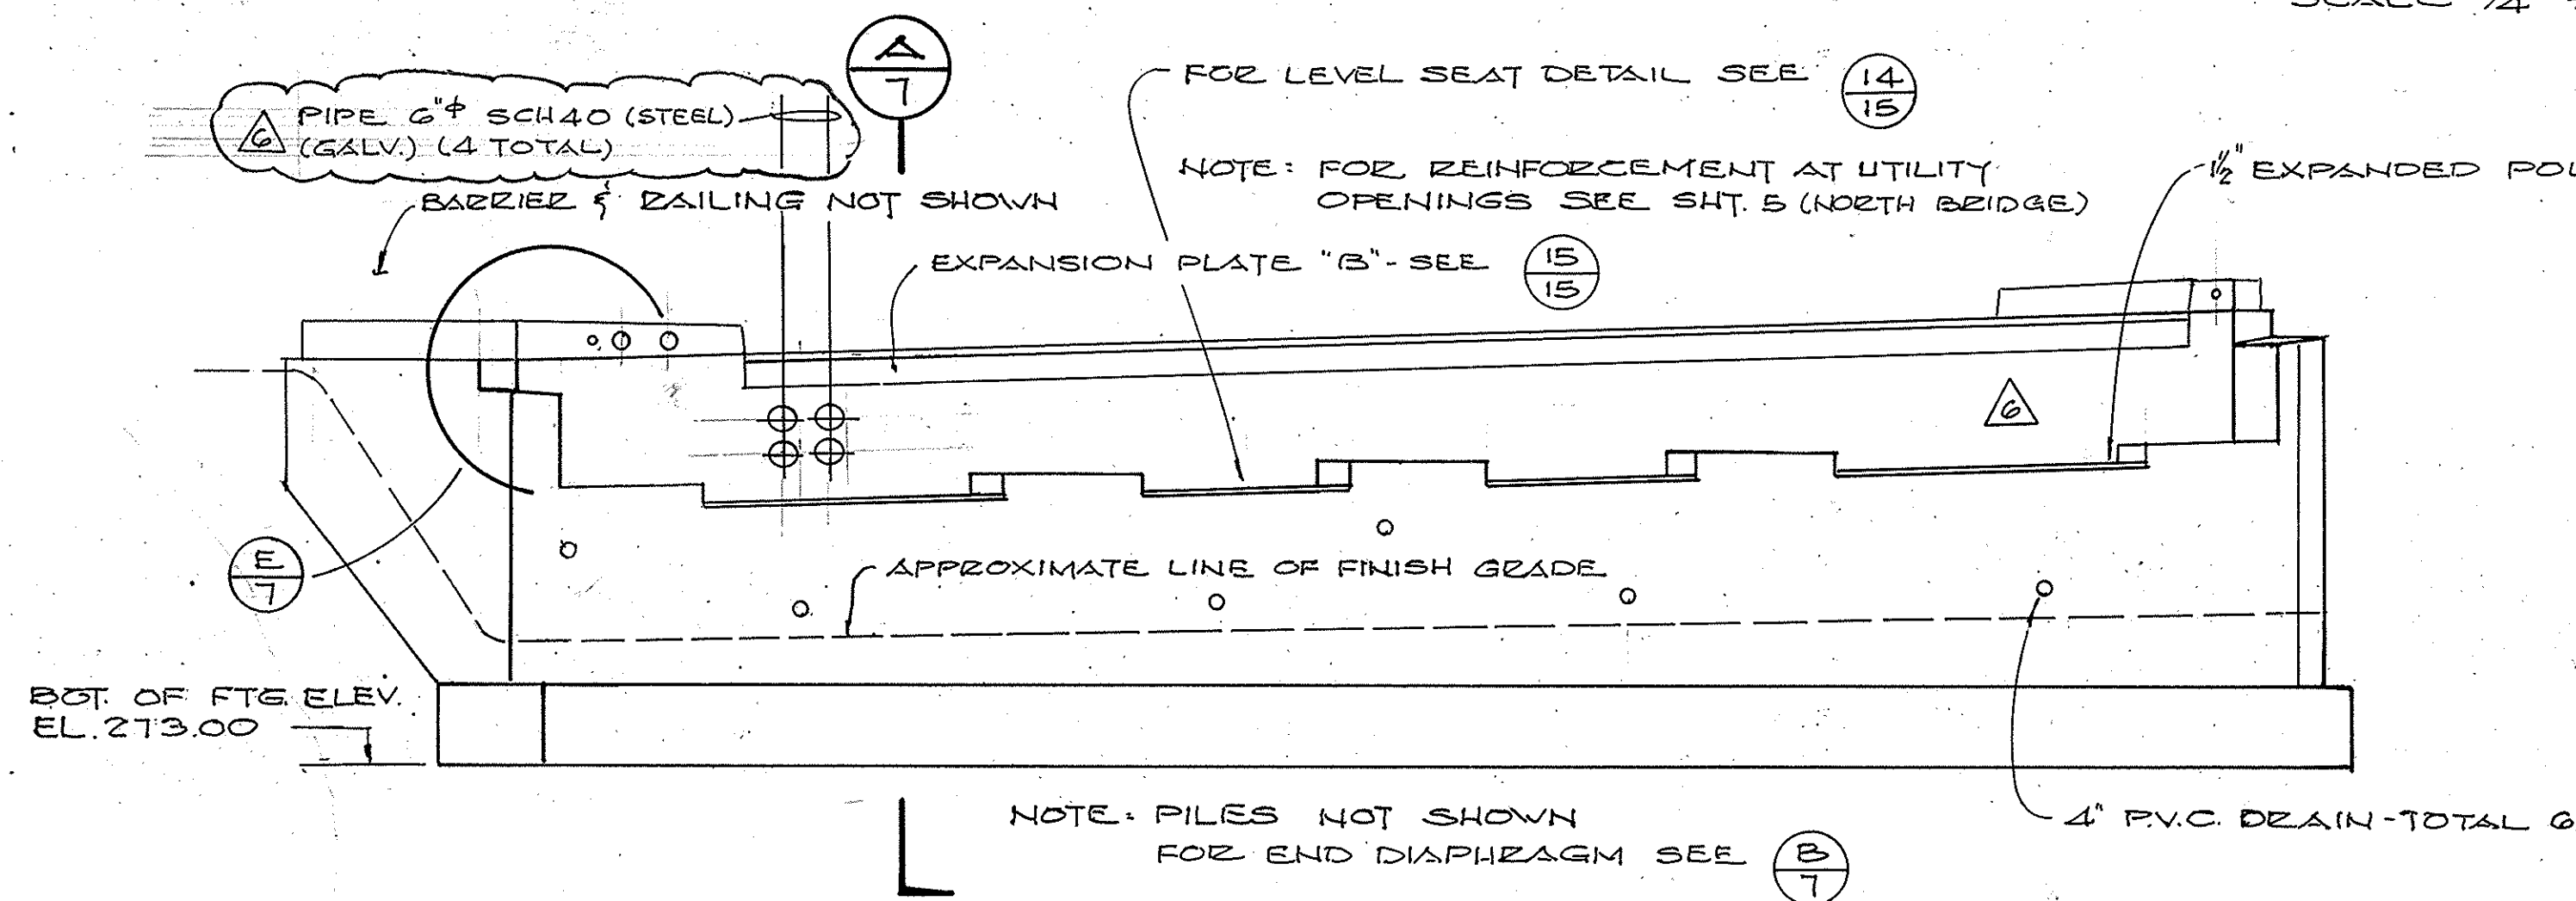

BEARING SEAT ELEVATIONS
ABUTMENT 4

NORTH BRIDGE		SOUTH BRIDGE	
G1 = EL. 280.11	G1 = EL. 280.08	G2 = EL. 279.99	G2 = EL. 280.11
G3 = EL. 279.82	G3 = EL. 280.17	G4 = EL. 279.64	G4 = EL. 280.22
G5 = EL. 279.47	G5 = EL. 280.28	G6 = EL. 279.35	G6 = EL. 280.31

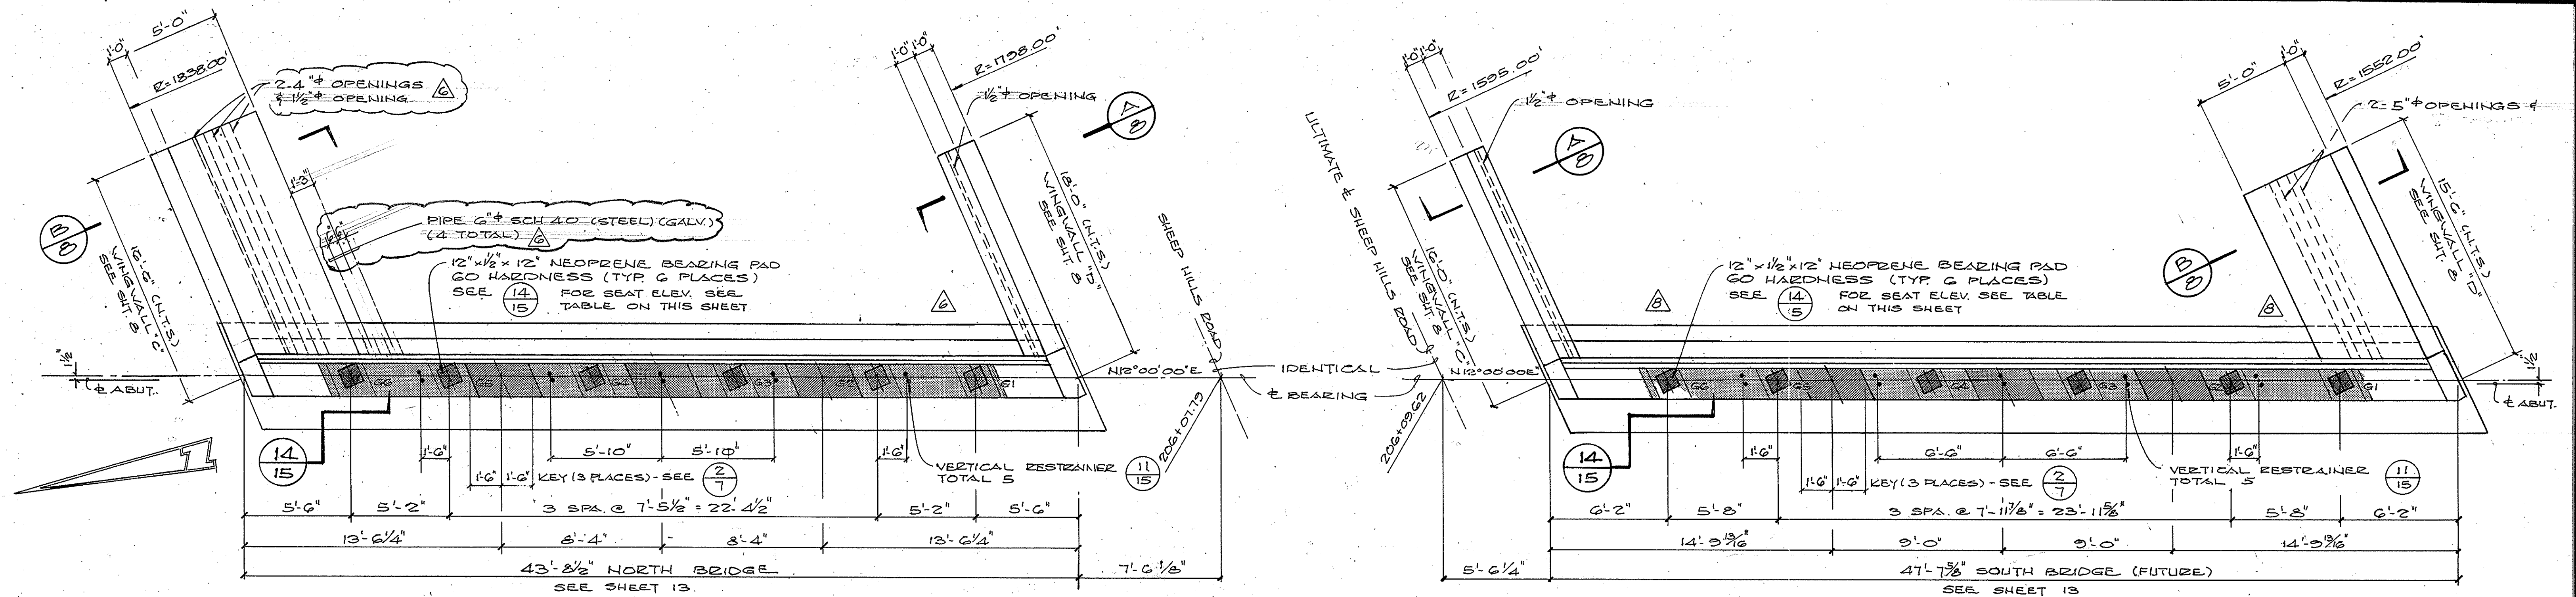

Jack G. Raub Company

Engineering & Planning
2401 Chocoma Drive - Mission Viejo, California 92691-7140-4948

DATE	BY	REVISION DESCRIPTION	APPD	DATE	CHKD	DATE
11/1/83	M.D.C.	DELETED UTILITY OPENINGS - SOUTH BRIDGE				
11/1/83	M.D.C.	"AS-BUILT"				
11/1/84	M.D.C.	DELETED 16" PIPE SLEEVES ADDED 4" SLEEVES - NORTH BRIDGE				
11/1/84	M.D.C.	COUNTY PLAN CHECK CORRECTION				

PLAN SCALE

DES J.K. DWN T.U.
CHKD M.D.C. DATE 2/4/84

ABUTMENT 4
PLAN & ELEVATION

SHEEP HILLS ROAD BRIDGE
ACROSS ALISO CREEK

SHEET

6

OF 17

JN 213040

DR. 5 (13985)