




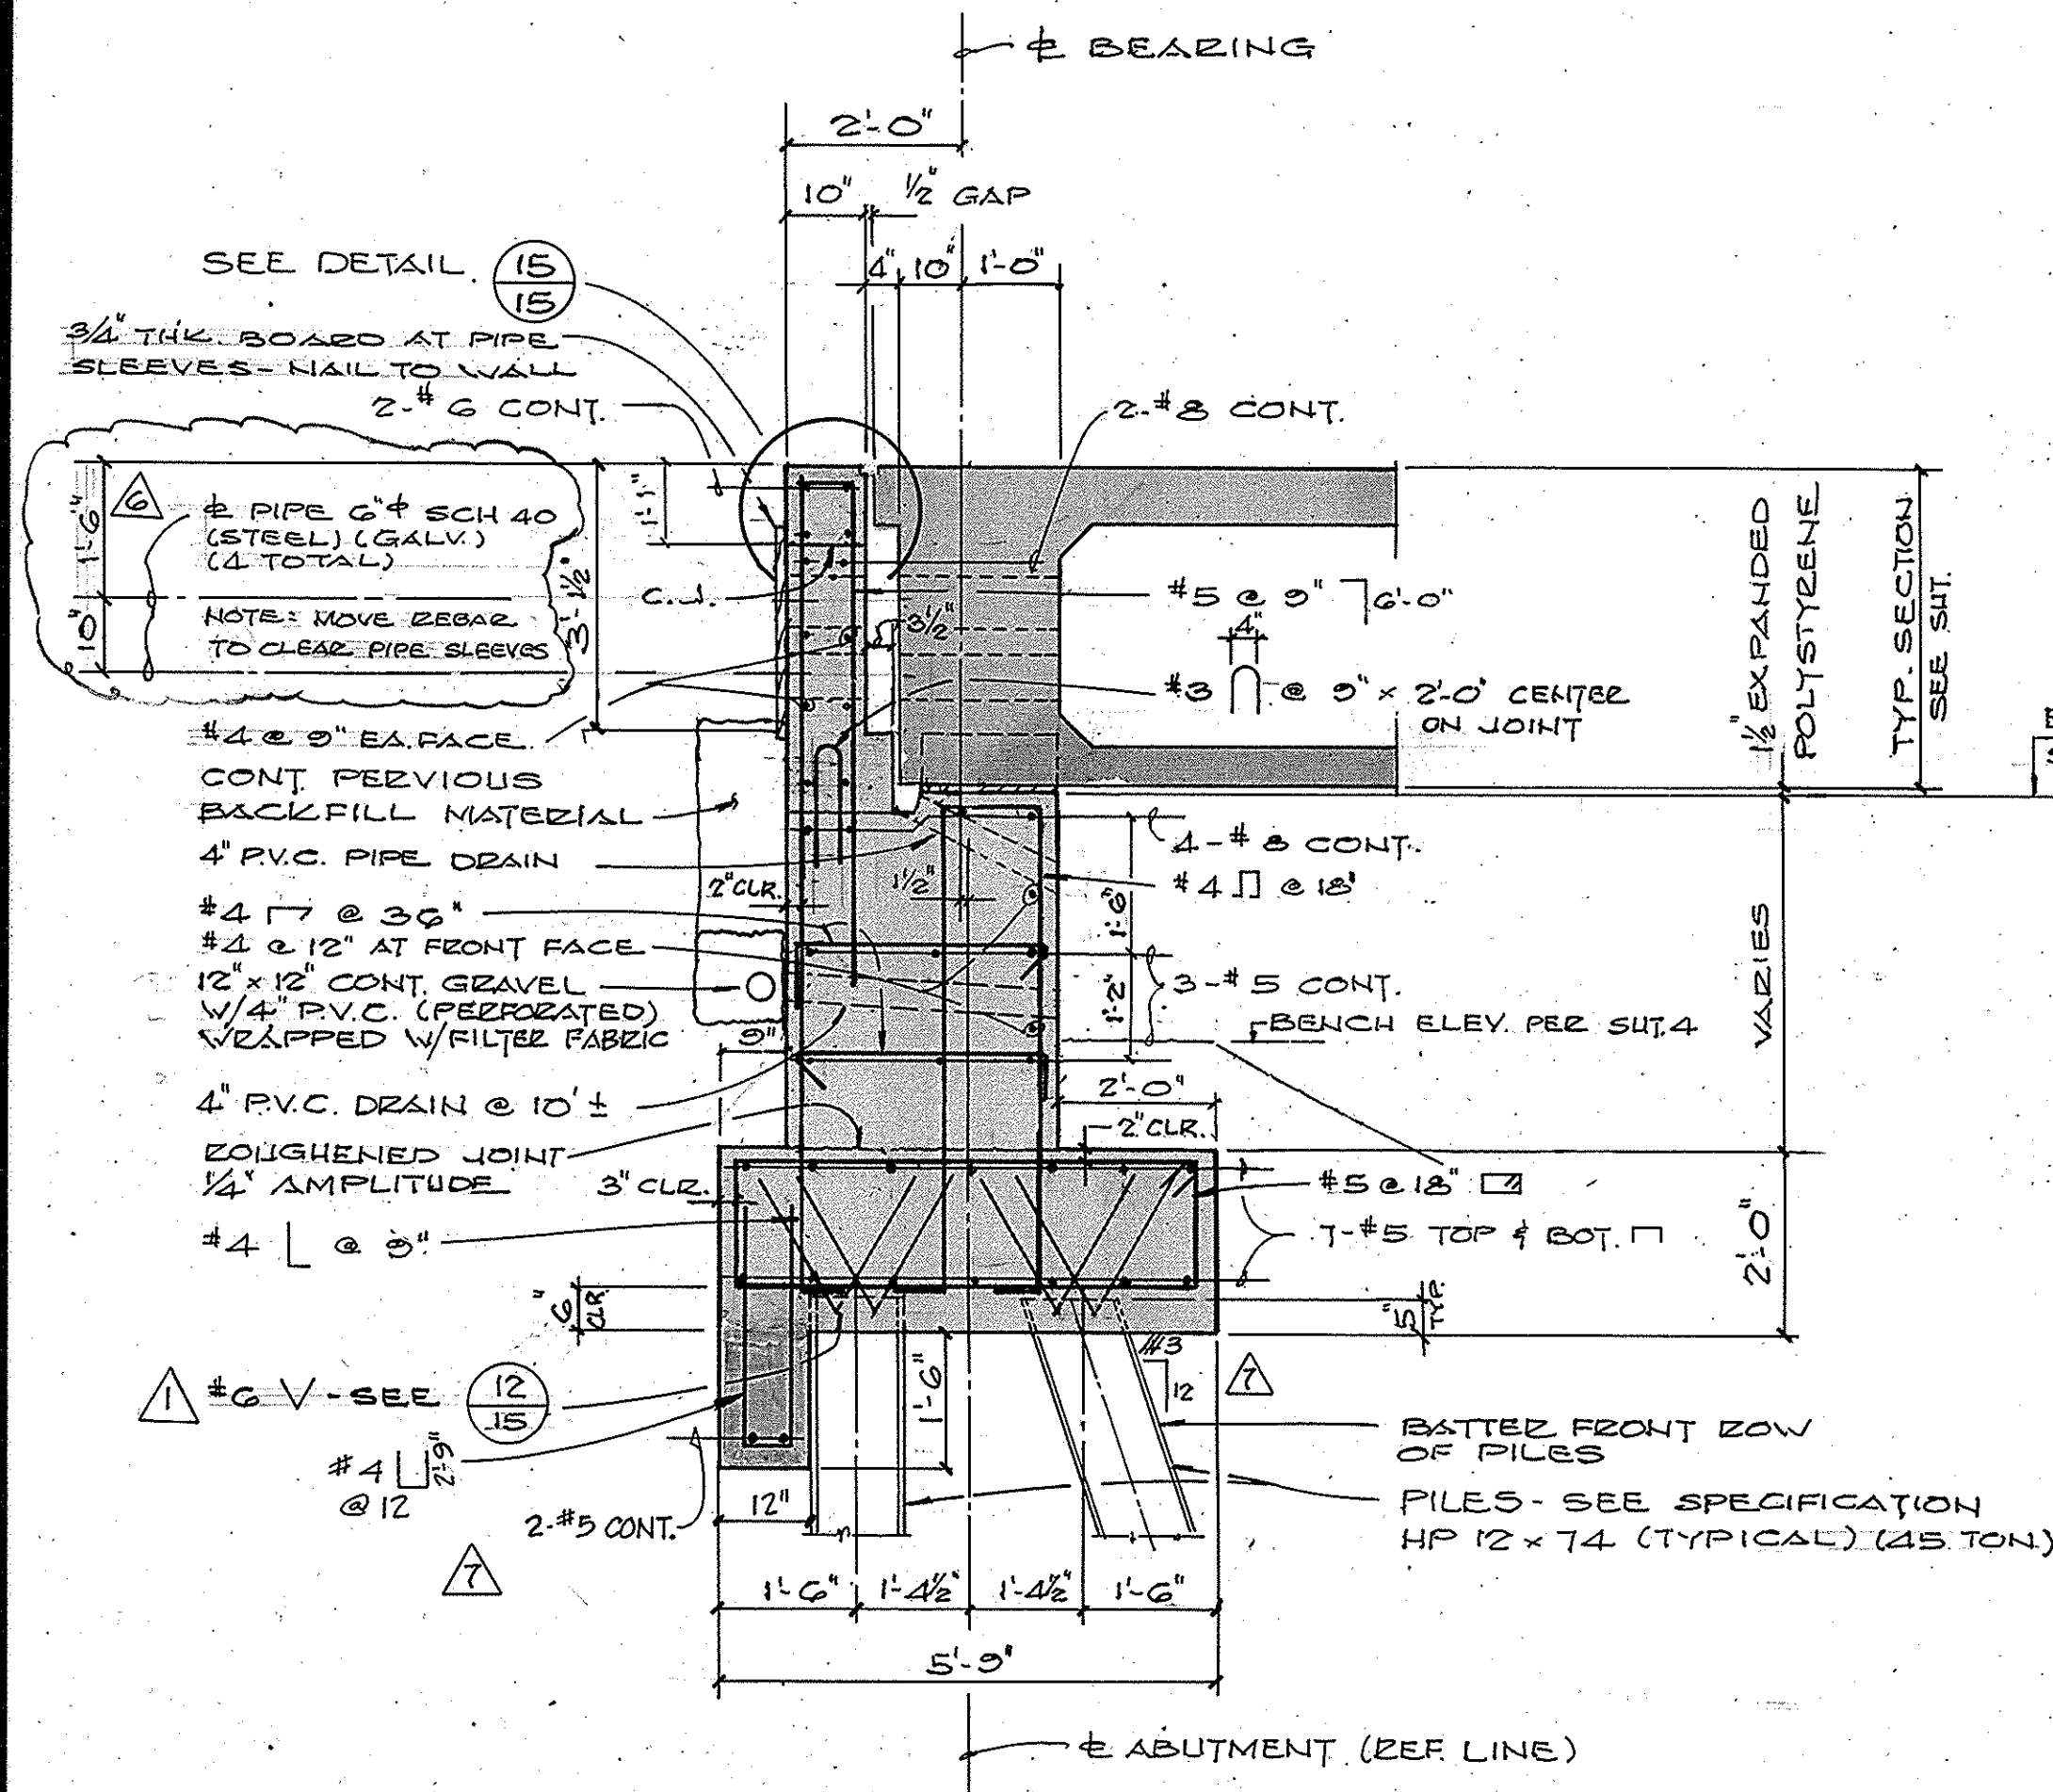


TYPICAL SECTION A-3
SCALE 1/2" = 1'-0"

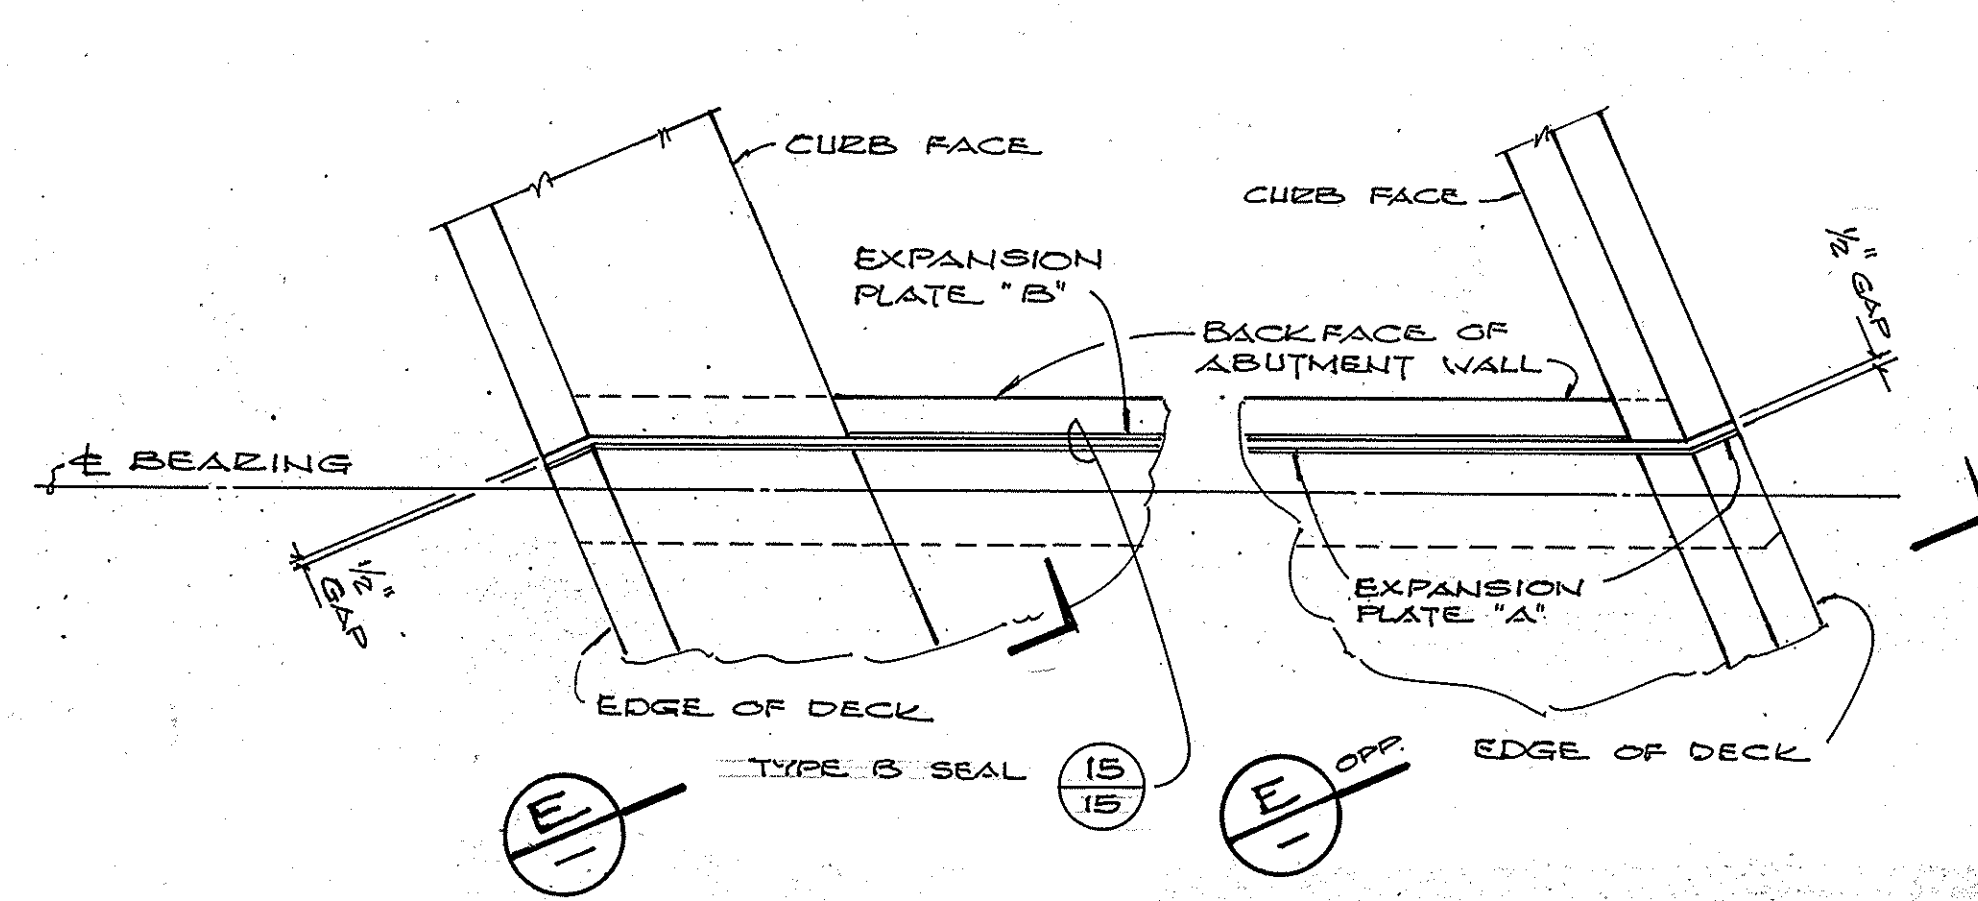


PLAN - LIMITS OF DECK EXP. PL'S D-1
SCALE 1/4" = 1'-0"
NOTE: SEE ABUTMENT PLAN - SHEETS 5 & 6 FOR ORIENTATION

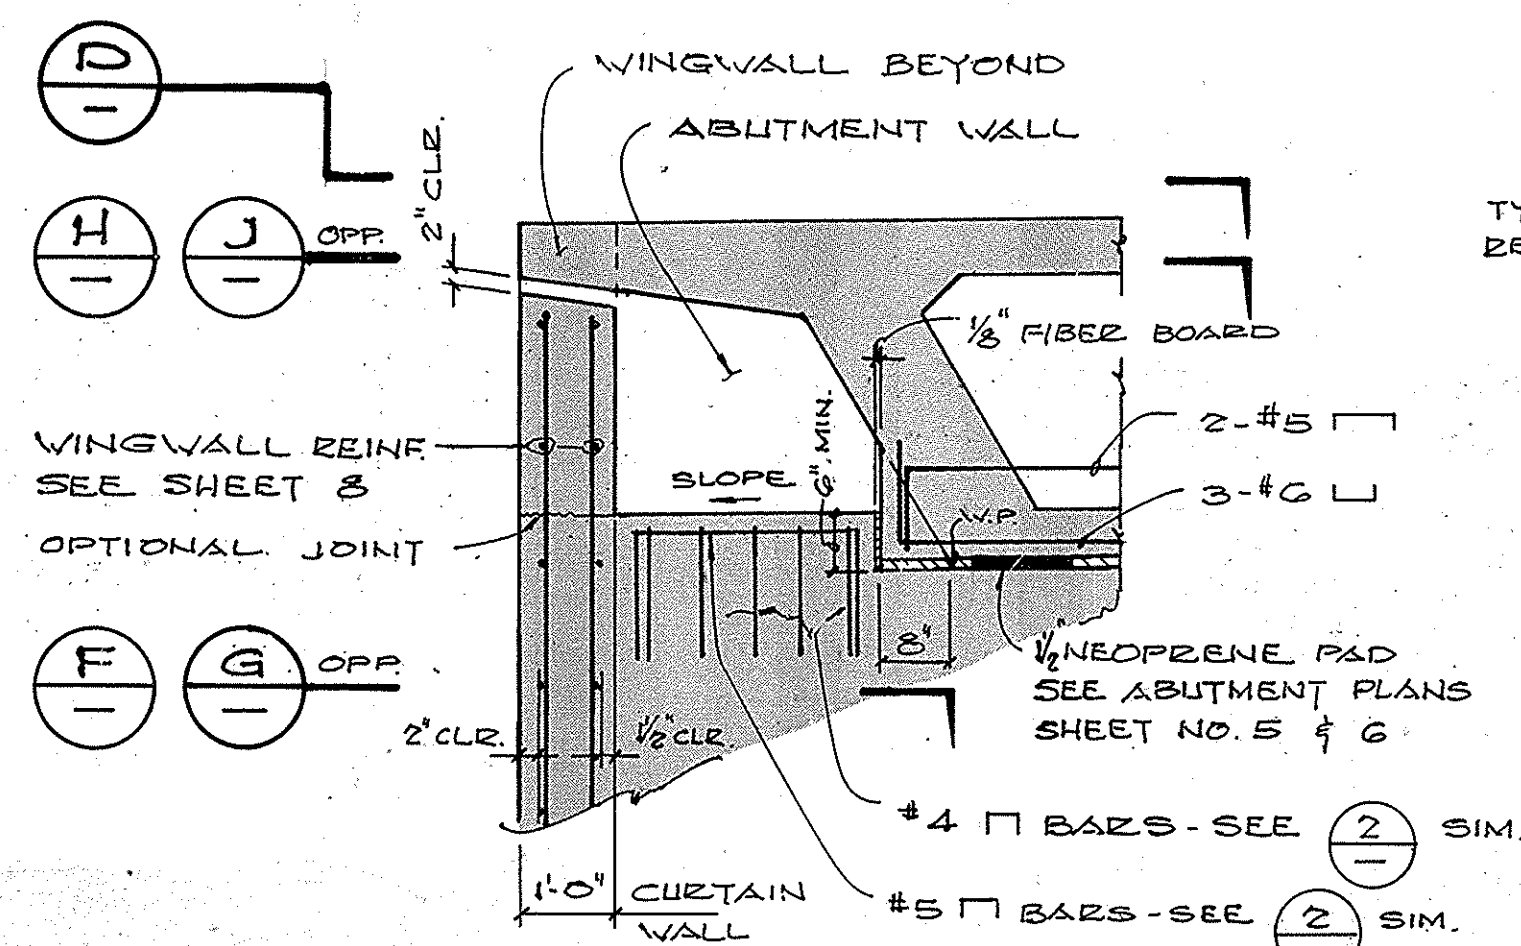

ELEVATION - CURTAIN WALL E-1
SCALE 1/2" = 1'-0"

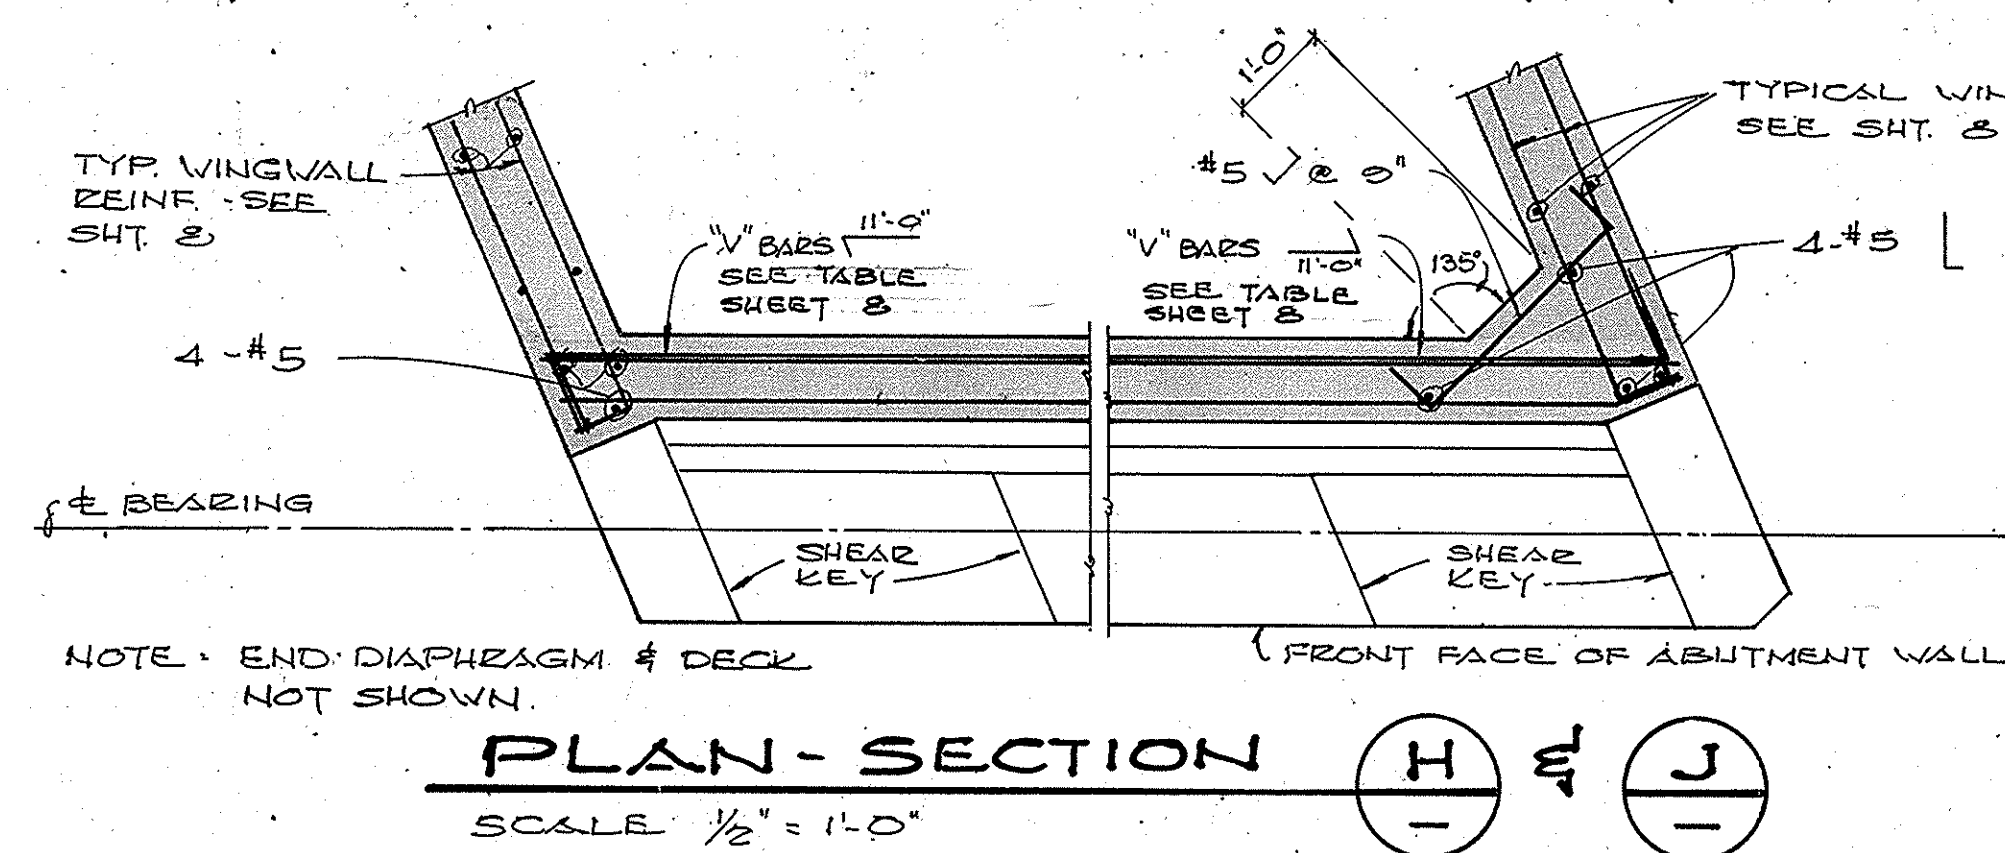


PLAN - SECTION H-1 & J-1
SCALE 1/2" = 1'-0"

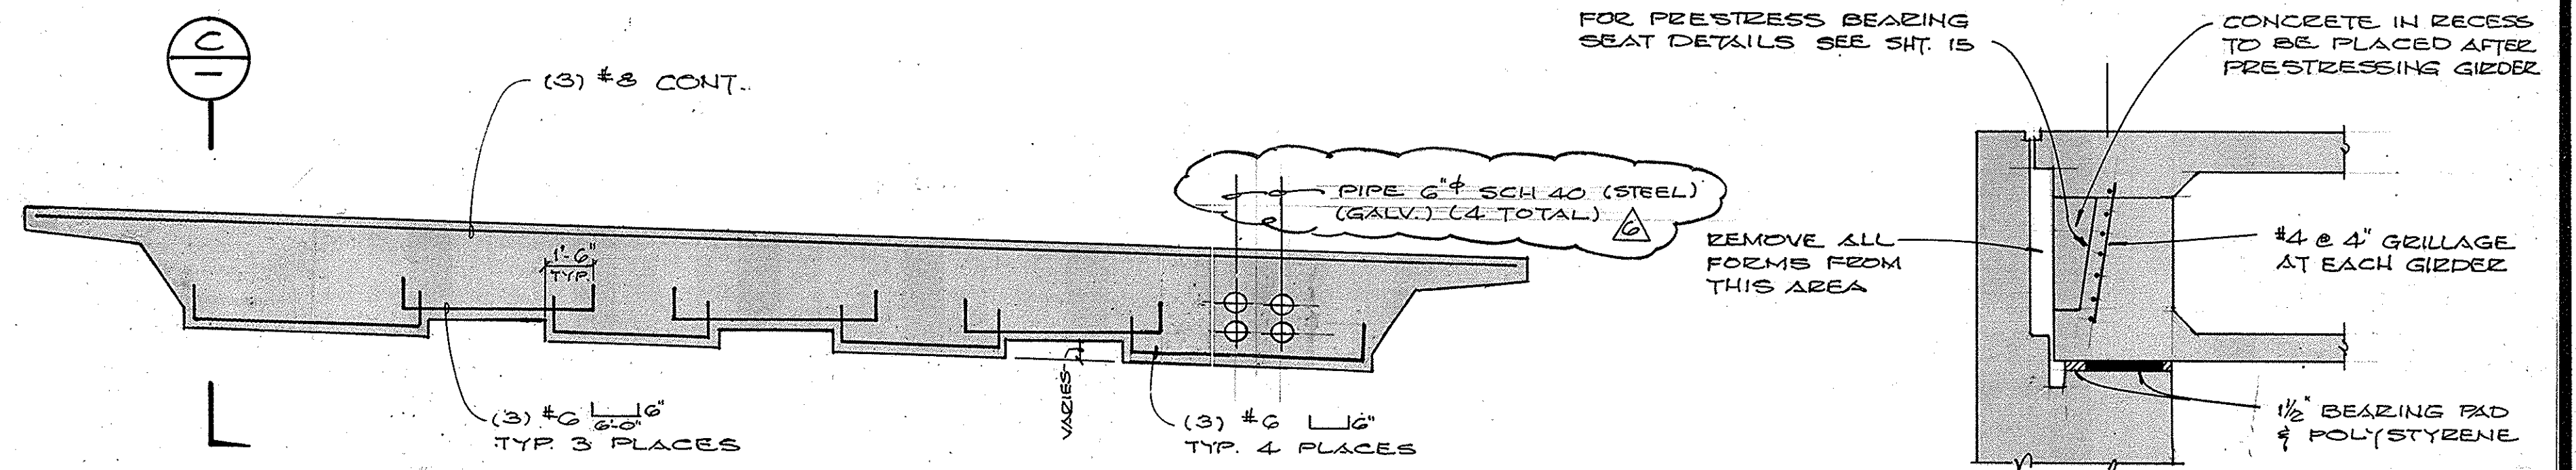


TYPICAL END DIAPHRAGM B-5
SCALE 1/4" = 1'-0"
NOTE: END DIAPHRAGM SHOWN - NORTH BRIDGE ABUTMENT 1


ANCHORAGE BLOCKOUT I-15
N.T.S.

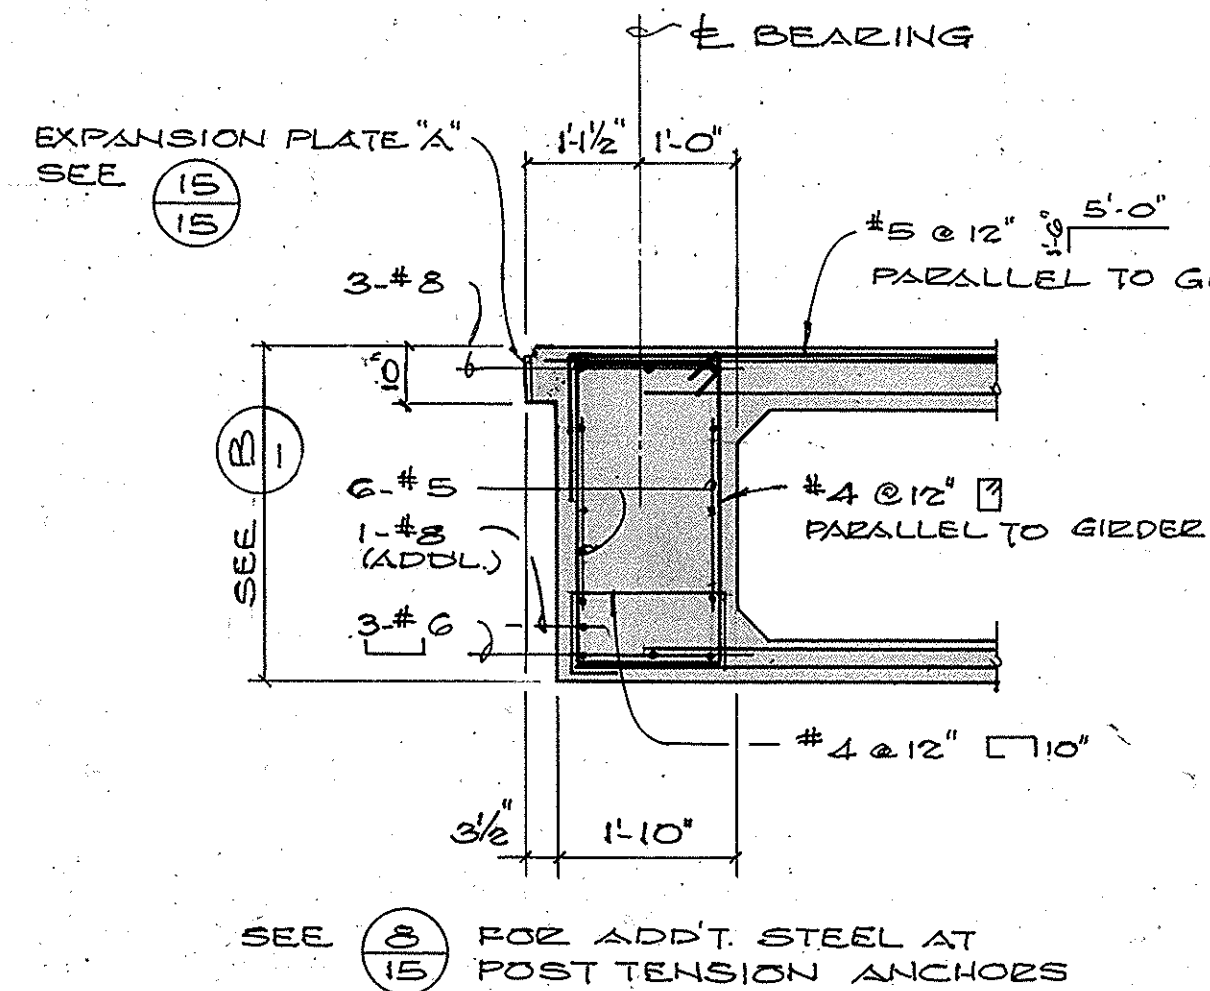


SECTION C-1
SCALE 1/2" = 1'-0"

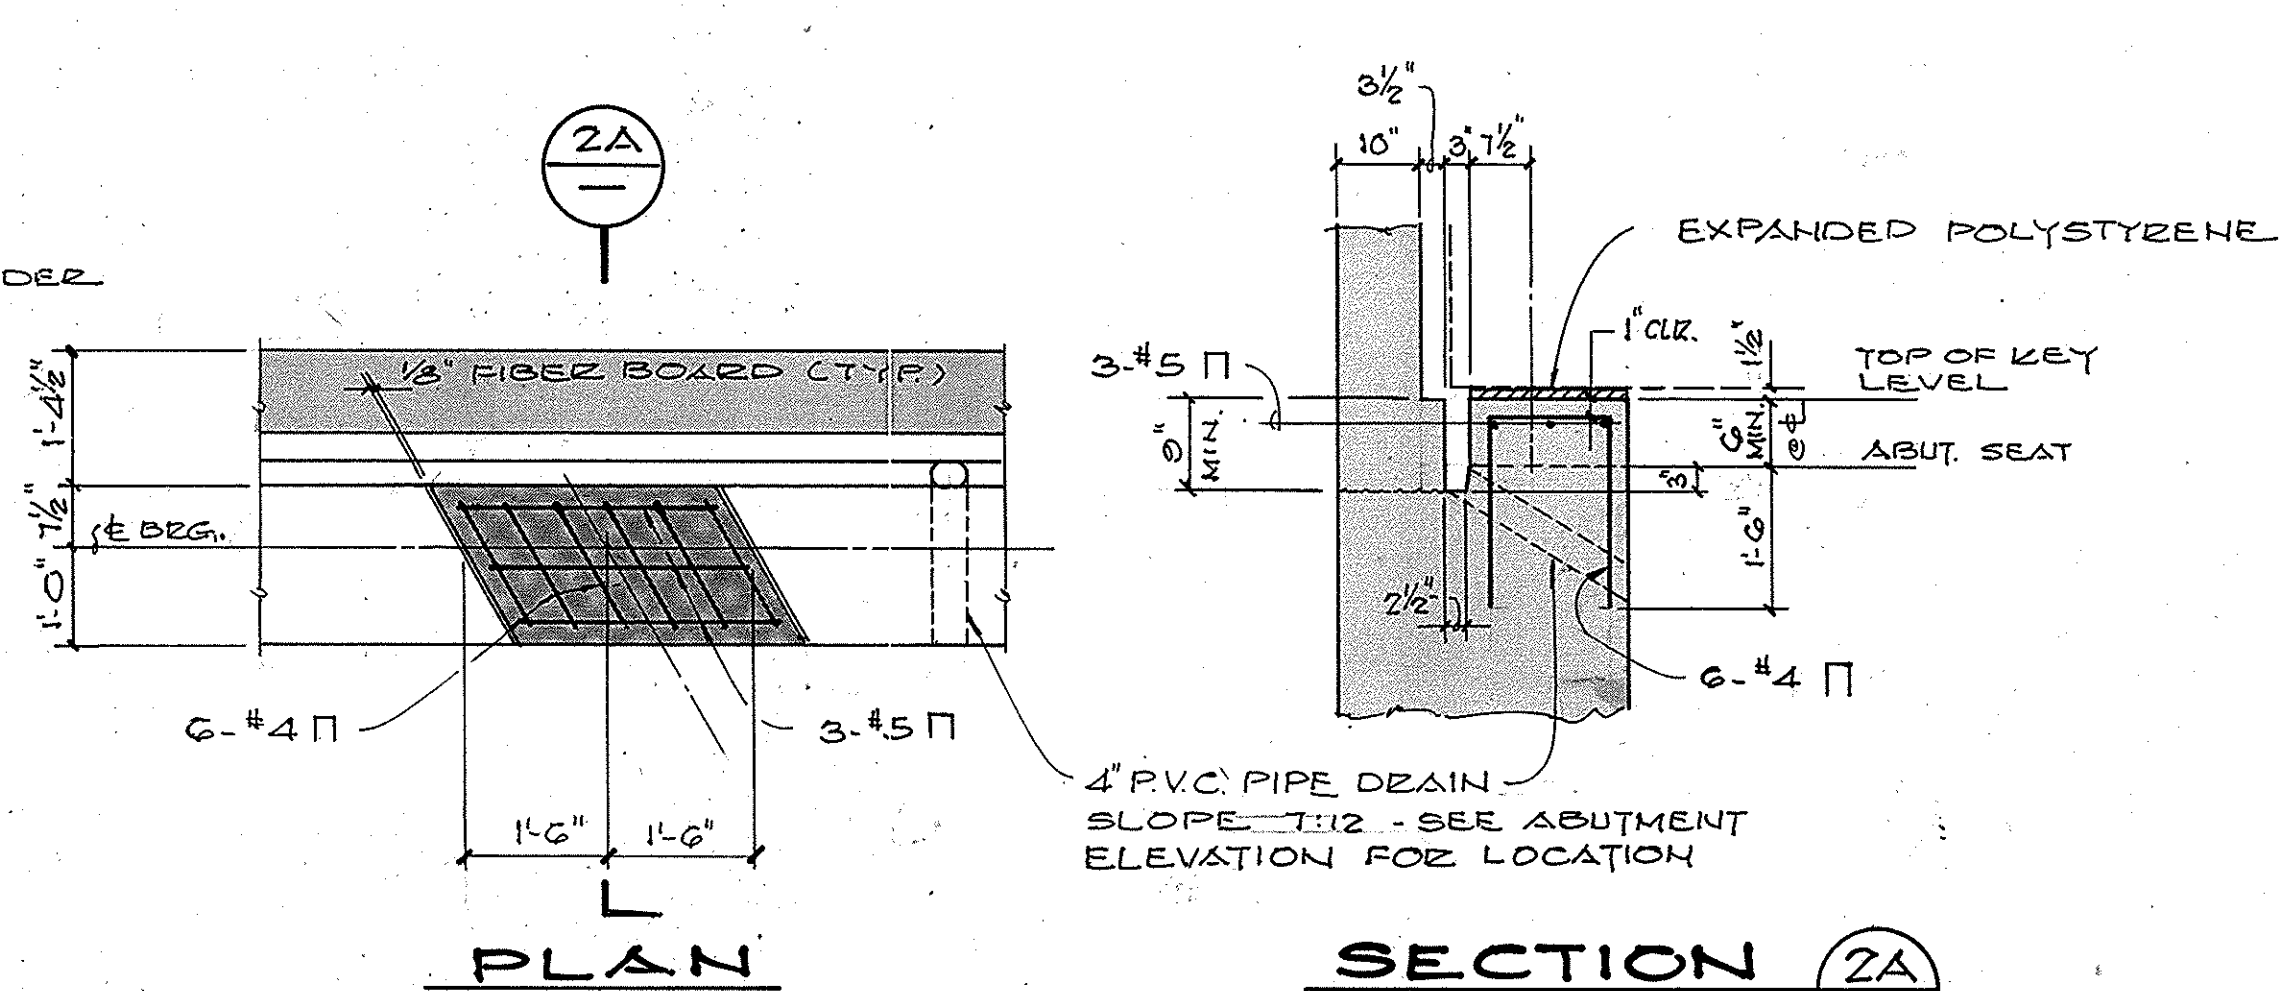


TYPICAL SHEAR KEY DETAIL 2A-1
SCALE 1/2" = 1'-0"

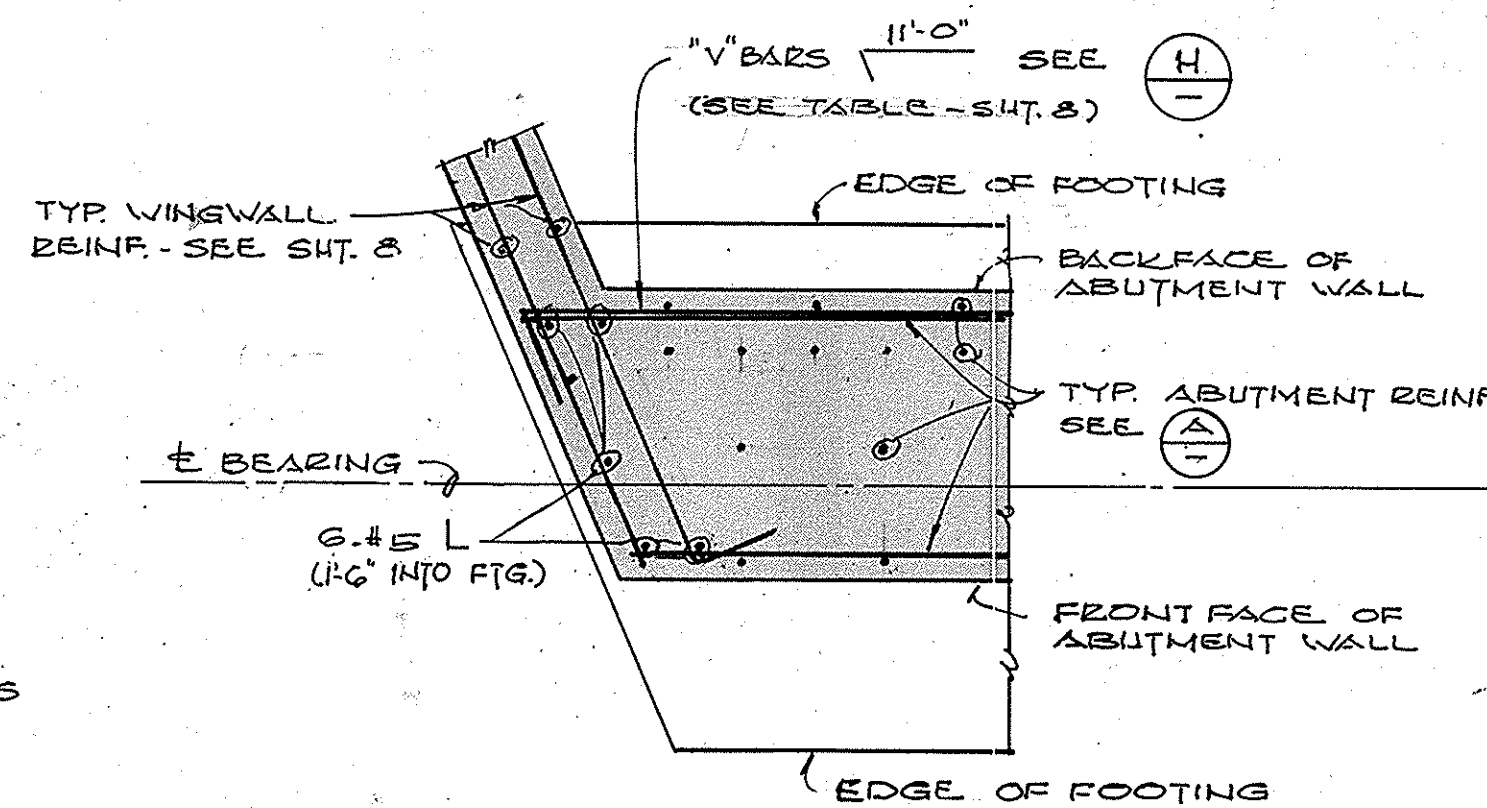

PLAN - SECTION F-1
SCALE 1/2" = 1'-0"

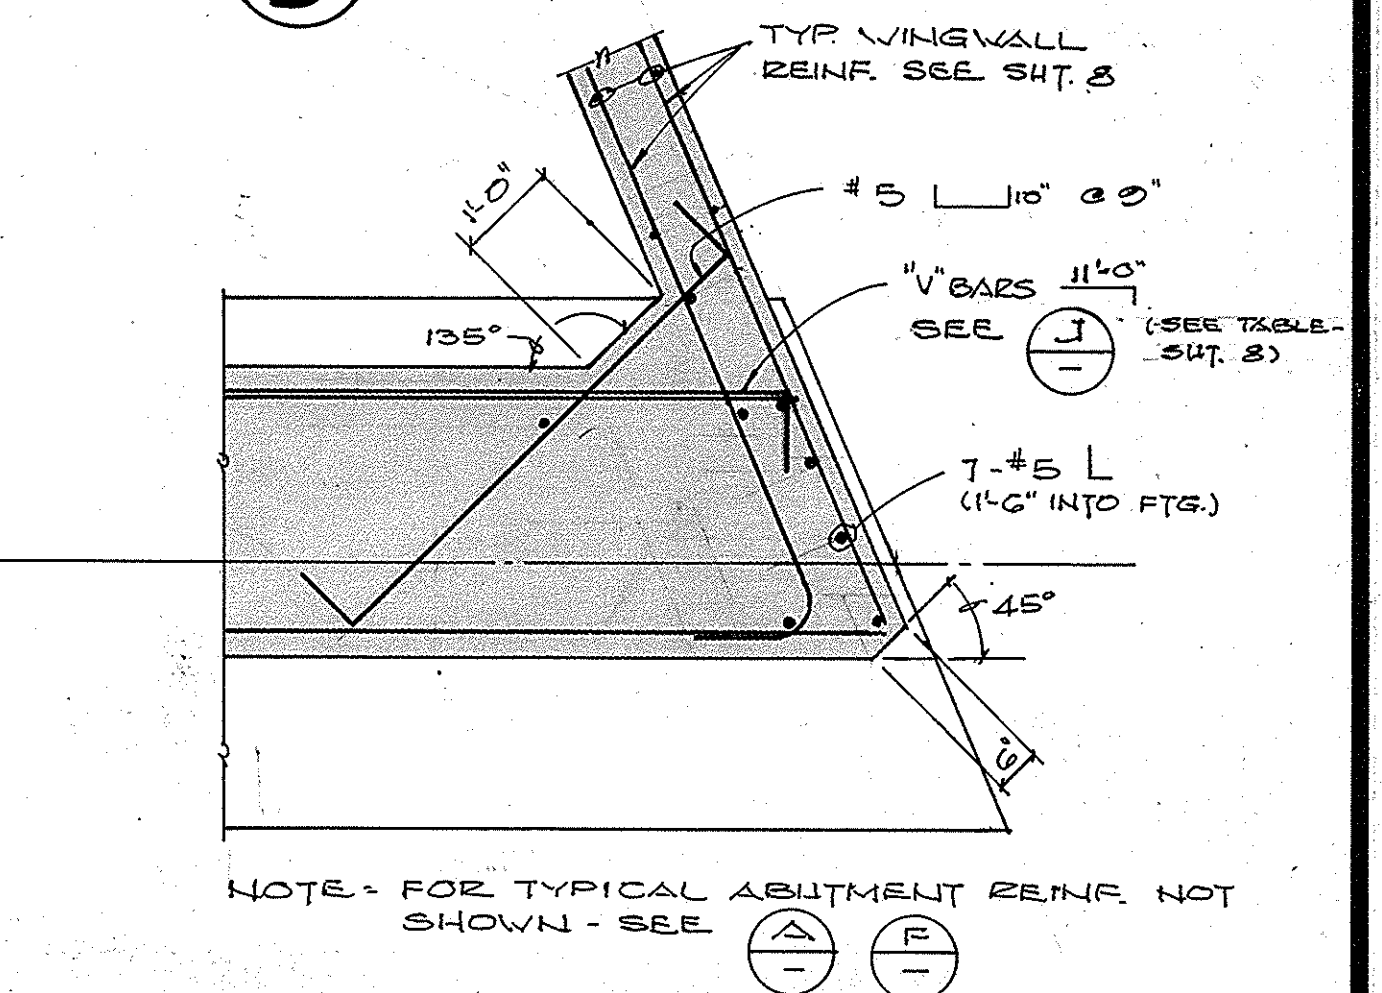

PLAN - SECTION G-1
SCALE 1/2" = 1'-0"

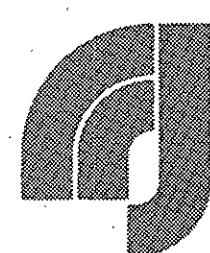

Jack G. Raub Company
Engineering & Planning
2400 Chicono Drive - Mission Viejo, California 92691 (714) 859-4948

--	--	
PLAN SCALE		ABUTMENT SECTIONS & DETAILS	SHEET 7 OF 17
DES. J.L.C. DWN. T.U.			
SHEEP HILLS ROAD BRIDGE ACROSS ALISO CREEK		IN 213040	

DR 5 (13985)