




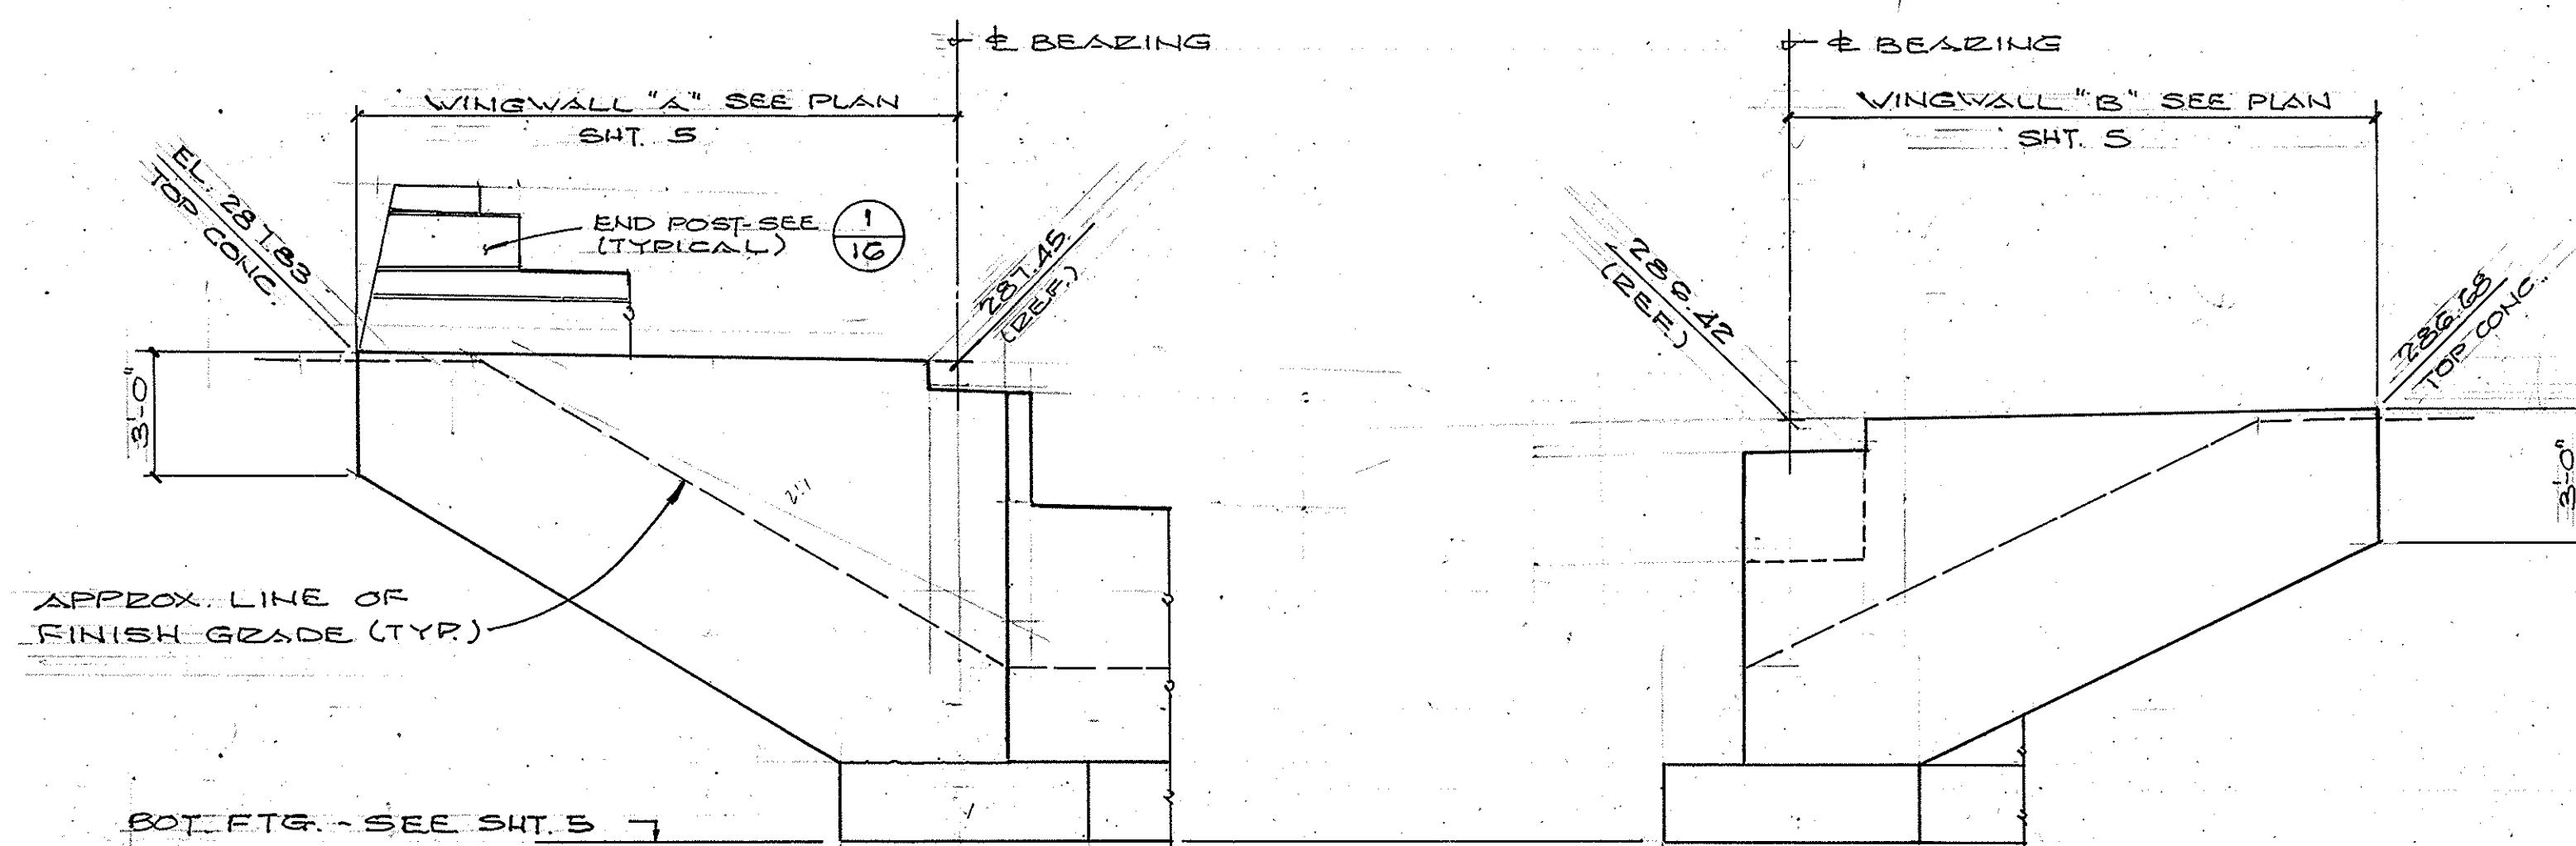


NORTH BRIDGE - ABUTMENT 1
SCALE 1/4" = 1'-0"

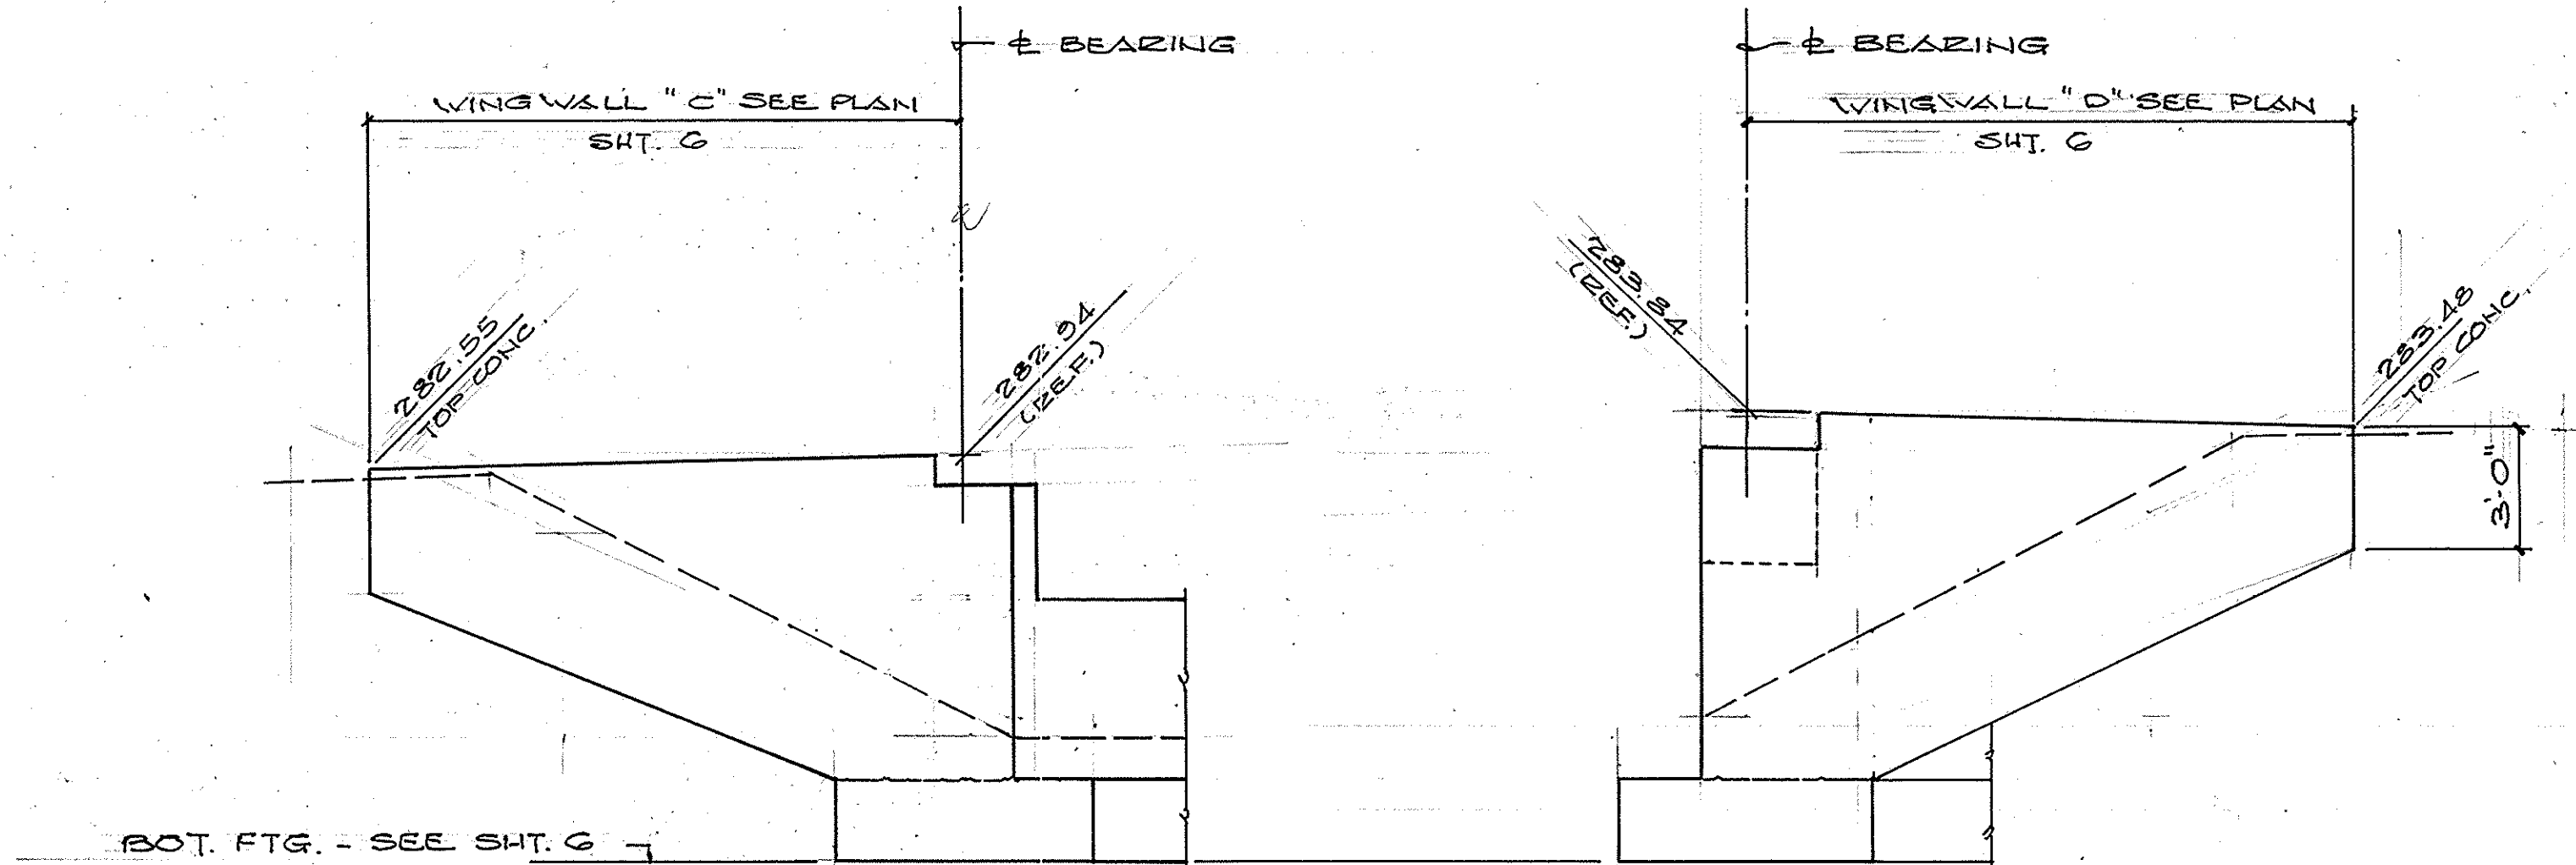


NORTH BRIDGE - ABUTMENT 4
SCALE 1/4" = 1'-0"

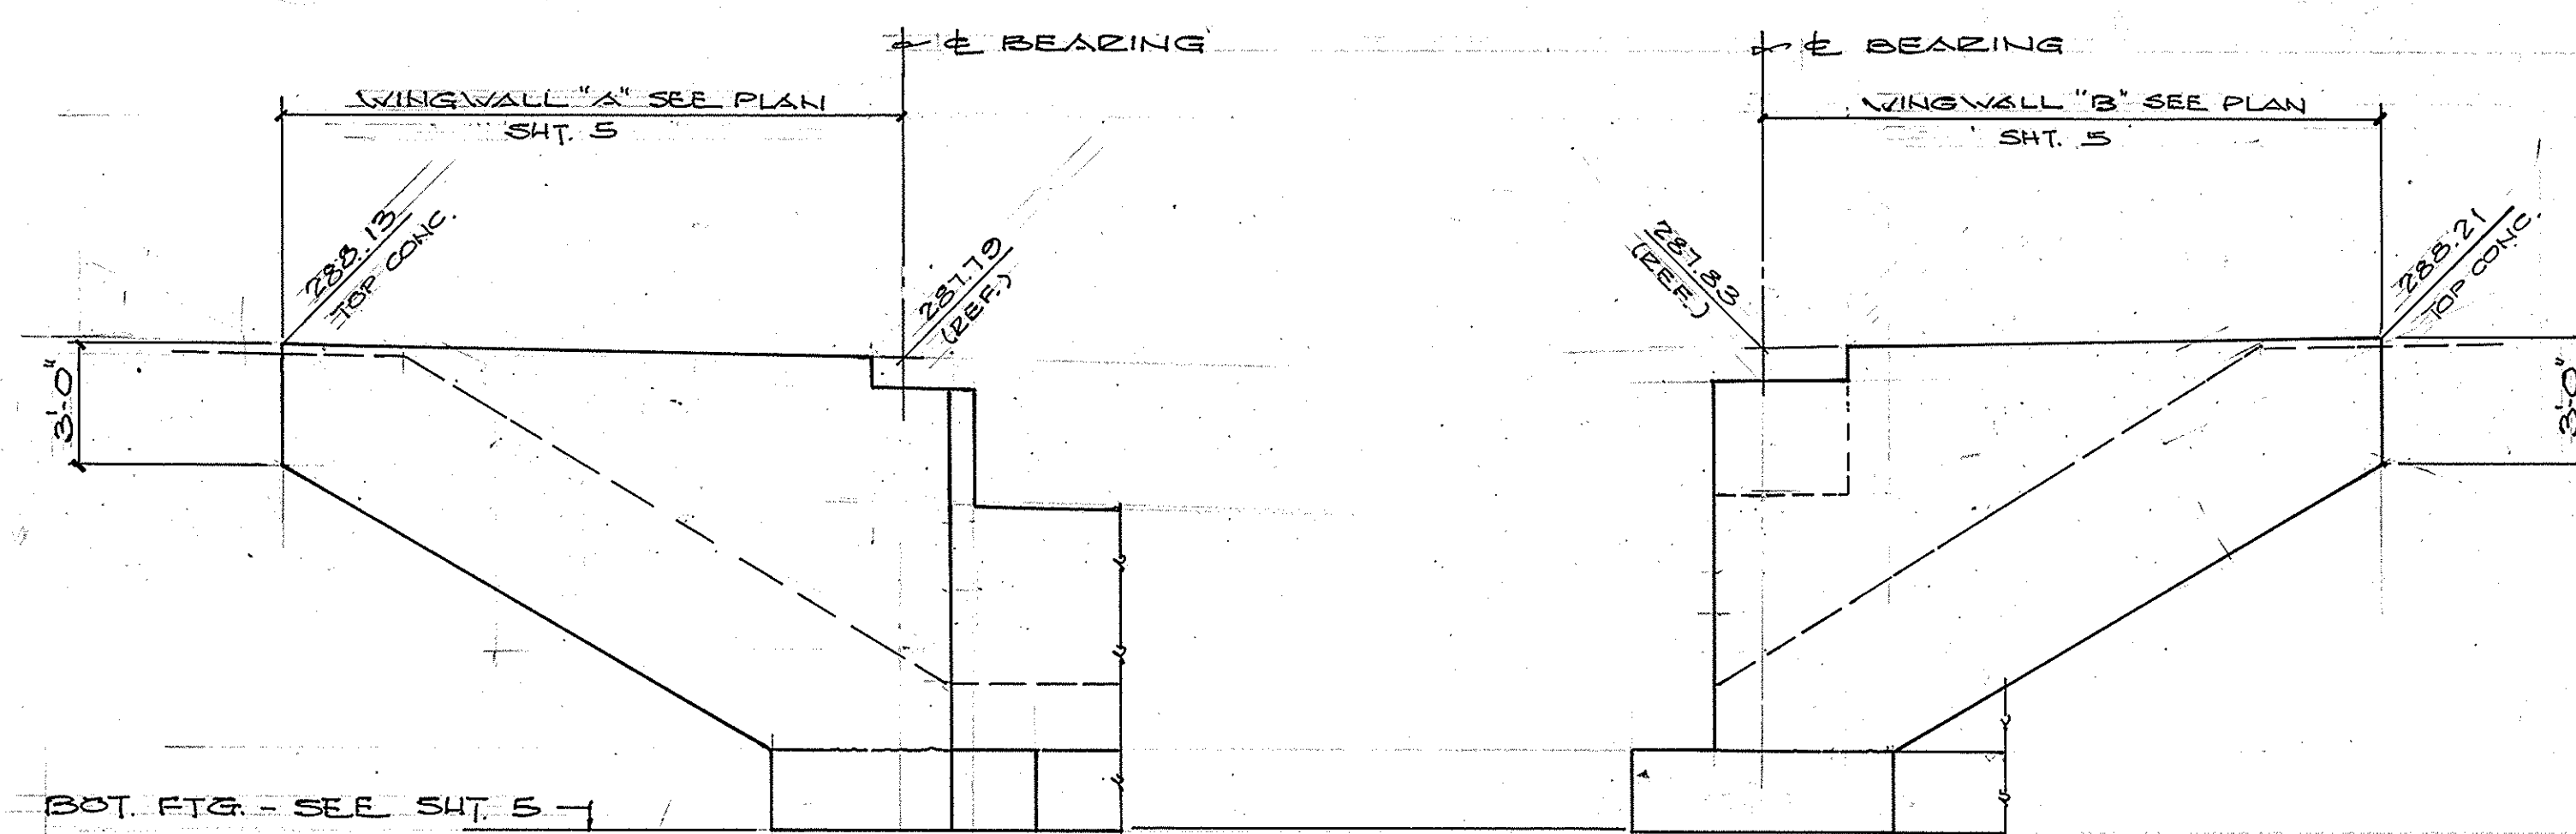

SOUTH BRIDGE - ABUTMENT 1
SCALE 1/4" = 1'-0" (FUTURE) ⚠

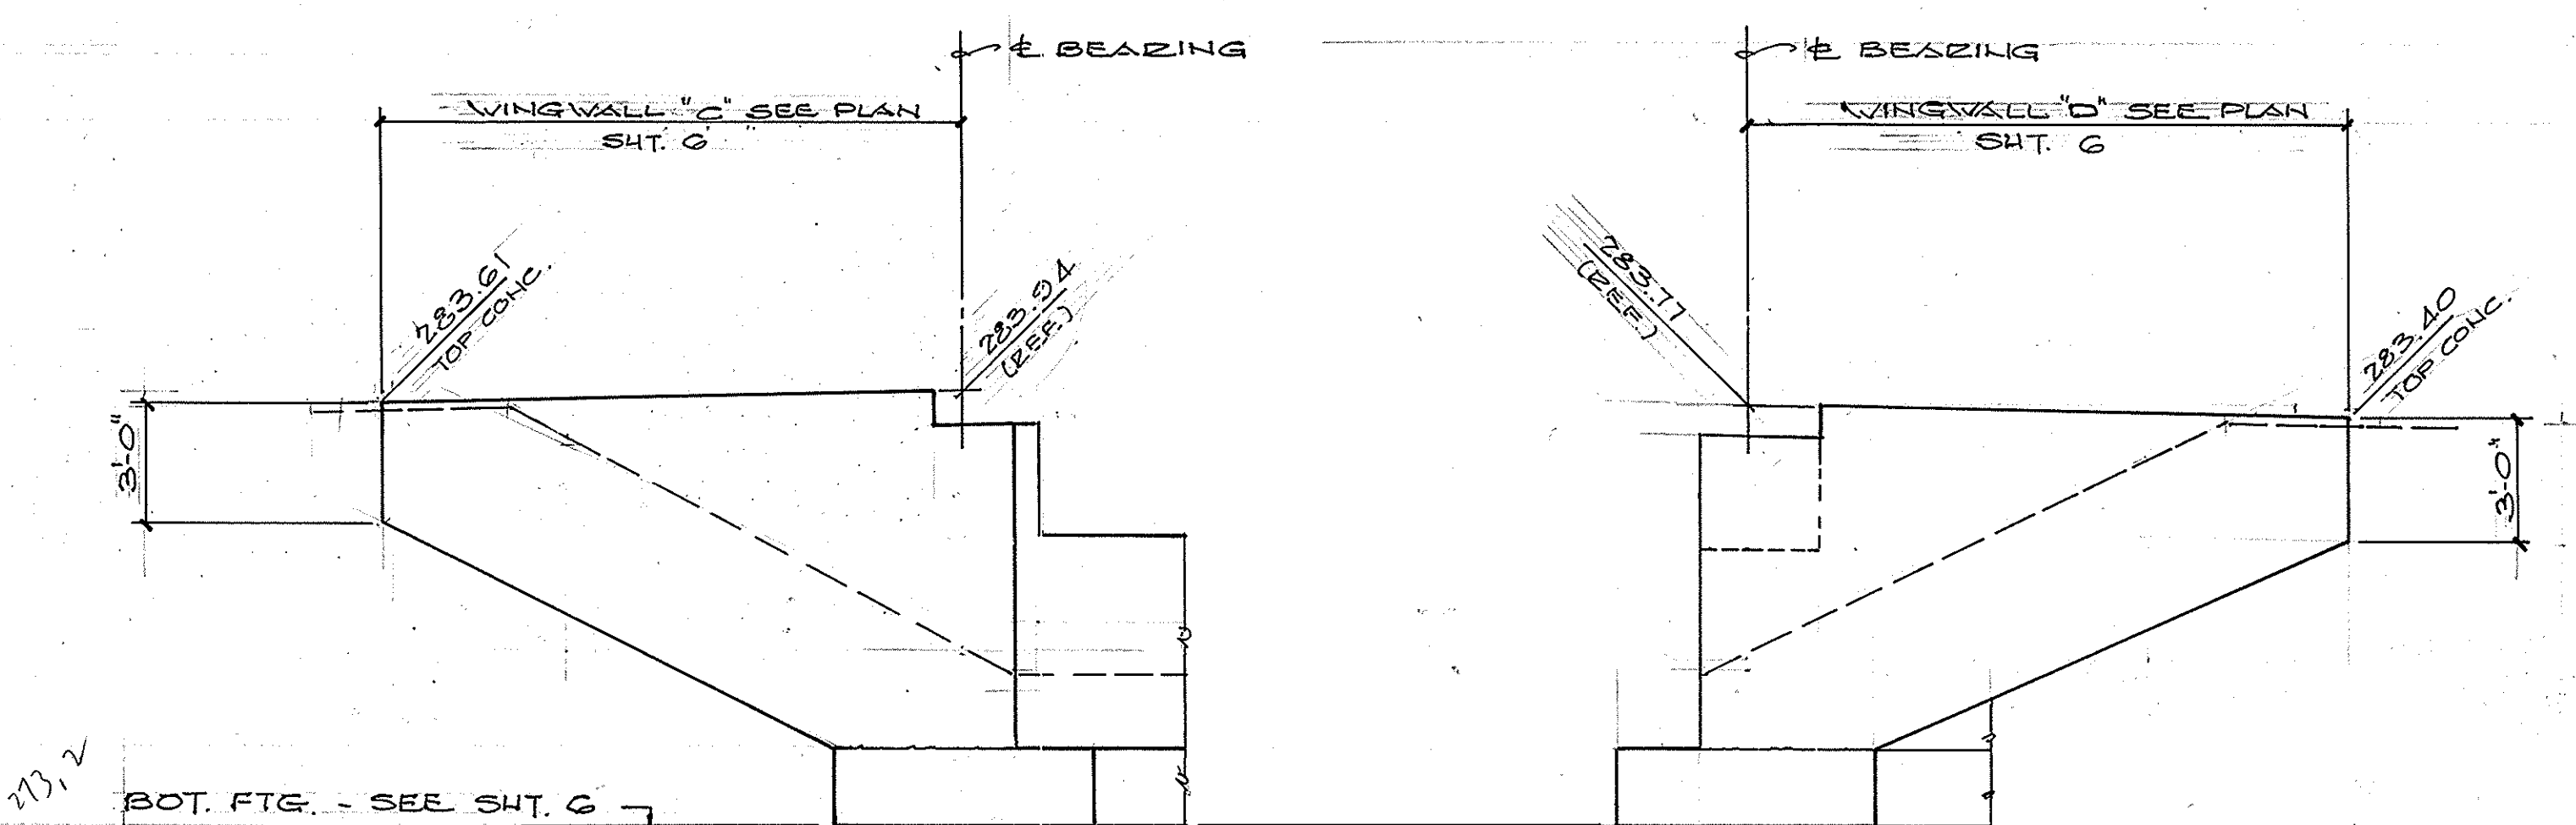

SOUTH BRIDGE - ABUTMENT 4
SCALE 1/4" = 1'-0" (FUTURE) ⚠

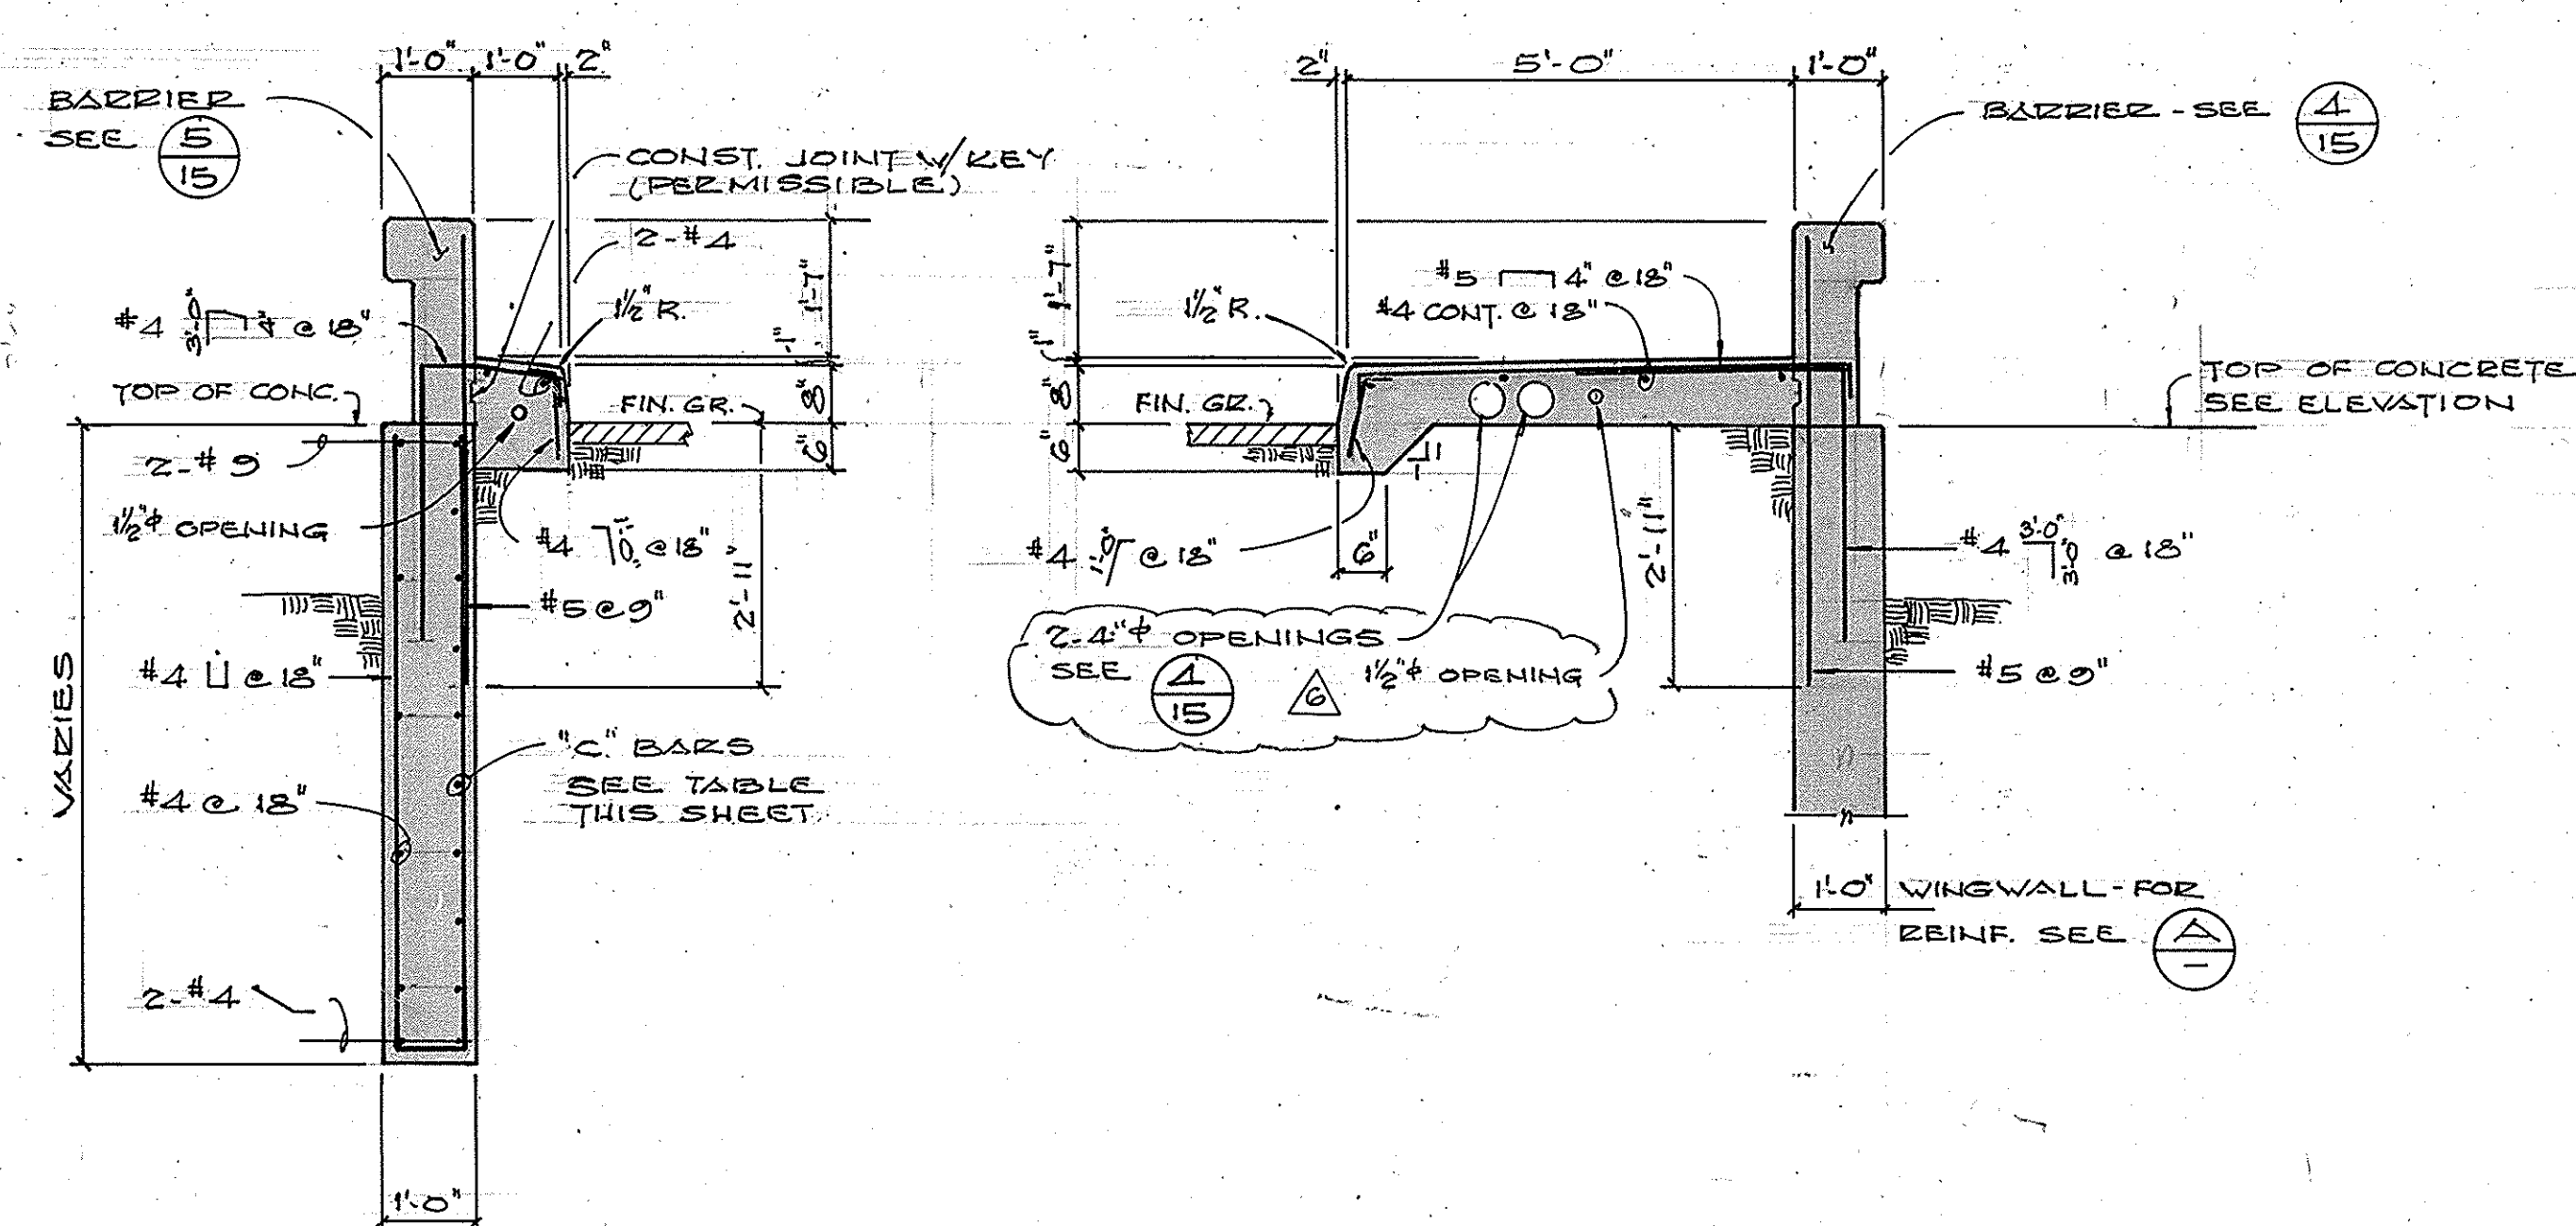

SECTION A
SCALE 1/2" = 1'-0"

SECTION B
SCALE 1/2" = 1'-0"

NORTH BRIDGE


WINGWALL	"C" BARS	"V" BARS
"A"	#8 @ 5'	#5 @ 5'
"B"	#6 @ 5'	#4 @ 5'
"C"	#7 @ 5'	#4 @ 5'
"D"	#7 @ 5'	#4 @ 5'

SOUTH BRIDGE

WINGWALL	"C" BARS	"V" BARS
"A"	#8 @ 5'	#5 @ 5'
"B"	#8 @ 5'	#5 @ 5'
"C"	#7 @ 5'	#4 @ 5'
"D"	#7 @ 5'	#4 @ 5'

NOTE: FOR LOCATION OF "V" BARS SEE SHEET 7

REINF. SCHEDULE 1

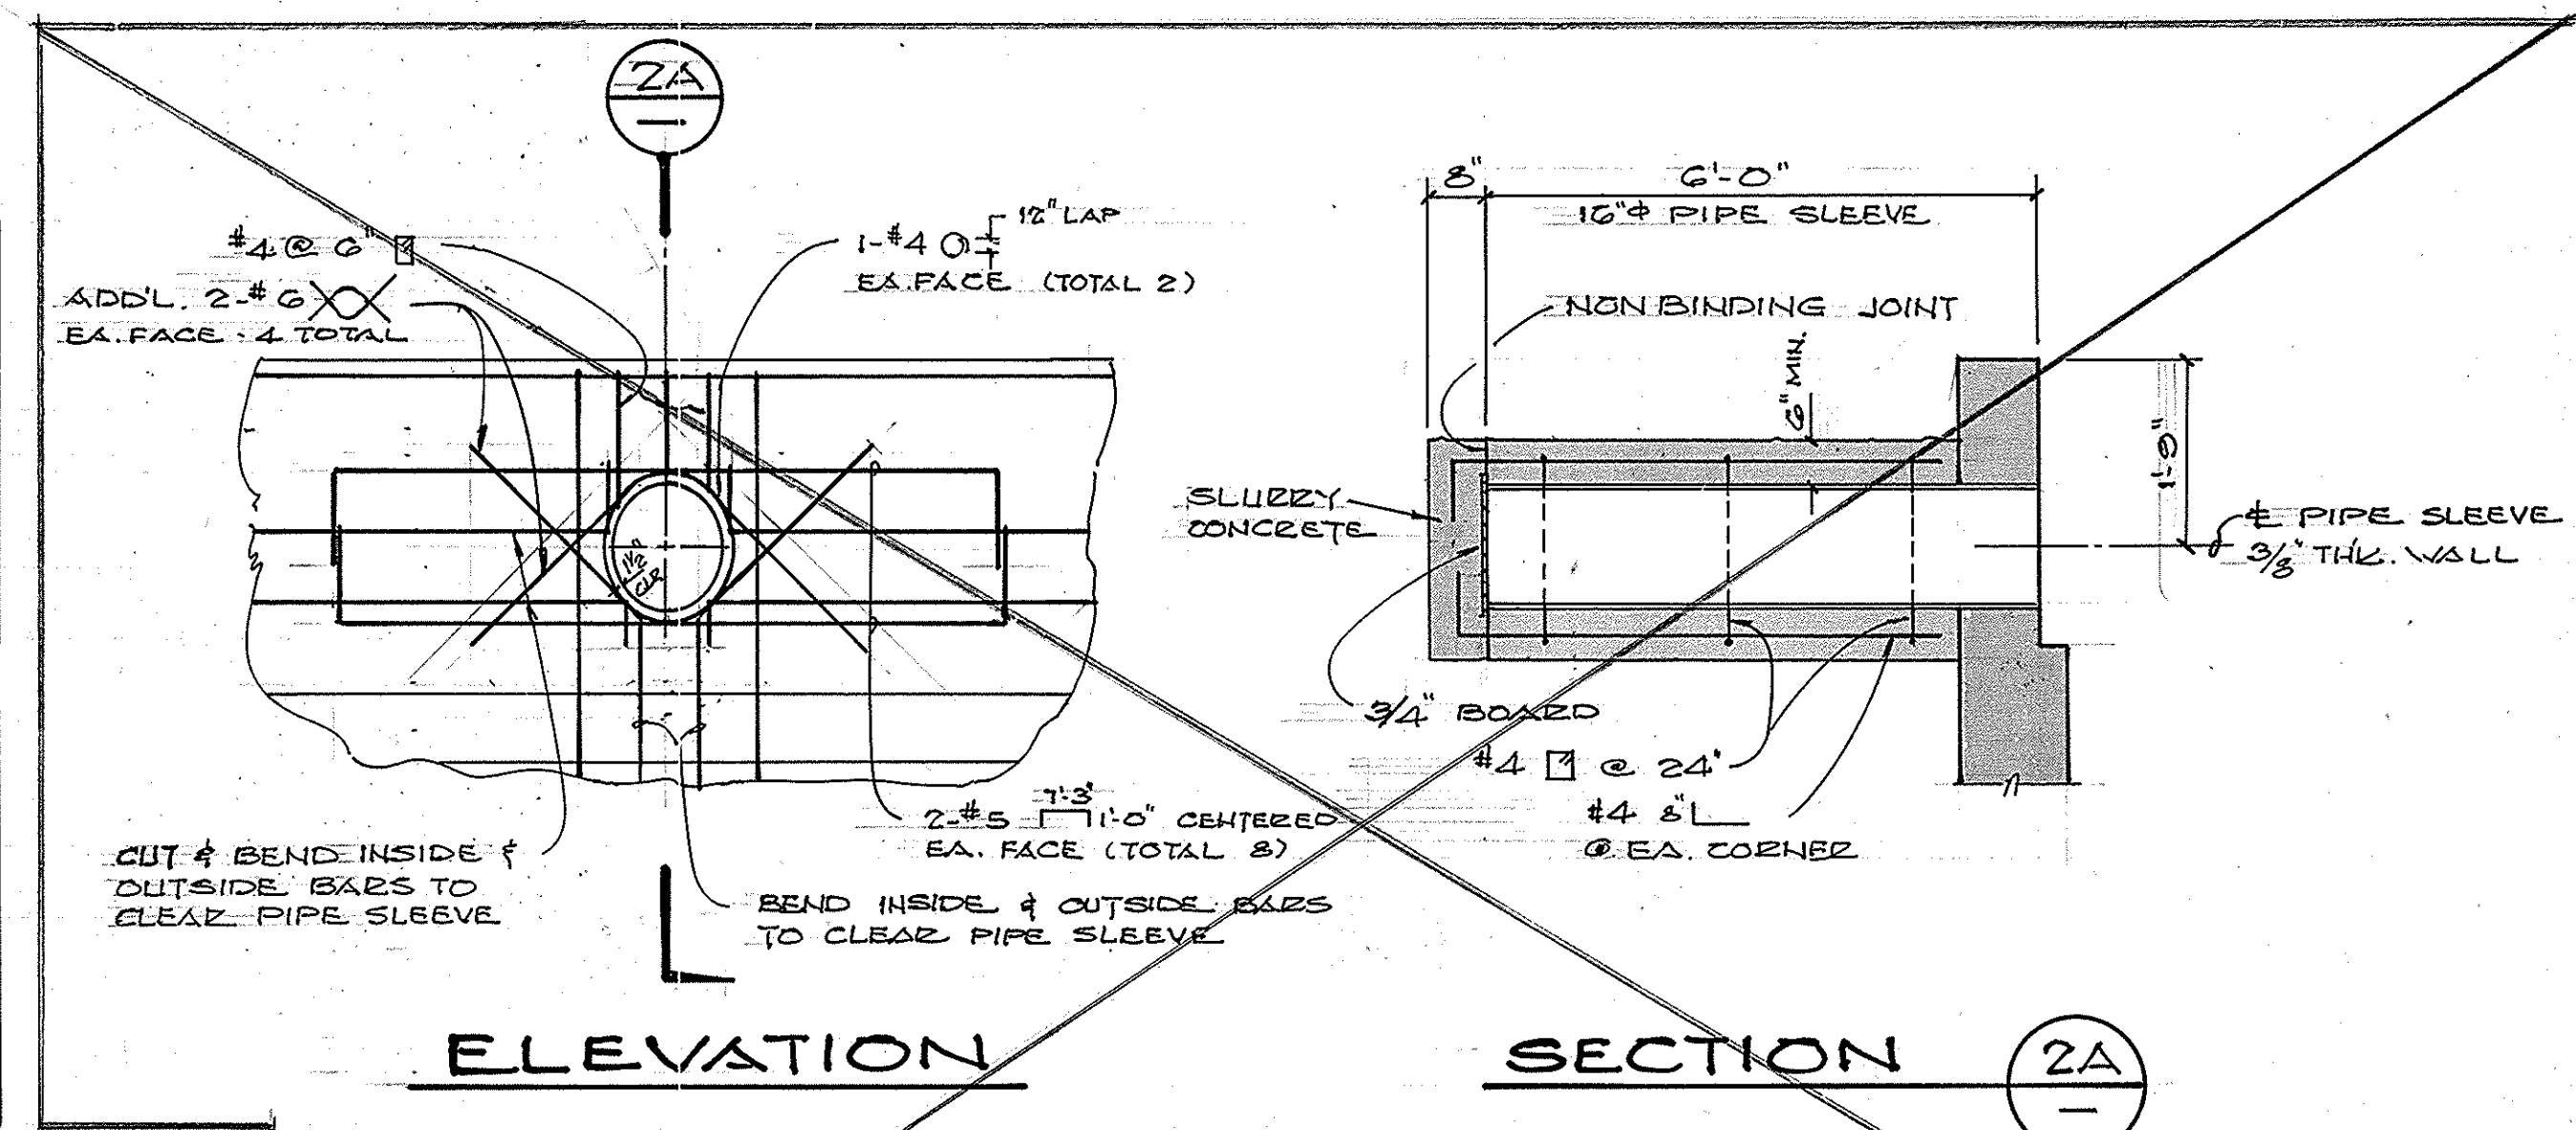


ELEVATION

SECTION 2A

10" STEEL PIPE SLEEVE THRU ABUTMENT
SCALE 1/2" = 1'-0"

2
5

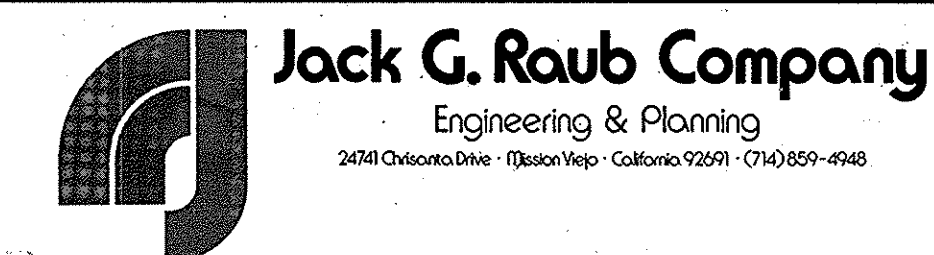

DATE	BY	REVISION DESCRIPTION	APPD	DATE	CHK M.D.C.	DATE	PLAN SCALE	DES J.L.C.	DWN T.L.	SHEET
11/11/05	M.D.C.	AS-BUILT								8
11/11/05	M.D.C.	4" OPNG. WAS 5", ADDED 1 1/2" OPNG.								OF 17
11/11/05	M.D.C.	FINAL COUNTY PLAN CHECK CORRECTION								
11/11/05	M.D.C.	COUNTY PLAN CHECK CORRECTION								

**WINGWALLS
SECTIONS & DETAILS**

SHEEP HILLS ROAD BRIDGE
ACROSS ALISO CREEK

SHEET
8
OF 17
IN 213040

DR. 5 (13985