


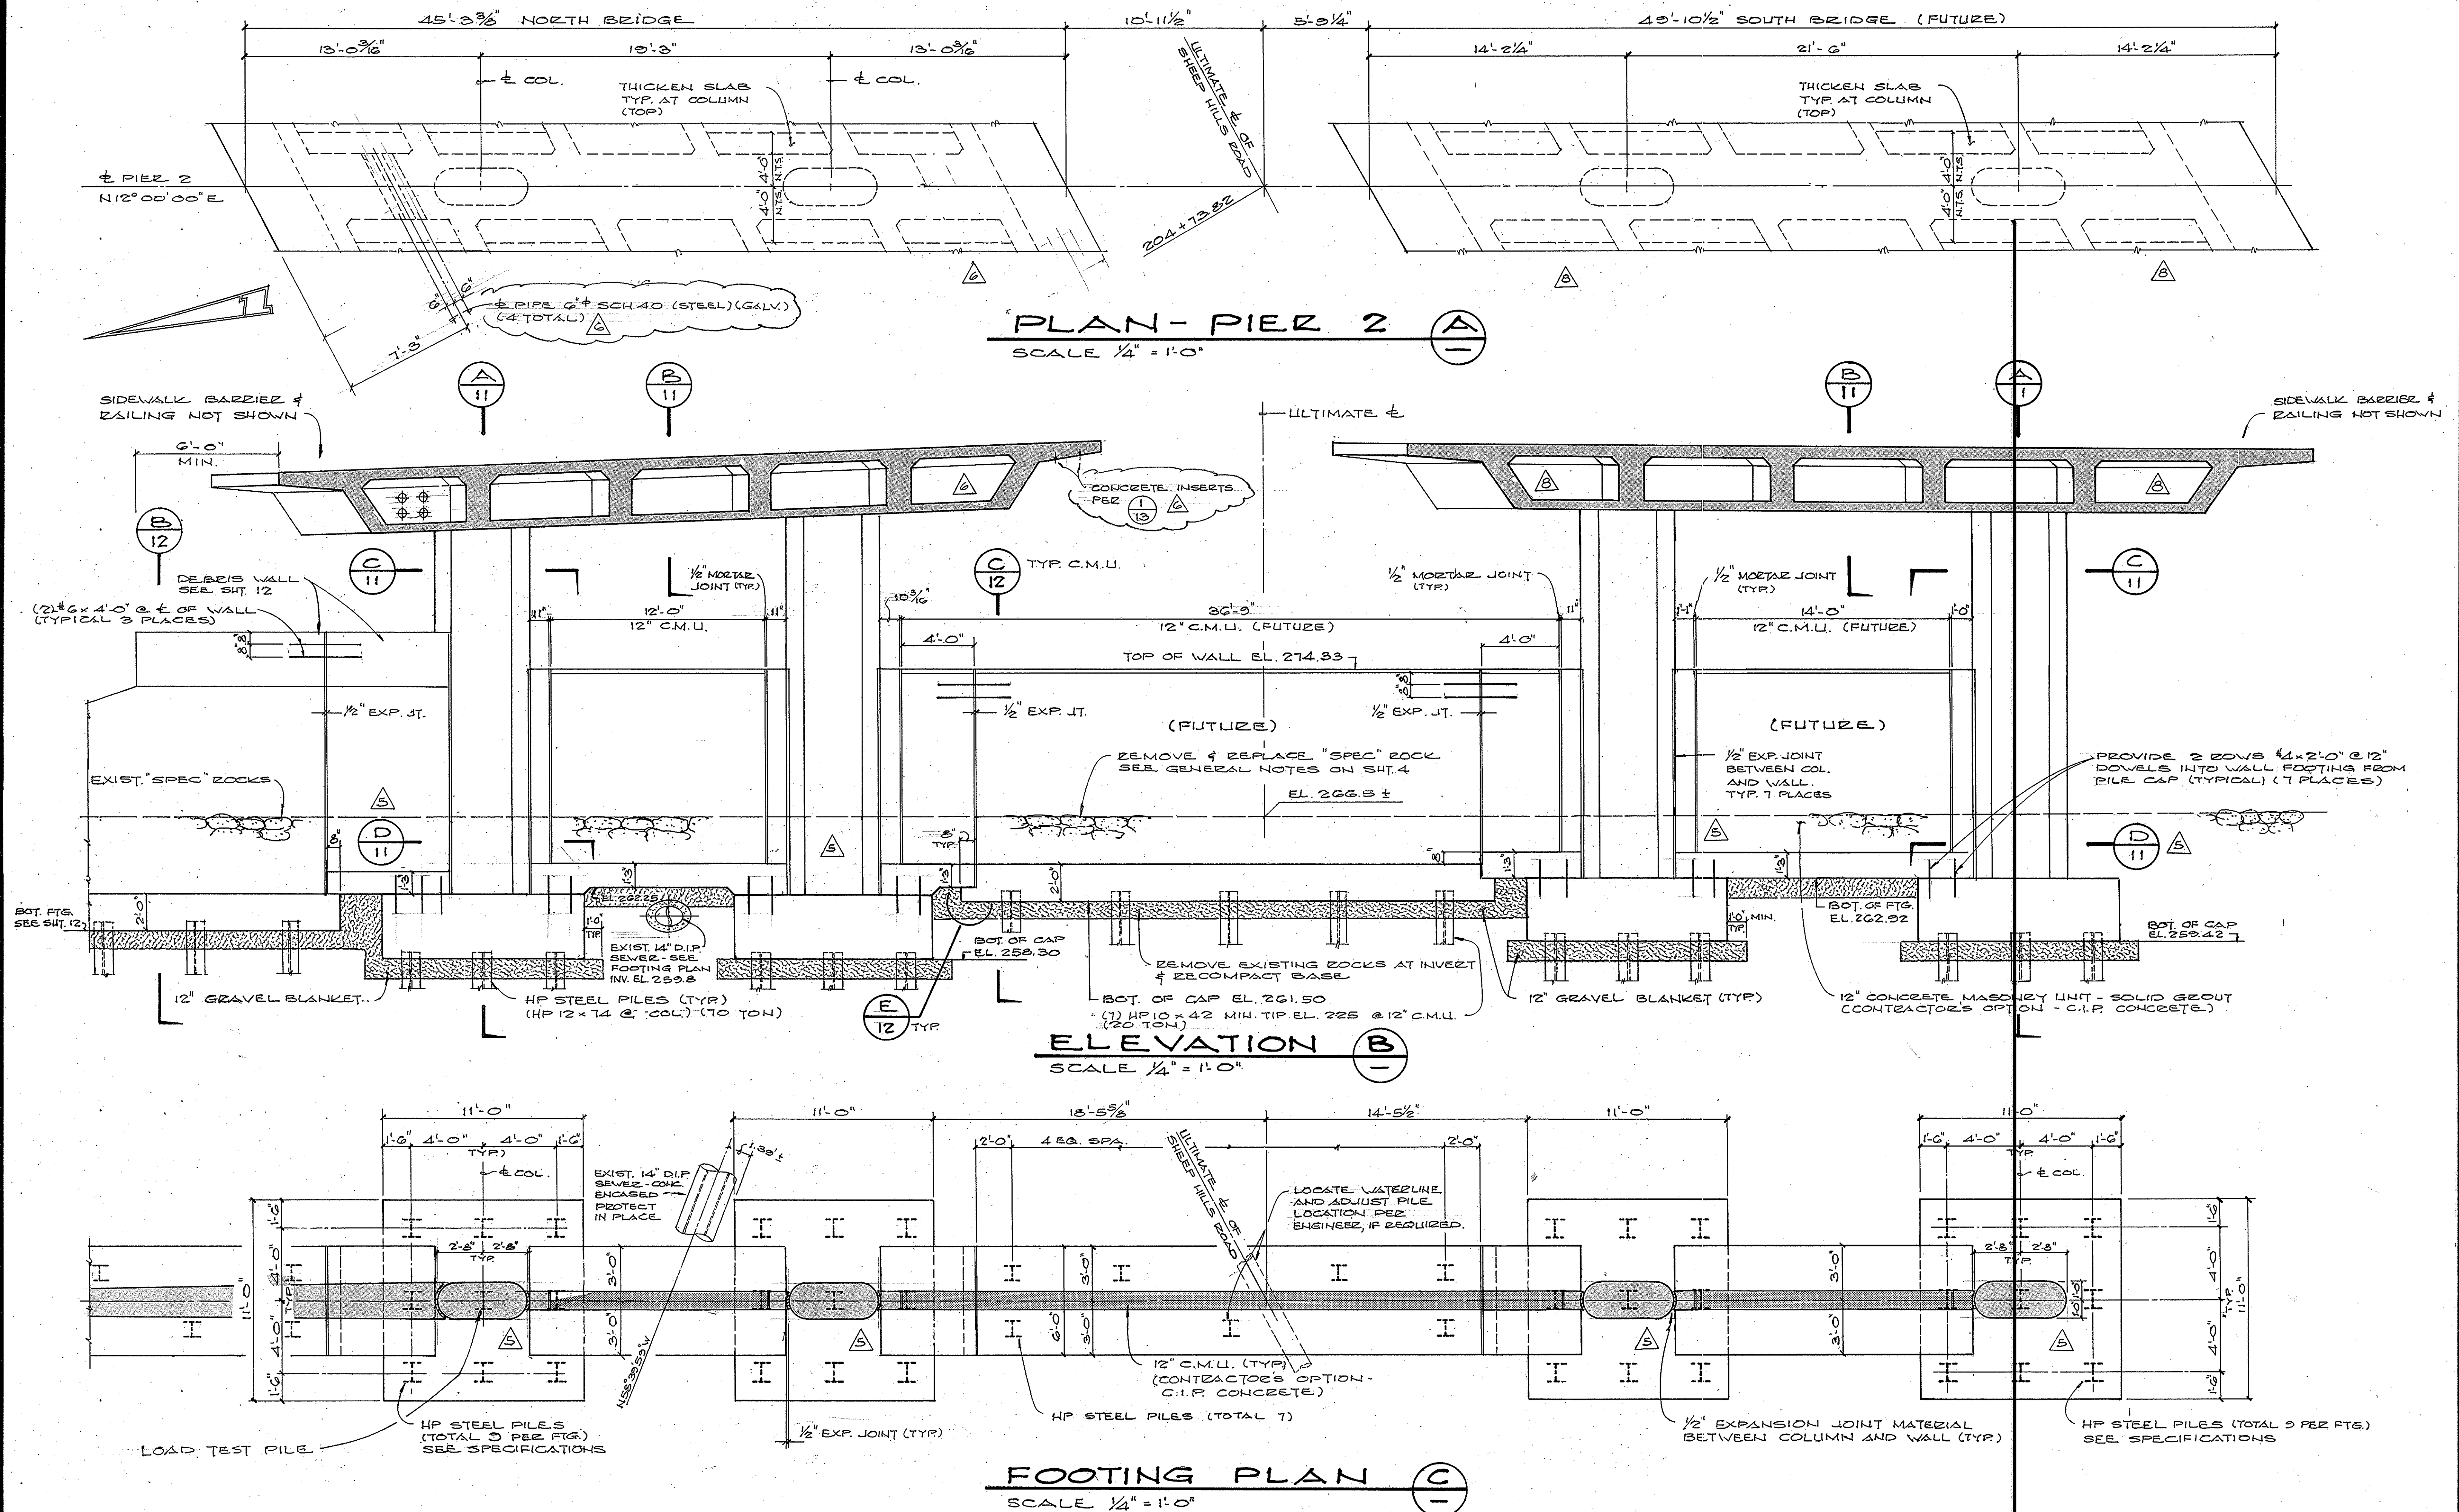

Jack G. Raub Company
Engineering & Planning
24740 Chiverton Drive • Mission Viejo, California 92691 • (714) 859-4948

DATE	BY	REVISION DESCRIPTION	APP'D	DATE	CHK'D M.D.C.	DATE
7/1/88	M.D.C.	DELETE UTILITY OPENINGS @ SOUTH BRIDGE				
7/1/88	M.D.C.	"AS-BUILT"				
7/1/88	M.D.C.	DELETED 10" PIPE SLEEVES ADDED 4" x 24" SLEEVES & CONC. INSECTS - APPROX. 8"				
7/1/88	M.D.C.	DELETED COLUMN RECTANGULAR SECTION				
7/1/88	M.D.C.	COUNTY PLAN COROL CORRECTION				

**PIER 2
PLAN & ELEVATION**

SHEEP HILLS ROAD BRIDGE
ACROSS ALISO CREEK

SHEET
9
OF
17
IN 213040

DR 5 (13985)