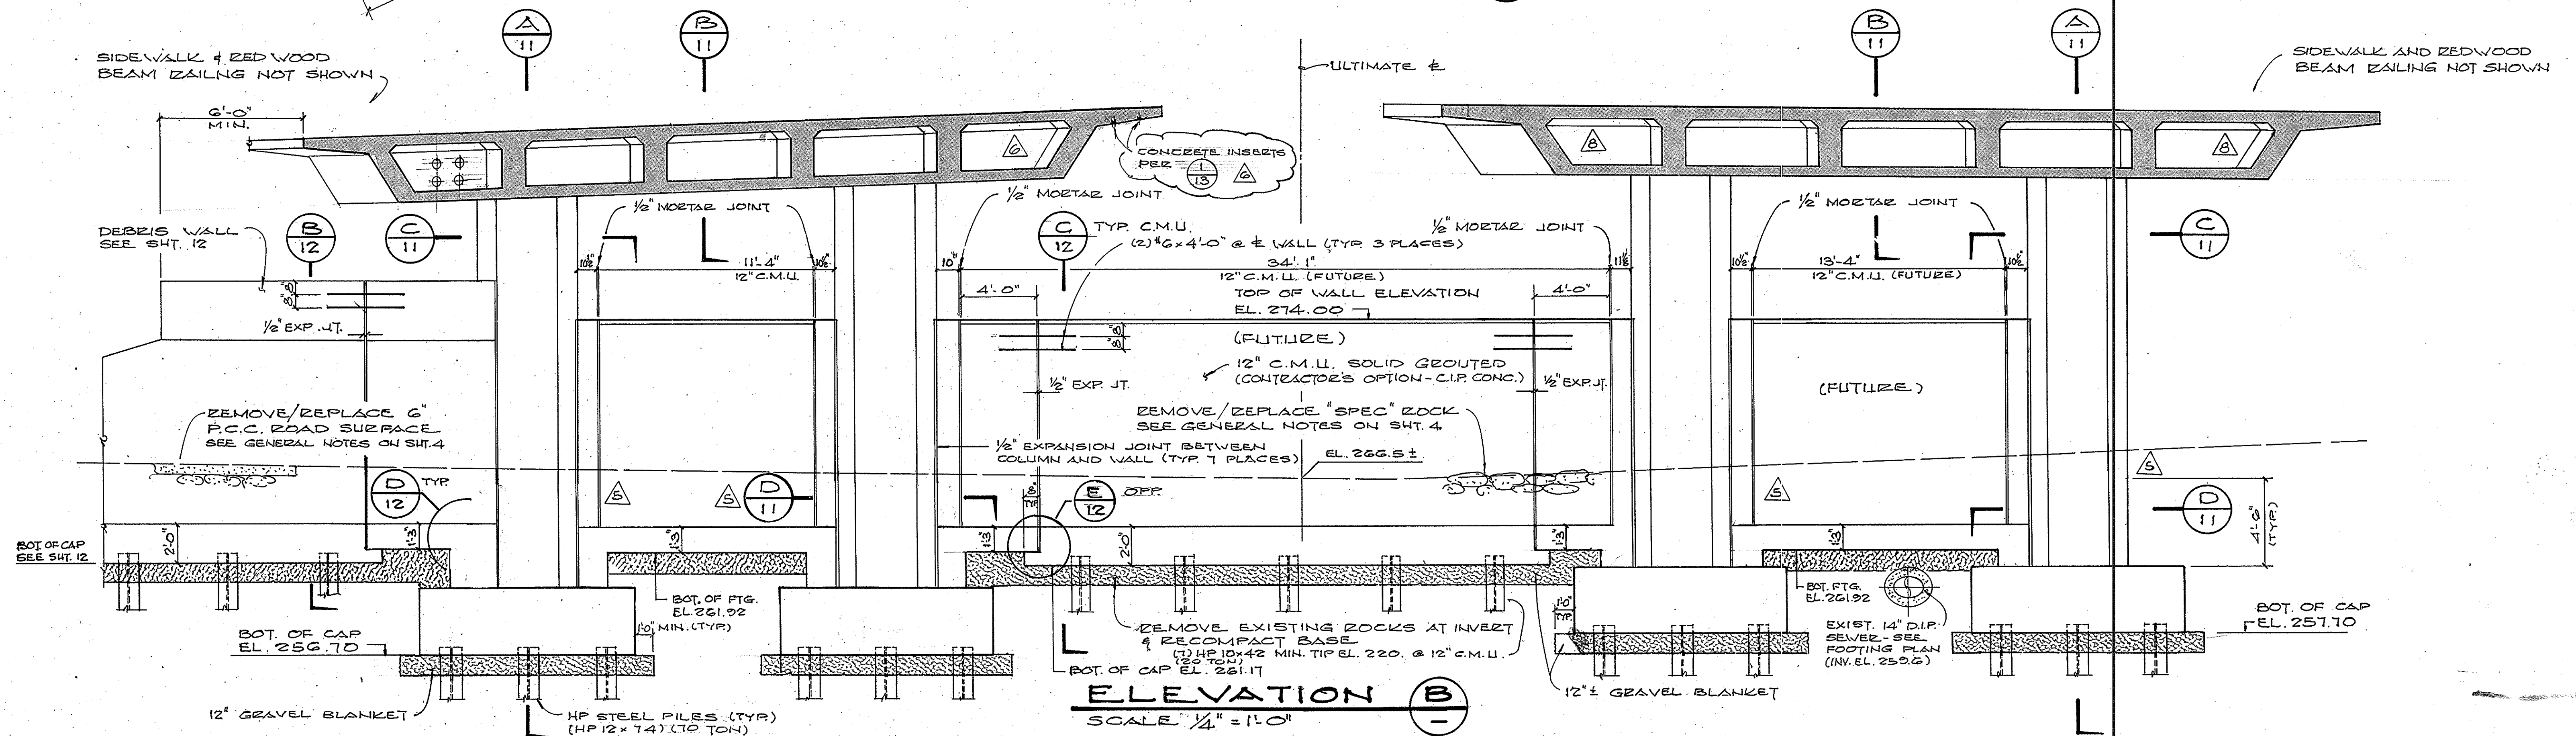
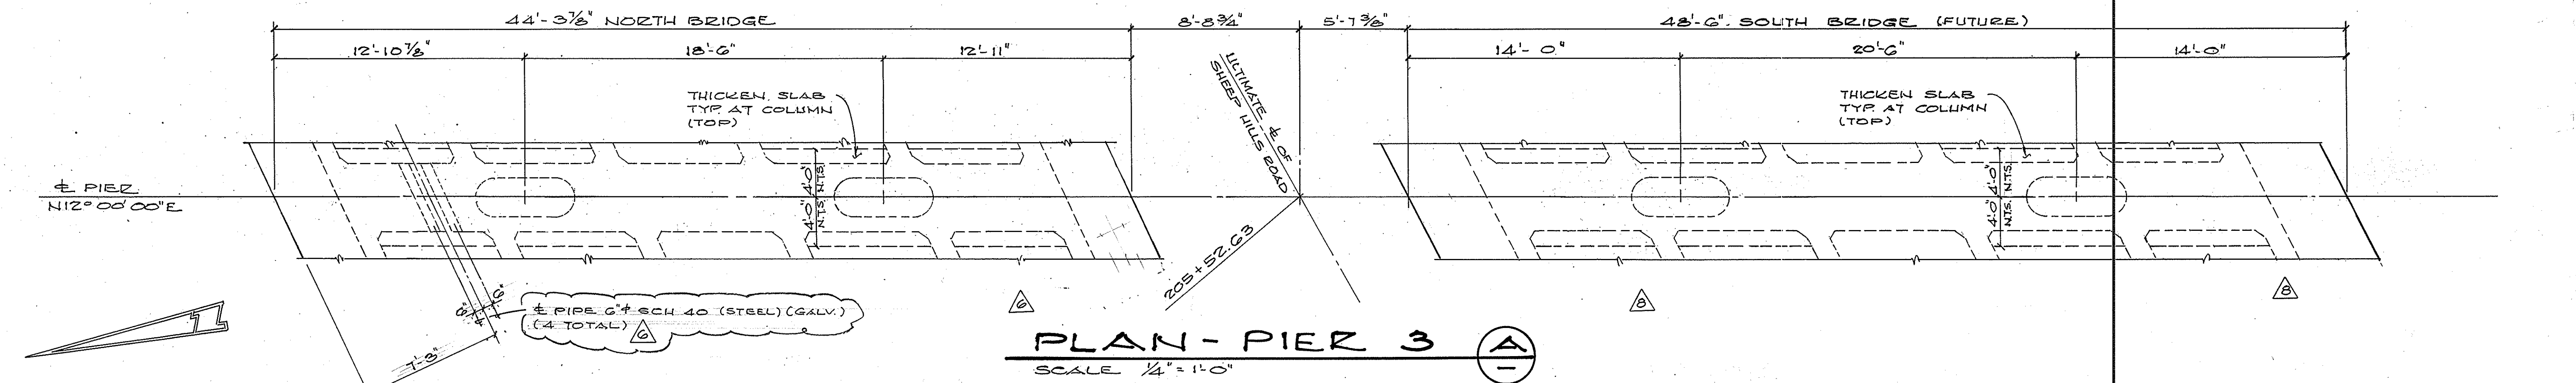


Jack G. Raub Company Engineering & Planning 2400 Chocoma Drive • (Mission Viejo) • California 92691 • (714) 857-4948				PIER 3 PLAN & ELEVATION SHEEP HILLS ROAD BRIDGE ACROSS ALISO CREEK				SHEET 10 OF 17 IN 213040
DATE	BY	REVISION	DESCRIPTION	APP'D	DATE	CHK'D	DATE	DATE
7/1/85	M.D.C.	1	DELETED UTILITY OPENINGS @ SOUTH BRIDGE					
7/1/85	M.P.C.	2	"AS-BUILT"					
7/1/85	M.D.C.	3	DELETED 12" PIPE SLEEVE, ADDED 4" DIA. SLEEVES & CONC. URETERS, APPROX. 82'					
7/1/84	M.D.C.	4	DELETED COLUMN RECTANGULAR SECTION					
7/1/84	M.D.C.	5	COUNTY PLAN CHECK CORRECTION					