
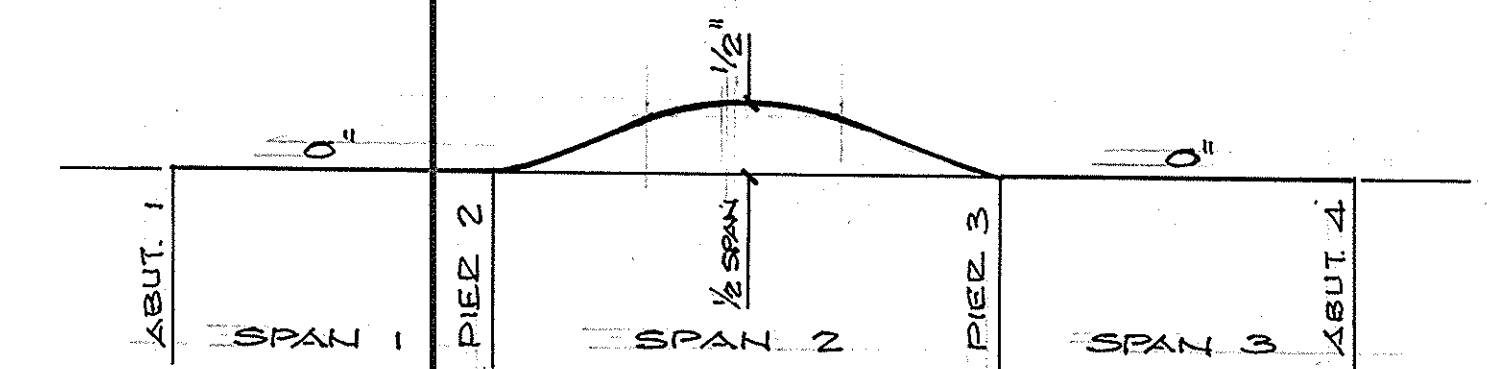


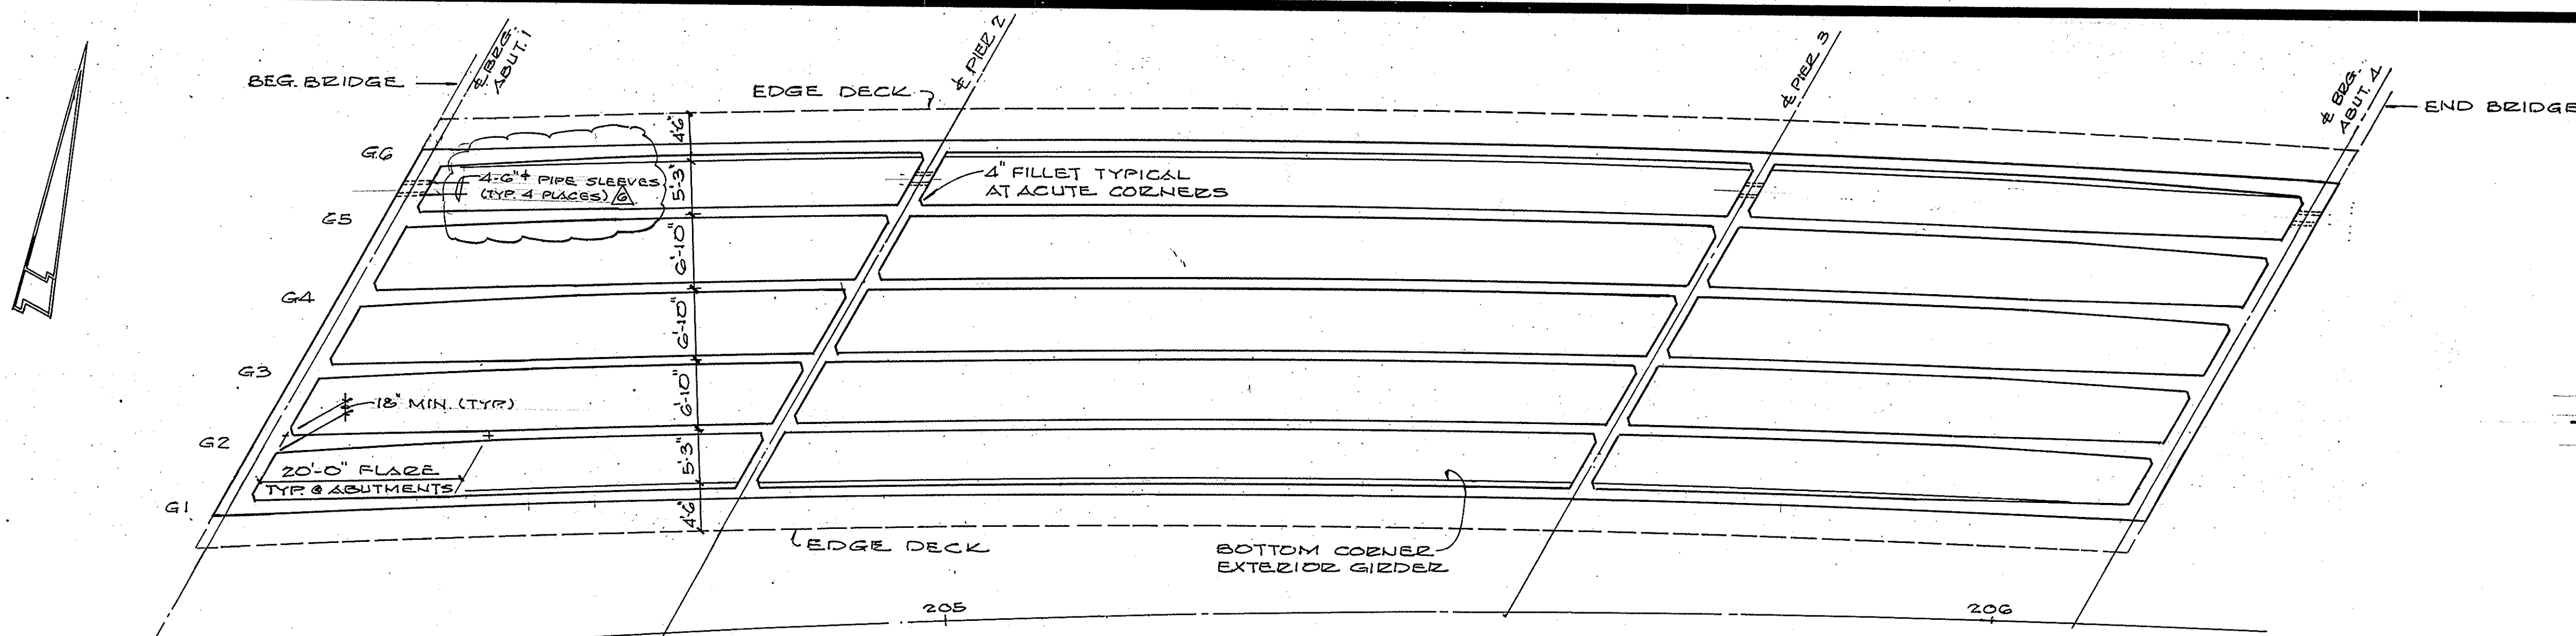


CAMBER DIAGRAM - NORTH & SOUTH BRIDGE

NO SCALE
NOTE:
CAMBER SHOWN DO NOT INCLUDE FALSE WORK SETTLEMENT WHICH SHALL BE ADDED TO THE VALUES NOTED.


PRESTRESSING NOTES

- PRESTRESS LOSSES:
LONG TERM
FRICTION COEFF (MAX VALUE) = 0.001
WOBBLE COEFF (MAX VALUE) = 0.20
ANCHOR SET (MAX VALUE) = 5/8 INCH
- JACKING FORCE BEFORE LOSSES:
NORTH BRIDGE = 5022 KIPS TOTAL (LOW LAX STRAND)
SOUTH BRIDGE = 6100 KIPS TOTAL
- $F_{ci} = 4000$ PSI $F_{ci} = 3500$ PSI
- UNLESS OTHERWISE NOTED ON THE DRAWING, PRESTRESSING FORCES SHALL BE DISTRIBUTED WITH AN APPROXIMATELY EQUAL AMOUNT IN EACH STEM AND SHALL BE PLACED SYMMETRICALLY ABOUT THE CENTERLINE OF THE STRUCTURE.
- MILD STEEL REINFORCEMENTS INTERFERING WITH THE PRESTRESSING TENDON SHALL BE ADJUSTED IN ORDER TO CLEAR. THE REARRANGEMENTS OF ALL STEEL SHALL BE SHOWN ON THE SHOP DRAWING AND REVIEWED BY ENGINEER.
- GIRDER STEMS SHALL BE FLARED NEAR ANCHORAGES TO PROVIDE A MINIMUM OF 1 1/2 INCH CONCRETE COVER OVER THE DUCTS. FLARE MAY BE ON ONE SIDE AT THE EXTERIOR STEMS.
- PLACE DUCT TIES AS SHOWN ON DETAIL 7 OF SHEET 15 AT LOCATION WHERE DUCT CHANGES HORIZONTAL DIRECTION.
- THE SHOP DRAWING FOR GIRDER SHALL INCLUDE INFORMATION FOR ALIGNMENT OF ALL PRESTRESS TENDON AND MILD STEEL REINFORCEMENTS, ACCOMPANIED WITH SET OF CALCULATION OF ALL LOSSES AND INDICATE THEREIN THE EFFECTIVE PRESTRESS FORCE OVERALL AT EVERY 10TH POINT ALONG EACH SPAN.
- PRESTRESSING SEQUENCE:
NO MORE THAN 1/2 OF THE PRESTRESSING FORCE IN ANY STEM SHALL BE STRESSED BEFORE AN EQUAL FORCE IS STRESSED IN THE ADJACENT STEM. AT NO TIME DURING THE STRESSING OPERATIONS SHALL MORE THAN 1/6 OF THE TOTAL PRESTRESSING FORCE BE APPLIED ECCENTRICALLY ABOUT THE CENTERLINE OF THE STRUCTURE.
TENDONS SHALL BE STRESSED FROM BOTH ENDS OF THE STRUCTURE.
10% OF TENDON LIFTOFF SHALL BE REQUIRED. STRANDS WILL BE SELECTED BY ENGINEER WHEN JACKINGS ARE COMPLETE.

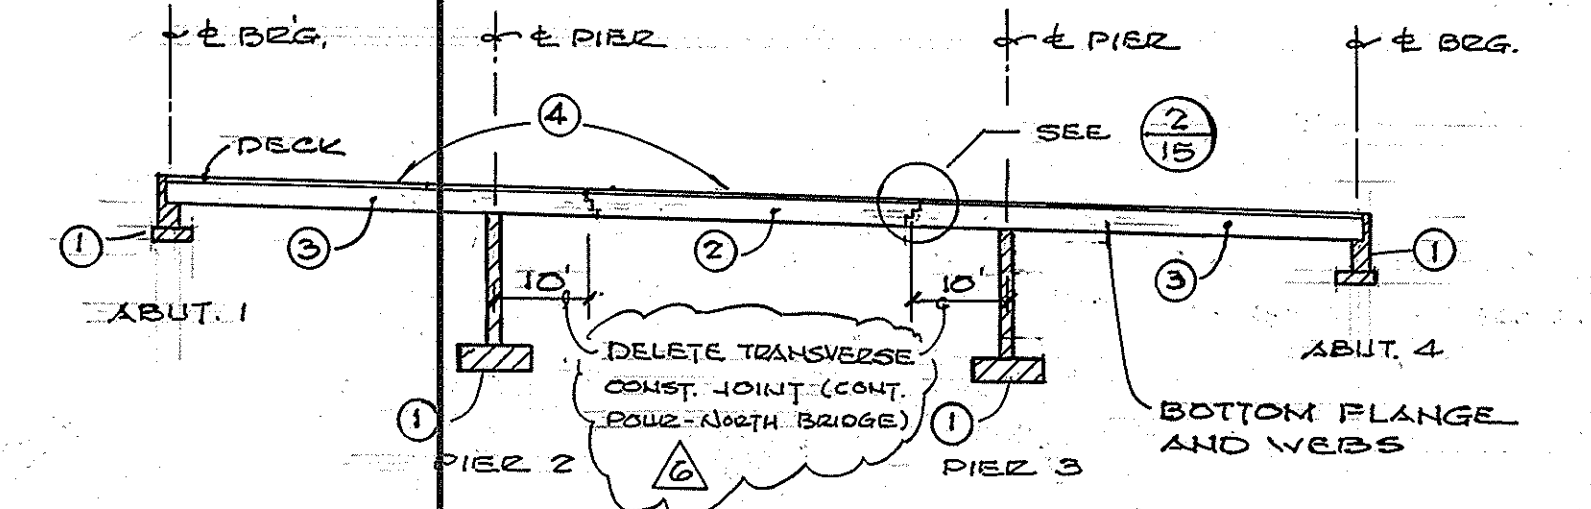


CONCRETE PLACING SEQUENCE

N.T.S. TYPICAL NORTH & SOUTH BRIDGE

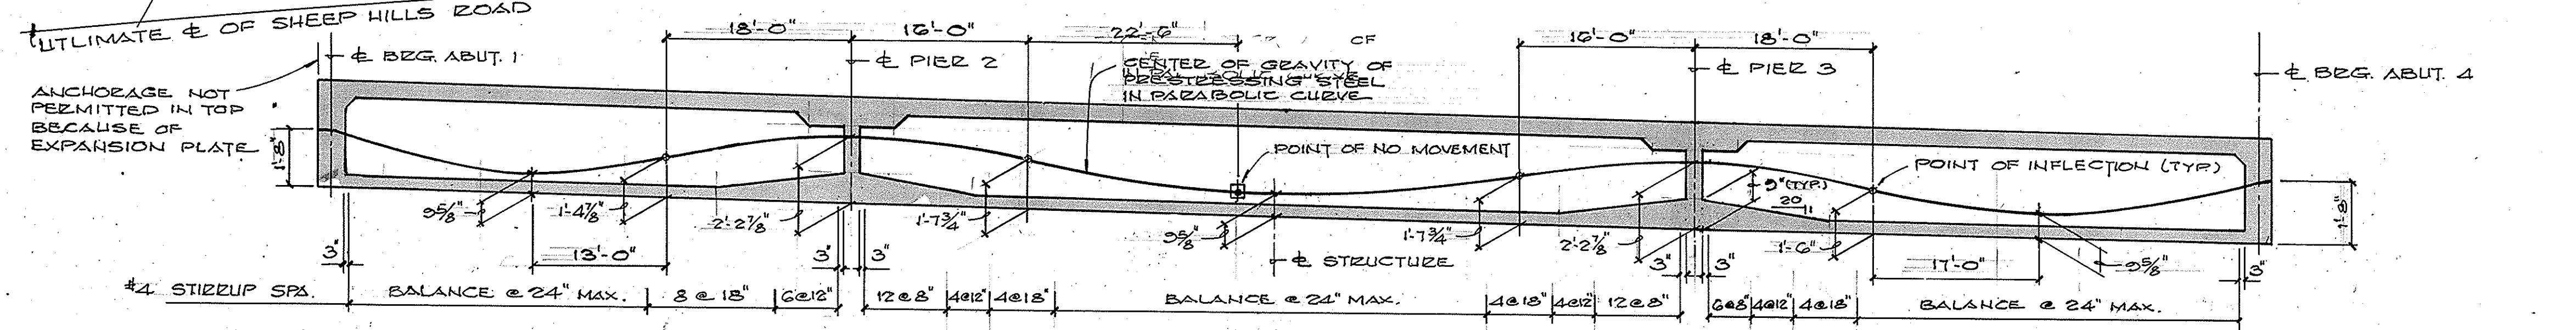

GIRDER LAYOUT PLAN & LONGITUDINAL SECTION - NORTH BRIDGE

SCALE: PLAN 1"=10' LONGITUDINAL SECTION - HORIZ. 1"=10' VERT. 1/4"=1'-0"

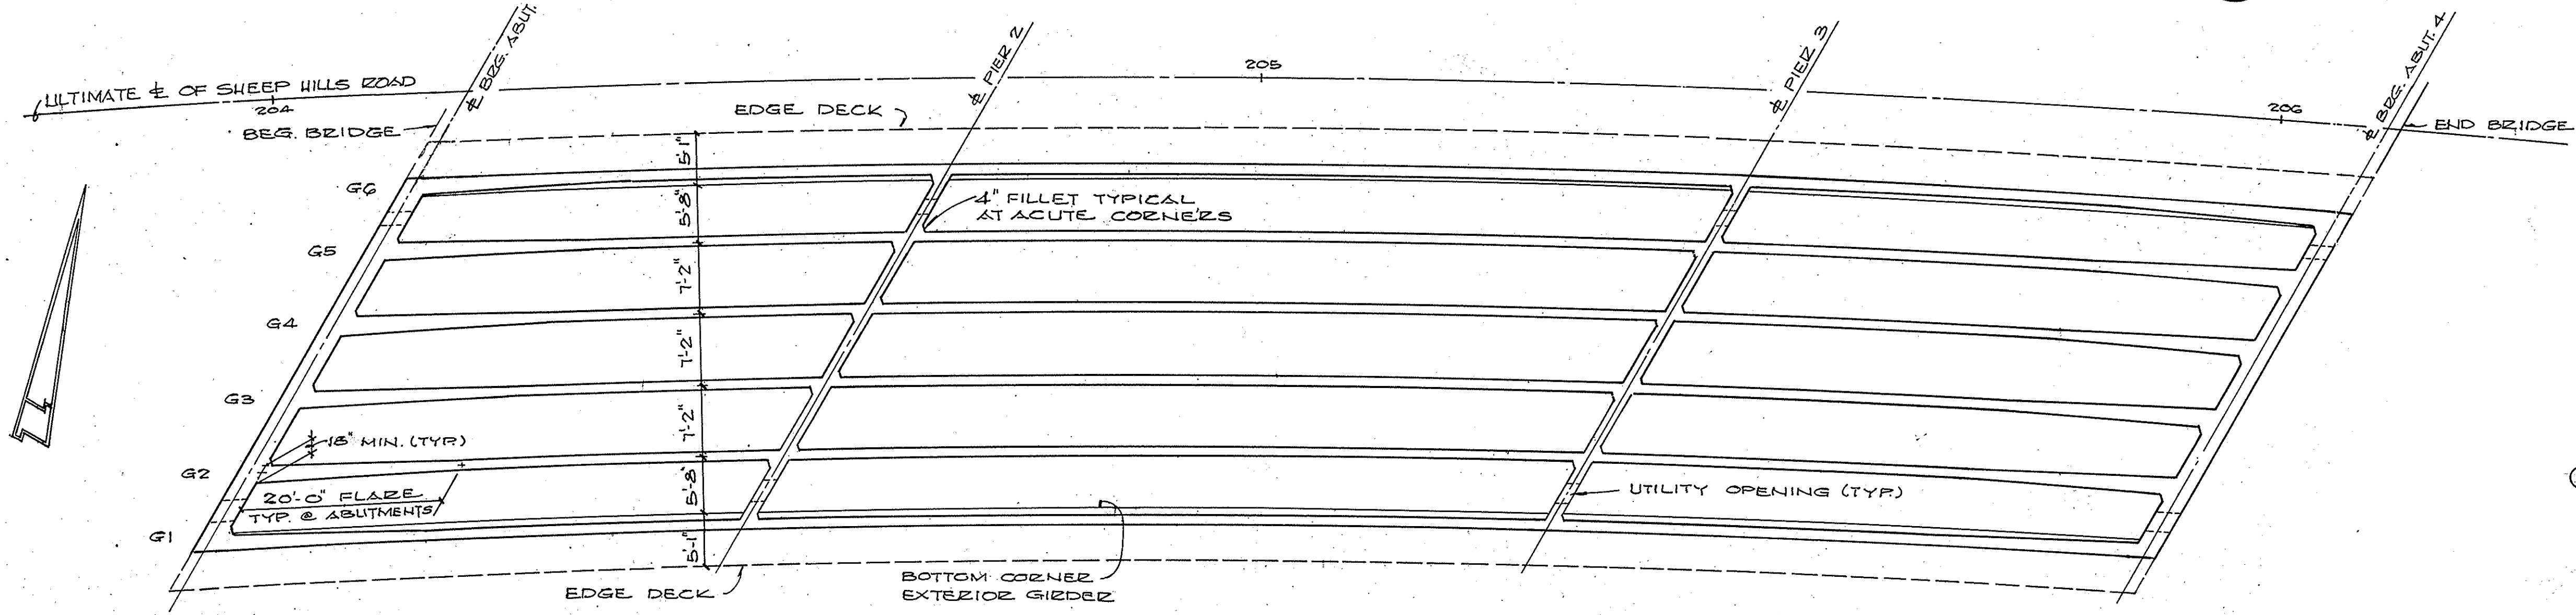

GIRDER LAYOUT PLAN & LONGITUDINAL SECTION - SOUTH BRIDGE

SCALE: PLAN 1"=10' LONGITUDINAL SECTION - HORIZ. 1"=10' VERT. 1/4"=1'-0"



Jack G. Raub Company
Engineering & Planning
2400 Ontario Drive • (Mission Viejo) • California 92691 • (714) 859-4248

--	--	
PLAN SCALE	SHEET
GIRDER LAYOUT & PROFILE	14
SHEEP HILLS ROAD BRIDGE ACROSS ALISO CREEK	OF 17
	IN 213040