


DESIGNED	DRAWN	CHECKED	APPROVED
DATE	INITIAL		

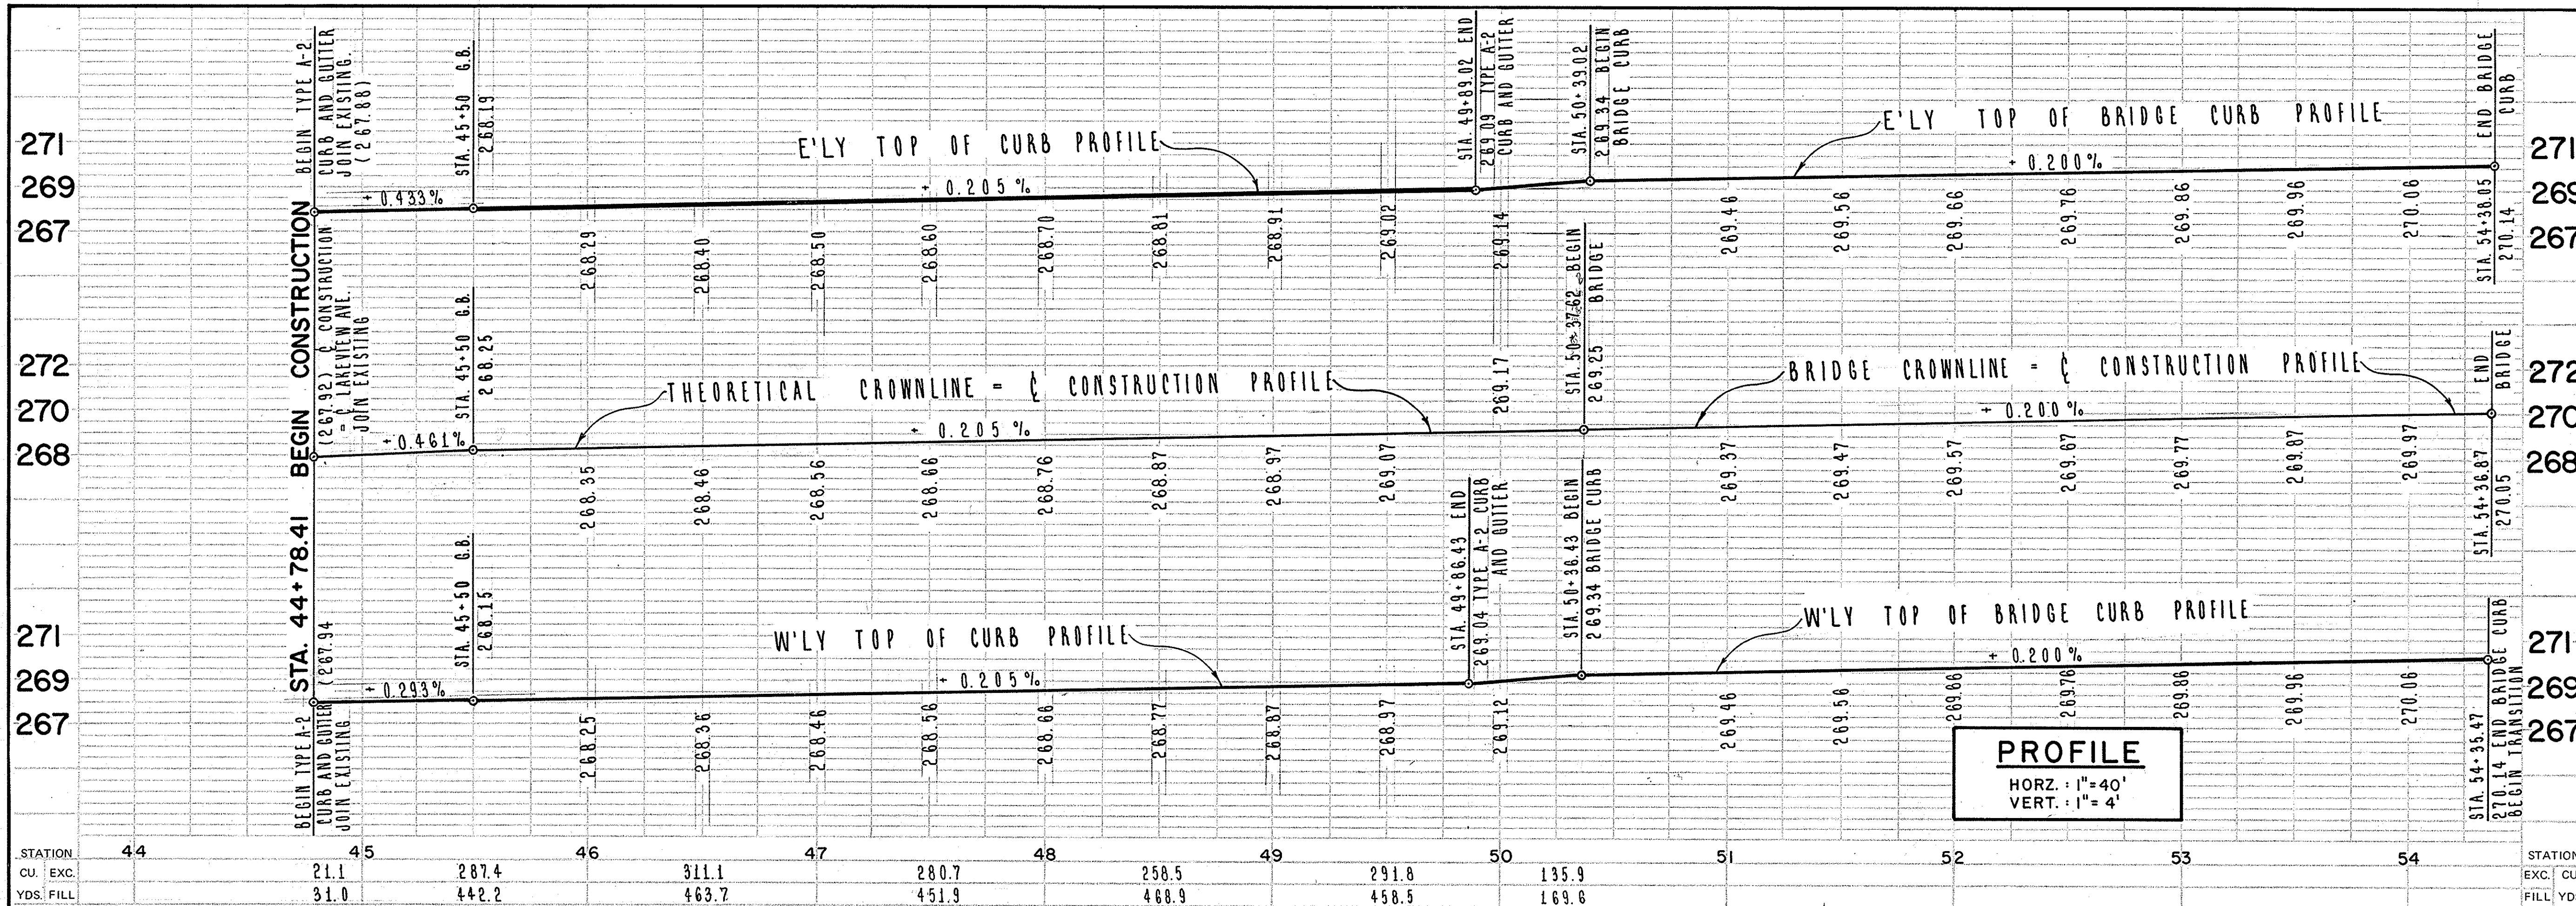


CONSTRUCTION NOTES

1. REMOVE AND SALVAGE 550 L.F. EXISTING CHAIN LINK FENCE. SEE SPECIAL PROVISIONS.
2. INSTALL 550 L.F. CHAIN LINK FENCE PER O.C.E.M.A. STD. PLAN # 412.
3. CONSTRUCT 6' WIDE P.C.C. SIDEWALK PER O.C.E.M.A. STD. PLAN # 205.
4. CONSTRUCT TYPE A-2 CURB AND GUTTER PER O.C.E.M.A. STD. PLAN # 202.
5. REMOVE EXISTING PADDLE BOARD.
6. REMOVE AND SALVAGE EXIST. METAL BEAM GUARD RAIL. SEE SPECIAL PROVISIONS.
7. CONSTRUCT 0.60' DEEP LIFT A.C. OVER N.S.
8. PROTECT IN PLACE.
9. RESURFACE EXIST. PAVEMENT WITH VARIABLE THICKNESS A.C. OVERLAY.
10. FEATHER FOR SMOOTH JOIN.
11. REMOVE EXISTING PAVEMENT.
12. GRADE AND RECONSTRUCT EXIST. LEVEE ACCESS ROAD TO JOIN EXISTING.
13. TRANSITION CURB FROM TYPE A-2 CURB AND GUTTER TO BRIDGE CURB.
14. RELOCATE 28 L.F. OF EXIST. METAL BEAM GUARD RAIL. SEE SHEET #5.
15. REMOVE EXISTING DEPRESSED CURB DRIVEWAY APPROACH AND RECONSTRUCT PER O.C.E.M.A. STD. PLAN # 209.

AS BUILT NOTES

1. CONSTRUCTED 3" A.C./N.S. BIKE TRAIL TO JOIN EXISTING.

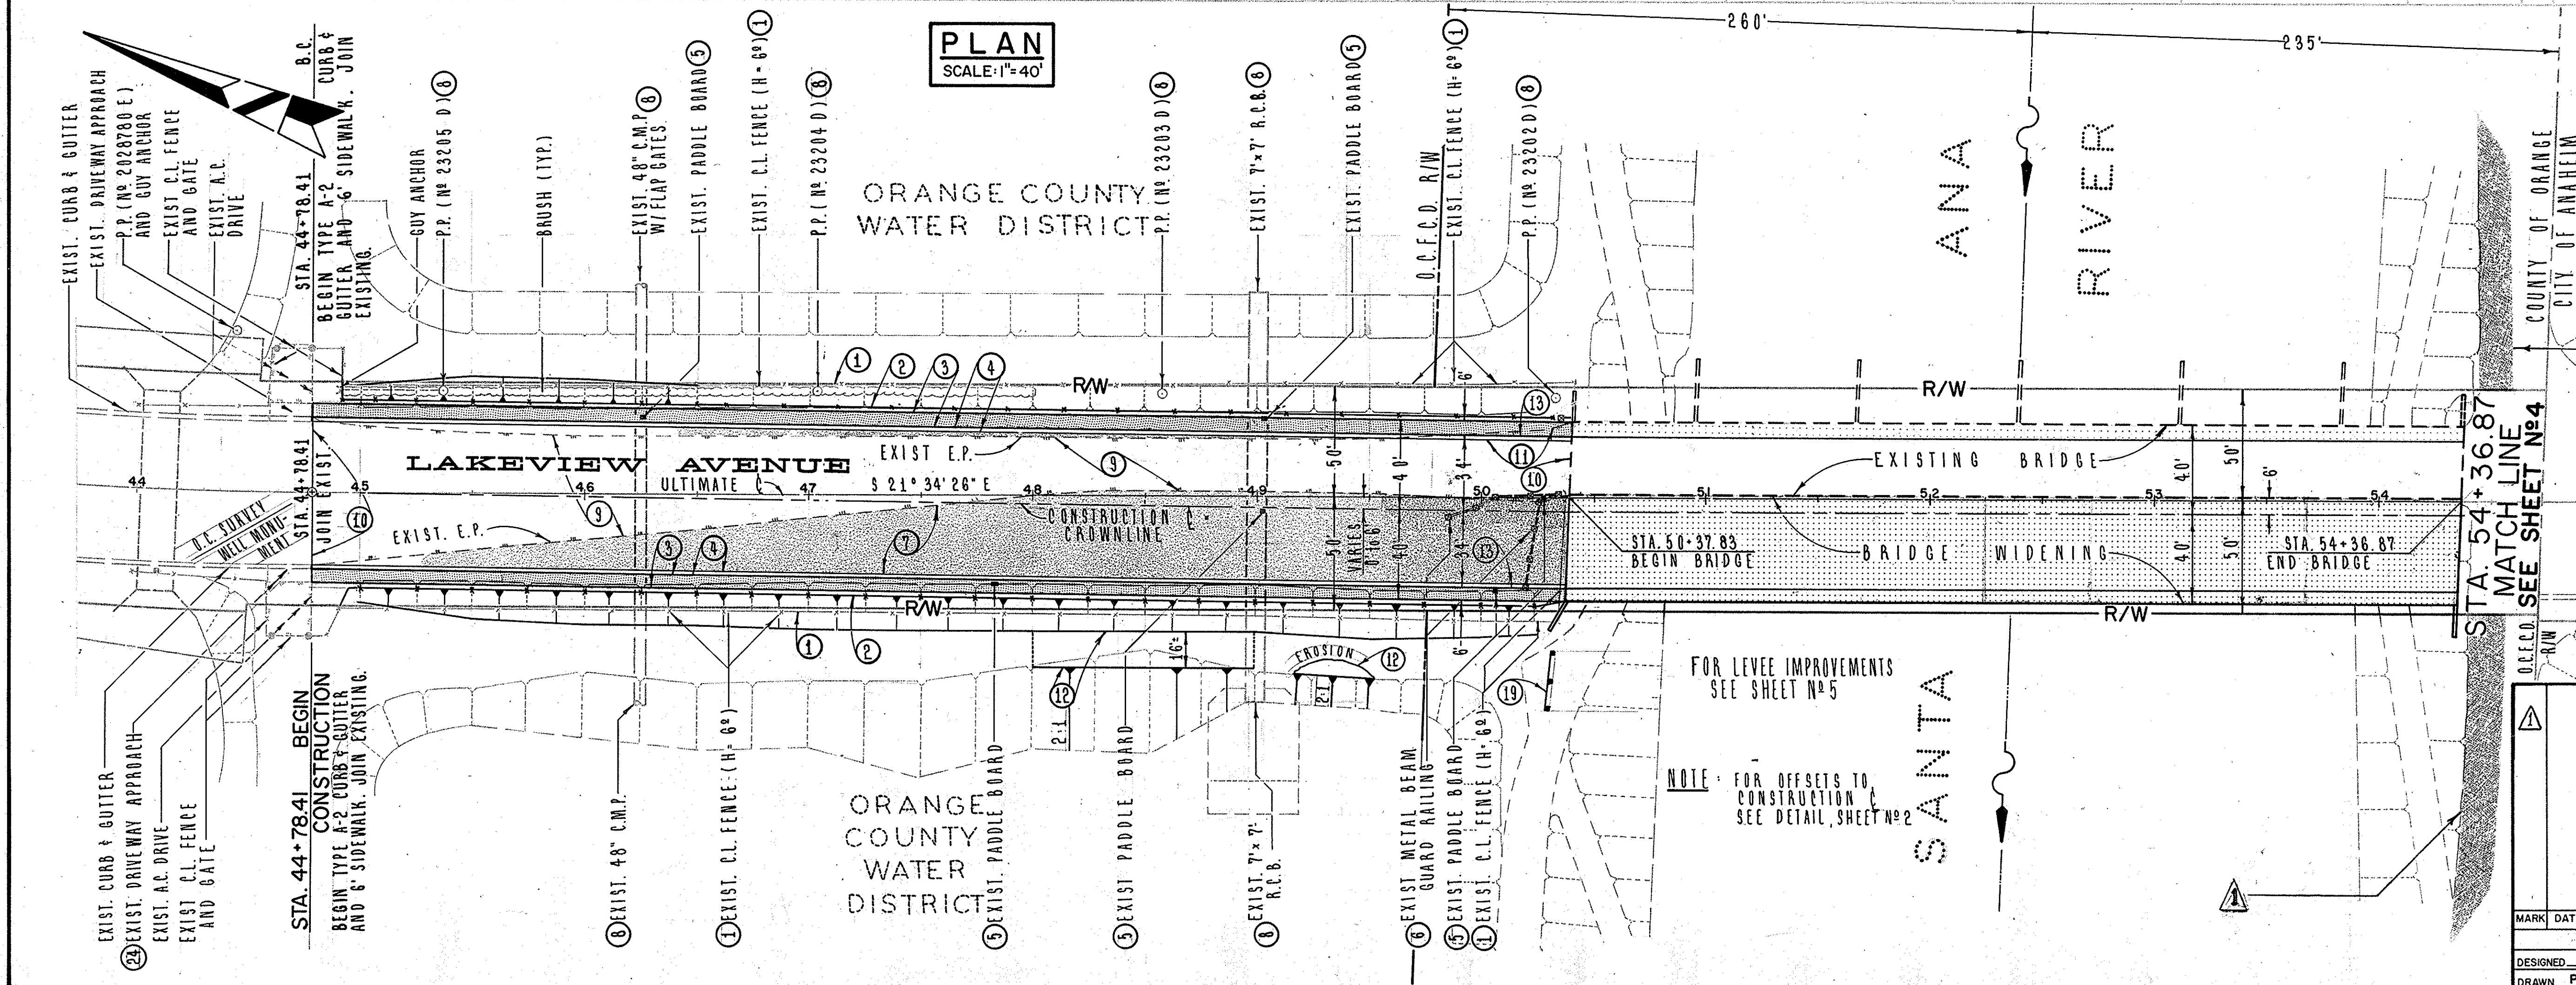

1 1/2 0 1 2
3 inches on original drawing

AS BUILT		ORANGE COUNTY ENVIRONMENTAL MANAGEMENT AGENCY	
WIDENING OF LAKEVIEW AVENUE		to STA. 44+78.41 STA. 50+37.83	
MARK	DATE	DESCRIPTION	PREPARED UNDER SUPERVISION OF
DESIGNED	GENE W. FOSTER	DATE	3/78
DRAWN	P. J. S.	CHECKED	AS SHOWN
SCALE		DATE	DWG. NO.
1" = 40'		MARCH 1978	
SHEET		OF	22

DR. #10 (12730)