
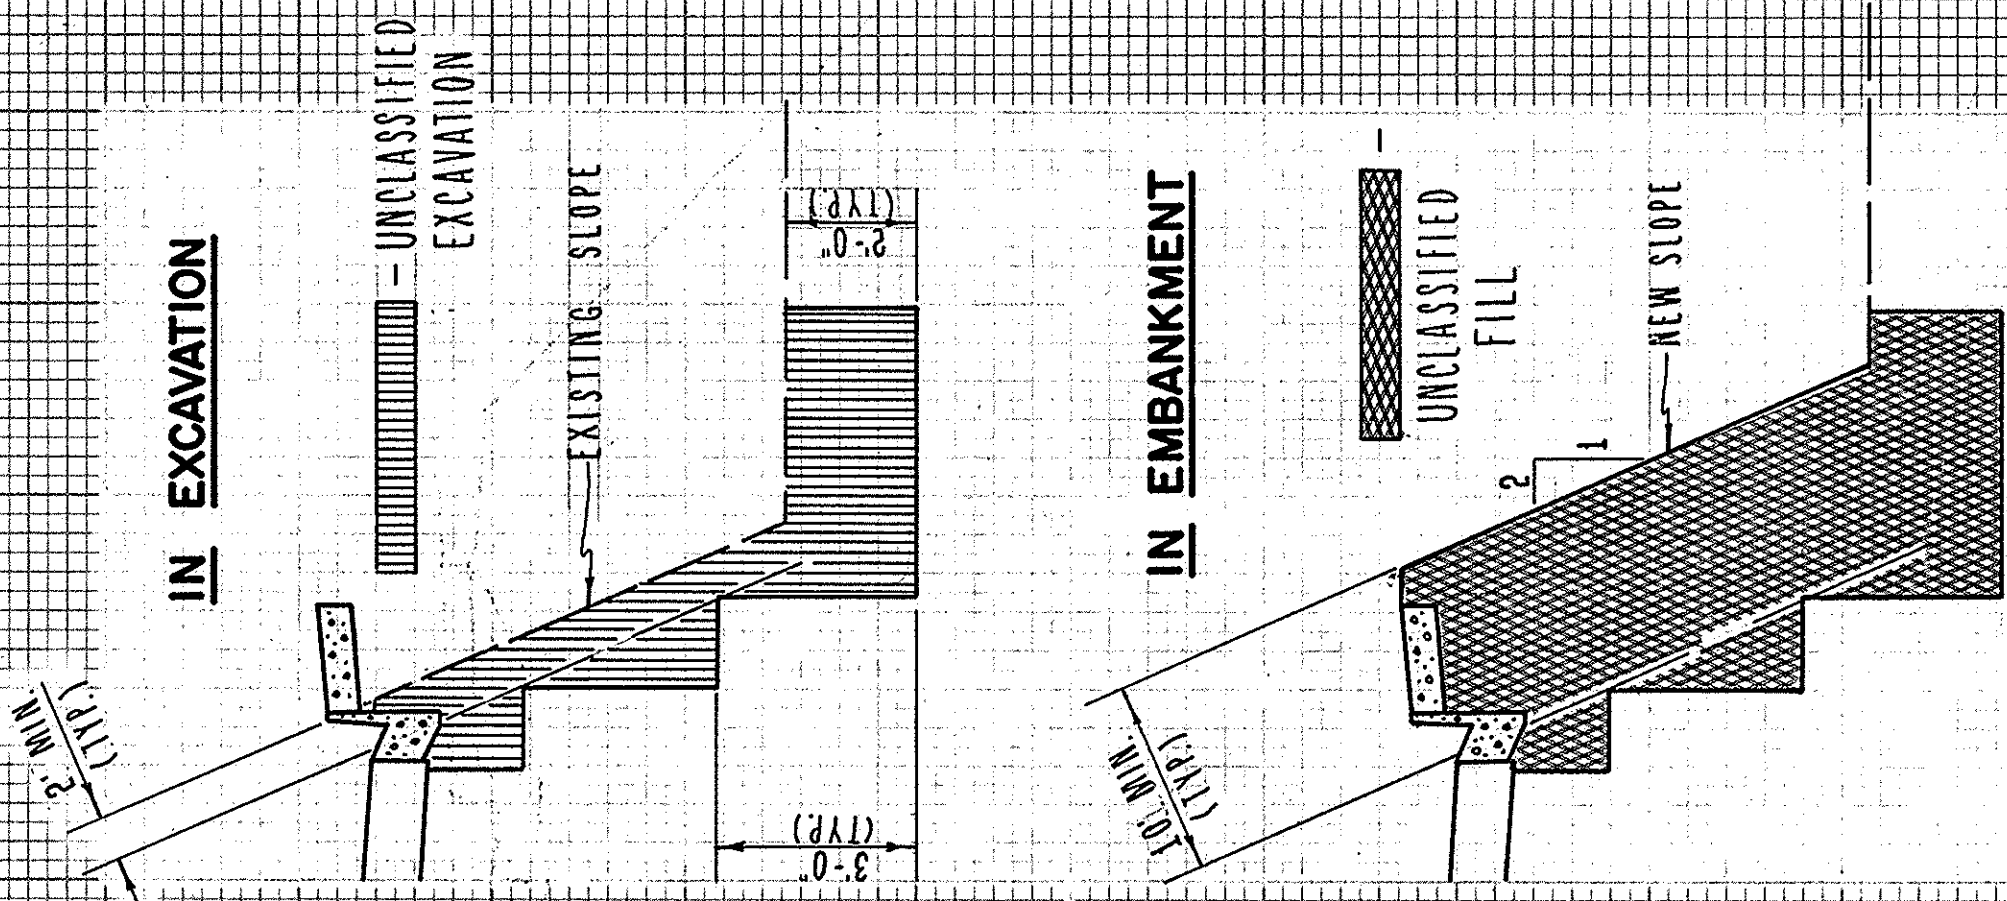


FINAL SURVEY	BY	DATE
SURVEYED	P J S	NOV 77
PLOTTED		
NOTE BOOK		
AREAS CHECKED		
NO.		

ORIGINAL SURVEY	BY	DATE
SURVEYED		
PLOTTED		
NOTE BOOK		
AREAS CHECKED		
NO.		

ORANGE COUNTY ENVIRONMENTAL MANAGEMENT AGENCY	
LAKEVIEW AVE. BRIDGE (SA-6) WIDENING OVER SANTA ANA RIVER (EOI)	
X-SECTIONS LAKEVIEW AVE. STA. 44+78.41 THRU 48+50	
MARK	DATE
DESCRIPTION	PREPARED UNDER SUPERVISION OF <i>M.A. Murphy</i> 3/78
DESIGNED GENE W FOSTER	DATE
DRAWN KKP	CHECKED <i>[Signature]</i> AS SHOWN
SCALE	DATE MARCH 1978
DWG. NO.	SHEET 6 OF 22

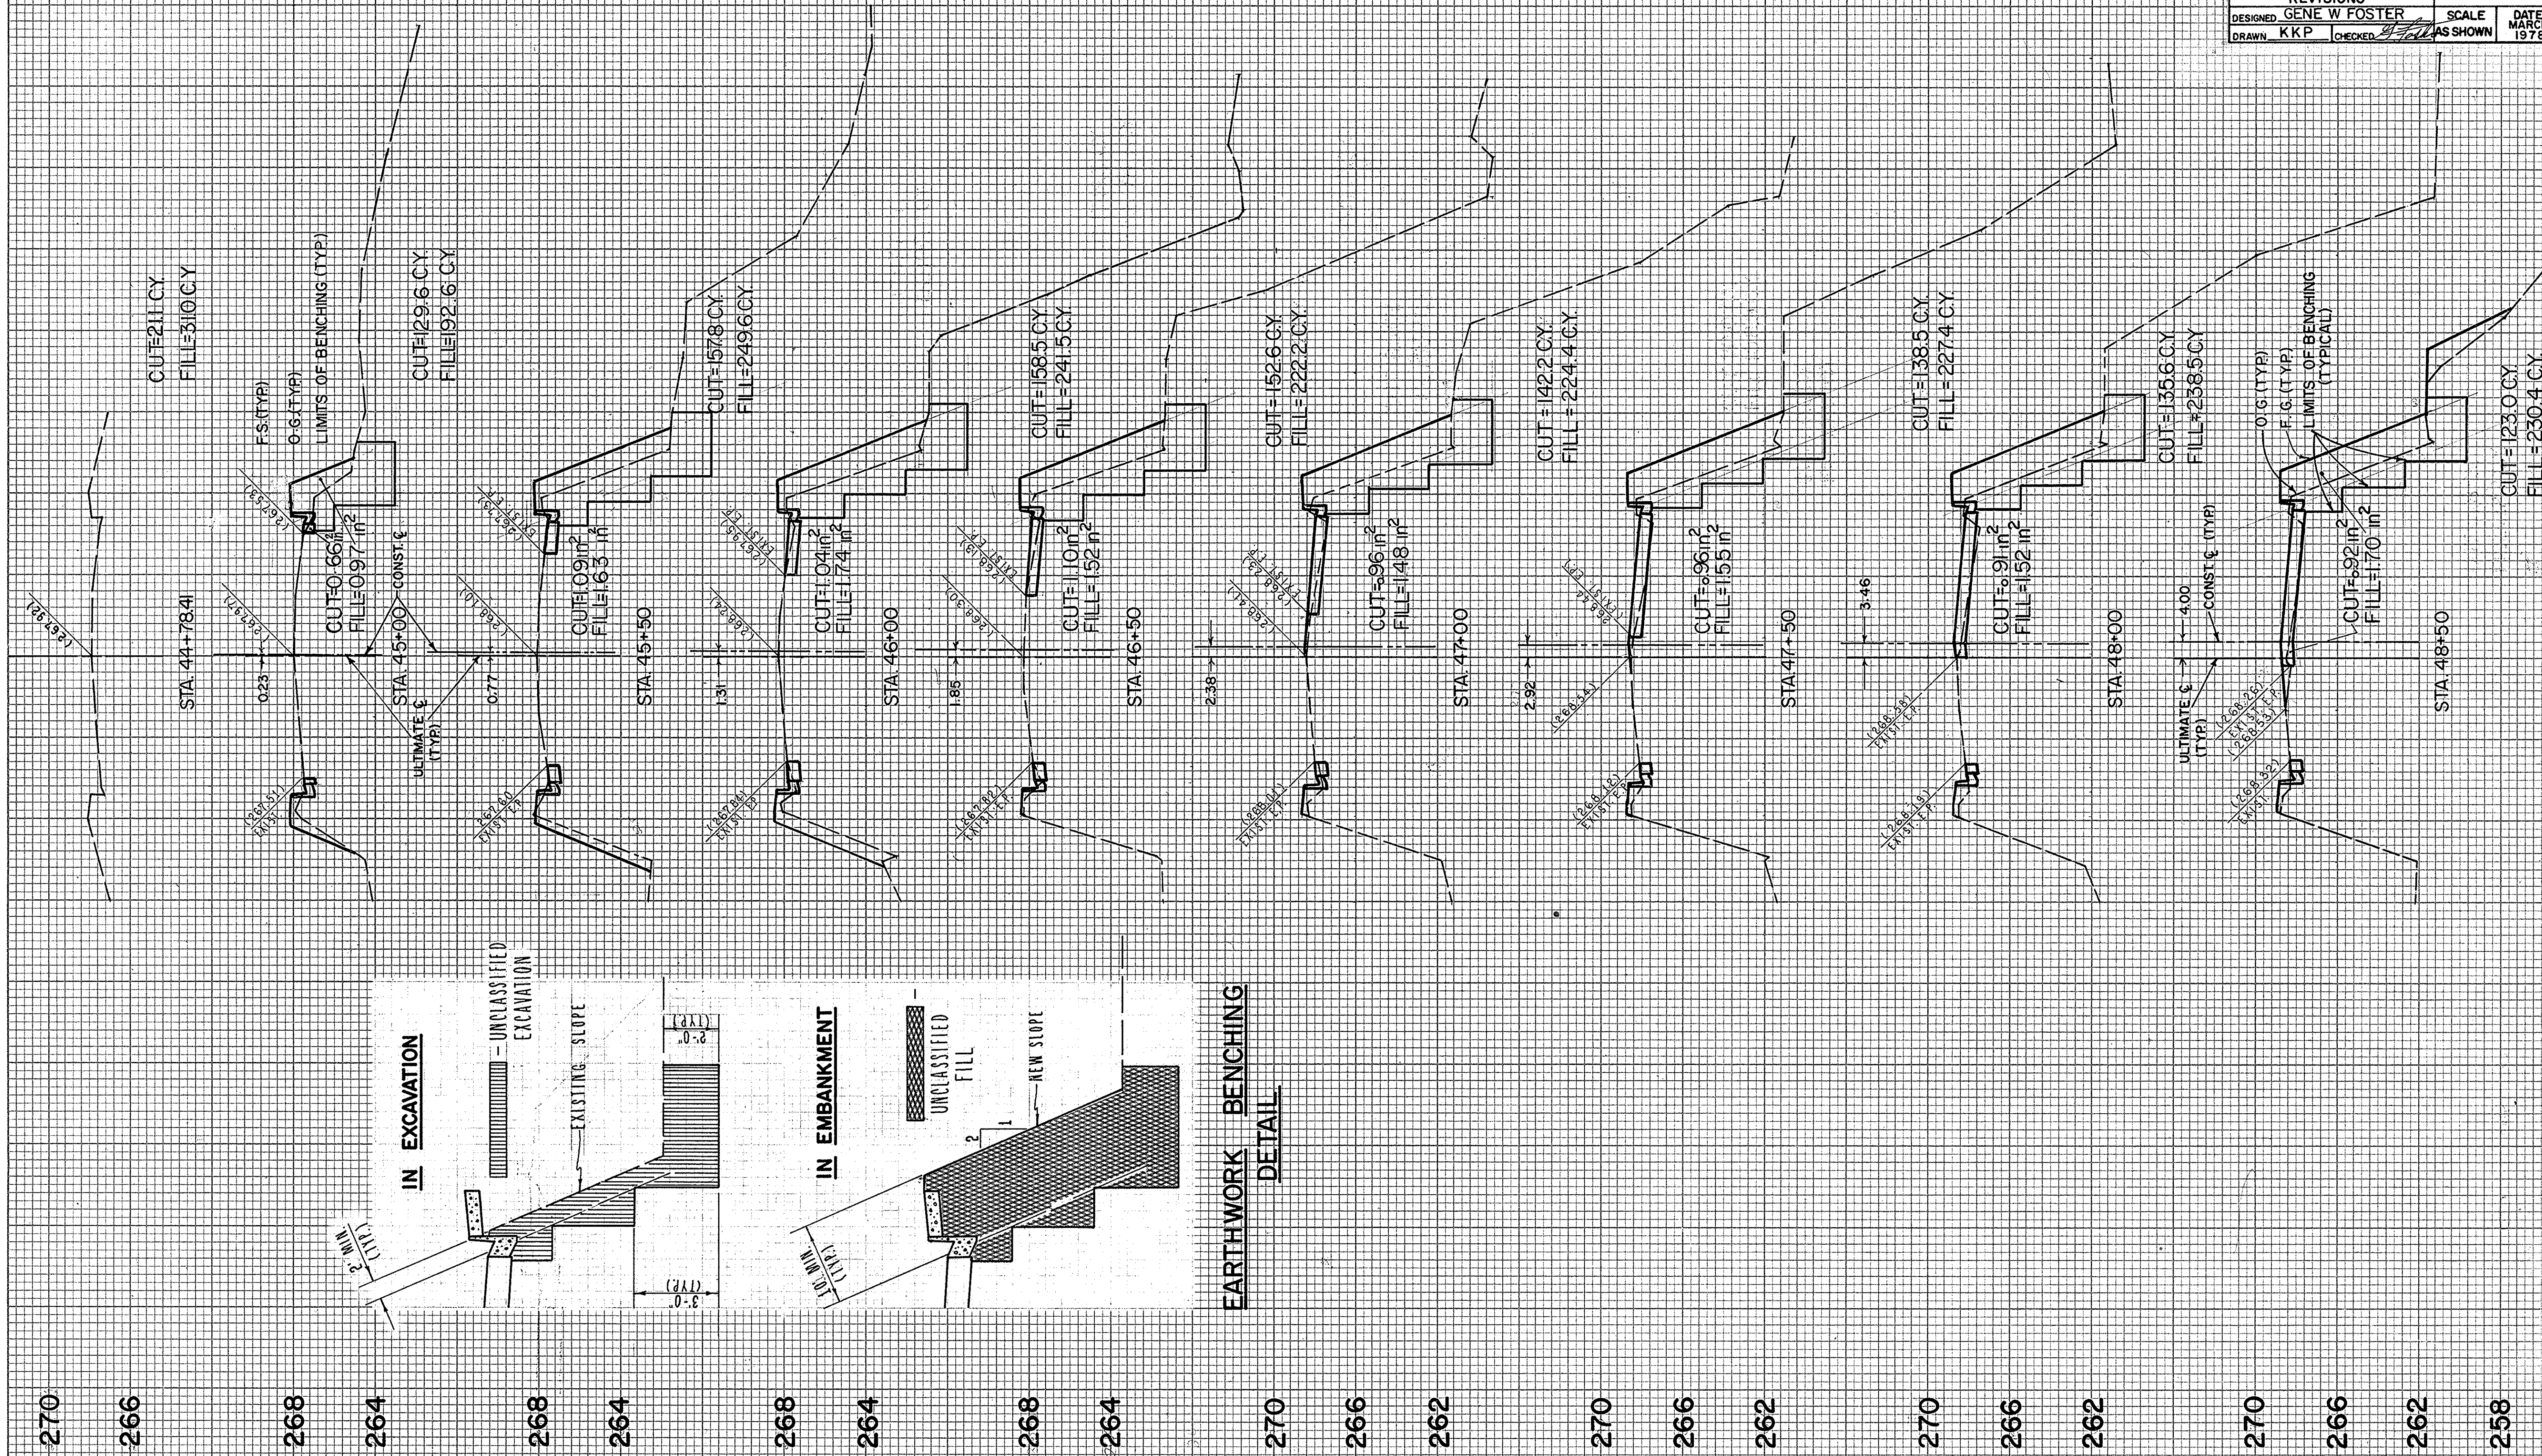

**EARTHWORK BENCHING
DETAIL**

SCALE
HORIZ. 1"=20'-0"
VERT. 1"=4'-0"

12730
Lakeview Ave. Bridge
Sheet 6 of 22
Red. 24:1
Cross Section