


ORIGINAL SURVEY	BY	DATE
SURVEYED		
PLOTTED		
TEMPLATE		
NOTE BOOK		
AREAS		
AREAS CHECKED		
NO.		

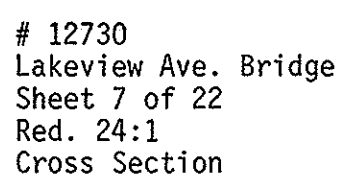

K+E PLATE 3, CROSS SECTION
KEUFFEL & ESSER CO.
48 7056 MADE IN U.S.A.*