


ORIGINAL SURVEY		BY	DATE
SURVEYED			
PLOTTED			
NOTE BOOK			
TEMPLATE			
AREAS			
AREAS CHECKED			
NO.			

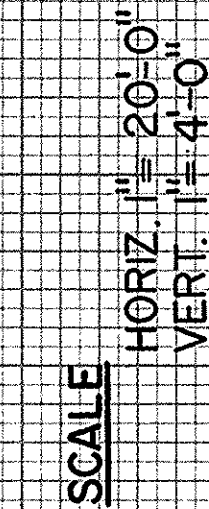

12730
Lakeview Ave. Bridge
Sheet 8 of 22
Red. 24:1
Cross Section