
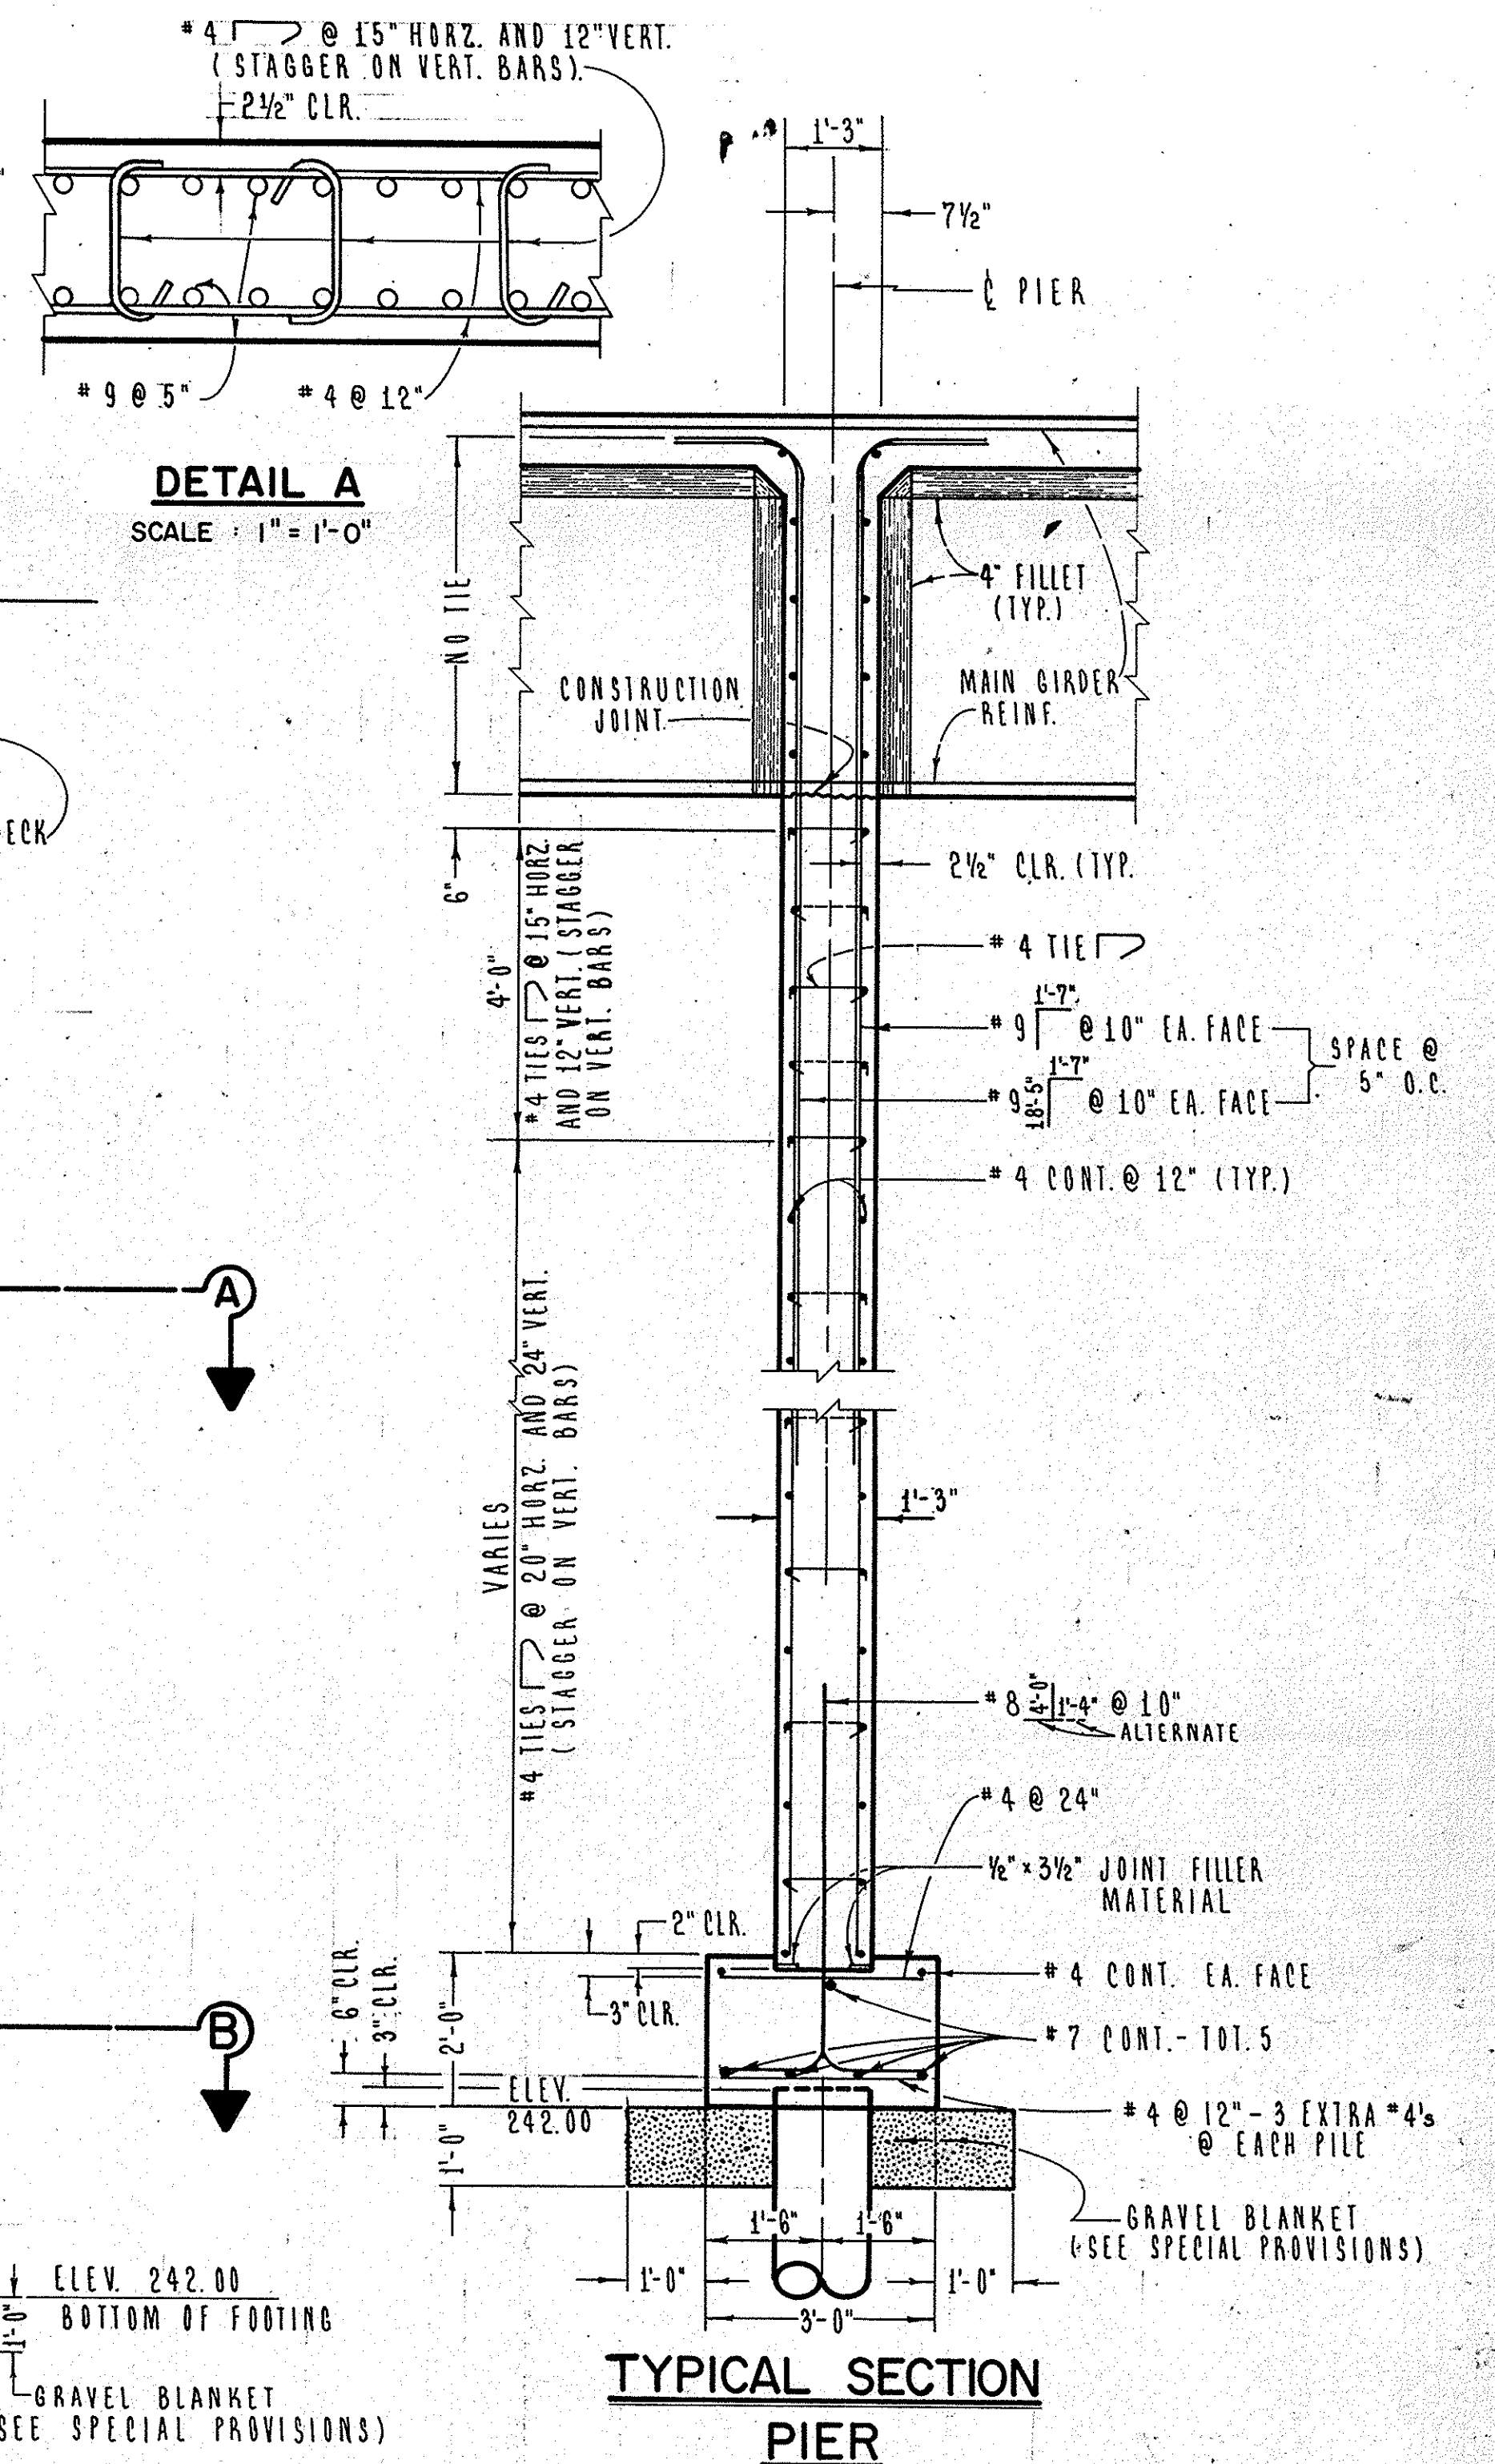


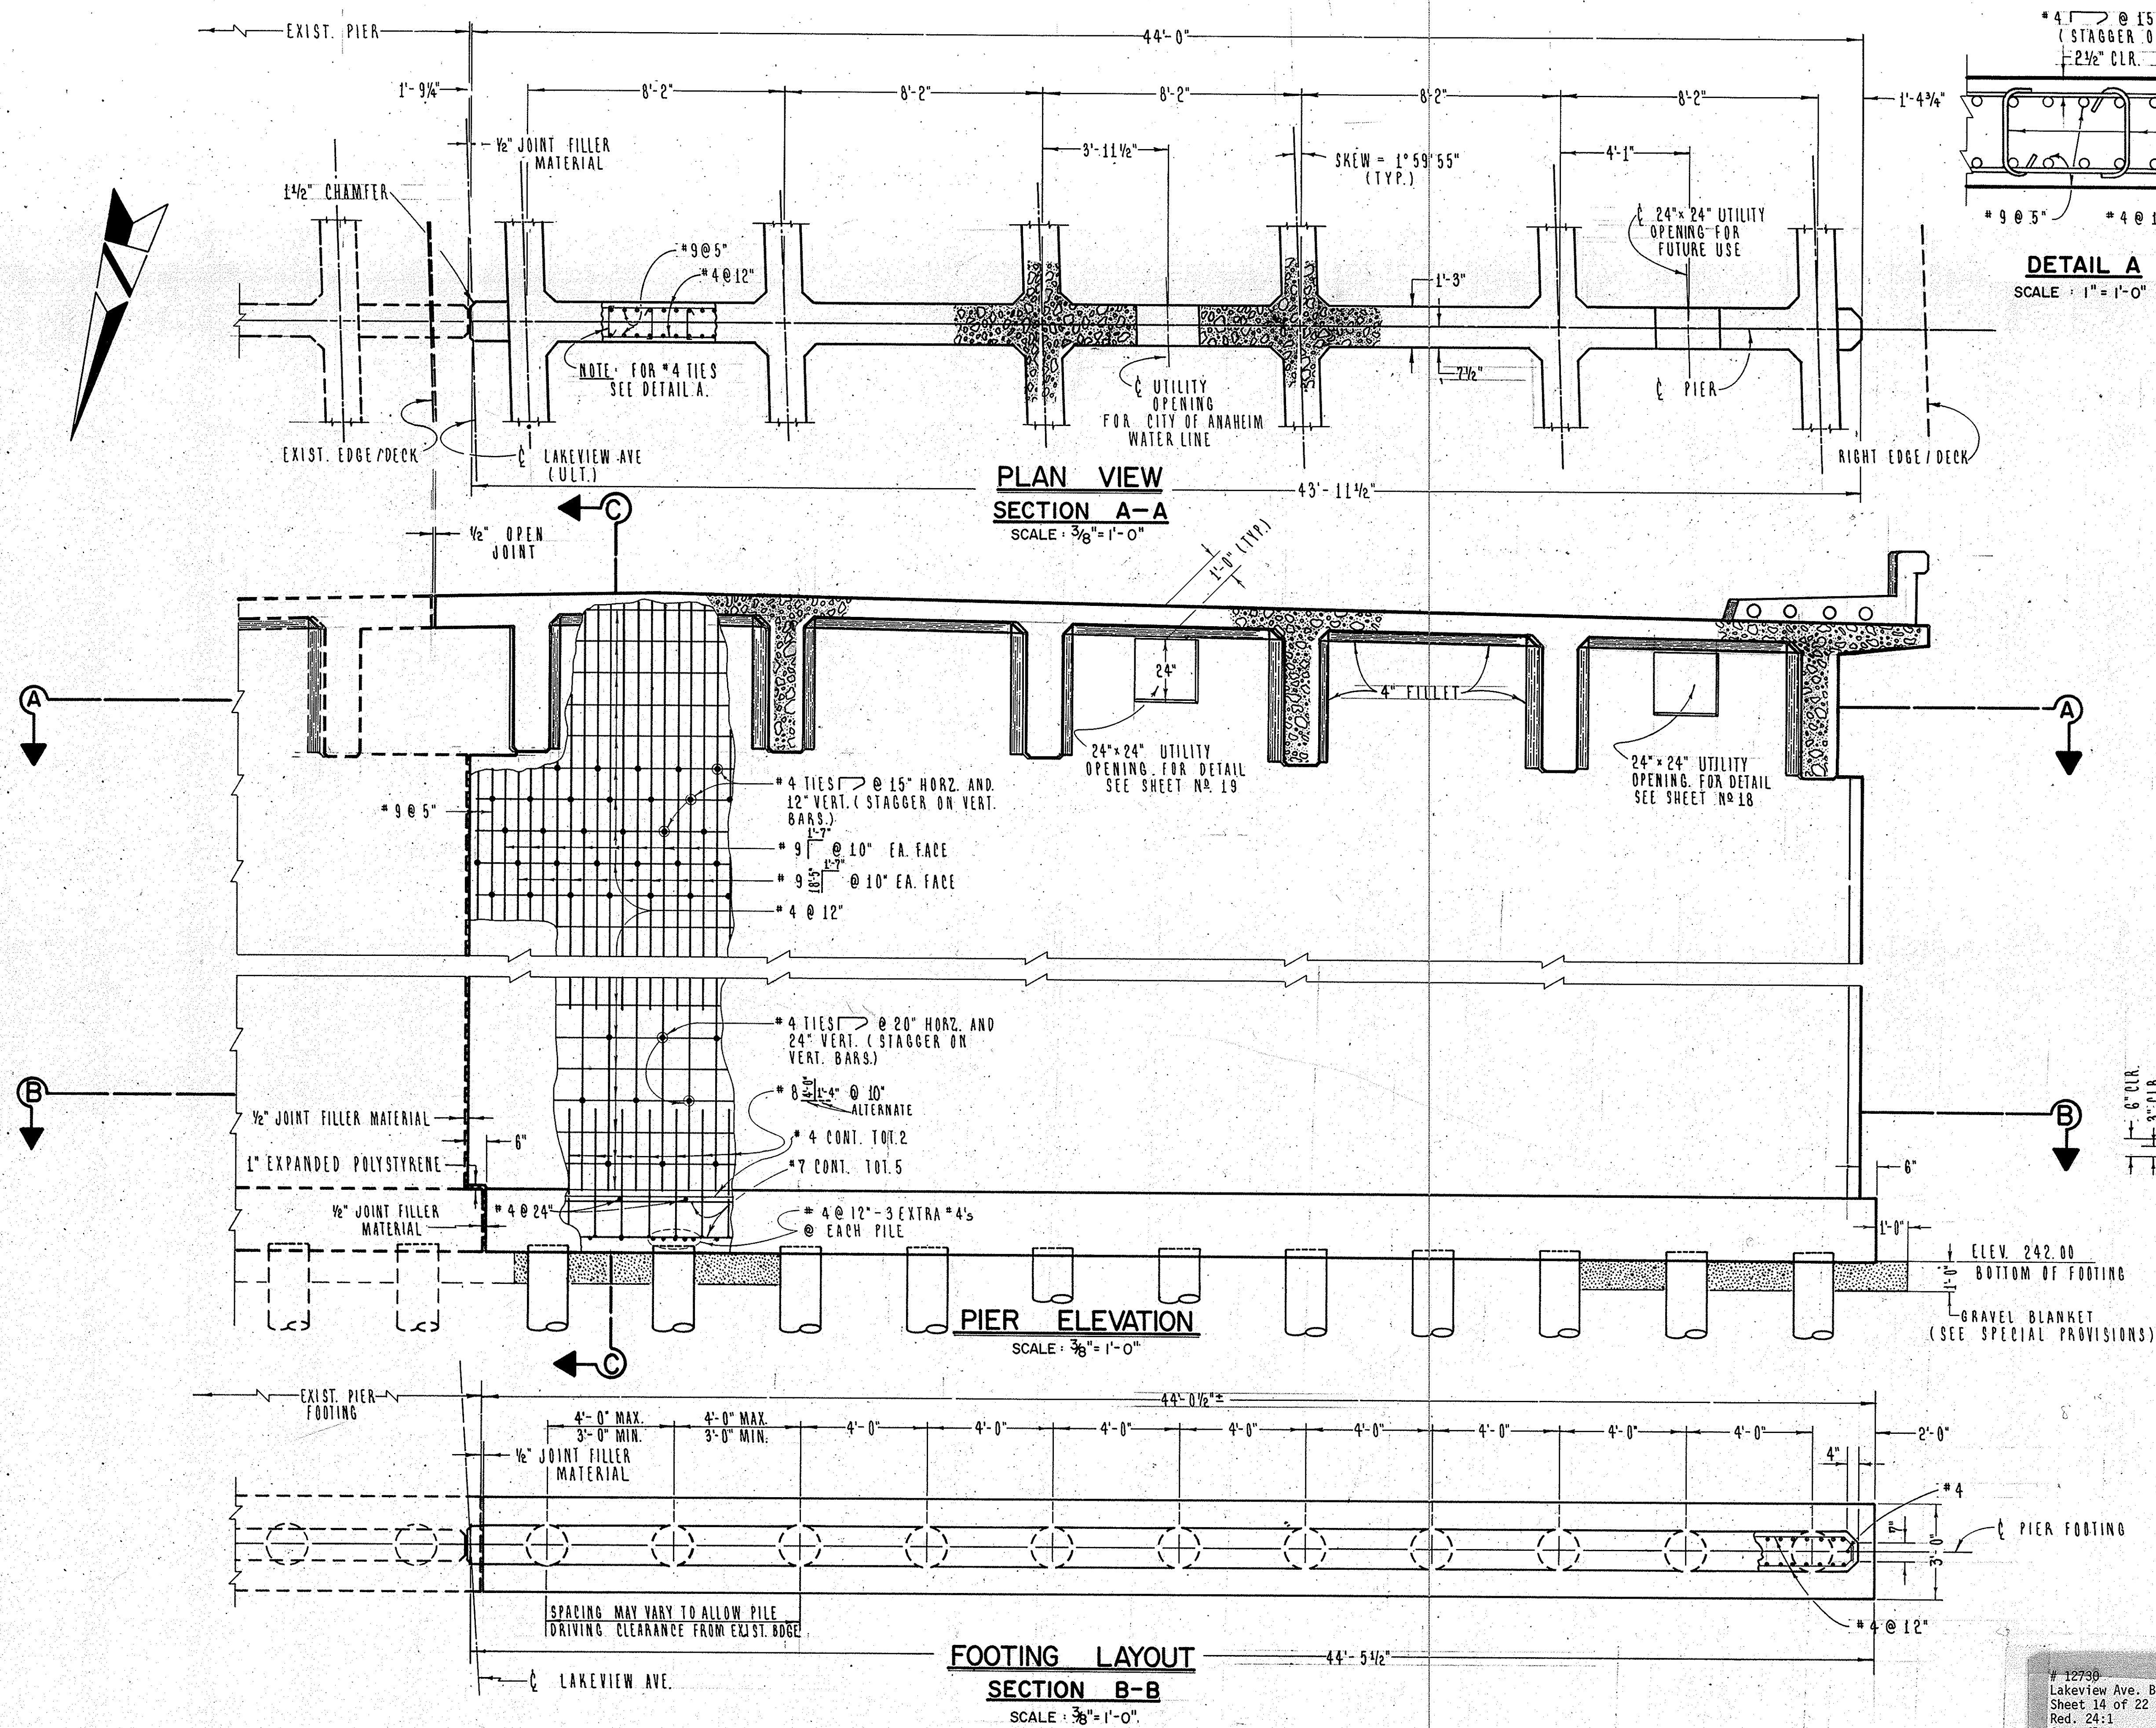

			ORANGE COUNTY ENVIRONMENTAL MANAGEMENT AGENCY	
			<u>LAKEVIEW AVE. BRIDGE (SA 6)</u>	
			<u>WIDENING OVER</u>	
			<u>SANTA ANA RIVER (EOI)</u>	
<u>PIER — DETAILS</u>				
MARK	DATE	DESCRIPTION	PREPARED UNDER SUPERVISION OF <u>M. A. Murphy</u> 3/78	
REVISIONS			DATE	SHEET
DESIGNED	<u>GENE W. FOSTER</u>	SCALE	<u>AS SHOWN</u>	14
DRAWN	<u>'P.J.'</u>	CHECKED	<u>3/78</u>	
			MARCH 1978	DWG. NO.
			OF 22	

DR.# 10 (12730)