




TYPICAL SECTION
DETOUR
SCALE 1"=10'0"

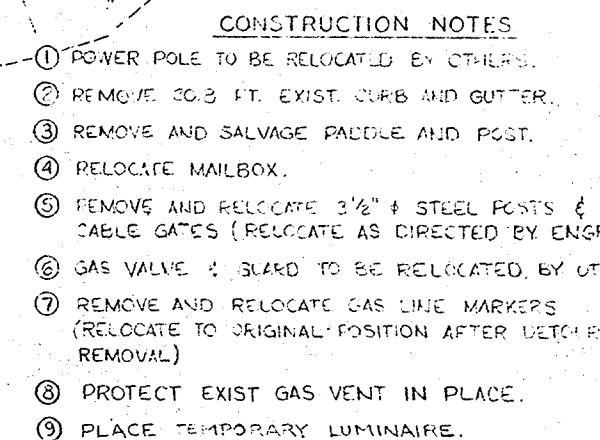