
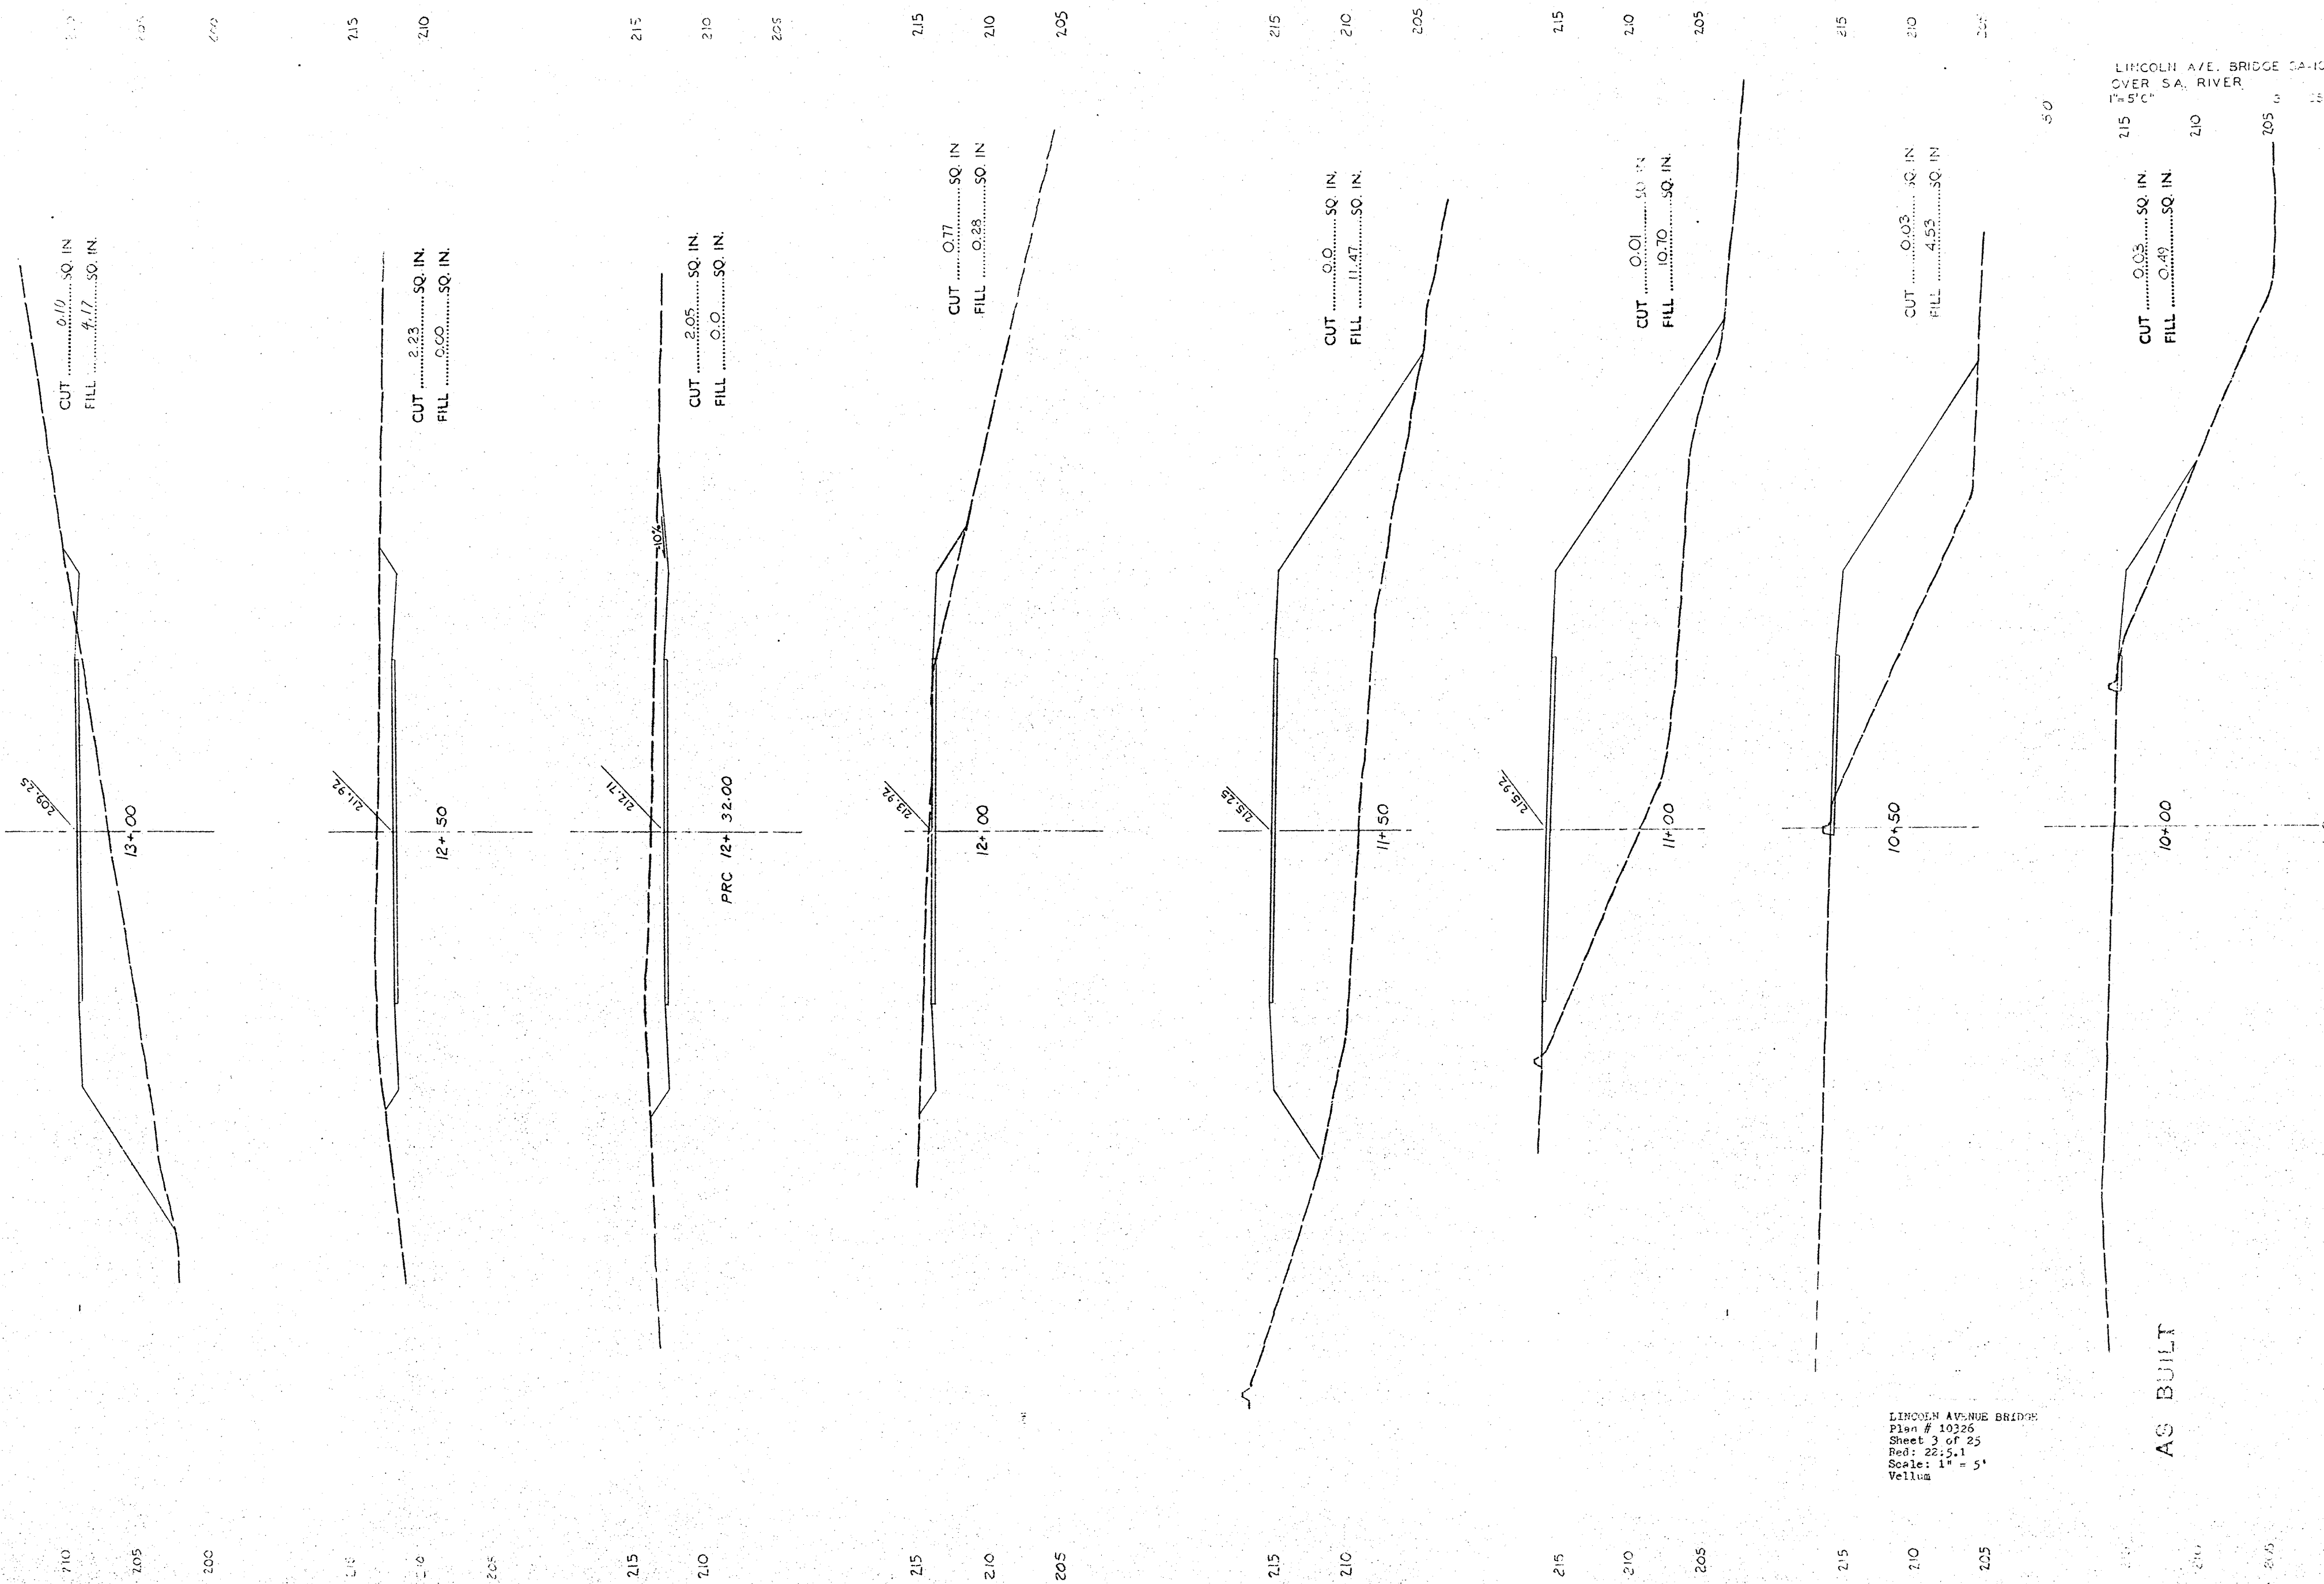


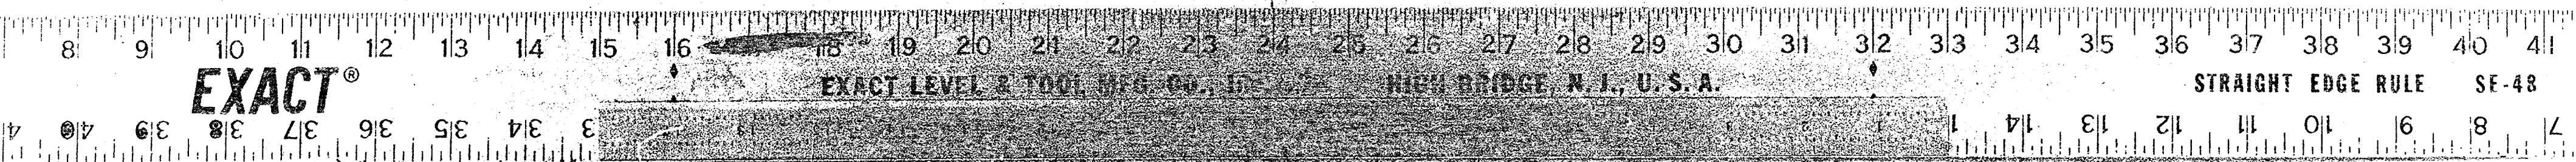

LINCOLN AVE. BRIDGE OVER SA. RIVER
1" = 5' H

LINCOLN AVENUE BRIDGE
Plan # 10326
Sheet 3 of 25
Red: 22:5.1
Scale: 1" = 5'
Vellum

AS BUILT

DR-10(11)226