


22.27
20.10
20.00

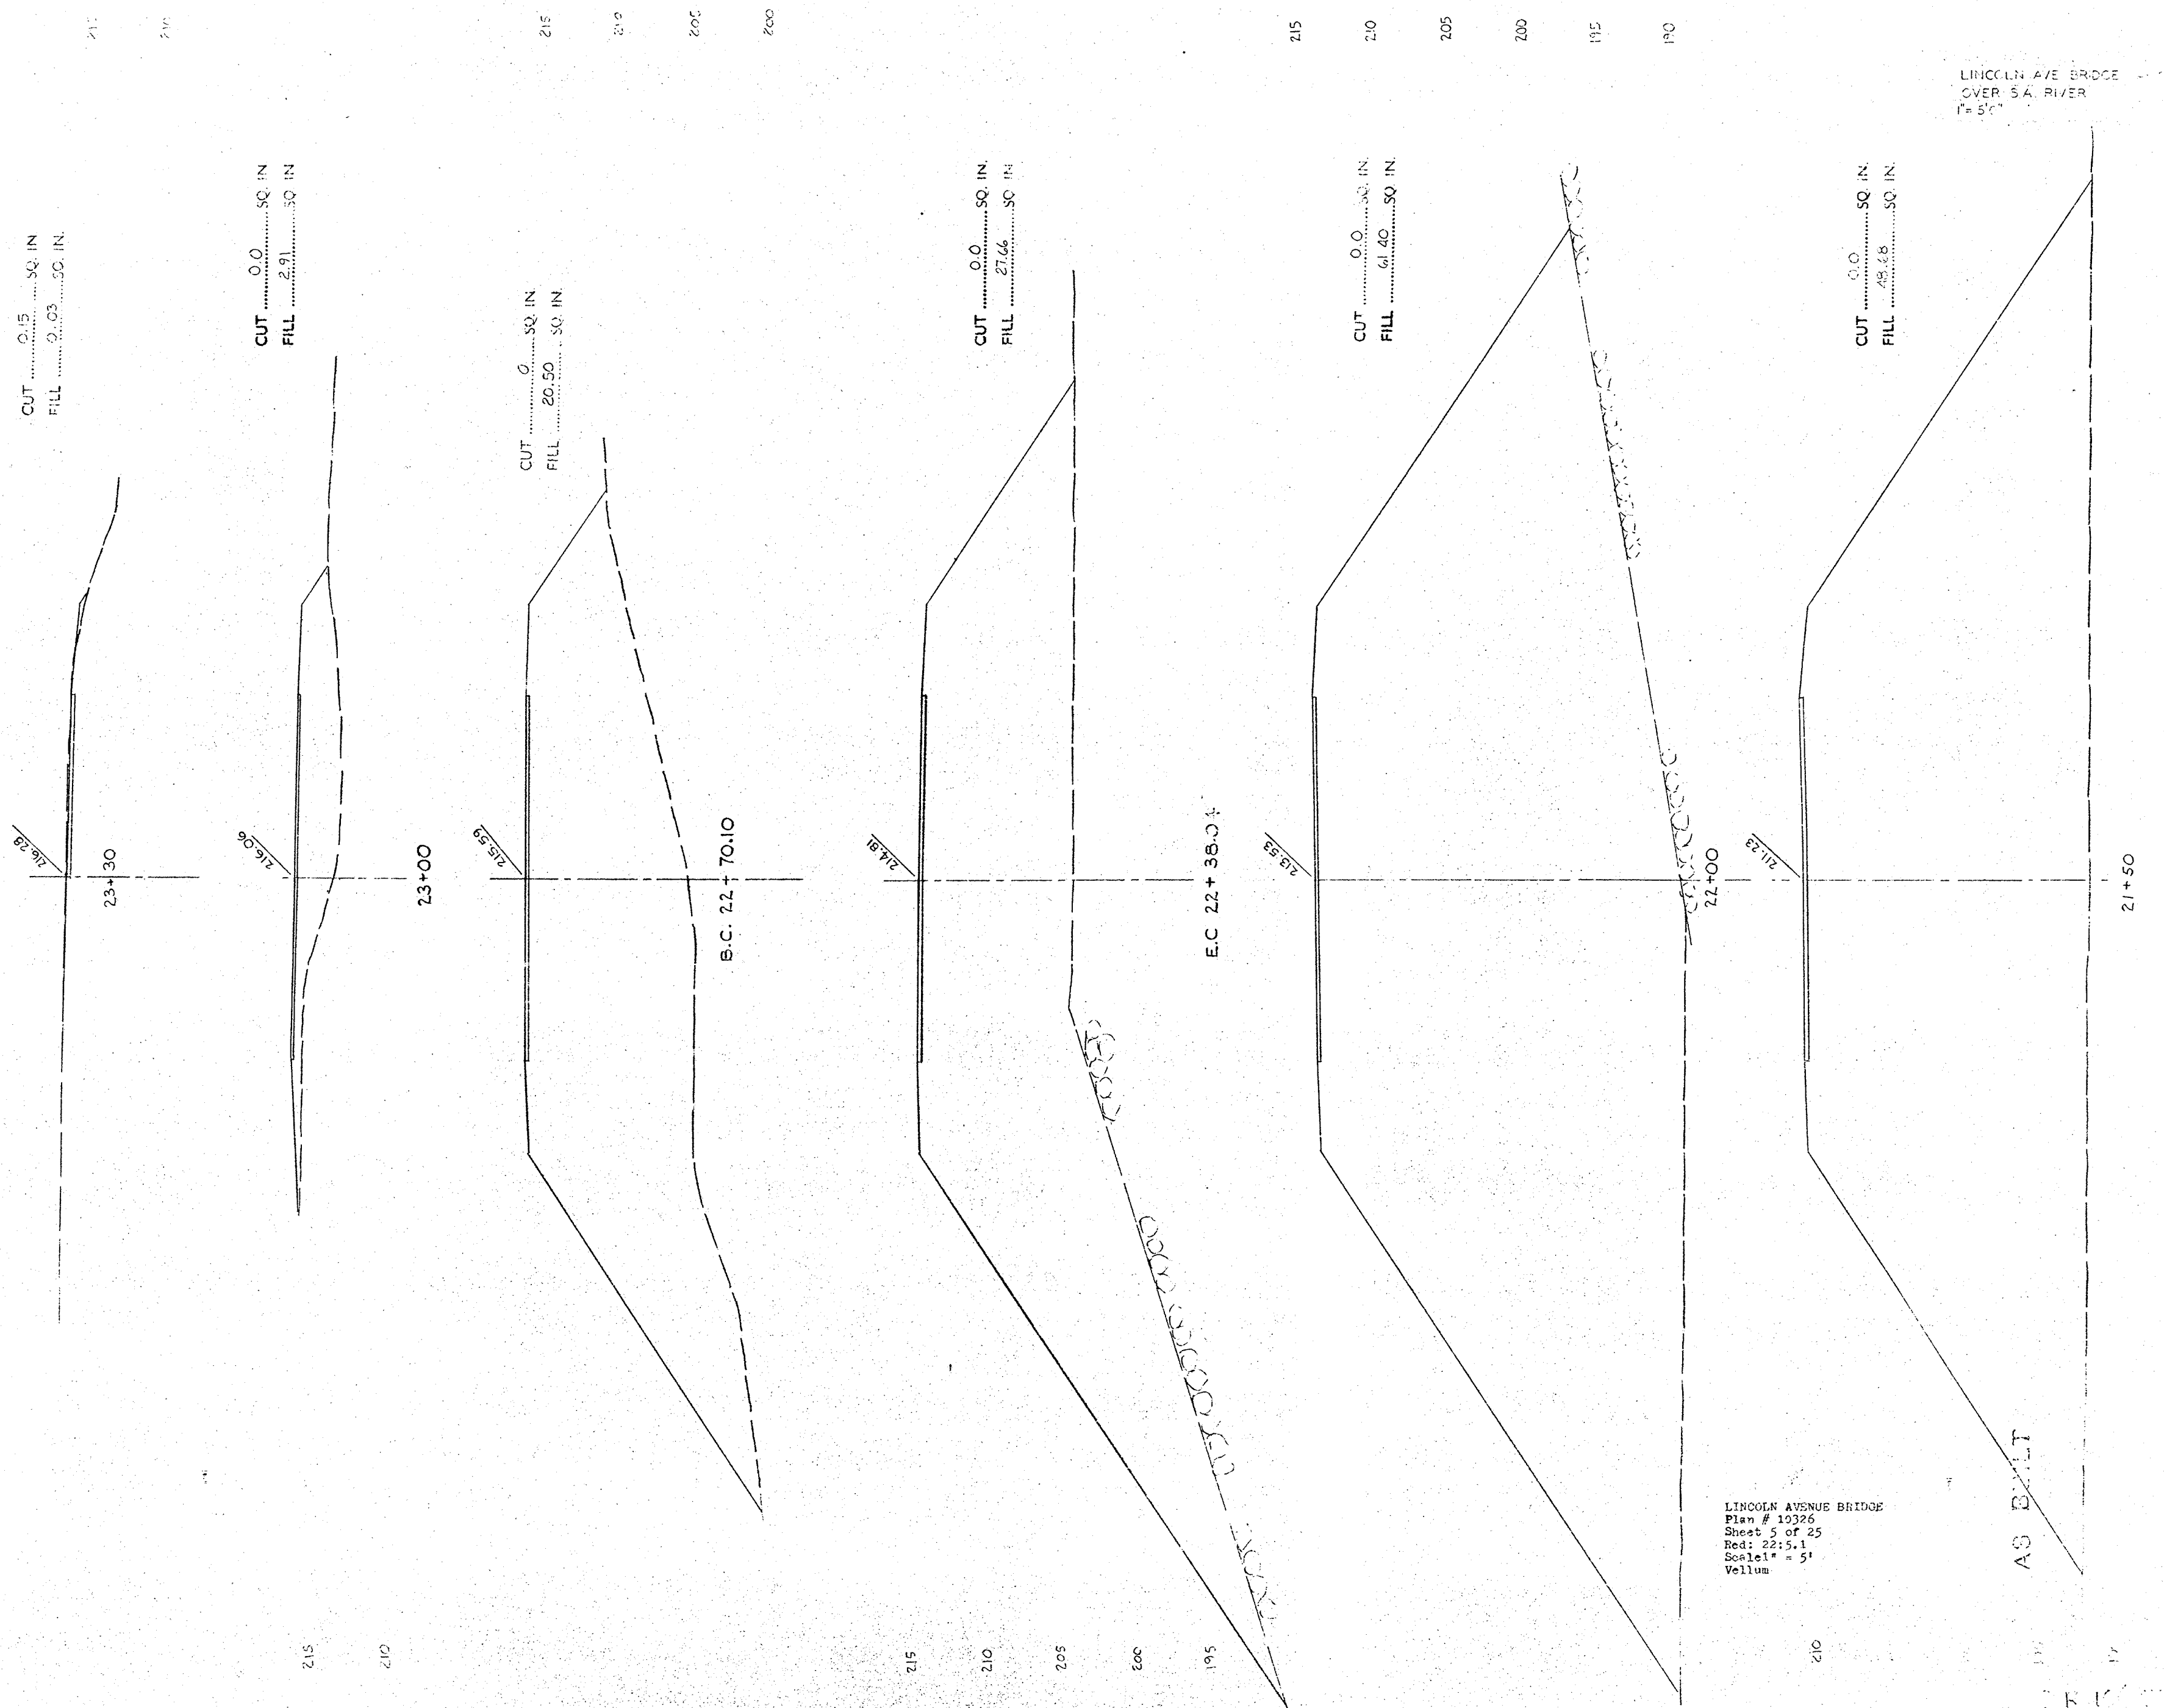

LINCOLN AVE BRIDGE
OVER SA. RIVER
1"=50'

LINCOLN AVENUE BRIDGE
Plan # 10326
Sheet 5 of 25
Red: 22:5.1
Scale: 1" = 50'
Vellum