



EXACT®

EXACT LEVEL 3 1/2" x 11" 1/2" U.S.A.


STRAIGHT EDGE RULE SE-48

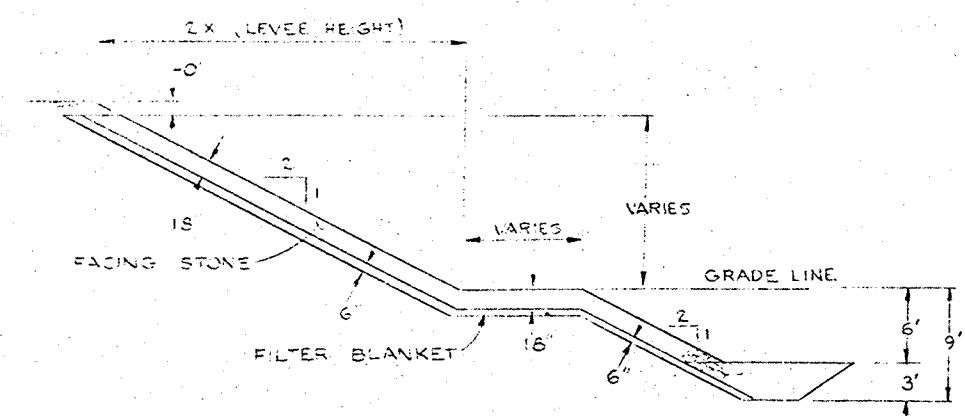



SECTION C-C
SCALE - 1"=10'

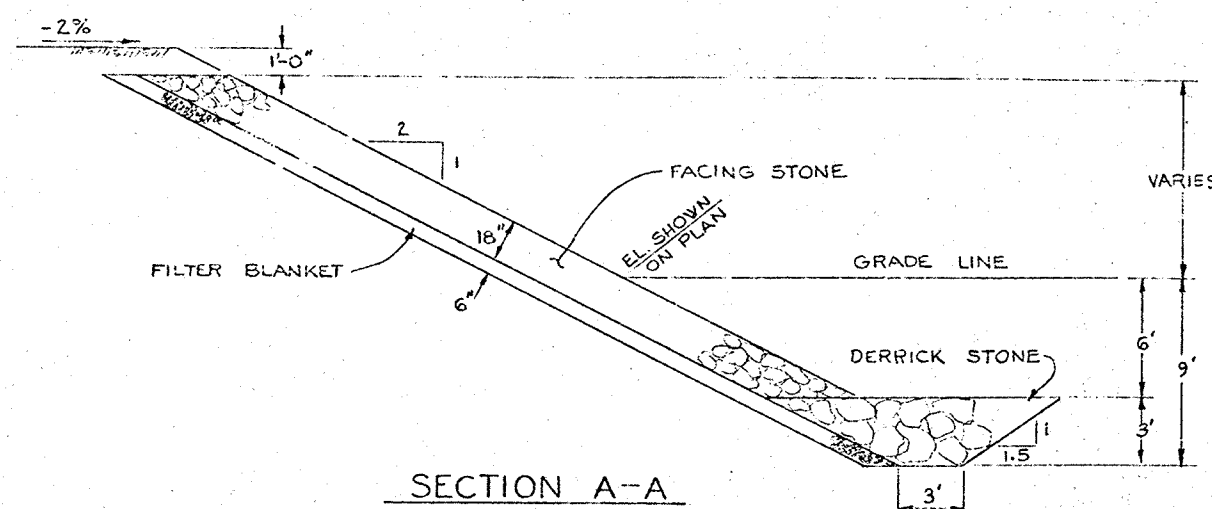


SECTION A-A
ROCK STRUCTURAL SECTION
NO SCALE

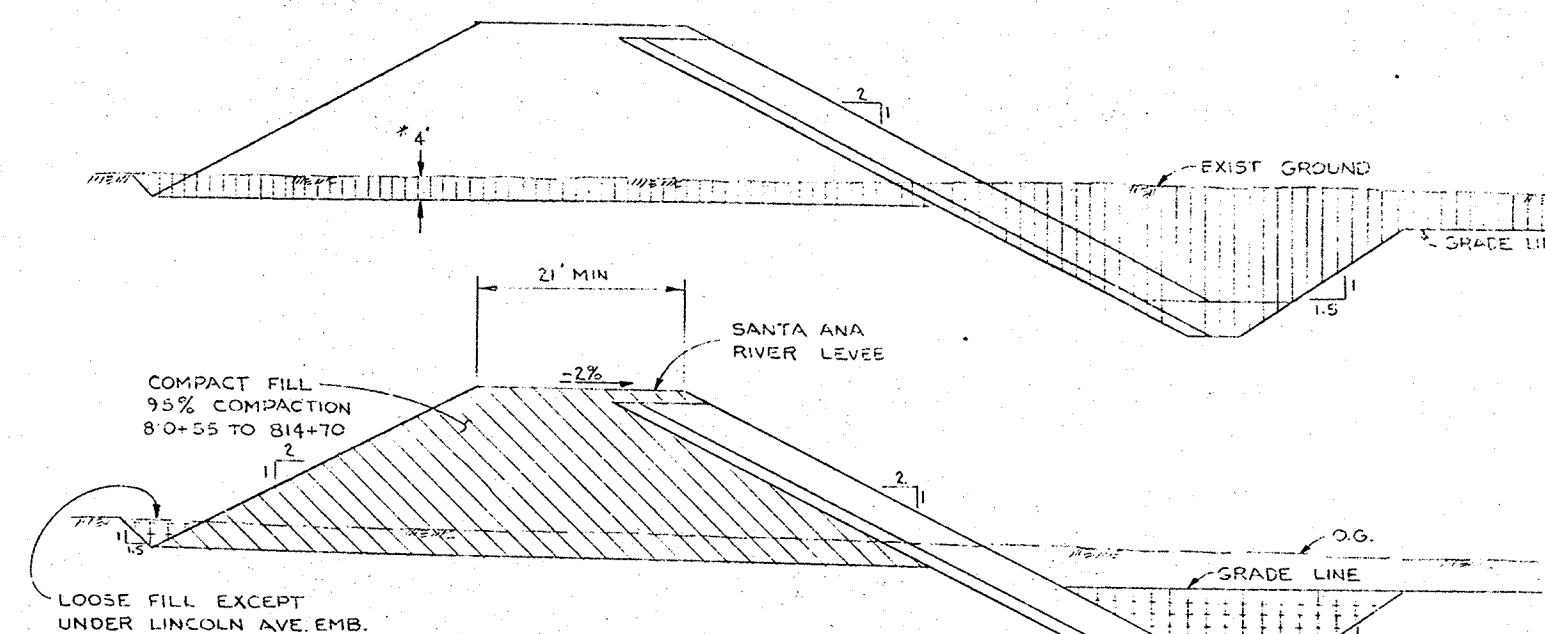


SANTA ANA RIVER
EXCAVATION & BACKFILL LIMITS
NO SCALE

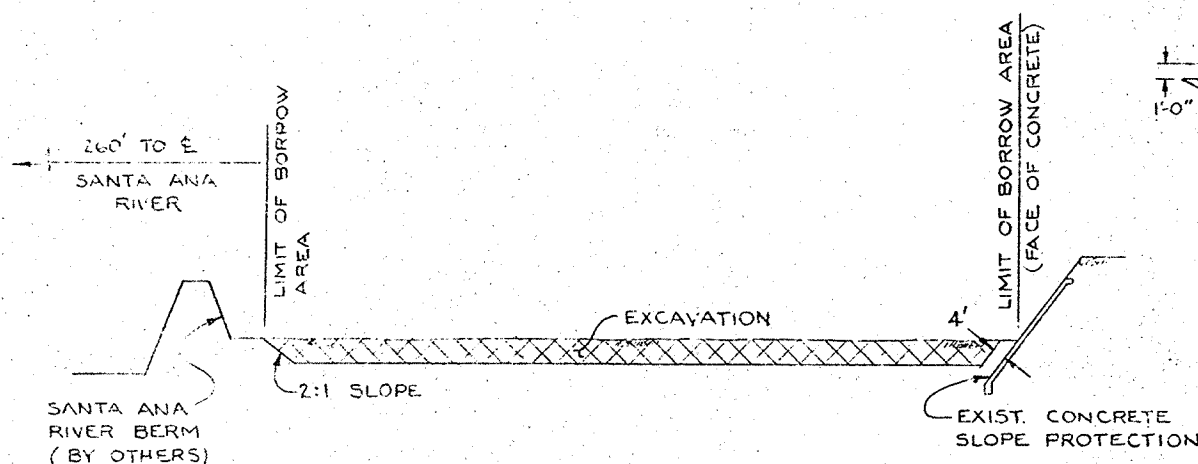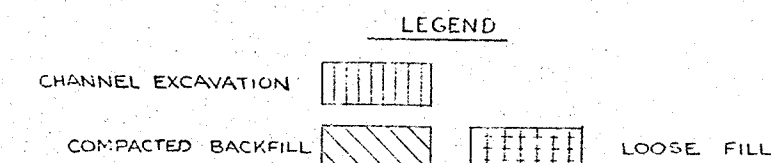


SECTION E-E
NO SCALE

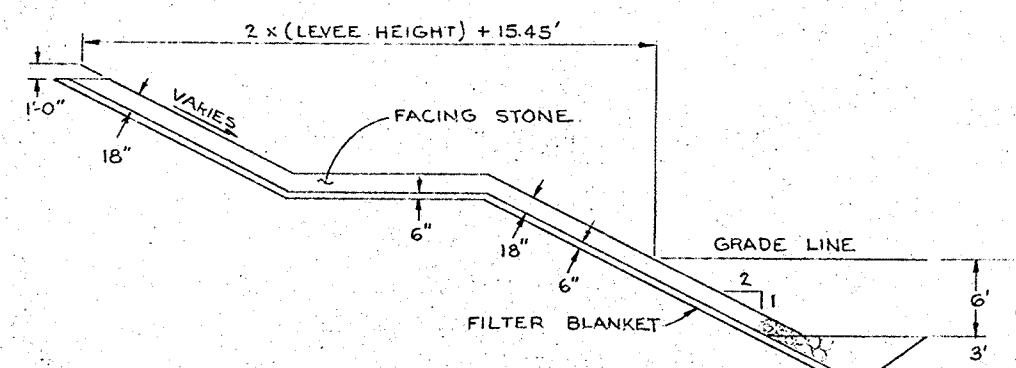


SECTION B-B
SCALE - 1"=10'

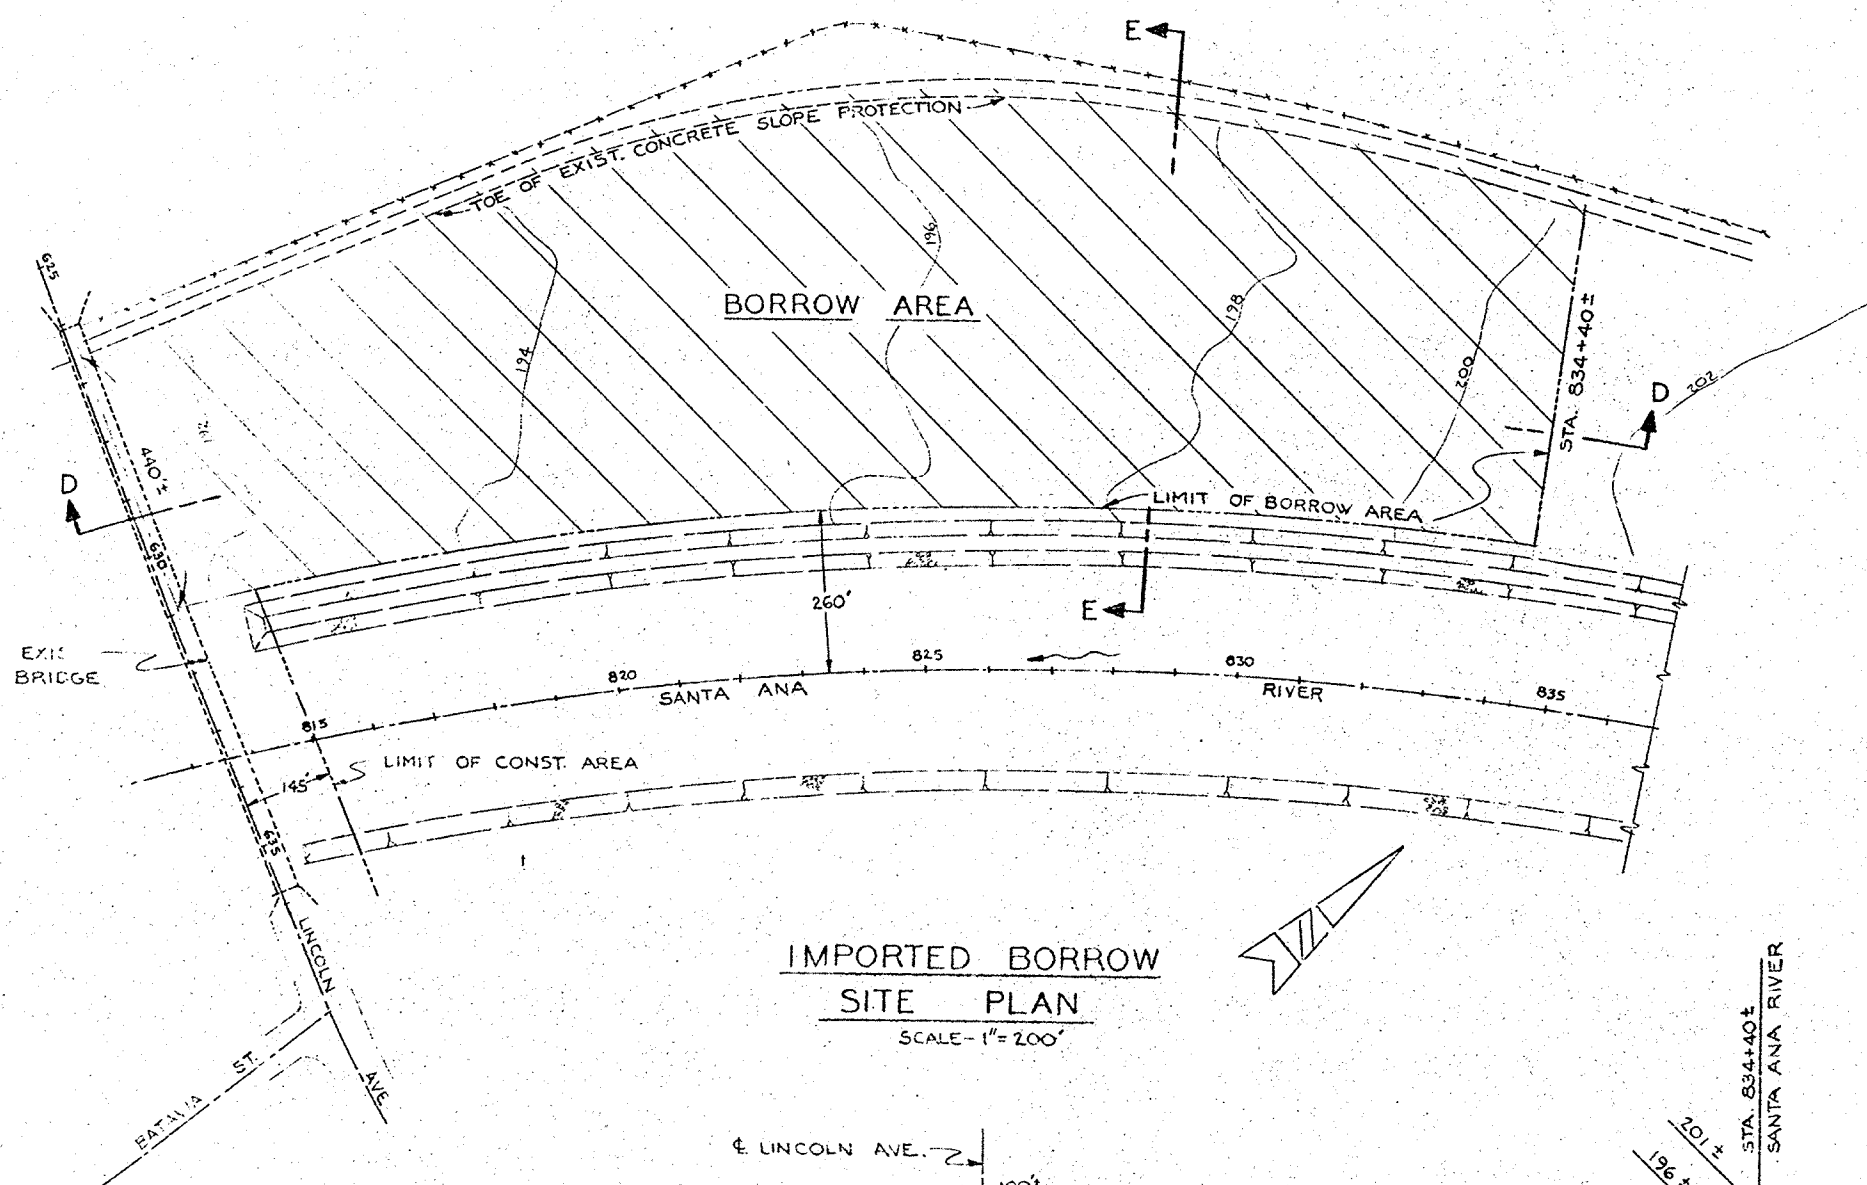

IMPORTED BORROW
SITE PLAN
SCALE - 1"=200'

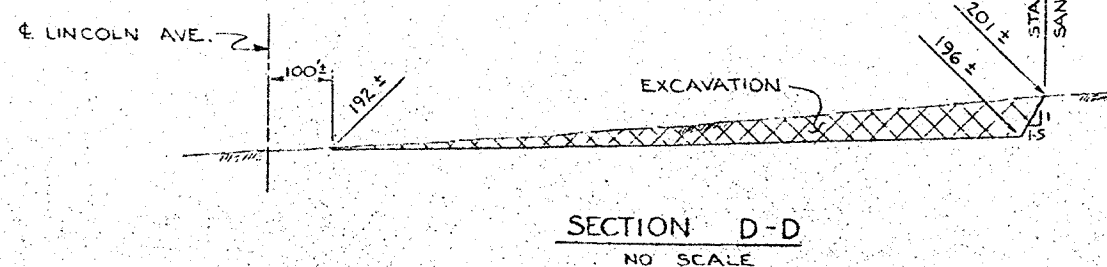

SECTION D-D
NO SCALE

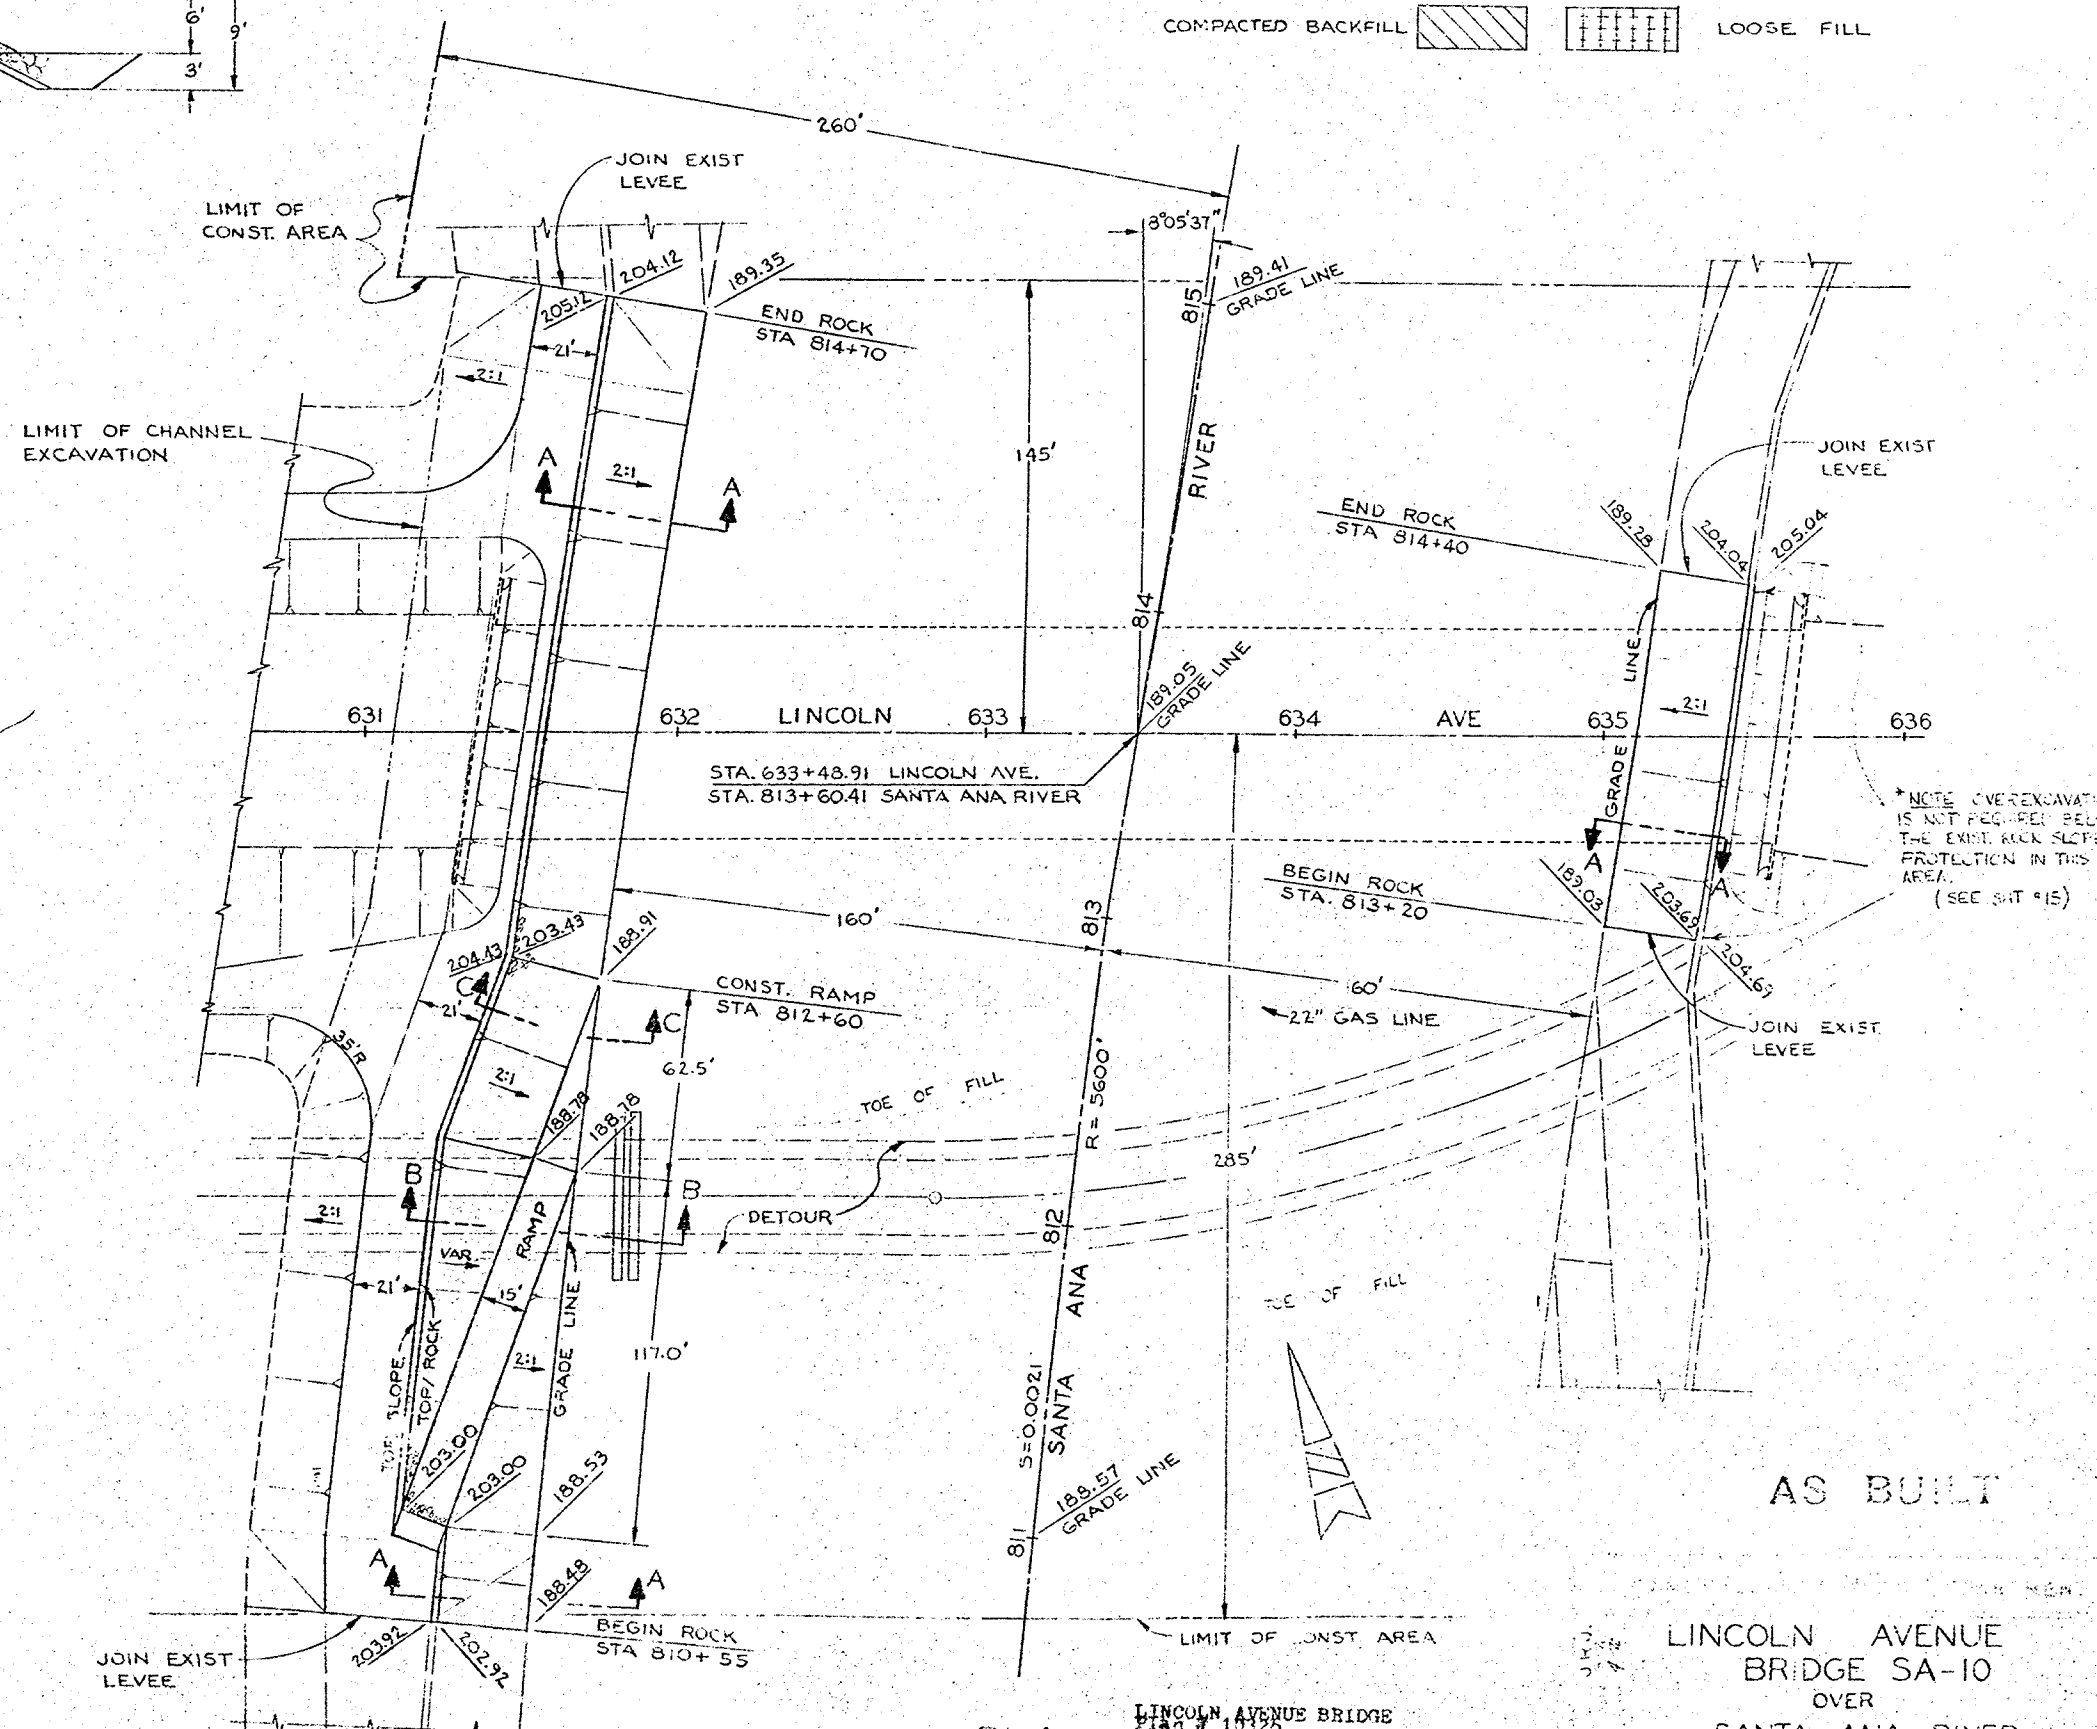

PLAN
SCALE - 1"=40'

AS BUILT

LINCOLN AVENUE
BRIDGE SA-10
OVER
SANTA ANA RIVER
SANTA ANA RIVER LEVEE
DETAILS &
IMPORTED BORROW SITE PLAN

AS NOTED

DR 106103