



EXACT®

STRAIGHT EDGE RULE SE-48

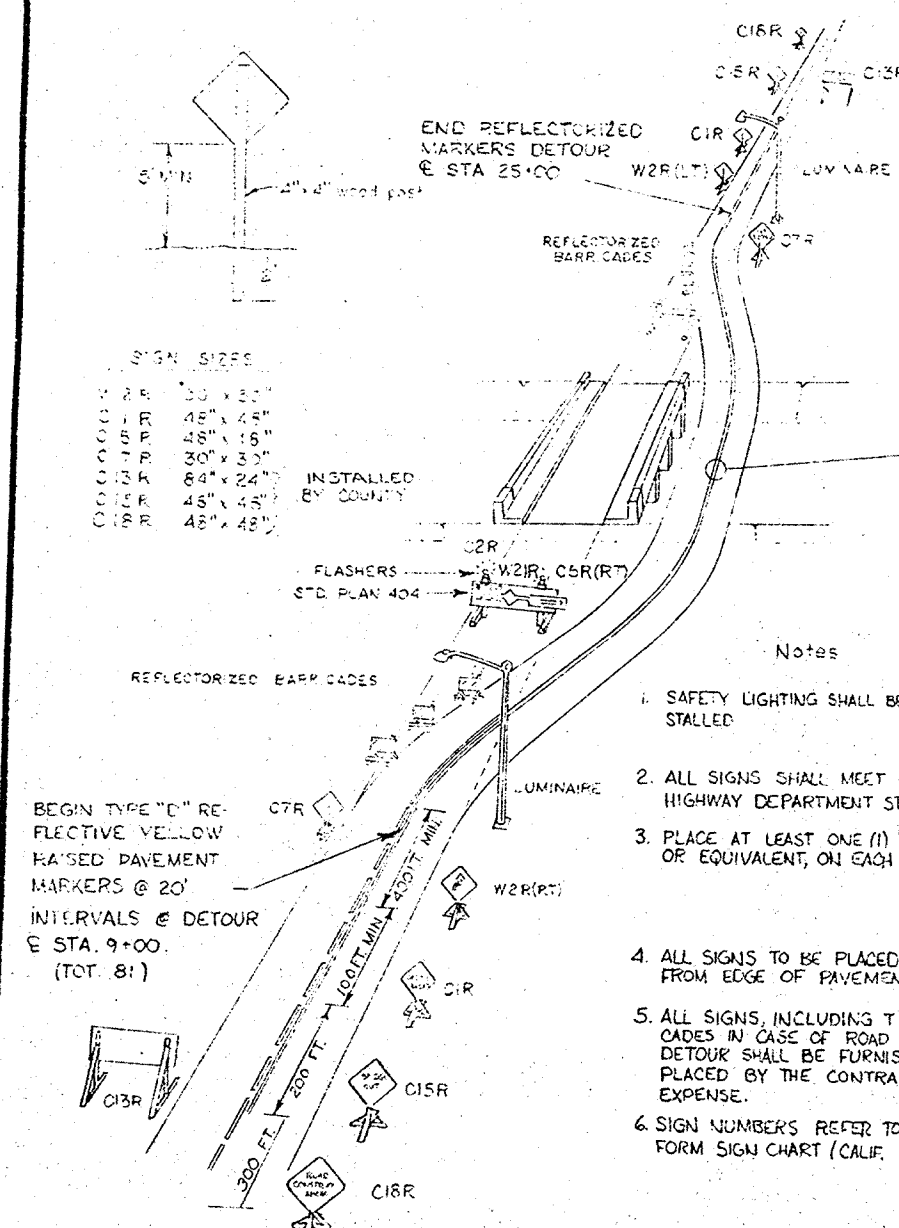


- Notes:
1. SAFETY LIGHTING SHALL BE INSTALLED.
 2. ALL SIGNS SHALL MEET ORANGE COUNTY HIGHWAY DEPARTMENT STANDARDS.
 3. PLACE AT LEAST ONE (1) "FLASHER" OR EQUIVALENT, ON EACH BARRICADE.
 4. ALL SIGNS TO BE PLACED 4'-12' FROM EDGE OF PAVEMENT.
 5. ALL SIGNS, INCLUDING TIMBER BARRICADES IN CASE OF ROAD CLOSURE OF DETOUR SHALL BE FURNISHED AND PLACED BY THE CONTRACTOR AT HIS EXPENSE.
 6. SIGN NUMBERS REFER TO CURRENT UNIT FORM SIGN CHART (CALIF. DIV. OF HIGHWAYS).

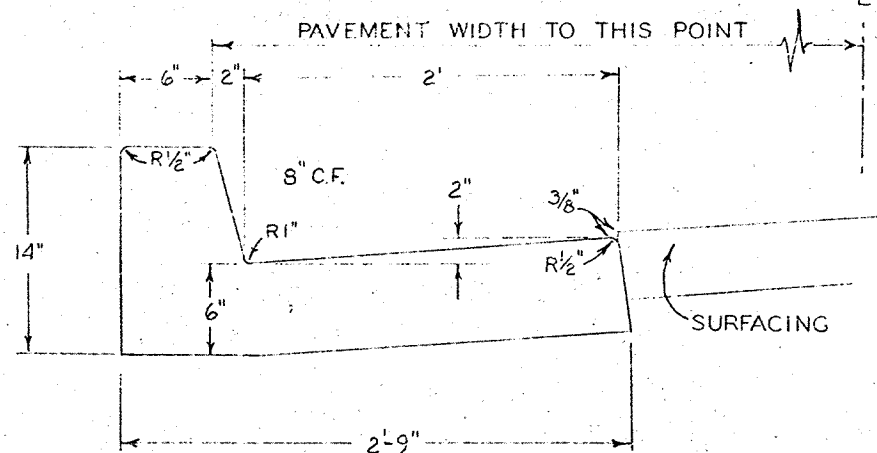


NOTE:
CONC. PER LIN. FT. = 0.645 CU. FT.
1 CU. YD. = 15.5 LI. FT.


TYPE A-2 CONCRETE CURB & GUTTER
SCALE 1-1/2"=1'-0"

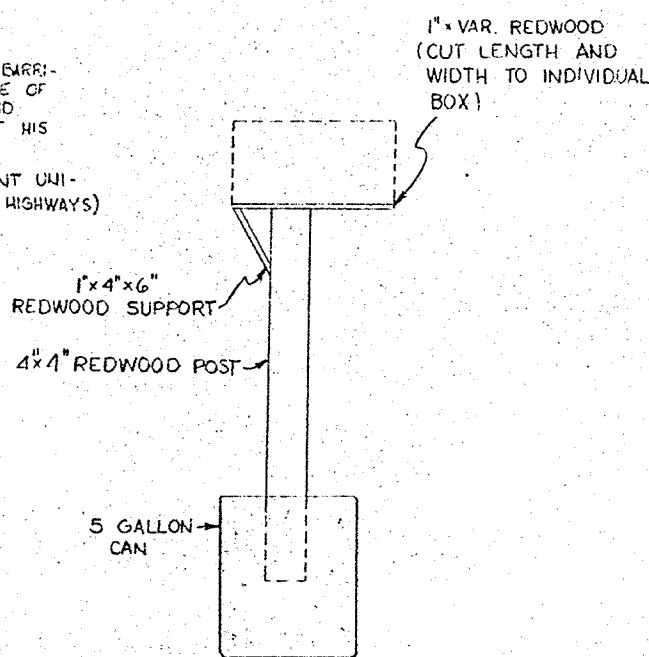


MAILBOX MOUNTS
NO SCALE

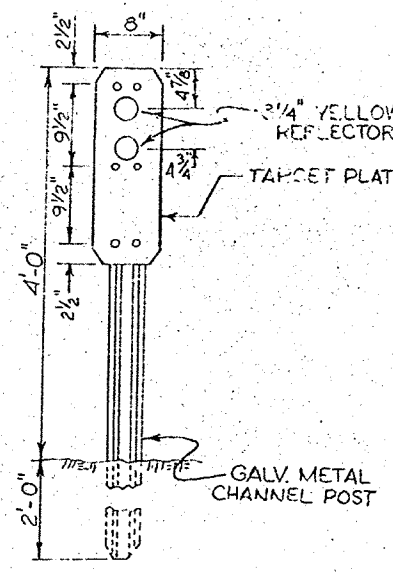


GUIDE MARKER
TYPE L-2
NO SCALE

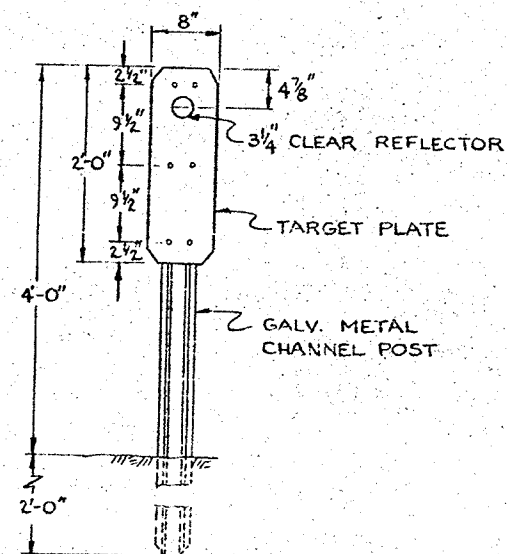

GUIDE MARKER
TYPE F-1
NO SCALE

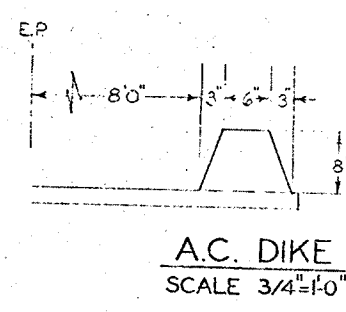

A.C. DIKE
SCALE 3/4"=1'-0"

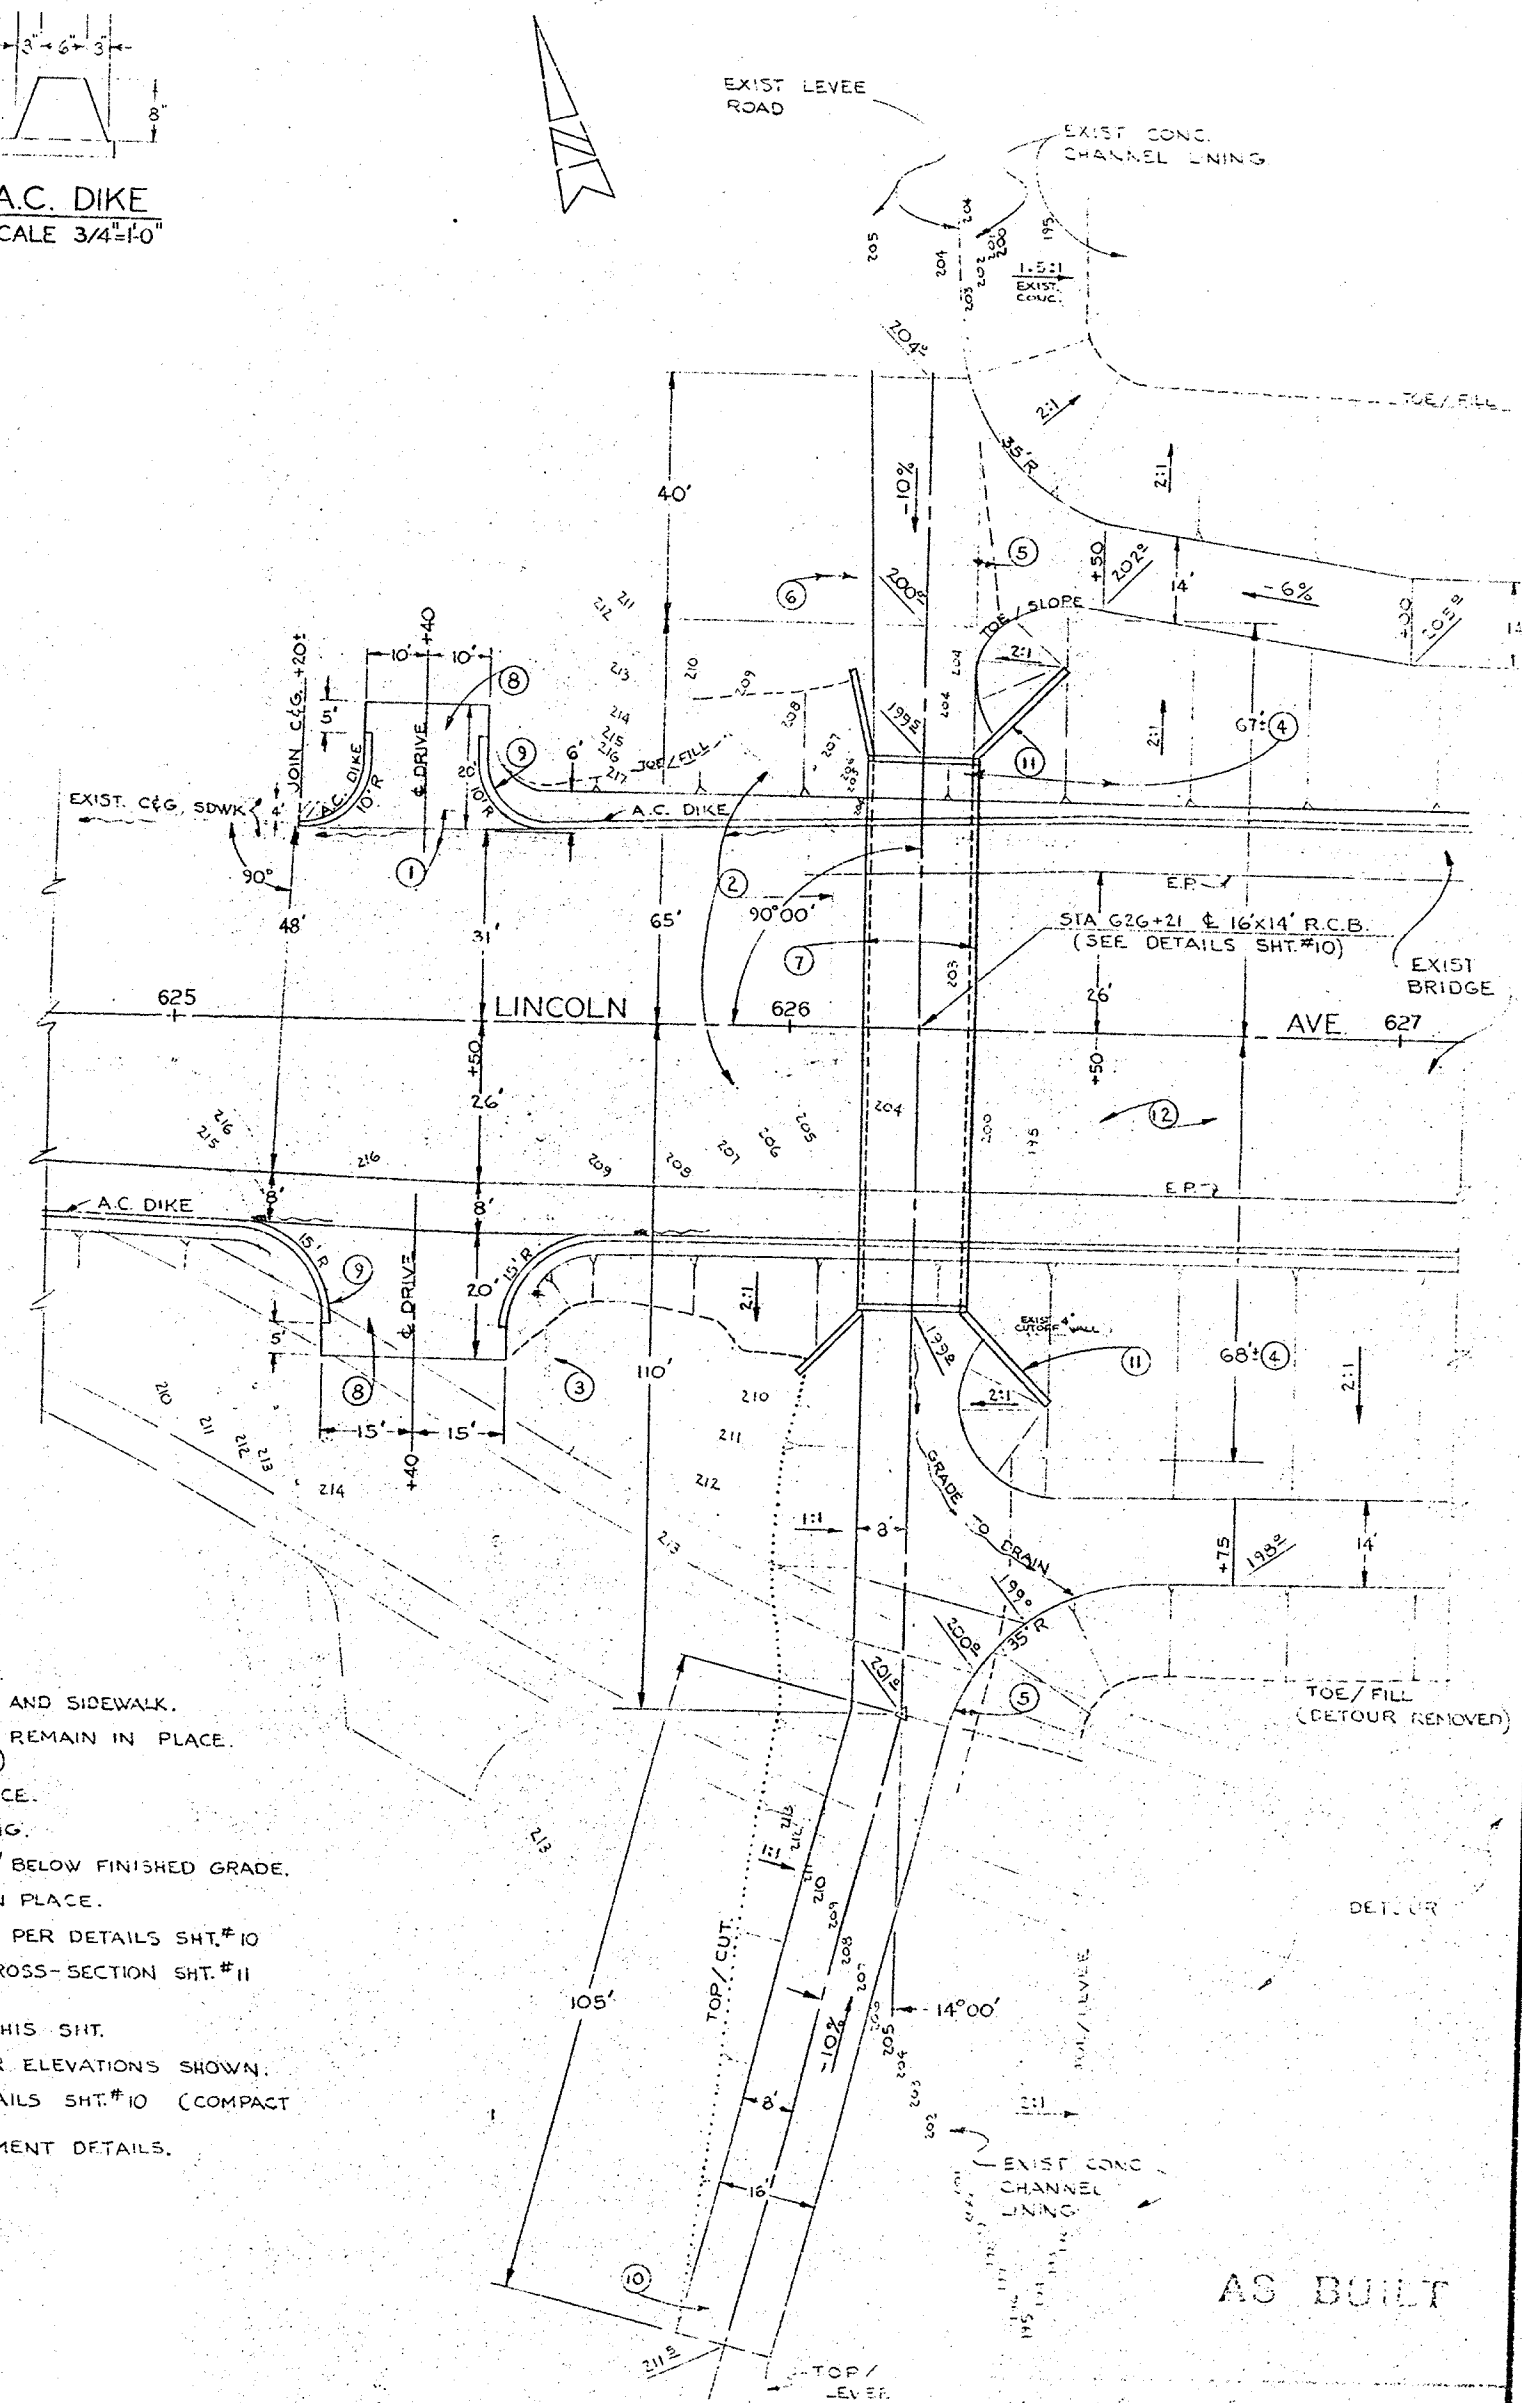

- CONSTRUCTION NOTES**
1. REMOVE 83'± OF EXIST. CURB & GUTTER AND SIDEWALK.
 2. EXIST. WINGWALLS & ABUT. WALL MAY REMAIN IN PLACE. (SEE BRIDGE REMOVAL LIMITS SHT.#6)
 3. OLD ABUT. WALL MAY REMAIN IN PLACE.
 4. REMOVE 135' OF 6" CONC. CHANNEL LINING.
 5. REMOVE CONC. CHANNEL LINING TO 1' BELOW FINISHED GRADE.
 6. PROTECT EXIST PIPE & WIRE FENCING IN PLACE.
 7. CONSTRUCT 16'x14' R.C.B. & WINGWALLS PER DETAILS SHT.#10
 8. CONSTRUCT 2'x14' R.C.B. DRIVE (SEE CROSS-SECTION SHT.#11 FOR PROFILE)
 9. CONSTRUCT A.C. DIKE PER DETAIL THIS SHT.
 10. CONSTRUCT LEVEE ACCESS ROAD PER ELEVATIONS SHOWN.
 11. CONSTRUCT RETAINING WALL PER DETAILS SHT.#10 (COMPACT FILL UNDER FOOTING TO 95%)
 12. SEE SHT.#7 FOR LINCOLN AVE. PAVEMENT DETAILS.

36 R.C.P. INLET DETAILS
NO SCALE

LINCOLN AVENUE BRIDGE
Plan # 10325
Sheet 9 of 25
Rev: 22.5.1
Scale As Shown
Vellum

WEST LEVEE
ACCESS PLAN
SCALE 1"=1'-0"

NOTE: CONTOUR SHOWN ARE APPROX. ONLY.

LINCOLN AVENUE
BRIDGE SA-10
OVER
SANTA ANA RIVER
WEST LEVEE ACCESS ROAD
AND MISC. DETAILS
AS NOTED

AS BUILT