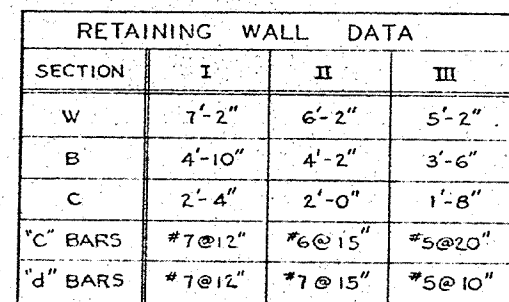
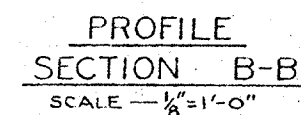
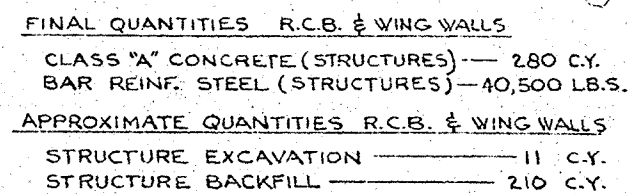
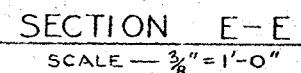
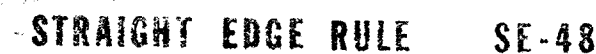


LINCOLN AVENUE BRIDGE
Plan # 10326
Sheet 10 of 25
Red: 22:5.1
Scale ~~As~~ Shown
Vellum

AS NOTED

25

DR-10(10326)