


EXACT®

EXACT LEVEL & TOLL REF. TO 1985
NEW BRIDGE, N. I., U. S. A.

STRAIGHT EDGE RULE SE-48

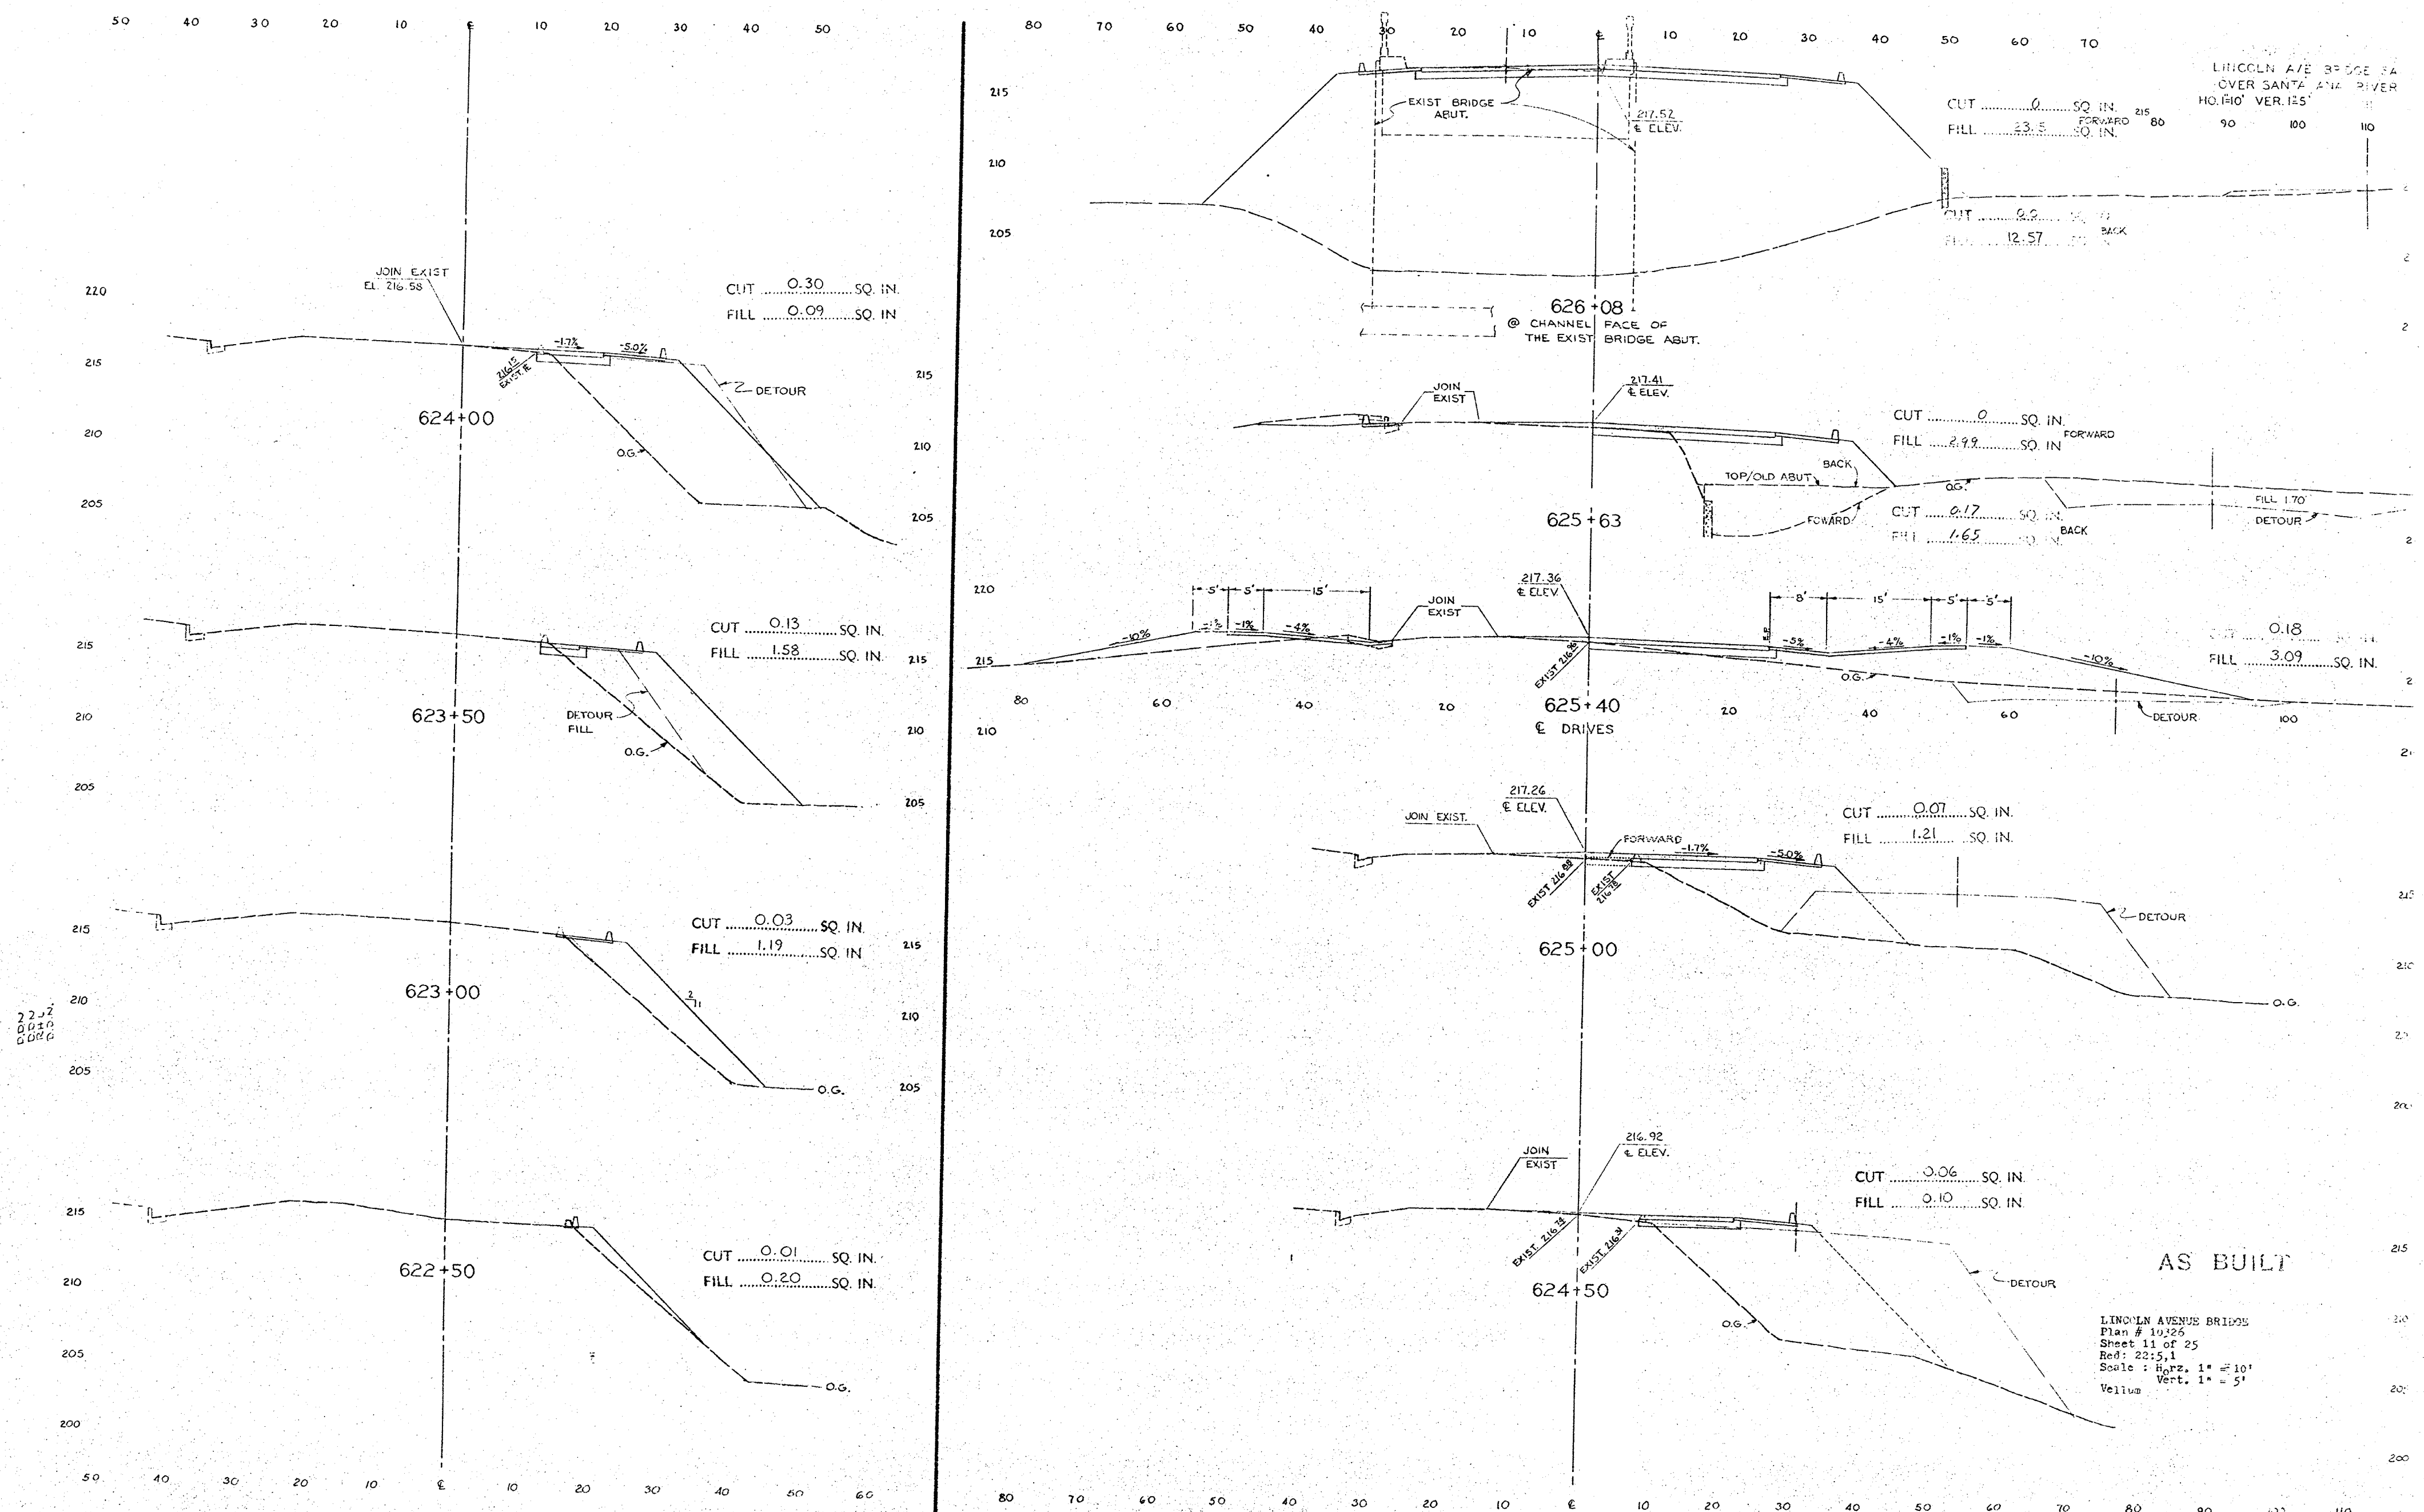

DR-1000