


EXACT®

EXACT LEVEL & TOOL MFG. CO., INC. HIGH BRIDGE, N. J., U. S. A.

STRAIGHT EDGE RULE SE-48

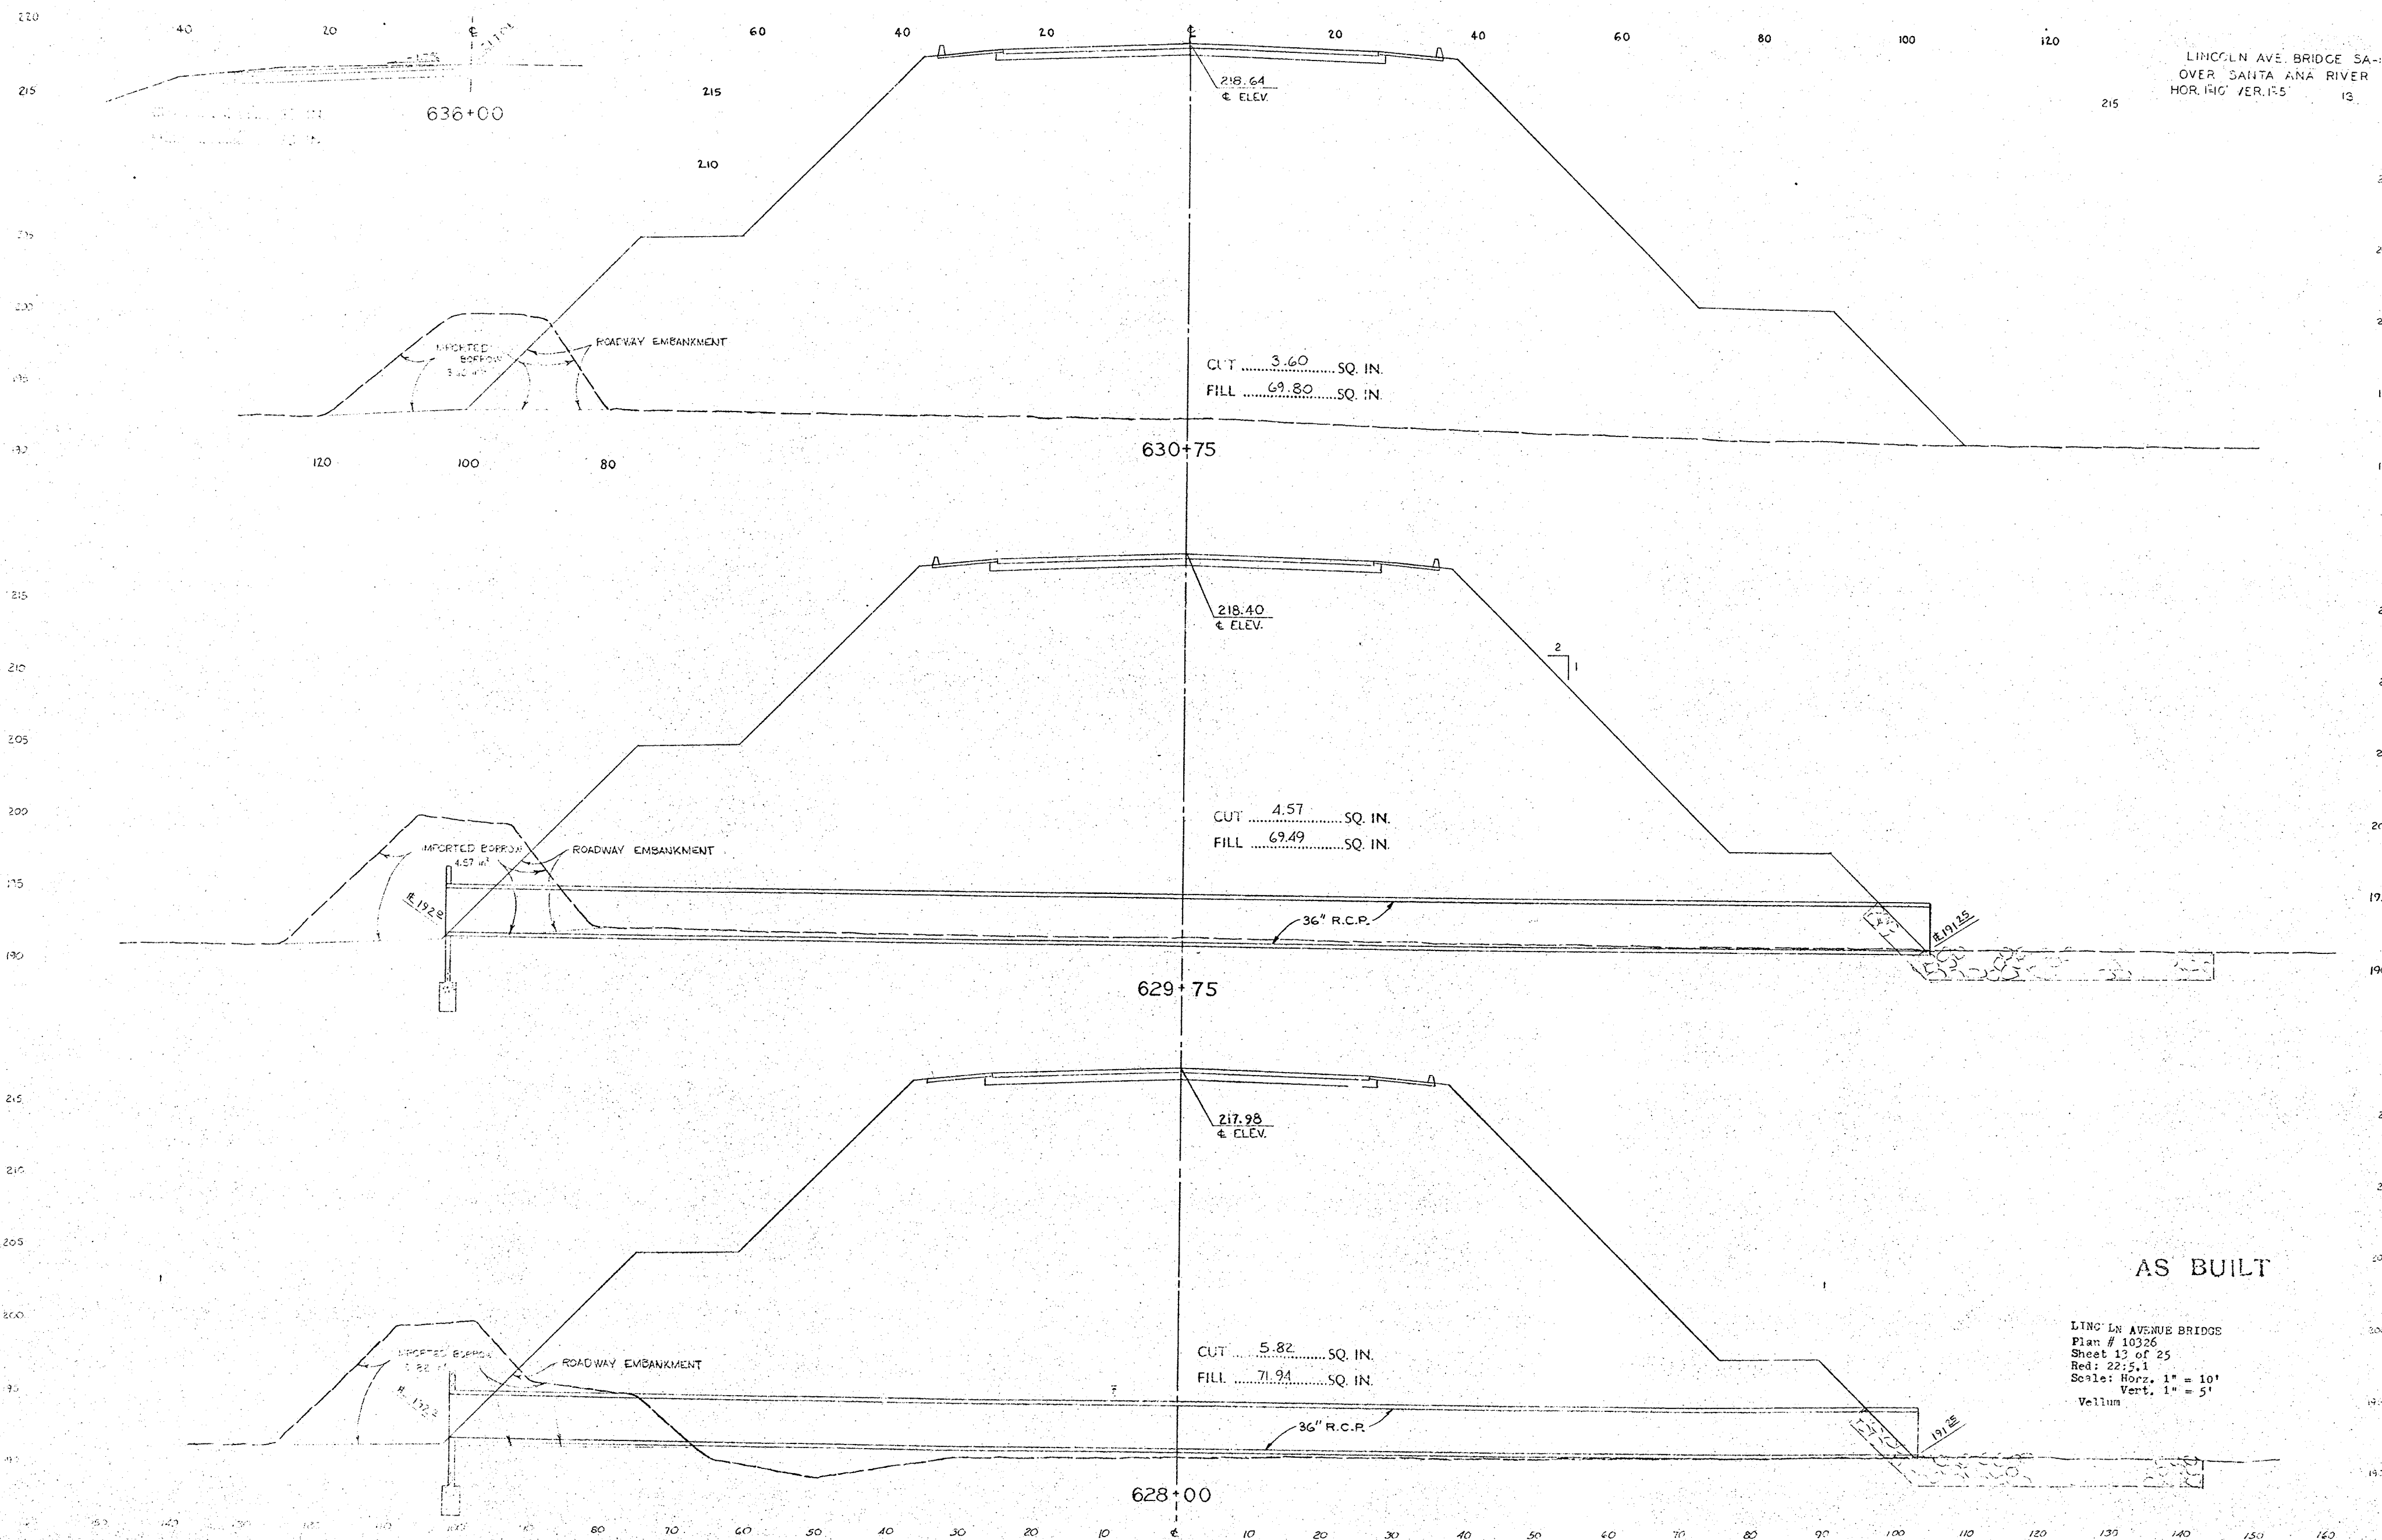

LINCOLN AVE. BRIDGE SA-
OVER SANTA ANA RIVER
HOR. 1/4\" VER. 1/5\" 13 1

AS BUILT

LINCOLN AVENUE BRIDGE
Plan # 10326
Sheet 12 of 25
Red: 22.5.1
Scale: Horiz. 1\" = 10'
Vert. 1\" = 5'
Vellum

DR 10