

EXACT®

EXACT LEVEL & 10' 1" HIGH BRIDGE, N. S. A.

STRAIGHT EDGE RULE SE-48


APPROXIMATE QUANTITIES BRIDGE SA

STRUCTURE EXCAVATION	789
STRUCTURE BACKFILL	140
FRUSH STEEL PILING	2440
DRIVE STEEL PILING	100
JOINT SEAL (TYPE A)	66
METAL BEAM BRIDGE RAIL	848


FINAL QUANTITIES BRIDGE SA-10

CLASS "A" CONCRETE (BRIDGE)	2161
BAR REINF. STEEL (BRIDGE)	615,000


PROFILE GRADE
NO SCALE

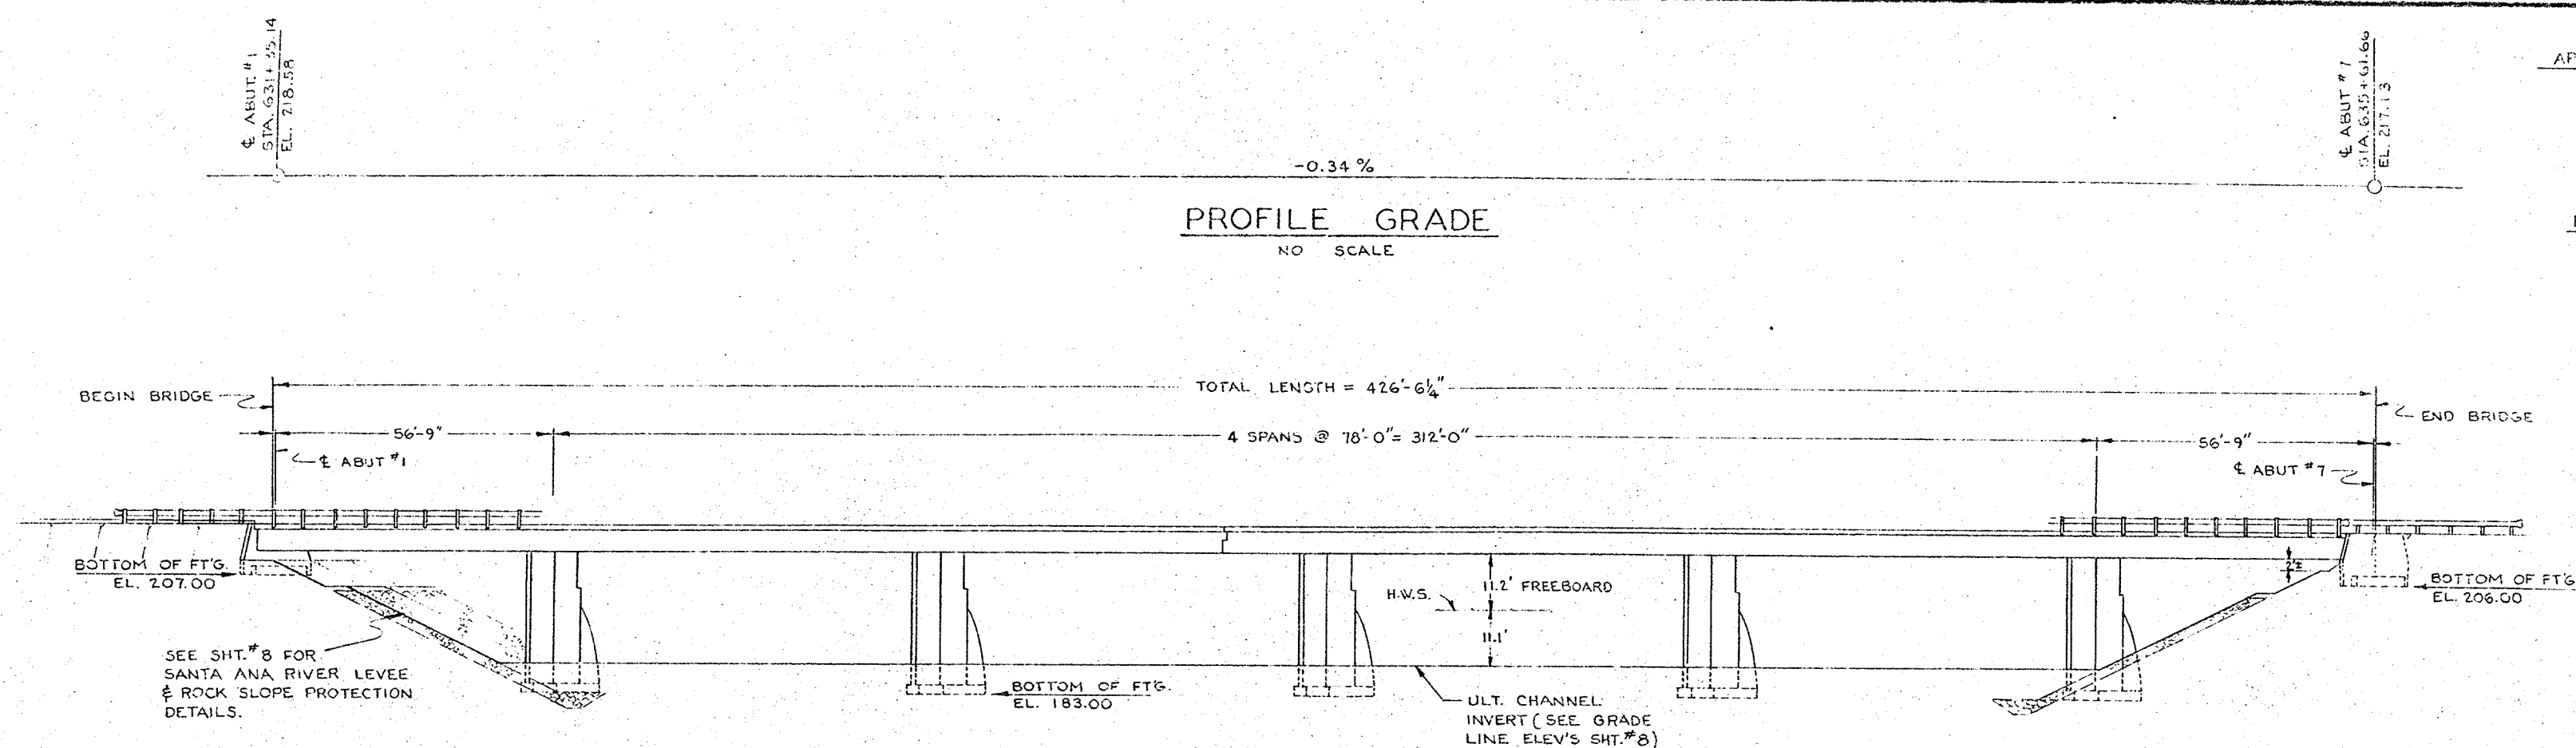

ELEVATION
PILING NOT SHOWN
SCALE - 1" = 20'

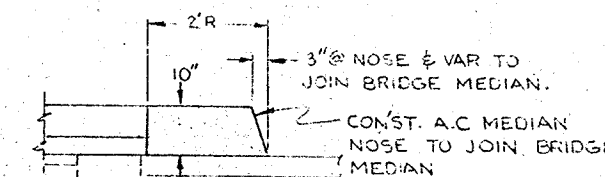


SECTION A-A
SCALE - 1/2" = 1'-0"

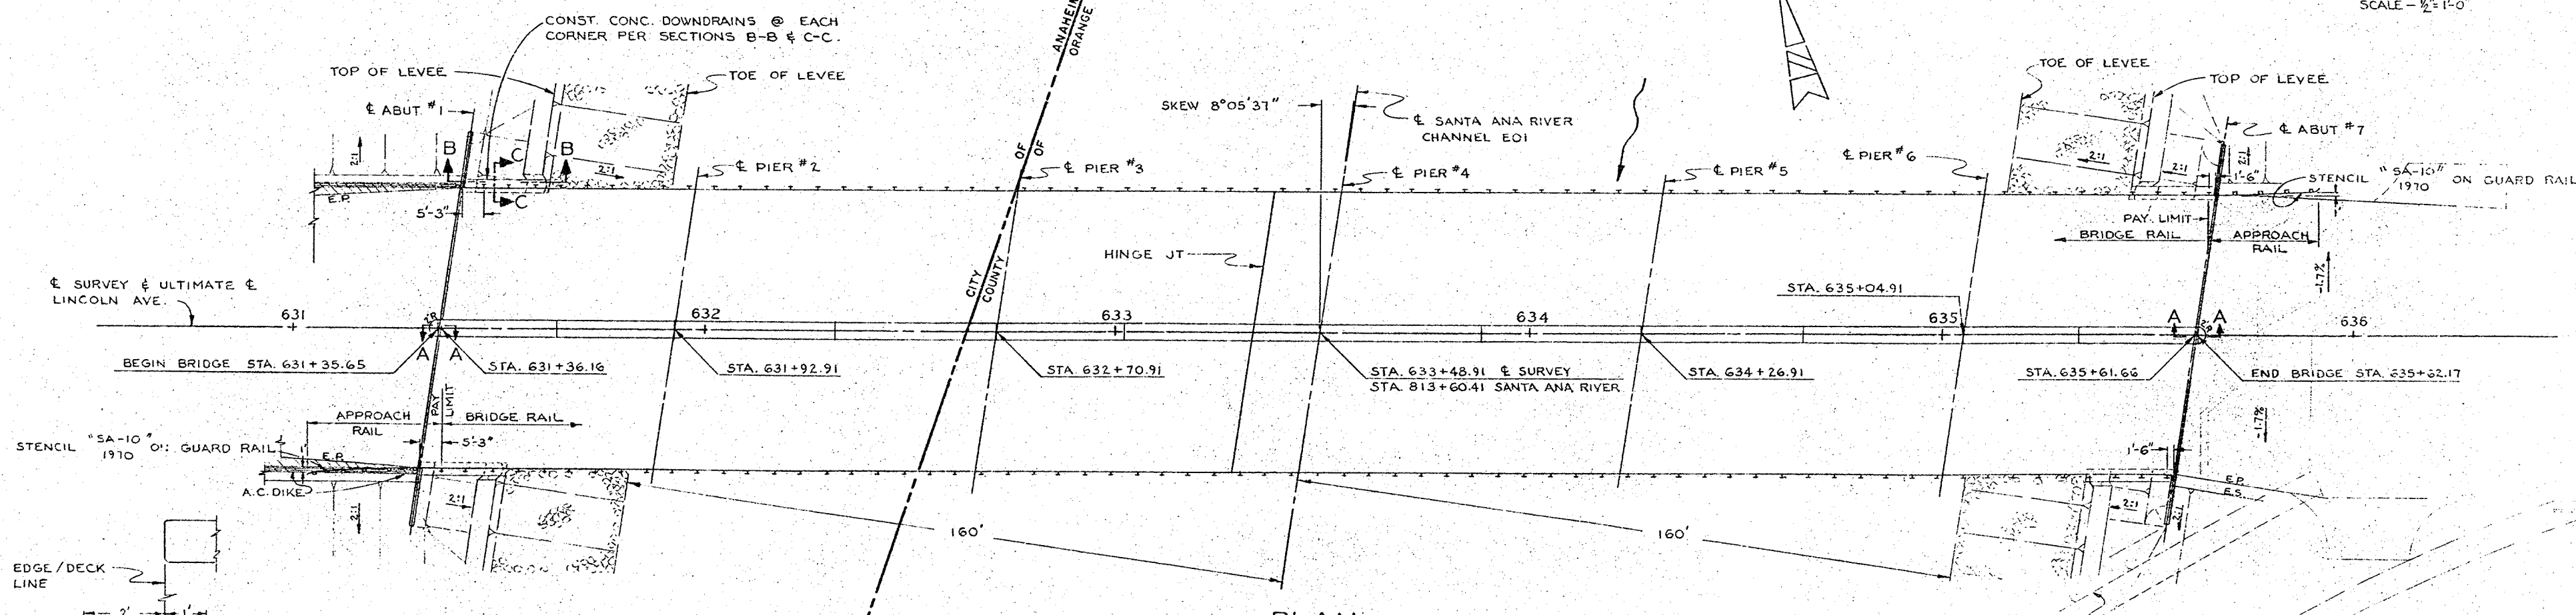


PLAN
SCALE - 1" = 20'


SECTION C-C
SCALE - 1/2" = 1'-0"

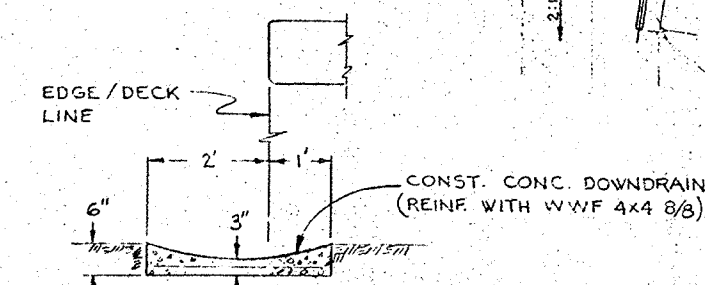

SECTION B-B
SCALE - 1/4" = 1'-0"

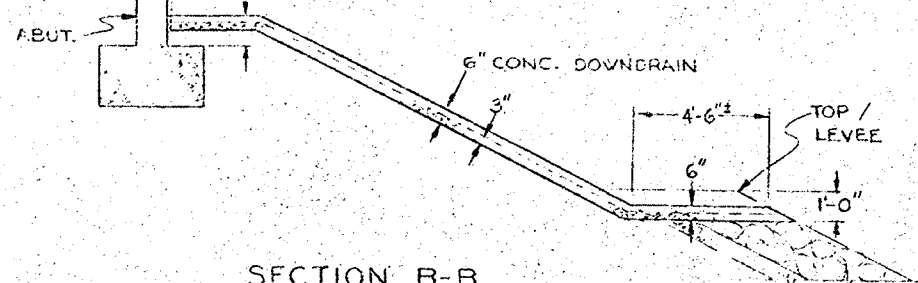

TYPICAL SECTION
SCALE - 1/4" = 1'-0"

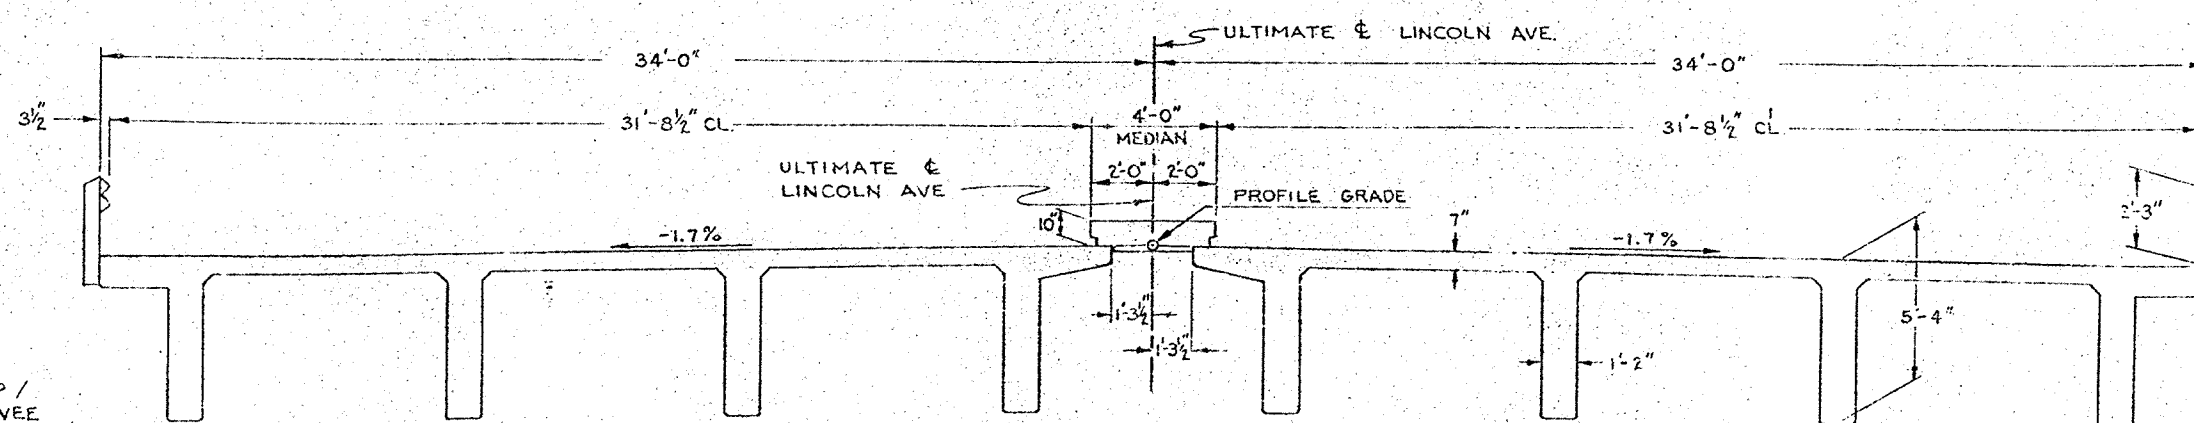

AS BUILT

LINCOLN AVENUE BRIDGE
Plan # 10326
Sheet 10 of 25
Red: 22-1-1
Scale: As Shown
Vellum

LINCOLN AVENUE
BRIDGE SA-10
OVER
SANTA ANA RIVER
GENERAL BRIDGE PLAN

AS NOTED

1-11-25

DR 10/1032