




SECTION A-A
SCALE — 1/4" = 1'-0"

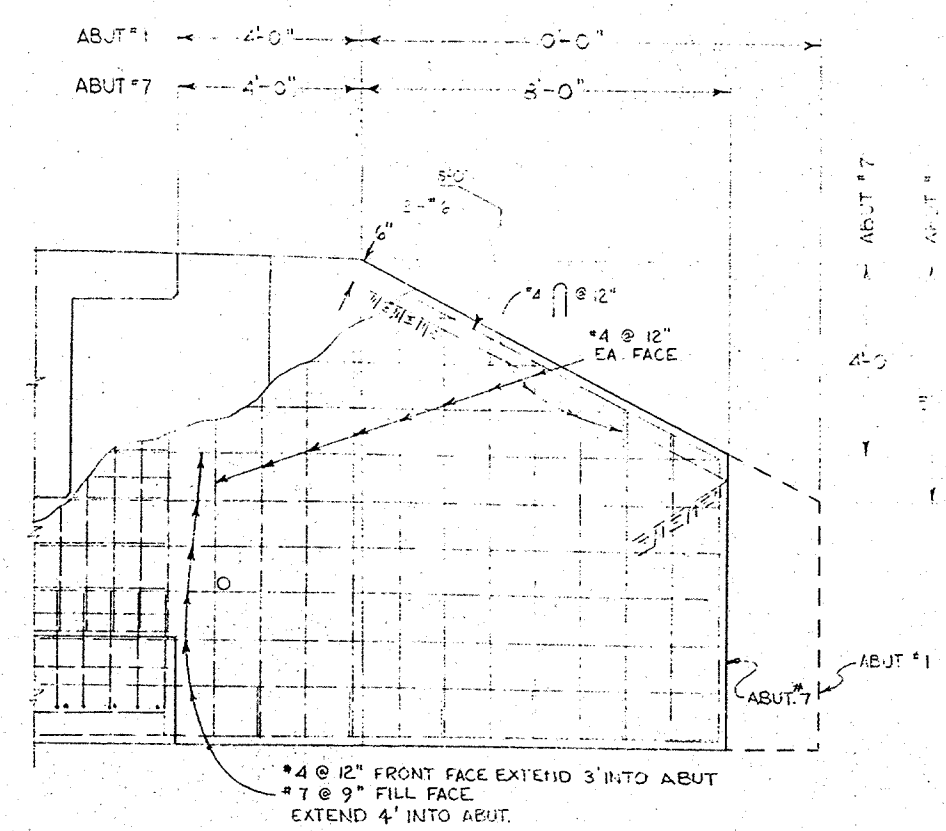

TYPICAL WINGWALL DETAIL
SCALE — 3/8" = 1'-0"

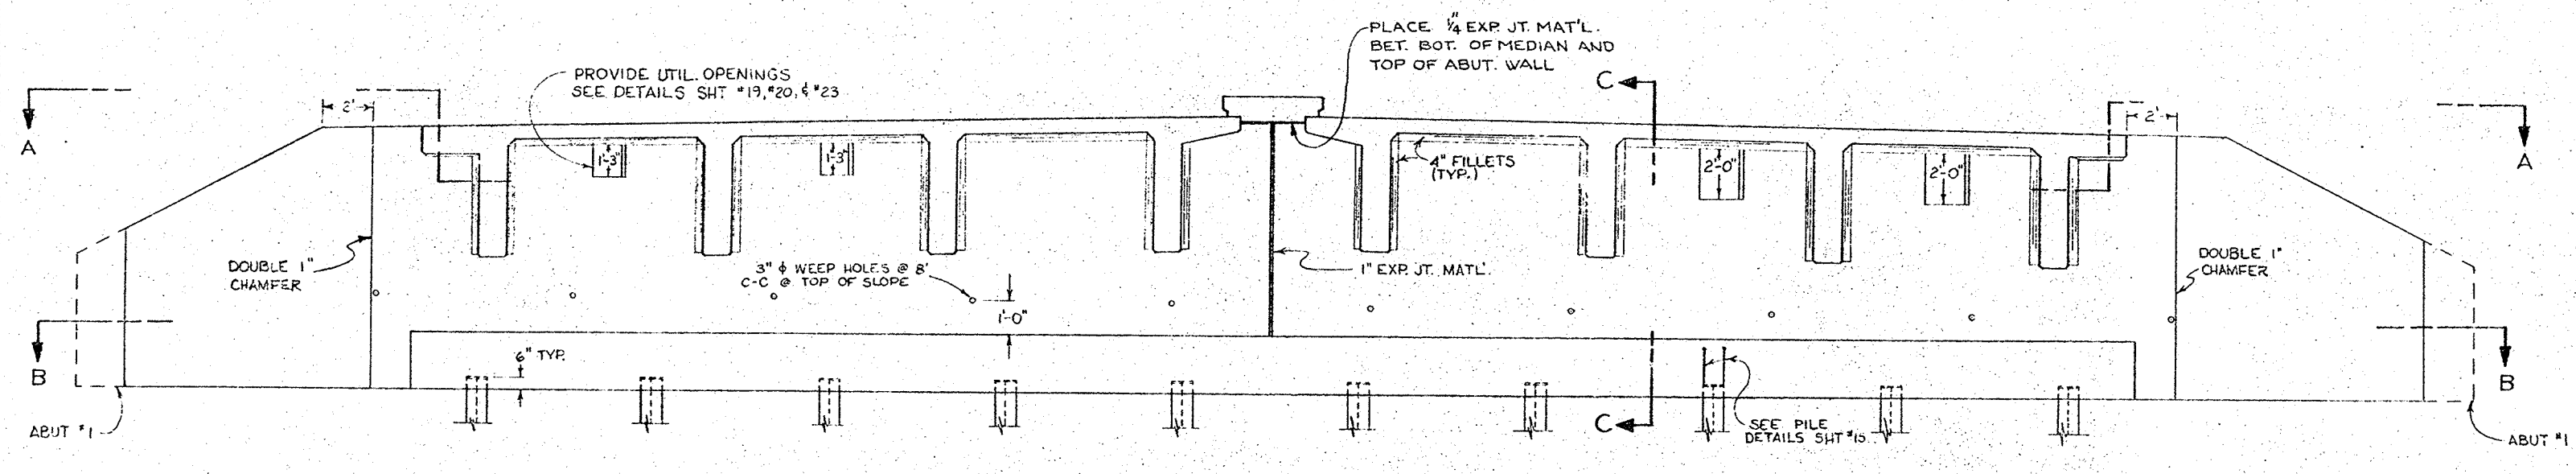


ABUTMENT #7 ELEVATION
ABUTMENT #1 SIMILAR
SCALE — 1/4" = 1'-0"

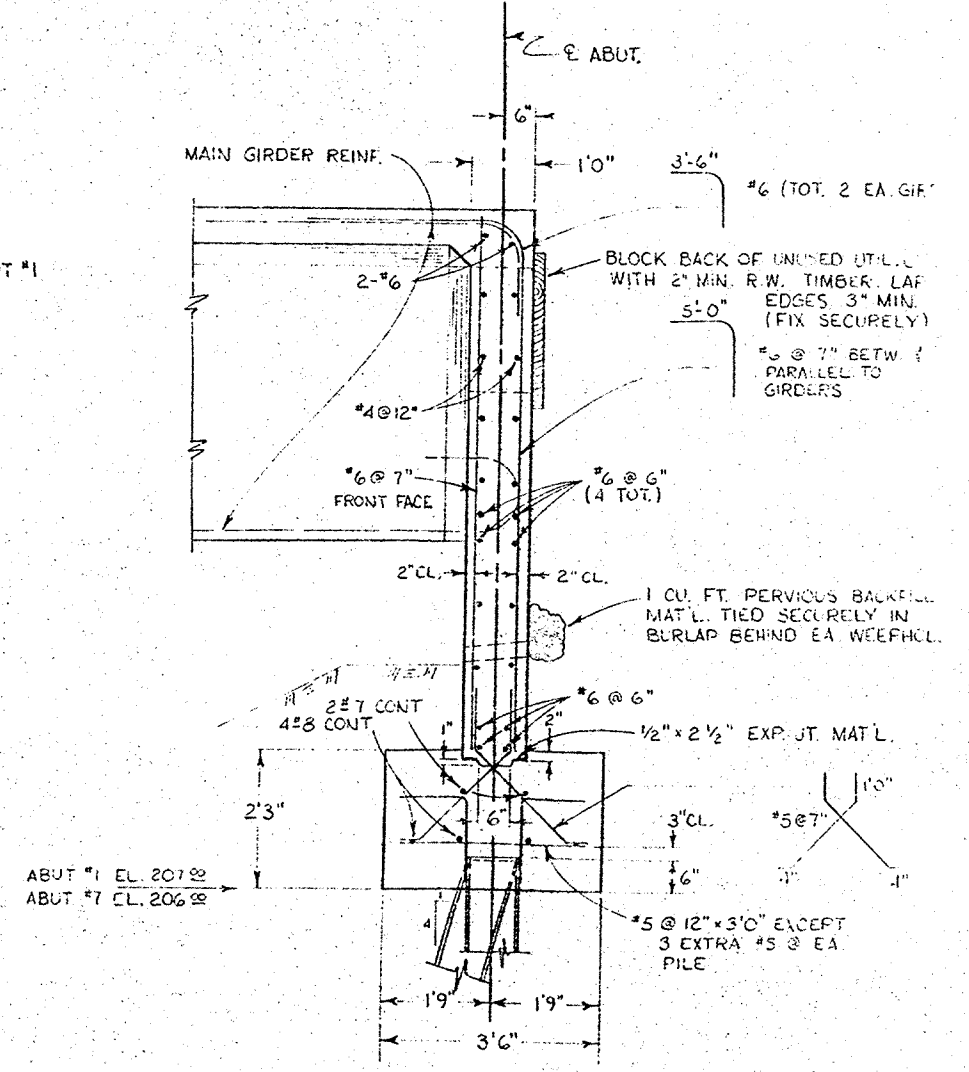

SECTION C-C
SCALE — 1/2" = 1'-0"

AS BUILT

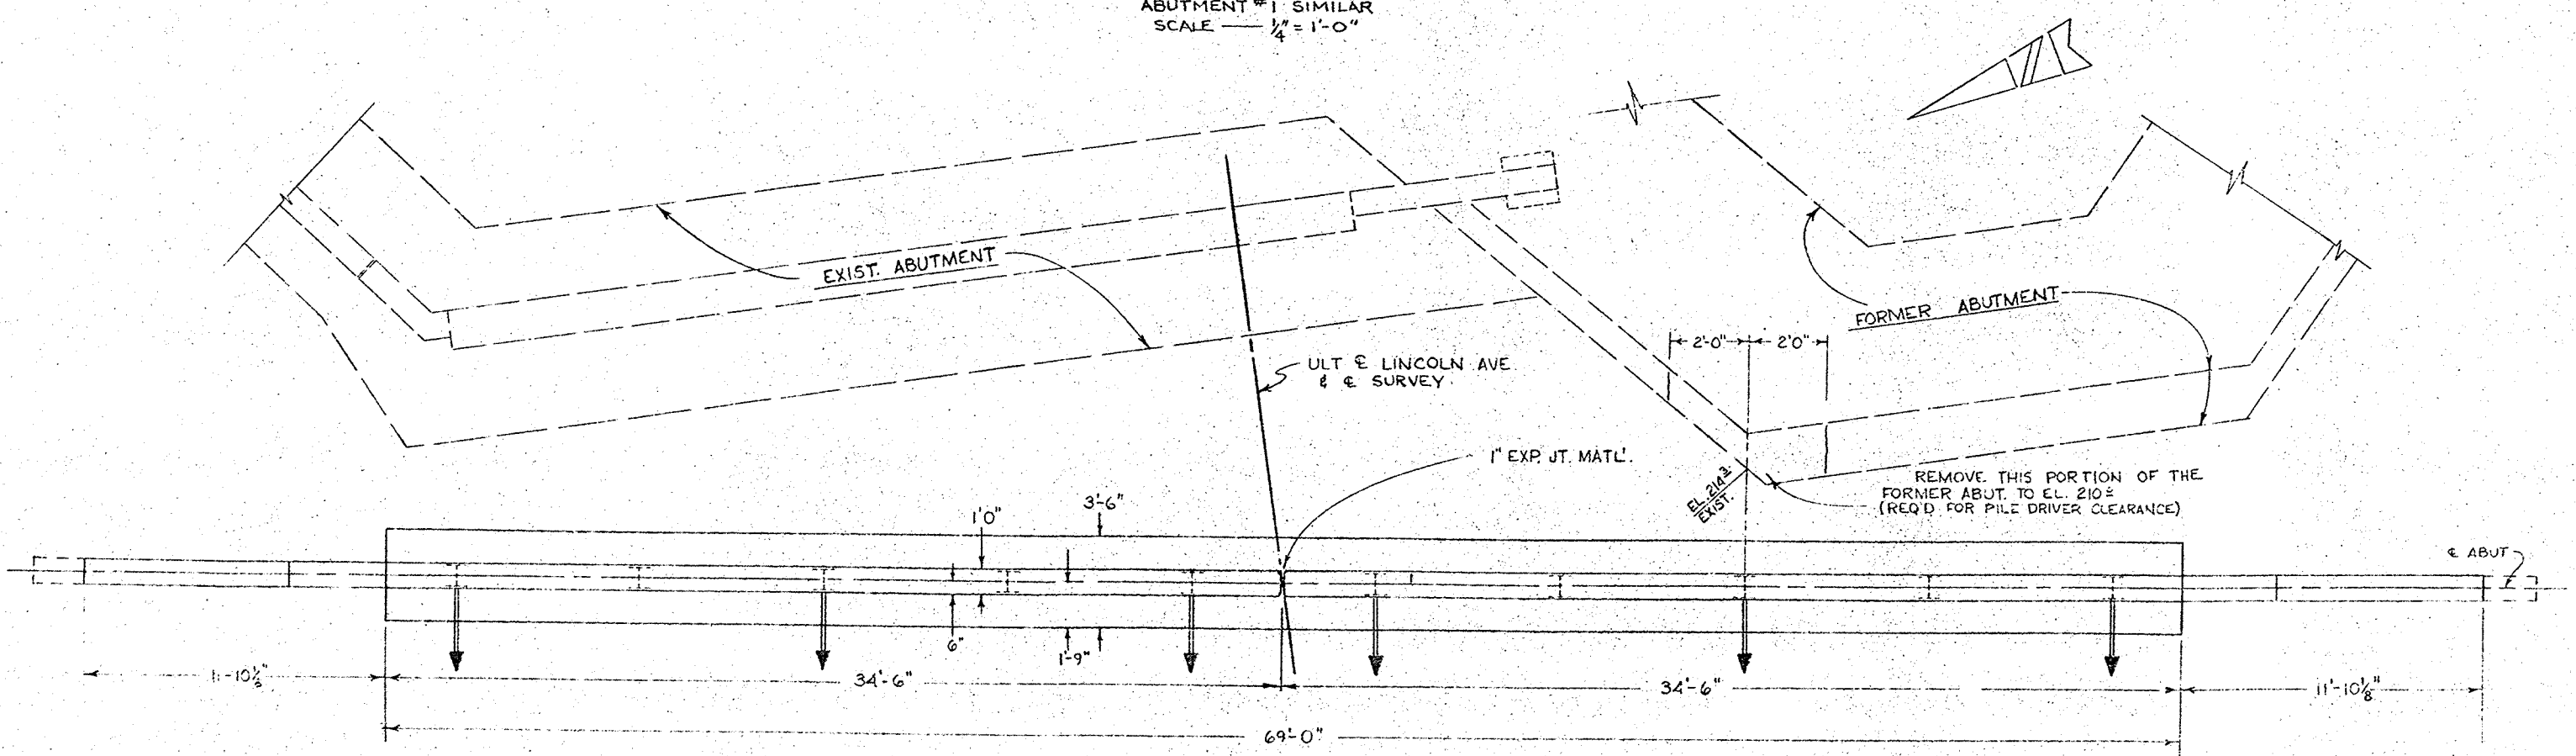

SECTION B-B
SCALE — 1/4" = 1'-0"

— H — SIGNIFIES BATTER 1:4 AND DIRECTION OF BATTER

LINCOLN AVENUE BRIDGE
Plan # 10325
Sheet 16 of 25
Red: 22:5.1
Scale: As Shown
Vellum

LINCOLN AVENUE
BRIDGE SA-10
OVER
SANTA ANA RIVER
ABUTMENT
DETAILS
AS NOTED

DR. 061022