




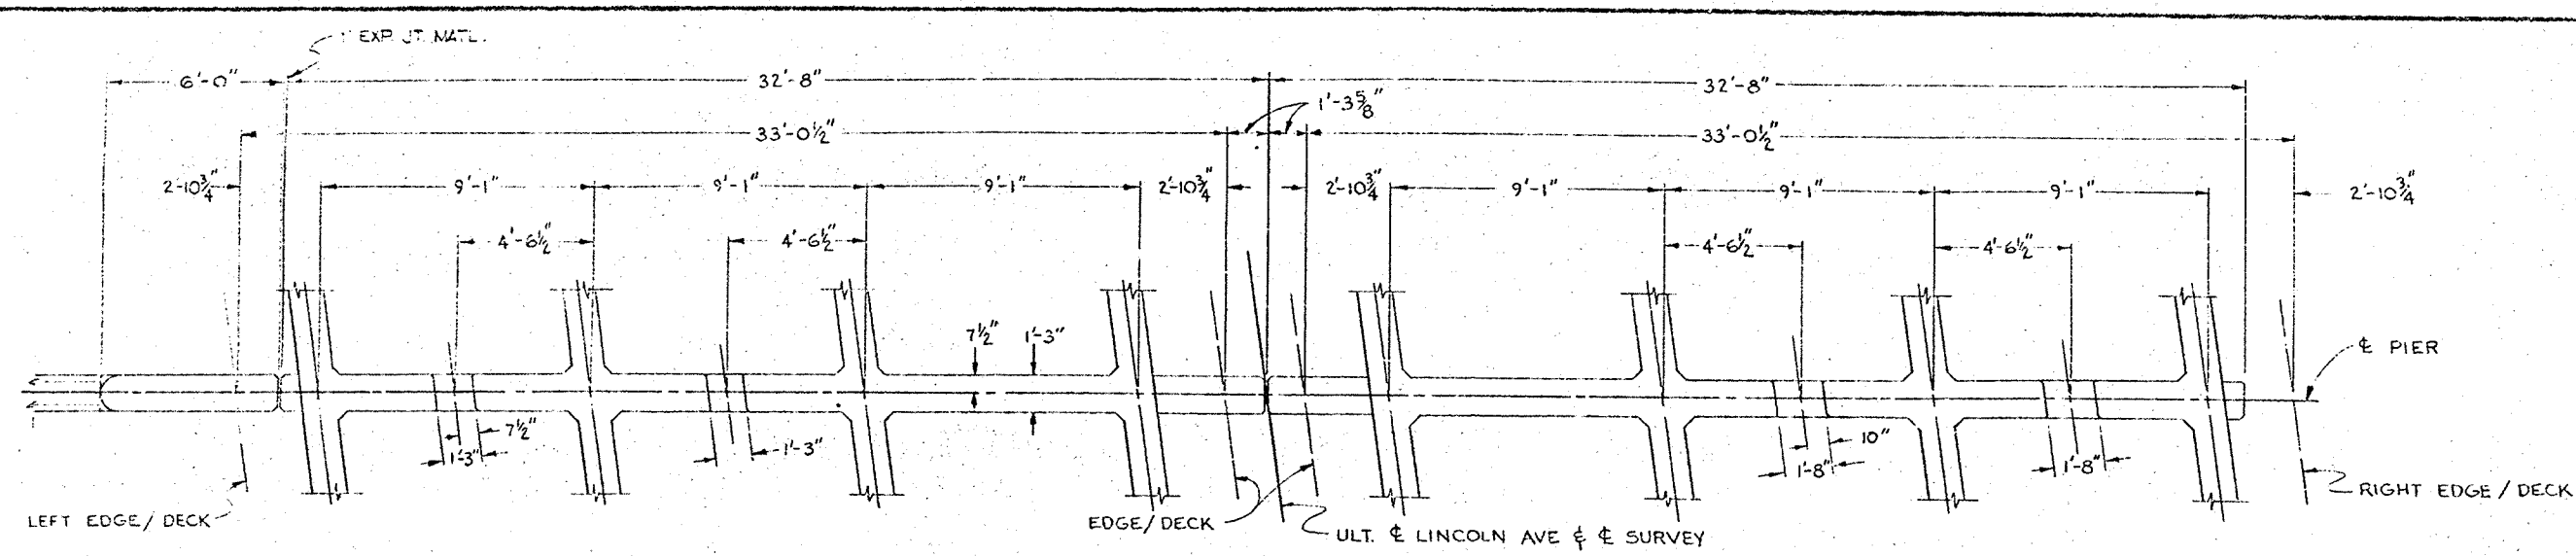


SECTION A-A
SCALE $\frac{1}{4}'' = 1'-0''$

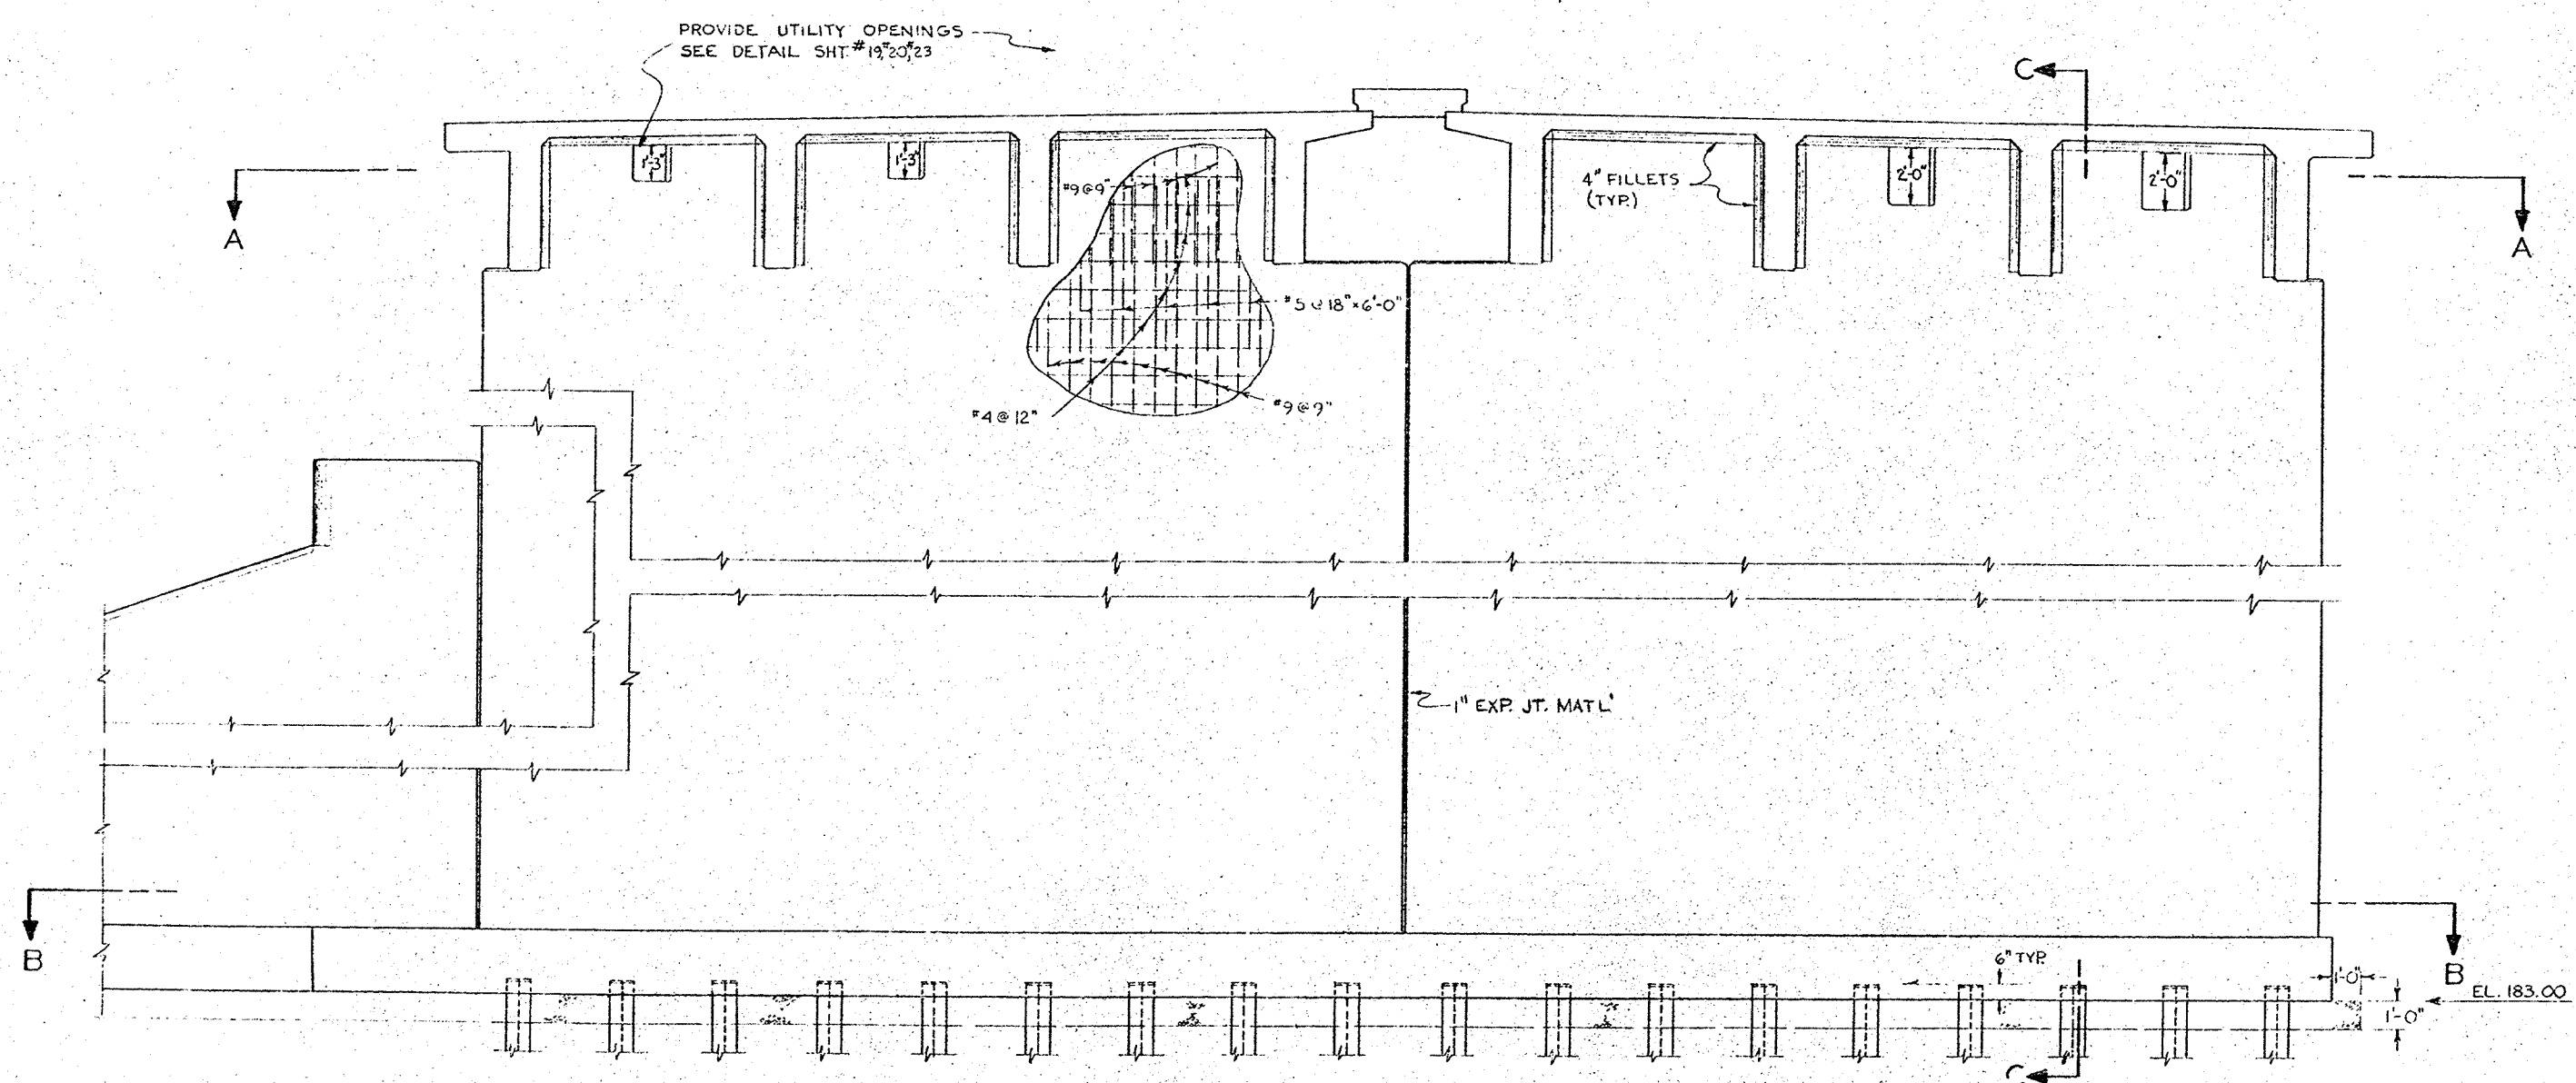

TYPICAL PIER DETAIL
SCALE $\frac{1}{4}'' = 1'-0''$

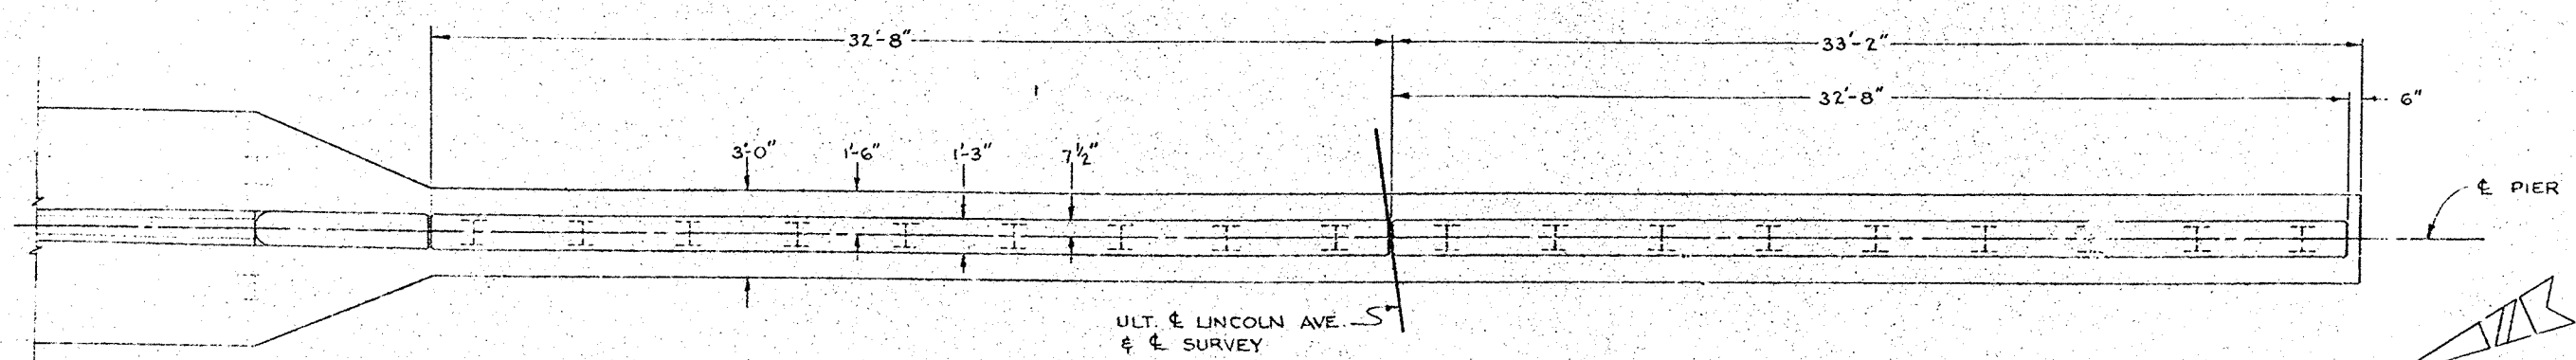

SECTION B-B
SCALE $\frac{1}{4}'' = 1'-0''$

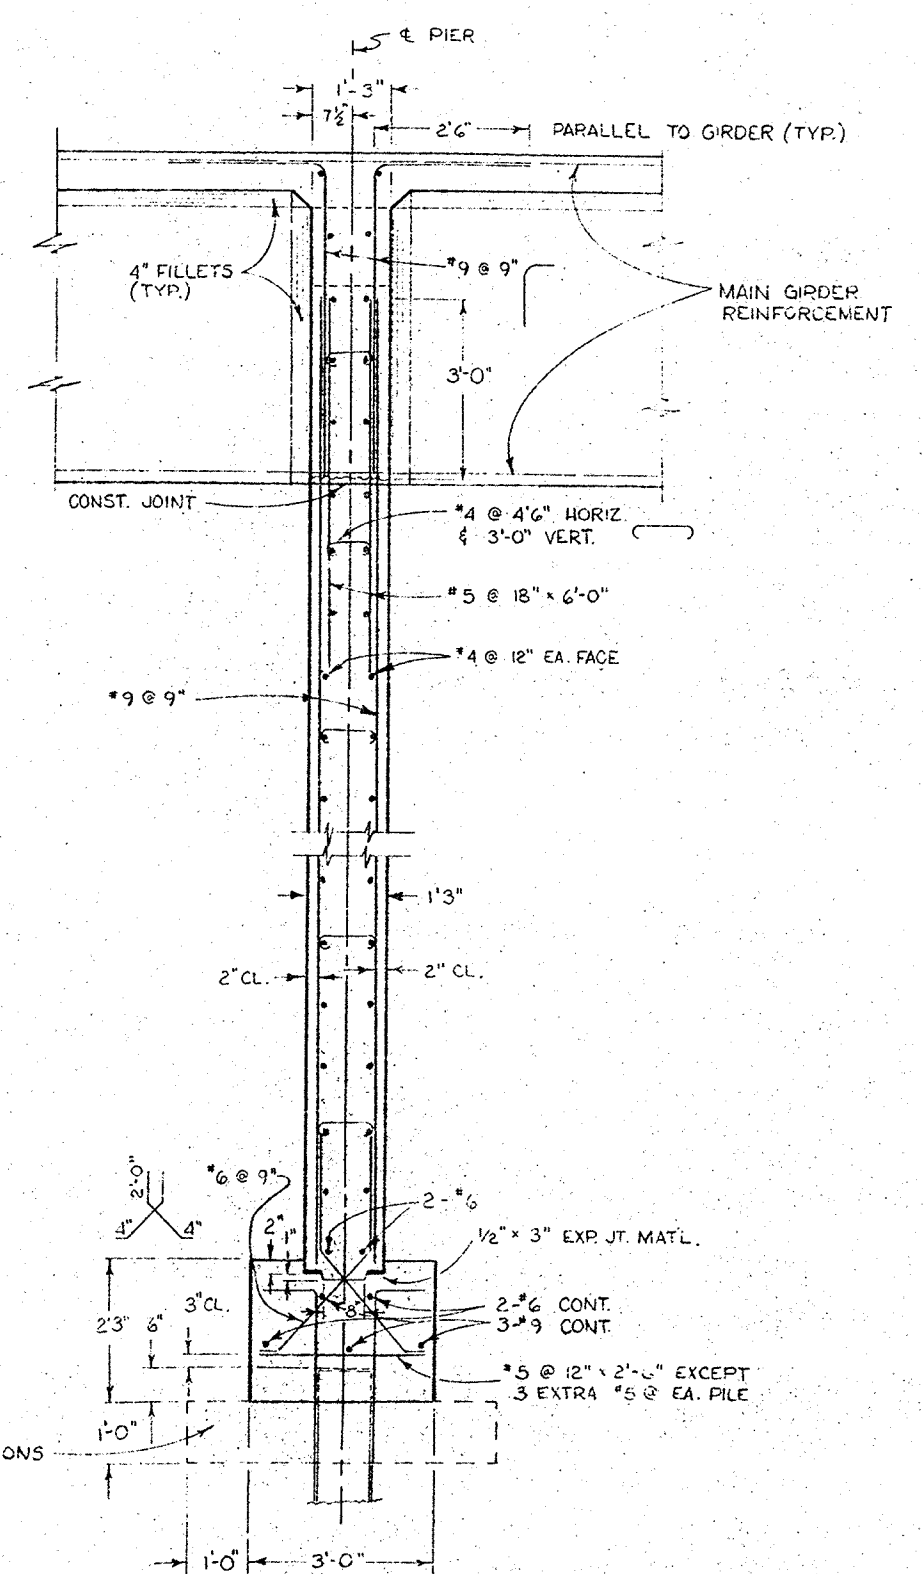

SECTION C-C
SCALE $\frac{1}{2}'' = 1'-0''$

GRAVEL BLANKET
LIMIT OF PAYMENT
SEE SPECIAL PROVISIONS

AS BUILT

LINCOLN AVENUE BRIDGE
Plan # 10326
Sheet 17 of 25
Red: 22:5.1
Scale: As Shown
Yellow

ORANGE COUNTY ROAD DEPARTMENT
LINCOLN AVENUE
BRIDGE SA-10
OVER
SANTA ANA RIVER
PIER DETAILS
AS NOTED

OR 10 103