


EXACT®


STRAIGHT EDGE RULE SE-48

LAYOUT PLAN
SYMMETRICAL ABOUT
E LINCOLN AVE.
E SURVEY

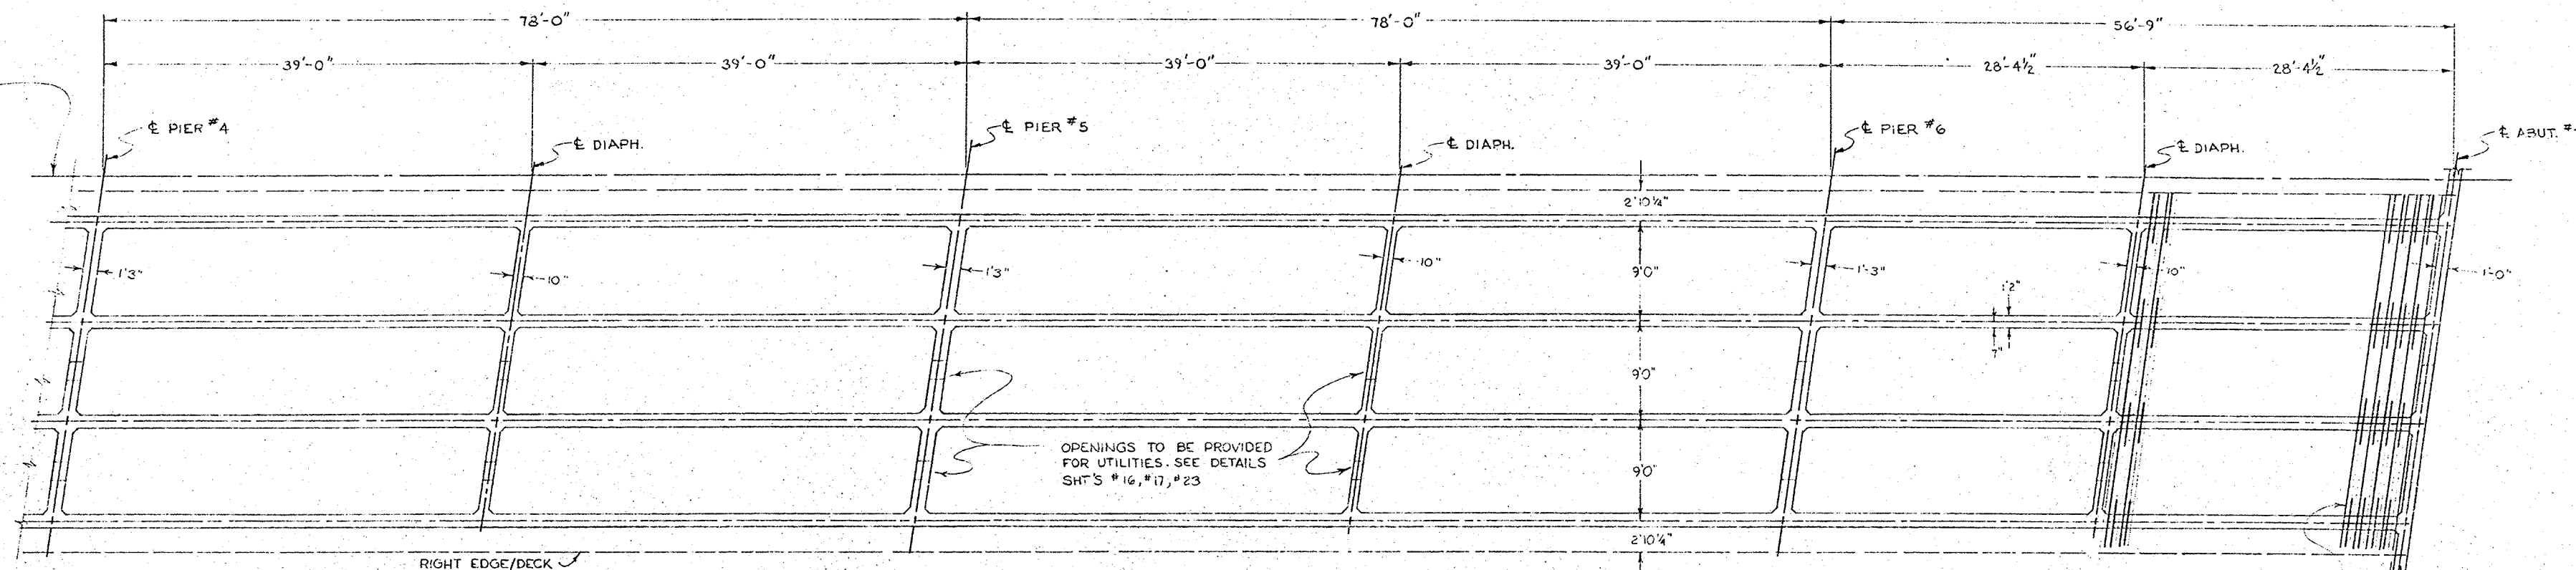


TYPICAL LAYOUT PLAN & DECK REINFORCEMENT

SCALE 1/8" = 1'-0"
S'LY BRIDGE SHOWN - N'LY BRIDGE SYMMETRICAL

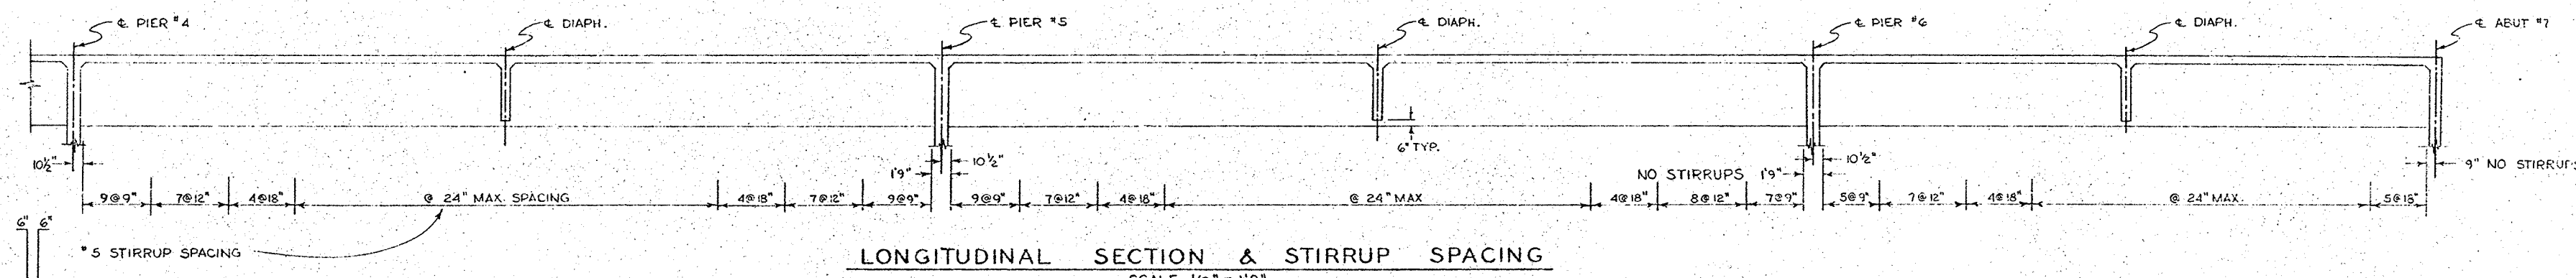

LONGITUDINAL SECTION & STIRRUP SPACING


SCALE 1/8" = 1'-0"

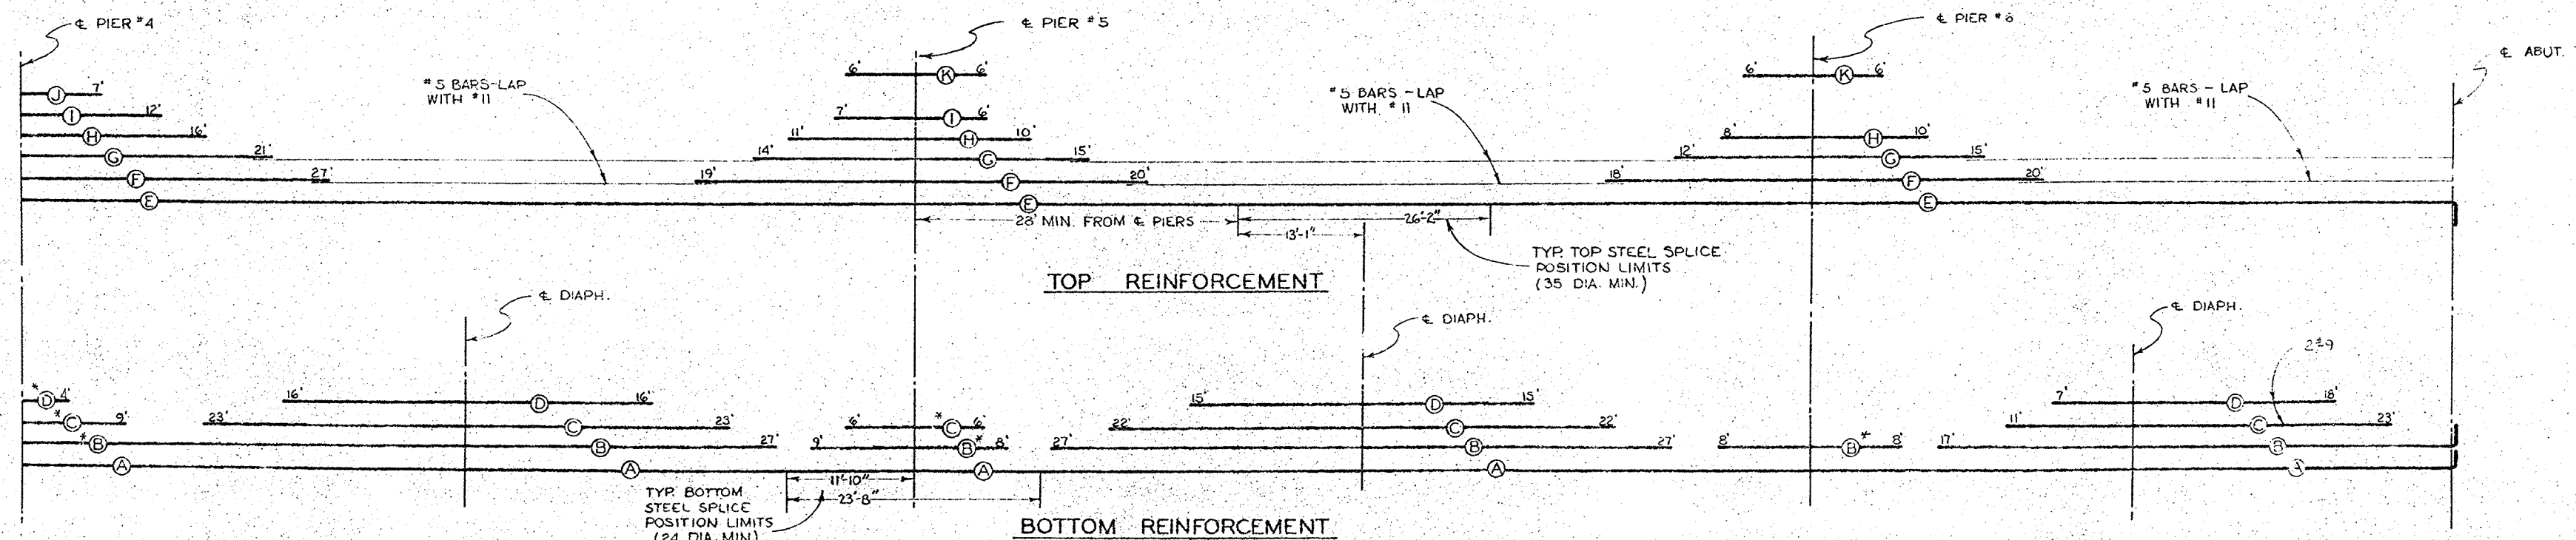


GIRDER REINFORCEMENT

SCALE 1/8" = 1'-0"

NOTE:
ALL MAIN GIRDER REINF ARE #11 BARS EXCEPT NOTED.
DIM. AT END OF BARS ARE FROM E DIAPH (BOT REINF)
AND E PIERS (TOP REINF).
FOR ADDITIONAL REINF IN SLAB OVER INTERMEDIATE
DIAPHRAGMS SEE SHT # 23
* THIS BOT REINF IS DIM. FROM E PIERS

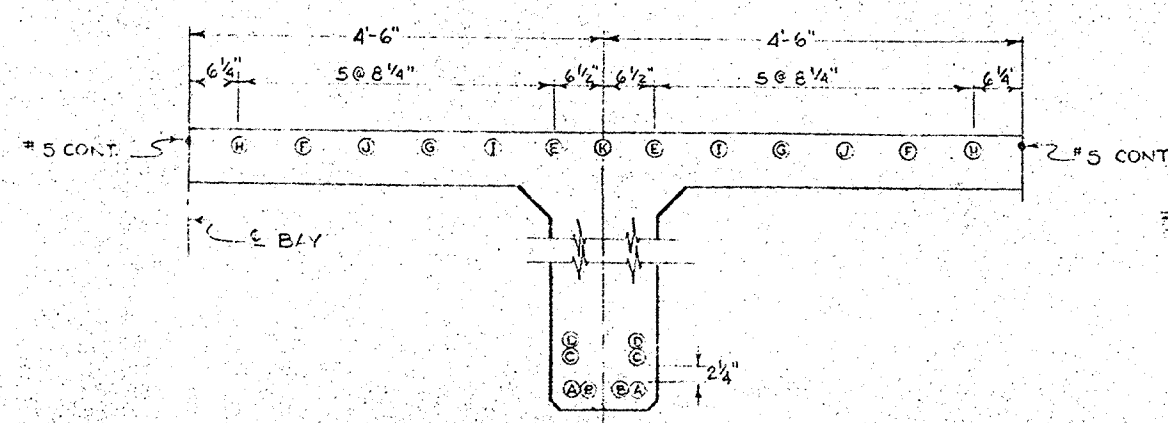

INTERIOR GIRDER REINFORCEMENT PLACING DIAGRAM

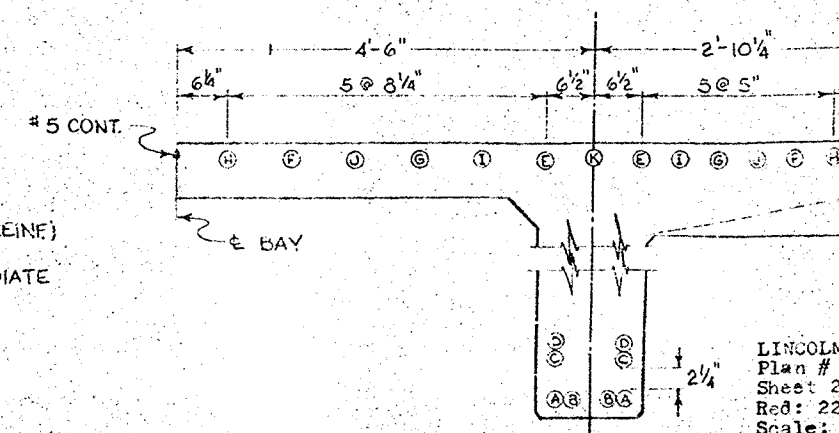

EXTERIOR GIRDER REINFORCEMENT PLACING DIAGRAM

AS BUILT

LINCOLN AVENUE BRIDGE
BRIDGE SA-10
OVER
SANTA ANA RIVER
SUPERSTRUCTURE LAYOUT
& REINFORCEMENT
AS NOTED

DR 10