



FED. ROAD DIST. NO.	STATE	PROJ. NO.	FISCAL YEAR	SHEET NO.	TOTAL SHEETS
7	CAL.			23	20

DIST.	COUNTY	ROUTE	SECTION	SHEET NO.	TOTAL SHEETS
VII	Oran	170	A	4	6


DATE APPROVED: SEPTEMBER 27, 1954

"AS BUILT"
NO CORRECTIONS
C.P. Hall for P.E.
3-6-56


DESCRIPTION	STATIONING	E. PROFILE GRADE
E. Abut. No. 1	18 + 32.00	40.25
E. Pier No. 2	19 + 16.00	40.35
E. Pier No. 3	20 + 00.00	40.47
E. Pier No. 4	20 + 84.00	40.58
E. Abut. No. 5	21 + 68.00	40.61

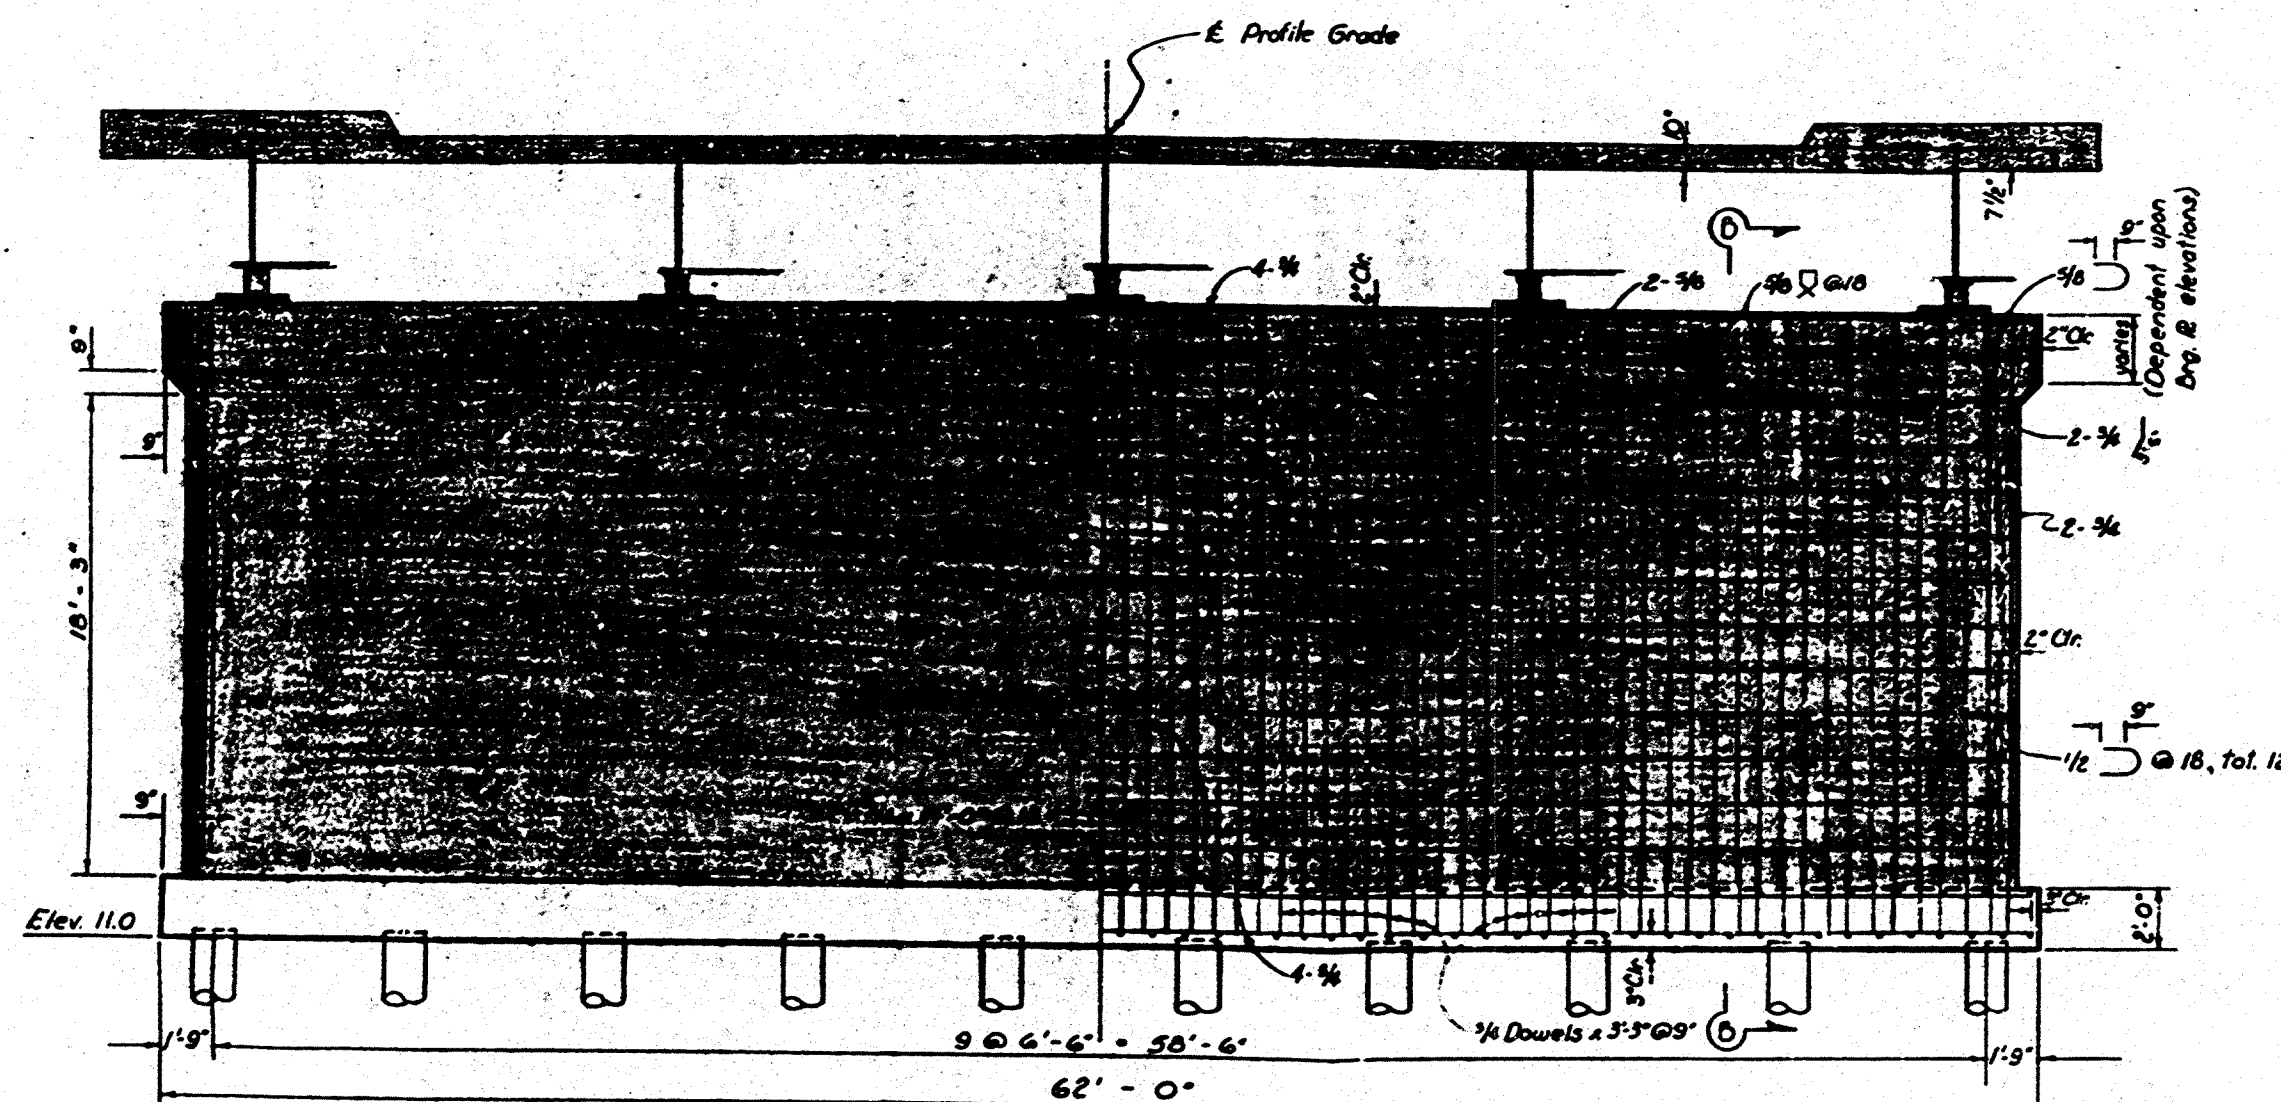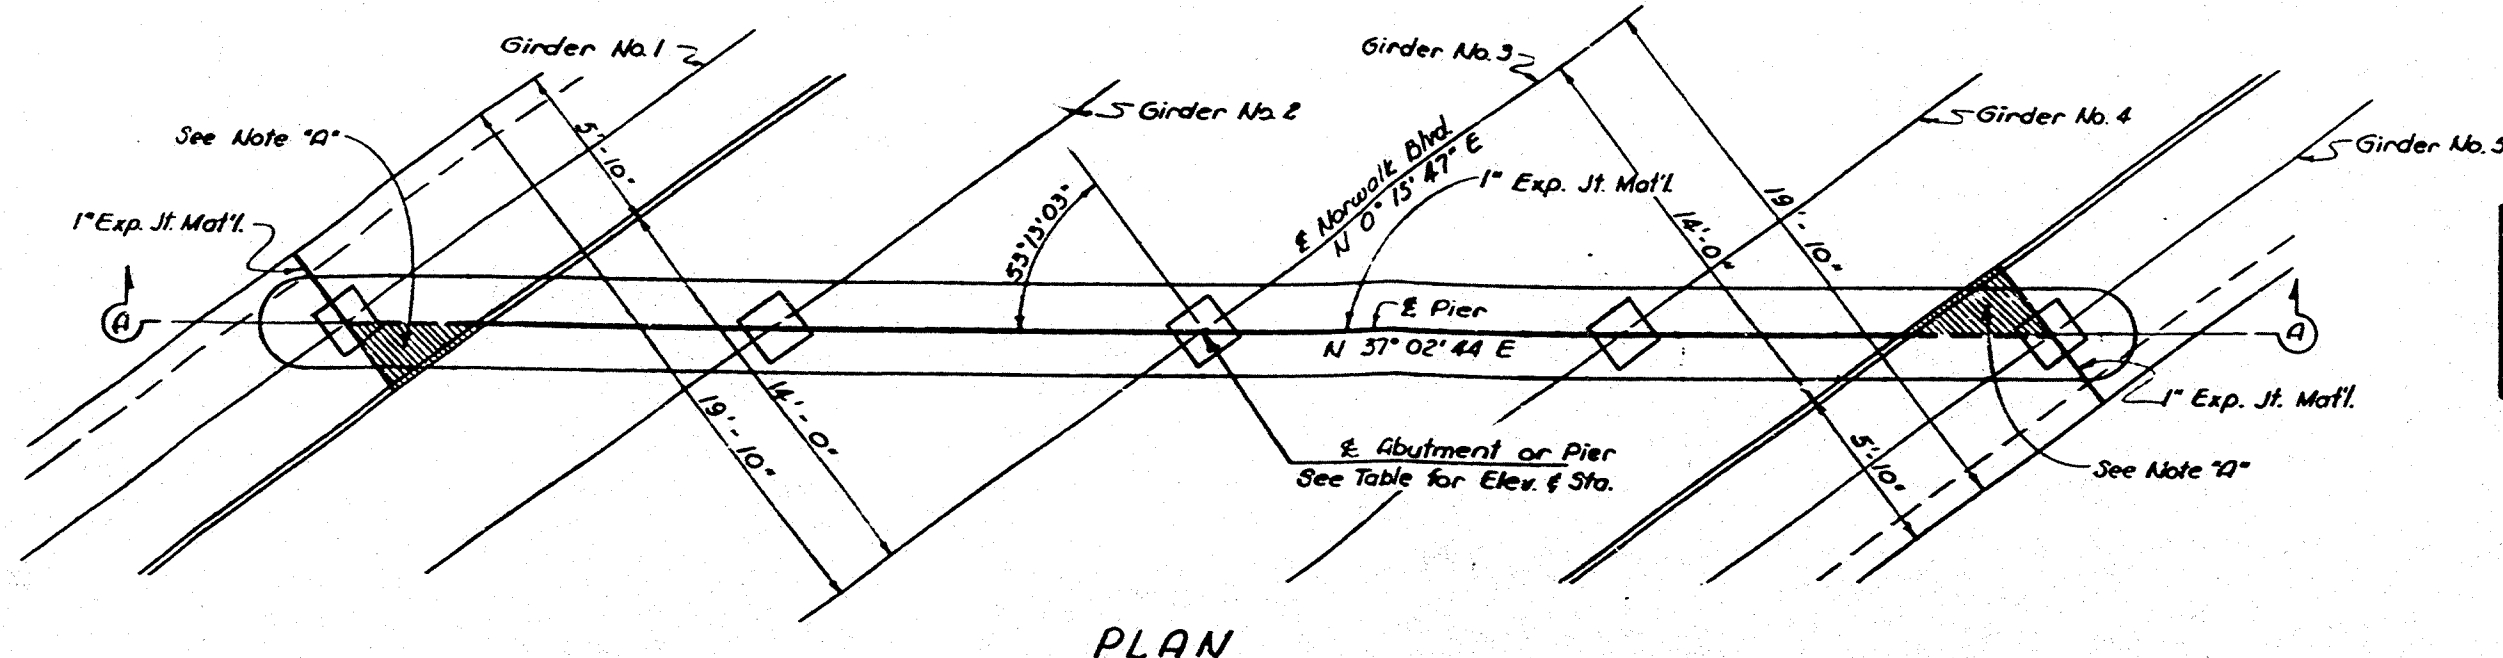

SECTION A-A

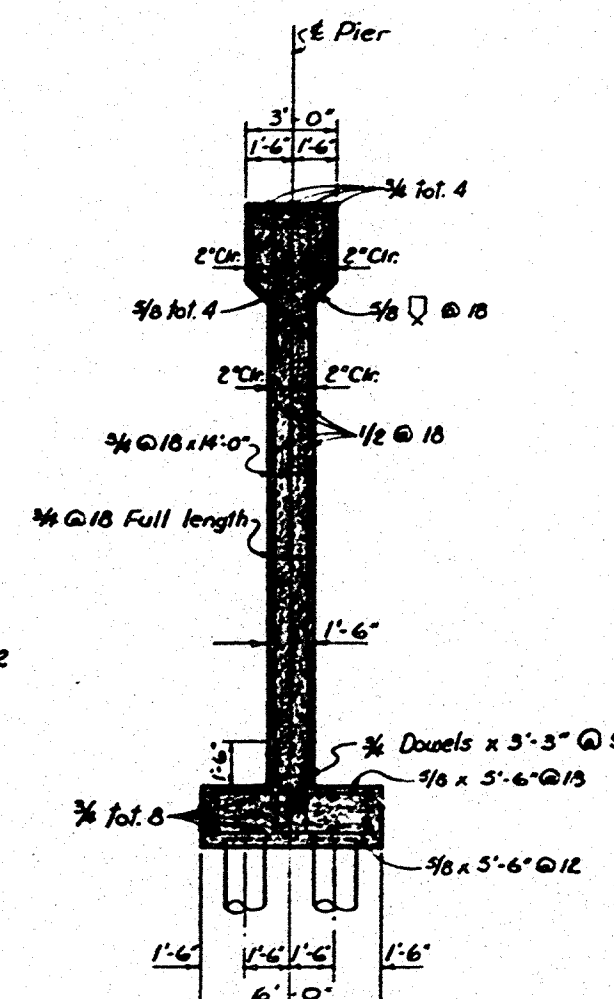

SECTION B-B

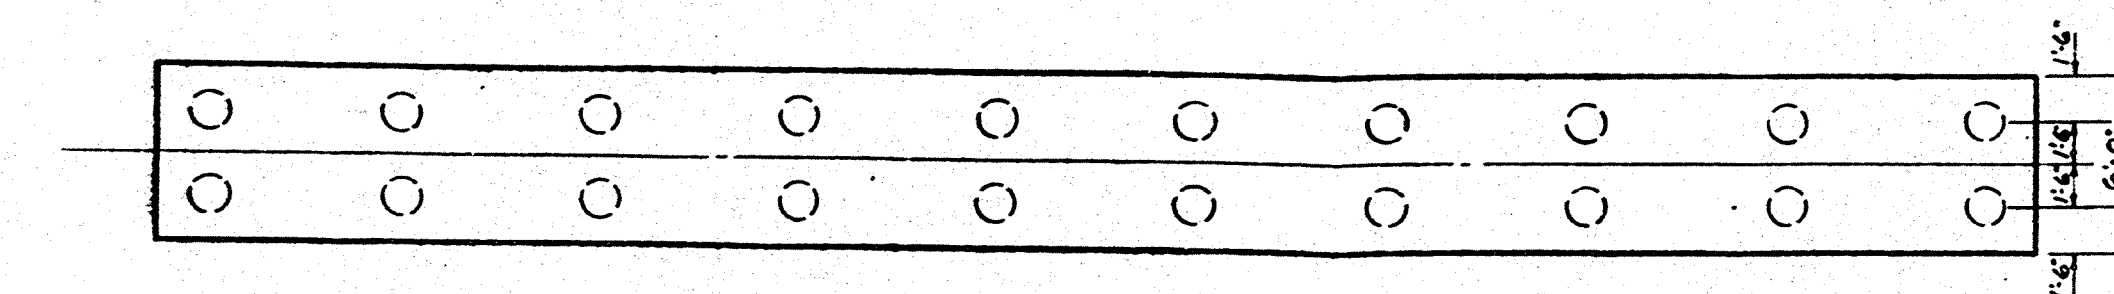

FOOTING PLAN

NOTE "A"
1/8" Tempered Masonite, smooth side up
and oiled over 1/2" Celotex, or equal.

Note: For remainder of Abutment Details, see Sht 3

STATE OF CALIFORNIA DEPARTMENT OF PUBLIC WORKS DIVISION OF HIGHWAYS			
COYOTE CREEK BRIDGE			
55C-52 TYPICAL PIER DETAILS			
SCALE 1/4" = 1'-0"	BRIDGE 55-136	FILE	DRAWING C-3832-4

PREL. DRAWING NO. P. 3832

Bridge 11108