

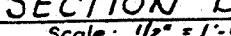
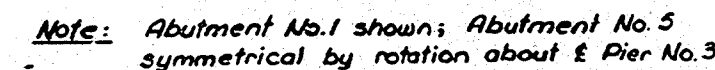


NO CORRECTIONS
C.R.V. J. R.E.
3-6-56

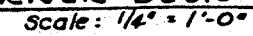

For remainder of pier details, see Sheet No. 4

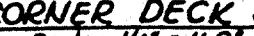

Bridges(11108)