


FED. ROAD DIST. NO.	STATE	PROJ. NO.	FISCAL YEAR	SHEET NO.	TOTAL SHEETS
7	CAL.			25	


DIST.	COUNTY	ROUTE	SECTION	SHEET NO.	TOTAL SHEETS
VII	Oran	170	A	6	10

"As Built"
Coyote Cr. B.E.
3-6-56


DATE APPROVED: SEPTEMBER 27, 1954

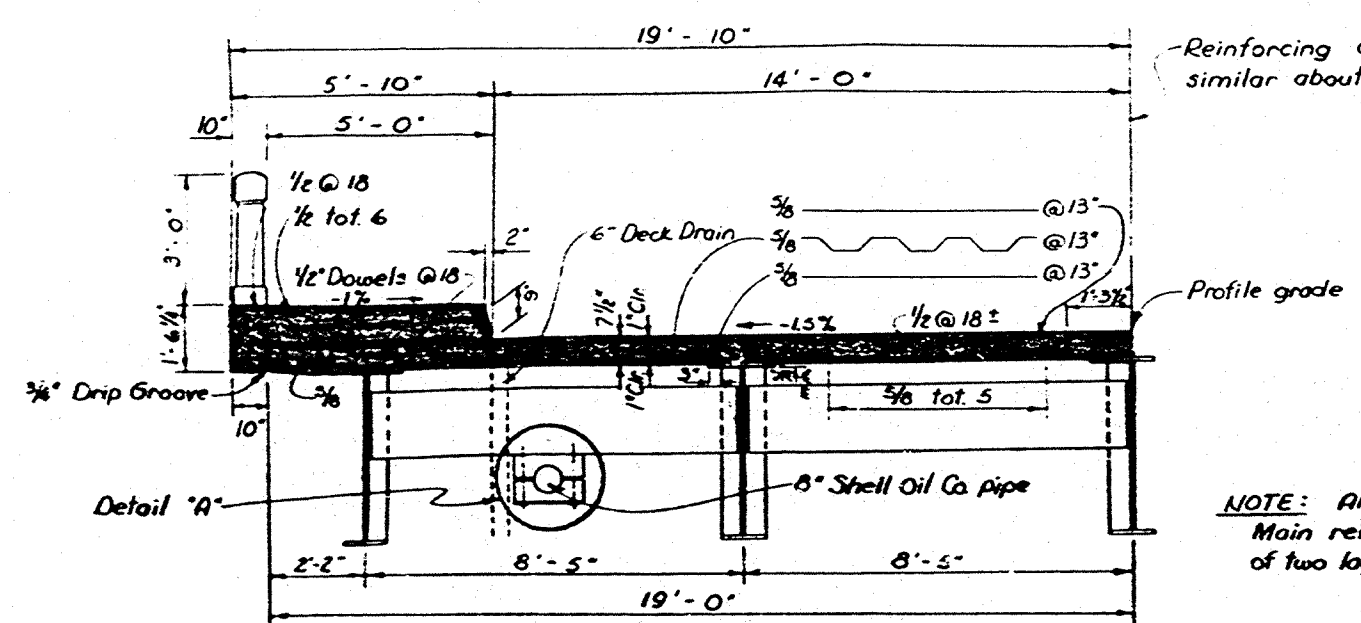


TYPICAL DECK HALF-SECTION
Scale: 3/8" = 1'-0"

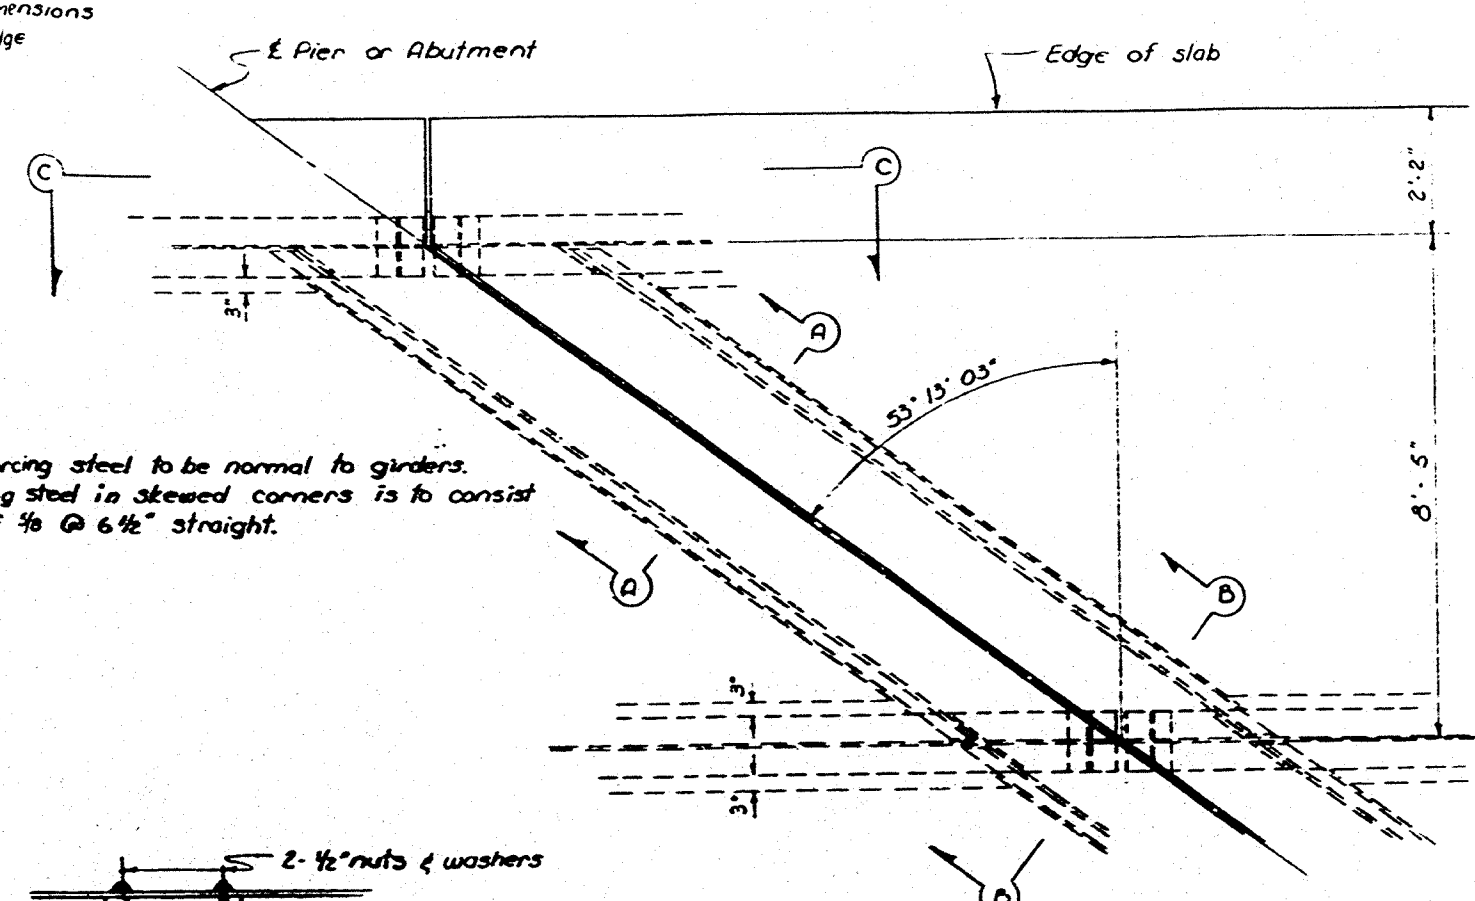

TYPICAL JOINT DETAILS
Scale: 1/2" = 1'-0"

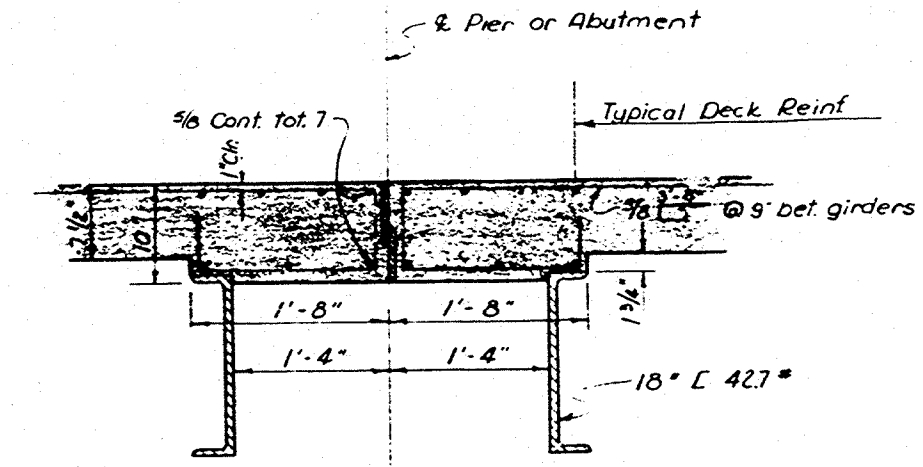


SECTION A-A
Scale: 1" = 1'-0"

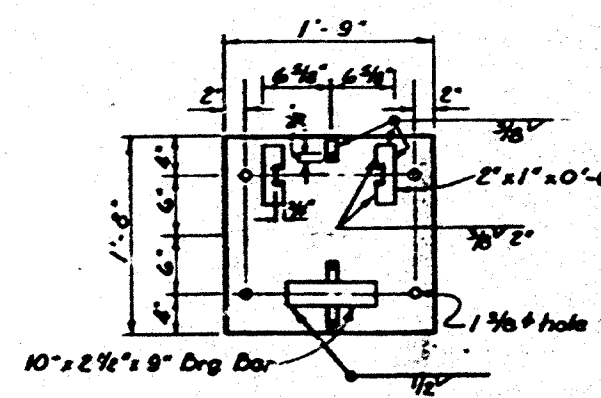


MASONRY PLATE
DETAILS
Scale: 1" = 1'-0"

KEEPER BAR DETAILS
Scale: 1" = 1'-0"

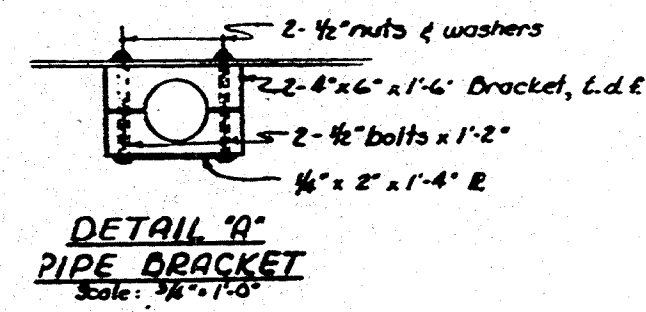


DETAIL 'A'
PIPE BRACKET
Scale: 3/8" = 1'-0"


FIXED BEARING BAR
DETAIL
Scale: 1" = 1'-0"

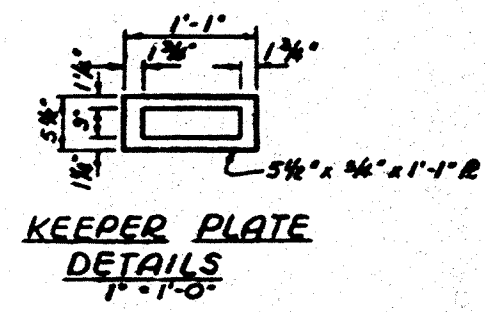


KEEPER PLATE
DETAILS
Scale: 1" = 1'-0"

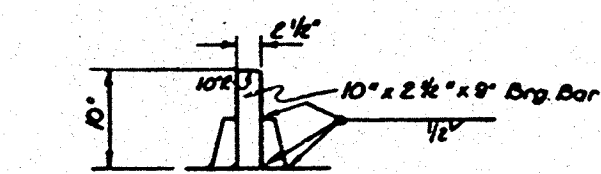


FIXED BEARING BAR
DETAIL
Scale: 1" = 1'-0"

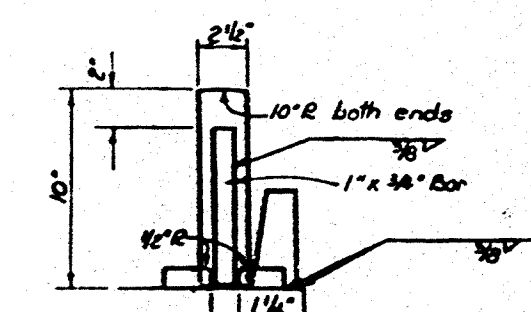


ROCKER BAR DETAILS
Scale: 1" = 1'-0"

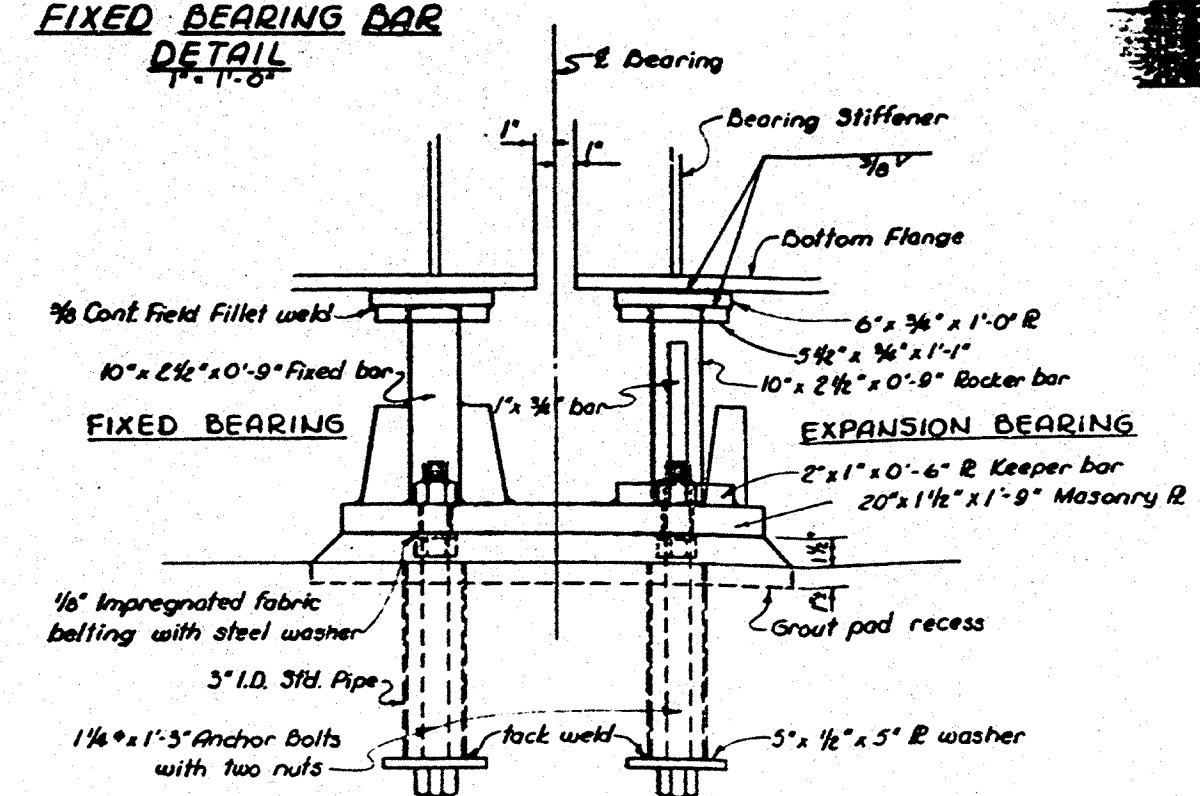

BEARING DETAIL
Scale: 2" = 1'-0"

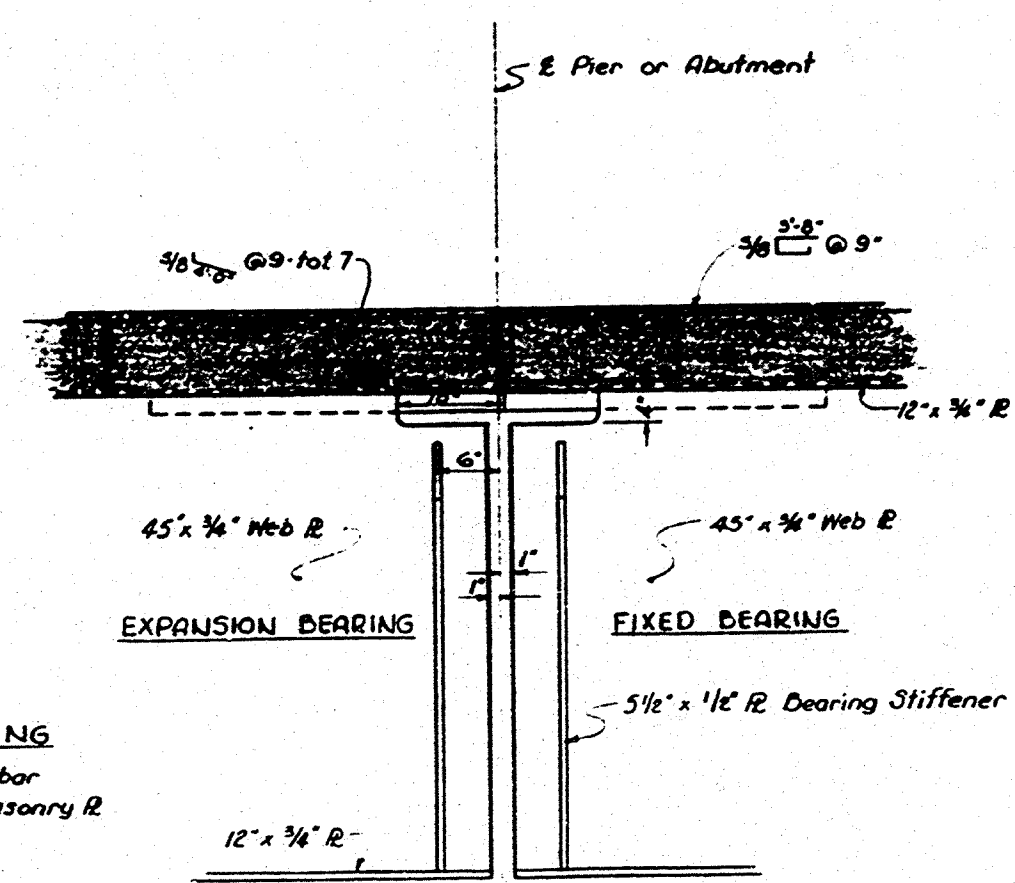

SECTION C-C
Scale: 1" = 1'-0"

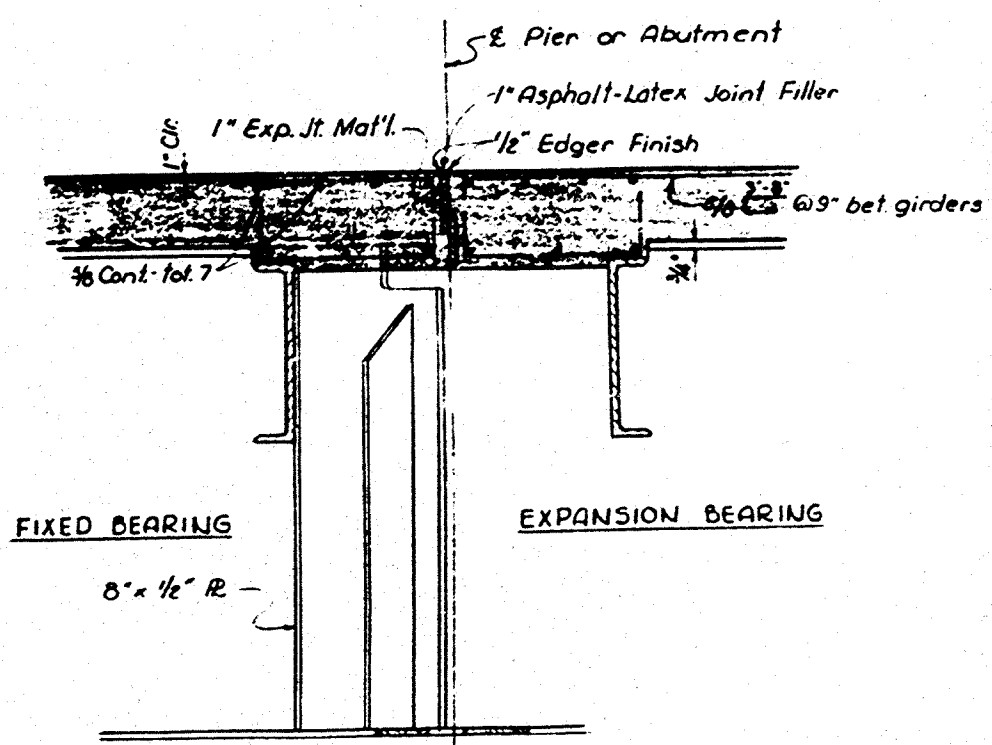

SECTION B-B
Scale: 1" = 1'-0"

NOTE: For Details of Paving Notch and back wall, see Sht. No. 3

Note: For Drain Details see Sheet No. 8

STATE OF CALIFORNIA DEPARTMENT OF PUBLIC WORKS DIVISION OF HIGHWAYS			
COYOTE CREEK BRIDGE 55C-52			
TYPICAL SECTION & DETAILS			
SCALE As Noted	BRIDGE 55-136	FILE	DRAWING 6-232-6

PREL. DRAWING NO. P. 3832

Bridges 11108

BRIDGE DEPARTMENT