




"As Built"
CR Hall Jr. P.E.
3-7-56

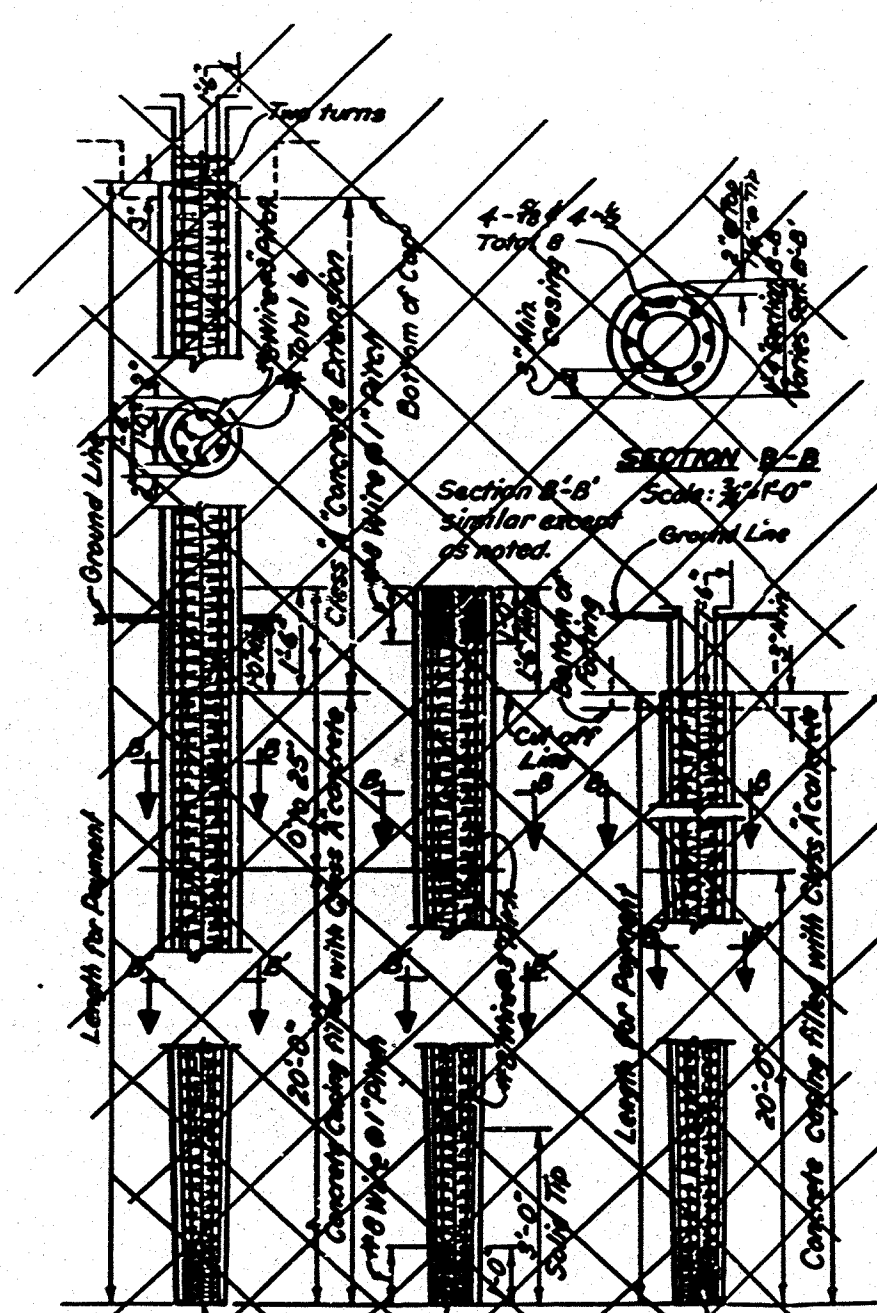


**CAST-IN-PLACE CONCRETE PILE
ALTERNATIVE "W"**

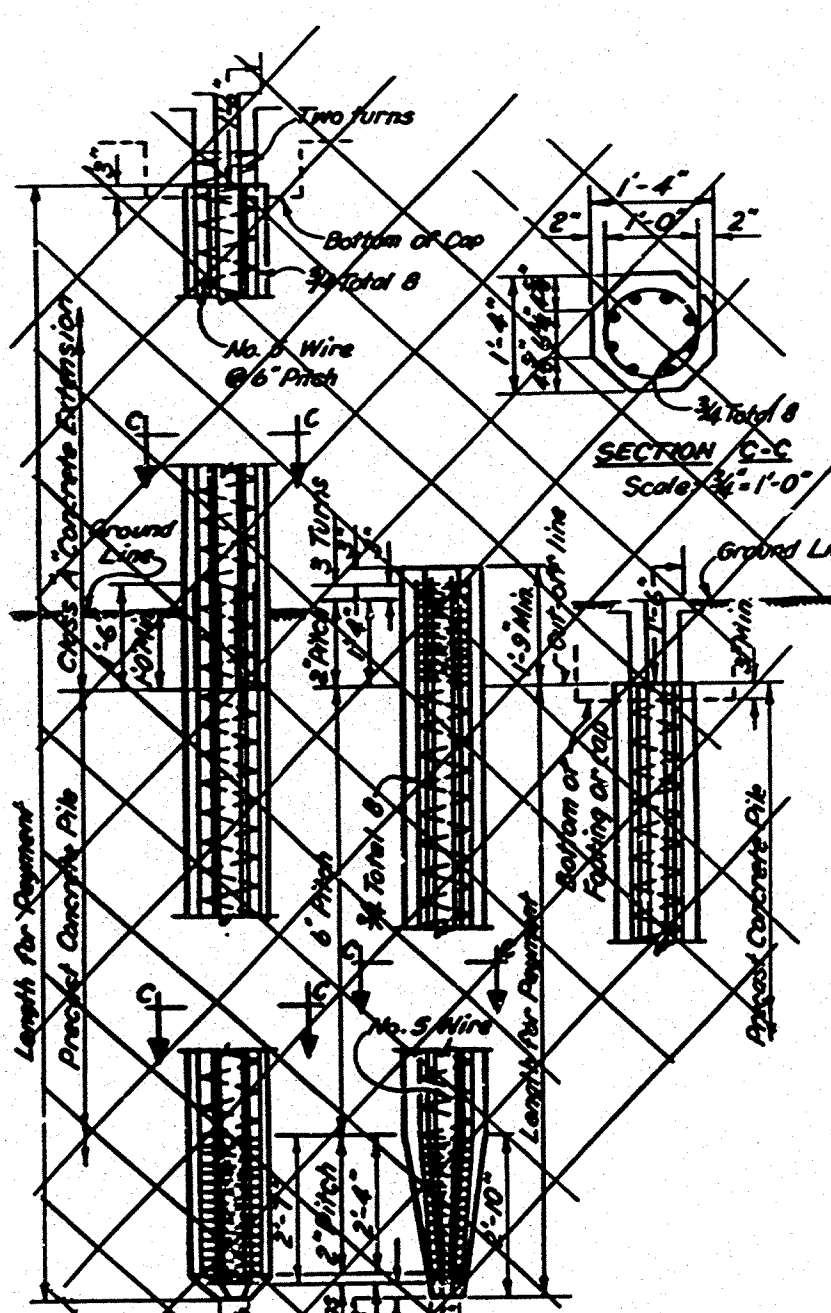

**PRECAST CONCRETE PILE
ALTERNATIVE "X"**

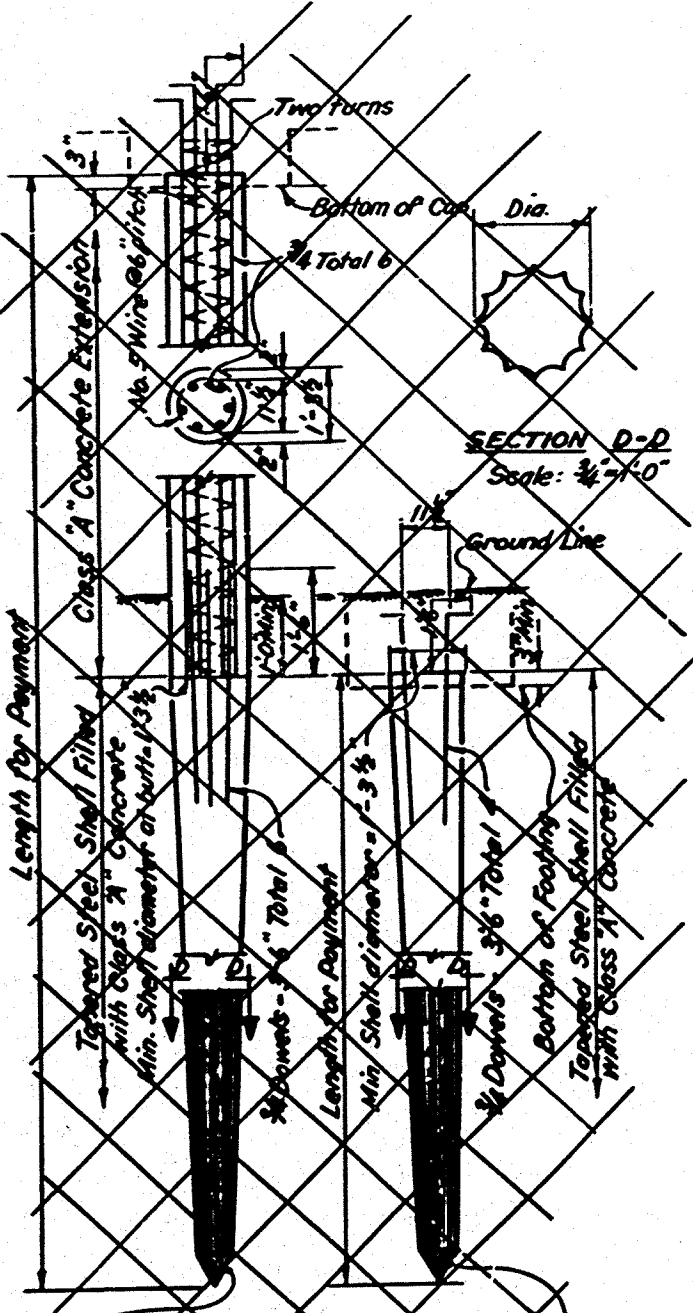

**CAST-IN-PLACE CONCRETE PILE
ALTERNATIVE "Y"**

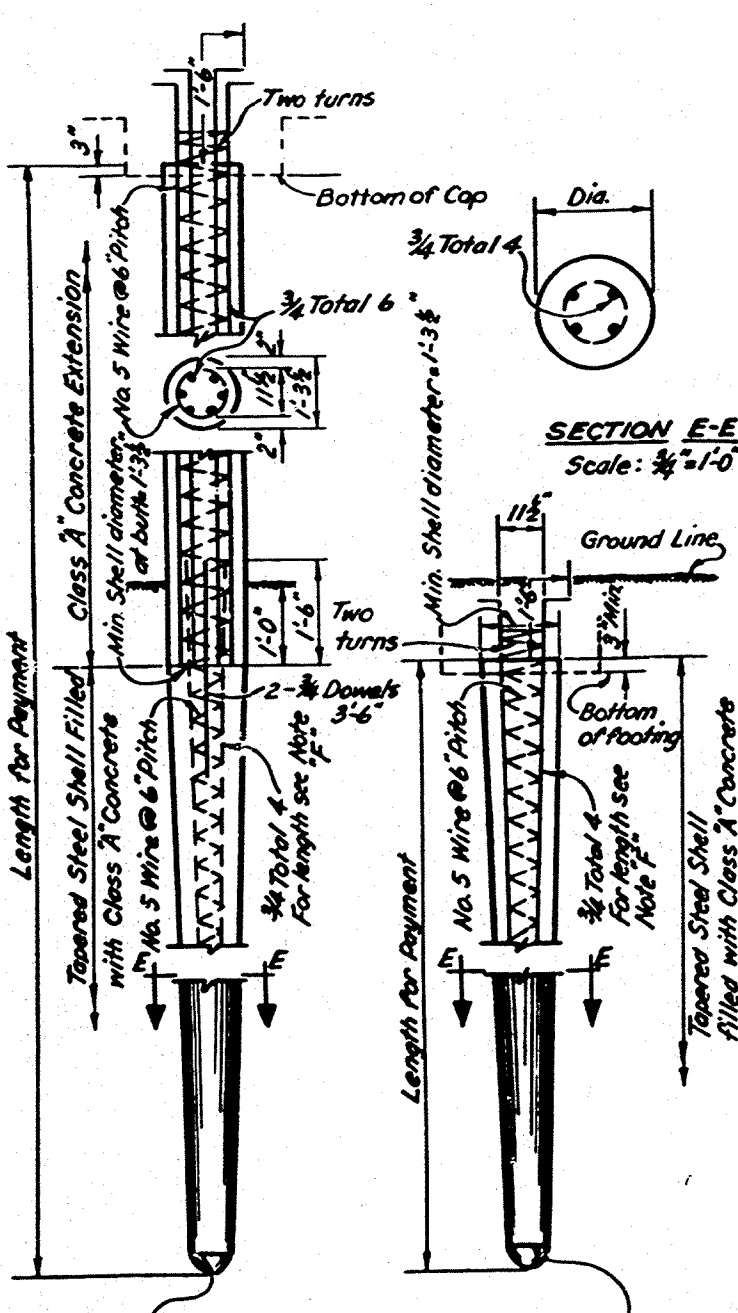

**CAST-IN-PLACE CONCRETE PILE
ALTERNATIVE "Z"**

Note: For Alternatives "W" and "X" the piles may be driven full length and cut off without extension or they may be extended as shown at the option of the Contractor.

Note E: Length of 3/4" round bars, measured below ground line or bottom of footing, to be either 1/3 of estimated penetration or 12" whichever is the greater. For total length of bars, add extension or splice.

STATE OF CALIFORNIA DEPARTMENT OF PUBLIC WORKS DIVISION OF HIGHWAYS	
COYOTE CREEK BRIDGE	
55C-52 PILE DETAILS	
EXCEPT AS NOTED SCALE: 3/4"=1'-0"	BRIDGE 55-136
FILE XS-10-76	DRAWING C-3E2-7
PREL. DRAWING NO. P. 3632	

Bridges (1108)

Revised by WCKB-52
STANDARD DWG.

Initial Date	
Design	WCKB-52
Detail	R.A. 6-52
Check	R.H. 6-52
Quant	
Check	
Supervised	W. Chas. Davis

BRIDGE DEPARTMENT

REVISION

By	Length
REVISION BY	DATE
CHANGED BY	
REVISION BY	

DESIGNED BY	WCKB-52
CHECKED BY	R.A. 6-52
APPROVED BY	R.H. 6-52
DATE	11-1-52
PROJECT NO.	55-136
BRIDGE NO.	55-136
SECTION	C-3E2-7
APPROVED BY	