

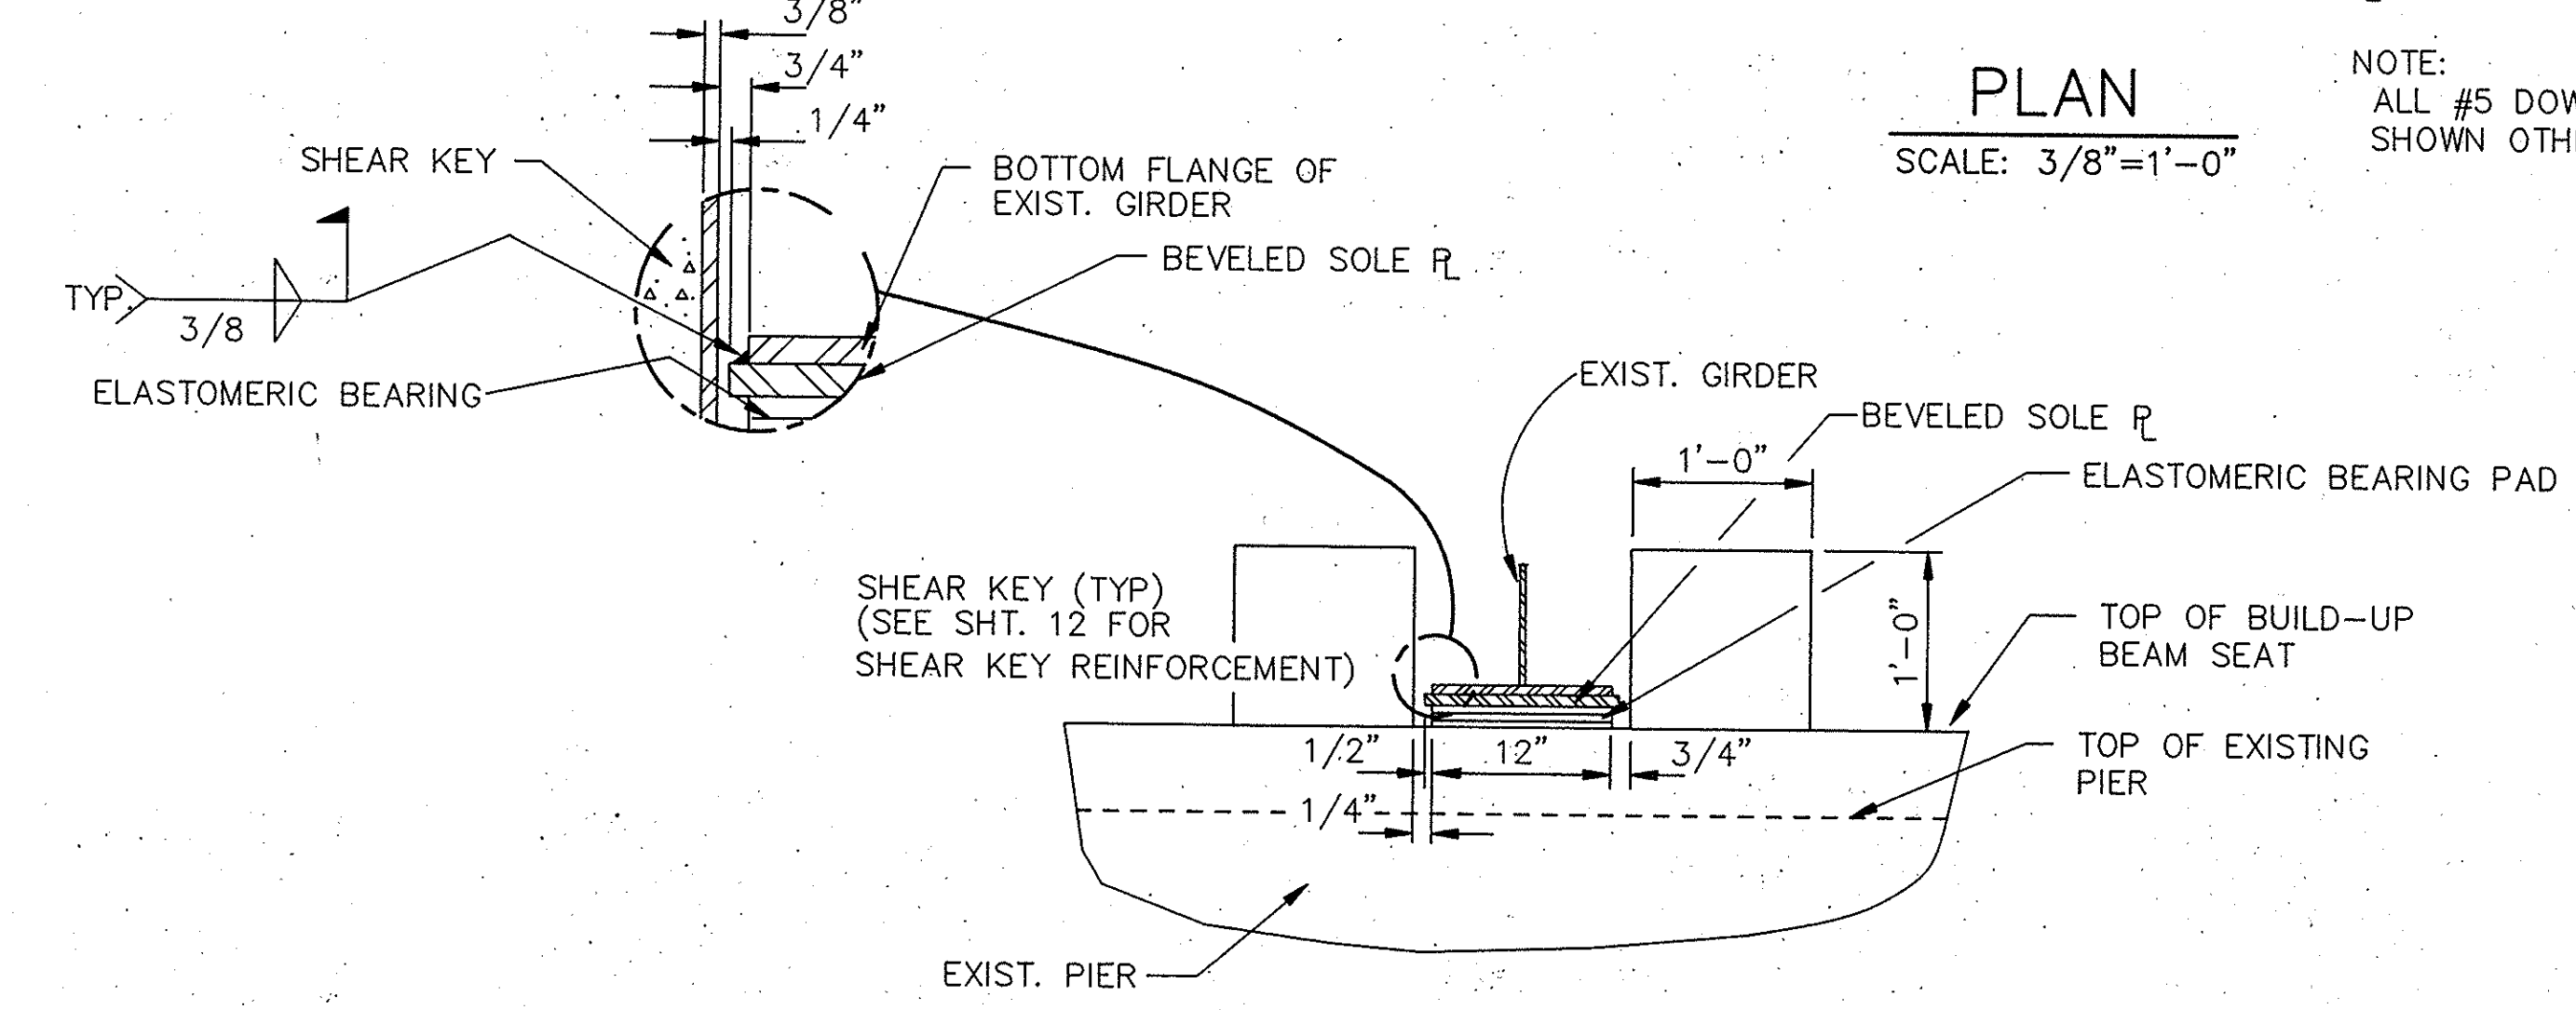
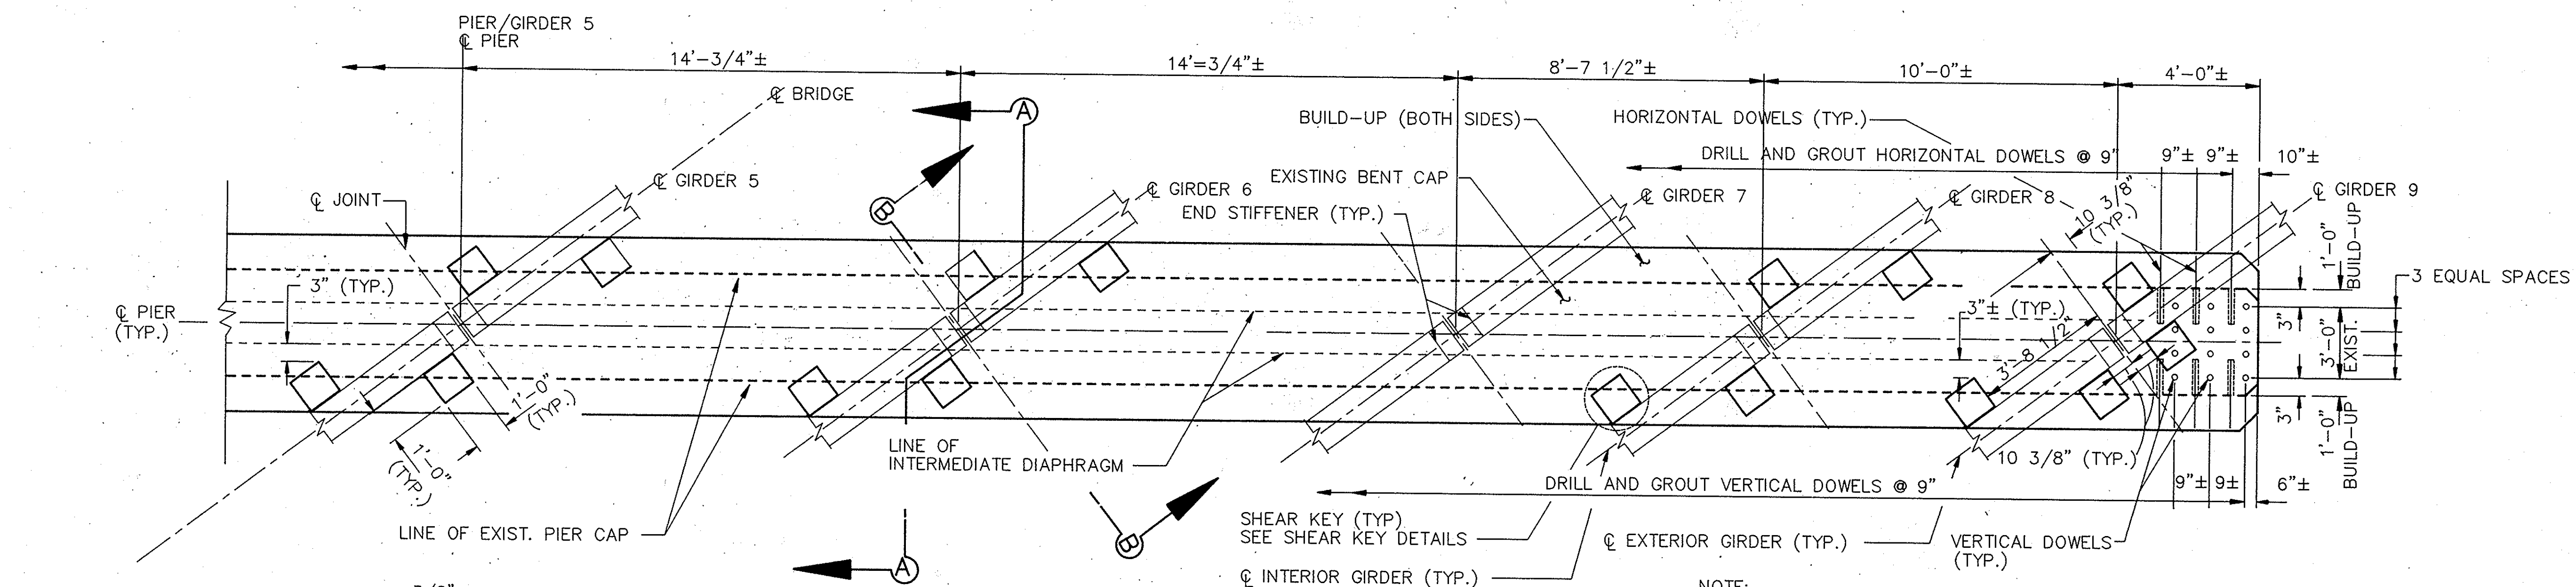


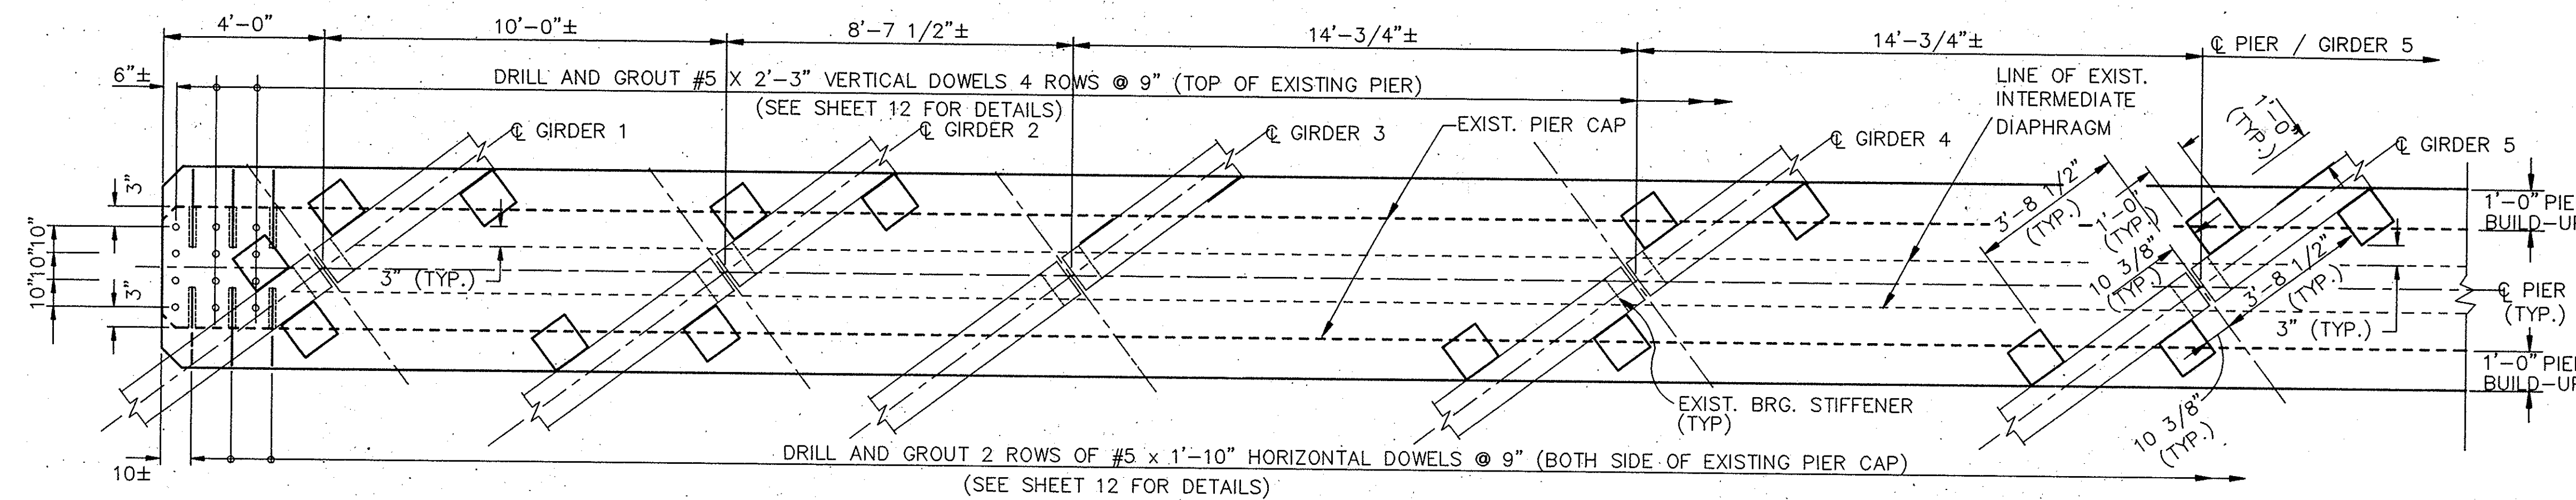

SECTION B-B
SCALE: 1"=1'-0"
NOTE:
SEE SHEET 8 FOR ADDITIONAL DETAILS

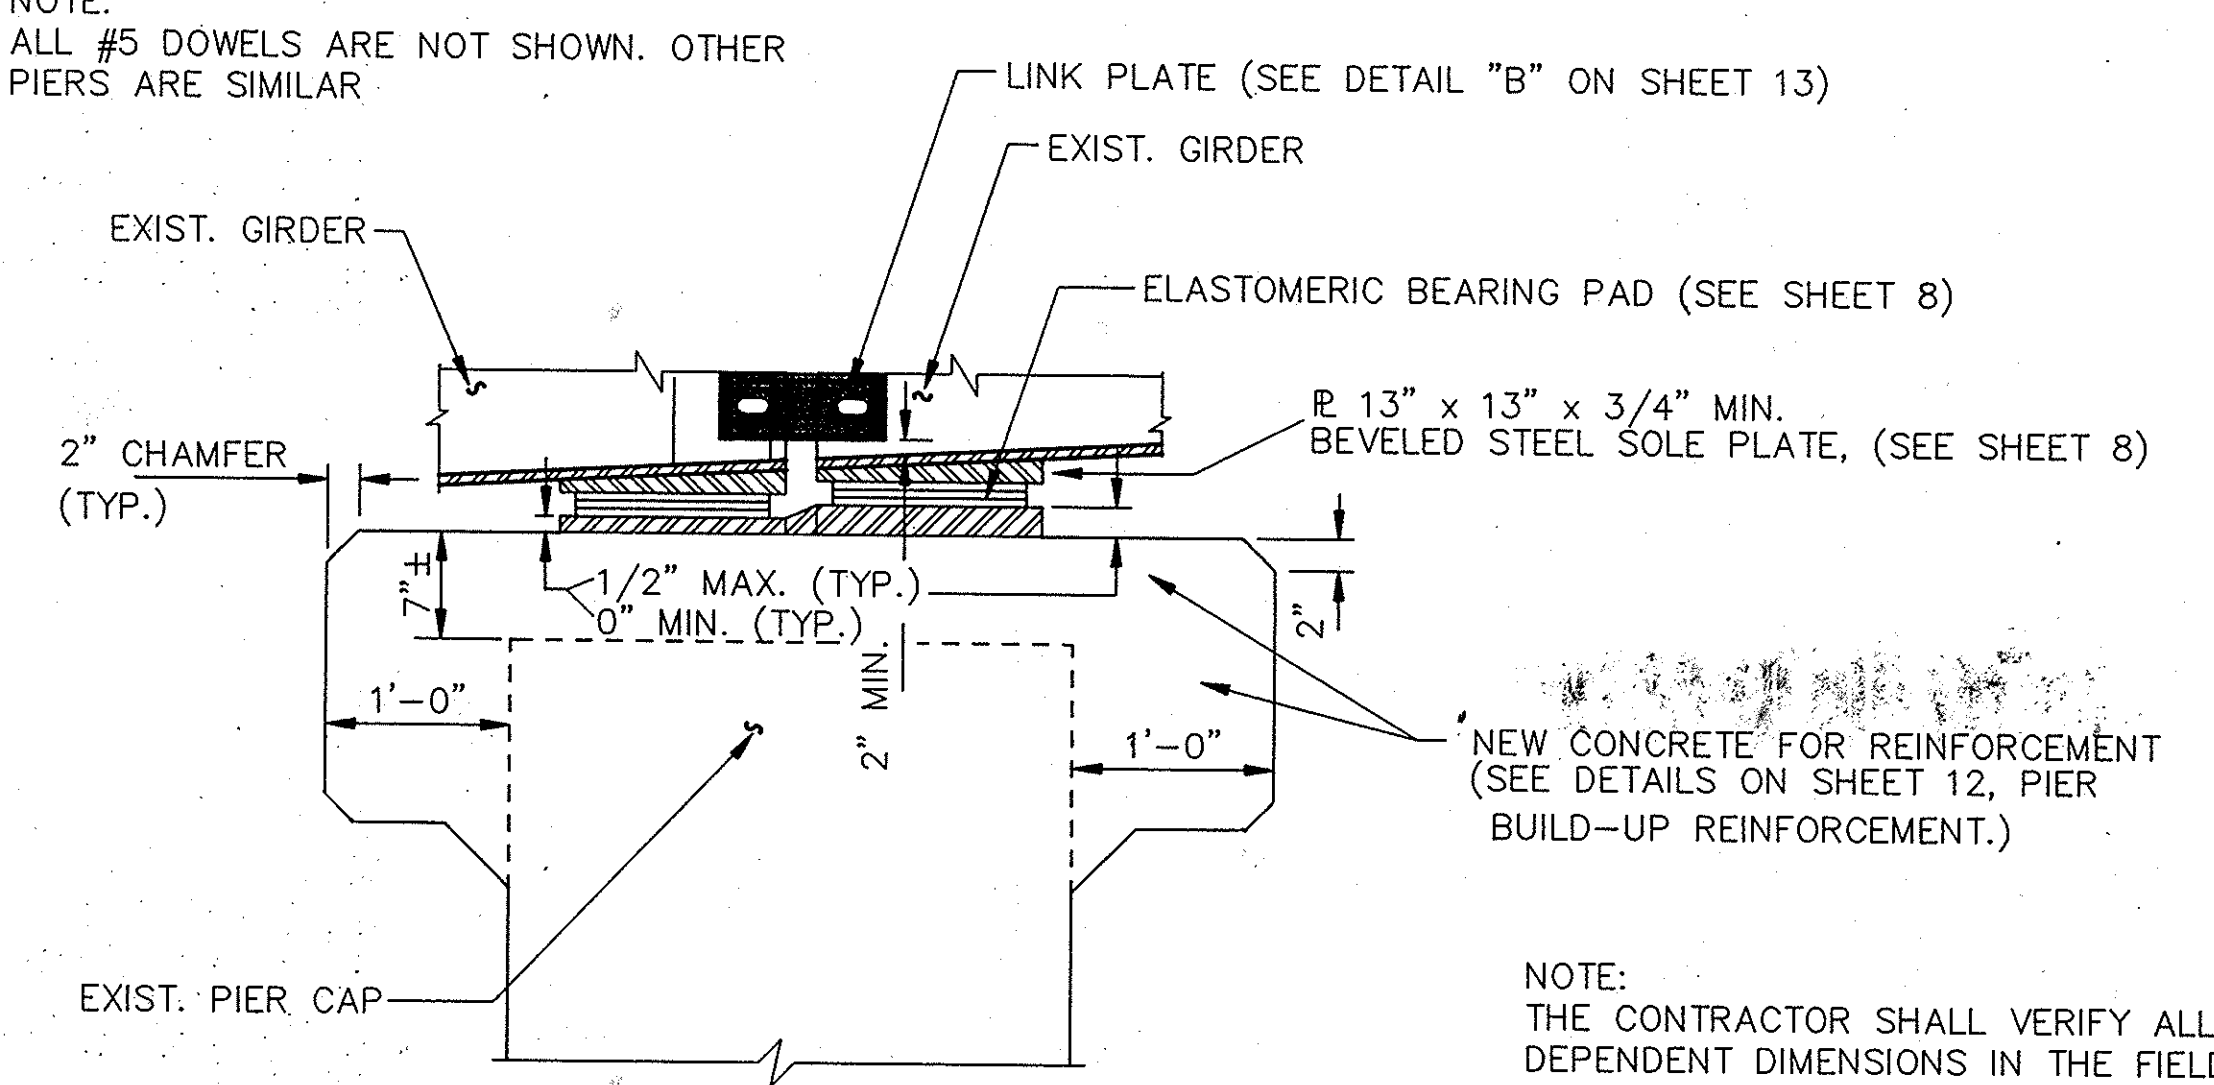

SECTION A-A
SCALE: 1"=1'-0"
(FOR INFORMATION NOT SHOWN, SEE SHT. 12)

DIST	COUNTY	ROUTE	POST MILES TOTAL PROJECT	SHEET NO.	TOTAL SHEETS

REGISTERED CIVIL ENGINEER

PLANS APPROVAL DATE

KERCHEVAL ENGINEERS
CIVIL/STRUCTURAL ENGINEERING
PLANNING AND SURVEYING
SAN DIEGO, CA. 92123
(619) 571-0520

REGISTERED PROFESSIONAL ENGINEER
DENIS HUGH MORGAN
No. 35153
EXP. 9-30-91
CIVIL
STATE OF CALIFORNIA

SPONSORING AGENCY

EARTHQUAKE RETROFIT PROJECT NO. C05									
LOS ALAMITOS BLVD. BRIDGE RETROFIT									
PIER CAP BUILD-UP									
REVISION DATES (PRELIMINARY STAGE ONLY)									
SHEET 10 OF 18									

DESIGN		BY	CHIN C. CHEN	CHECKED	DONALD L. ALLEN	LOAD FACTOR DESIGN	ORIGINAL SCALE IN INCHES FOR REDUCED PLANS		PREPARED FOR THE STATE OF CALIFORNIA DEPARTMENT OF TRANSPORTATION	PROJECT ENGINEER CHIN C. CHEN	BRIDGE NO.	55C - 0052	
DETAILS		BY	CAD / C.E. JONES	CHECKED	BRYAN PETERS	LAYOUT	BY	RON BROWN			CHECKED	PON-FIN CHEN	POST MILE
QUANTITIES		BY	BRYAN D. PETERS	CHECKED	PON-FIN CHEN	SPECIFICATION	BY	CHIN C. CHEN			PLANS AND SPECS COMPARED		
SIGNOFF DATE													

ORIGINAL SCALE IN INCHES FOR REDUCED PLANS										CU	EA	DISREGARD PRINTS BEARING EARLIER REVISION DATES	1/10/95																																																																																																																																																																																																																																																																																																																																																																																																																																																																																																																																																																																																																																																																																																																																																																																																																																																																																																																																																																																																																																																																																																																																																																																																																																																																																									</
--	--	--	--	--	--	--	--	--	--	----	----	---	---------	--	--	----

RECORD DRAWING