
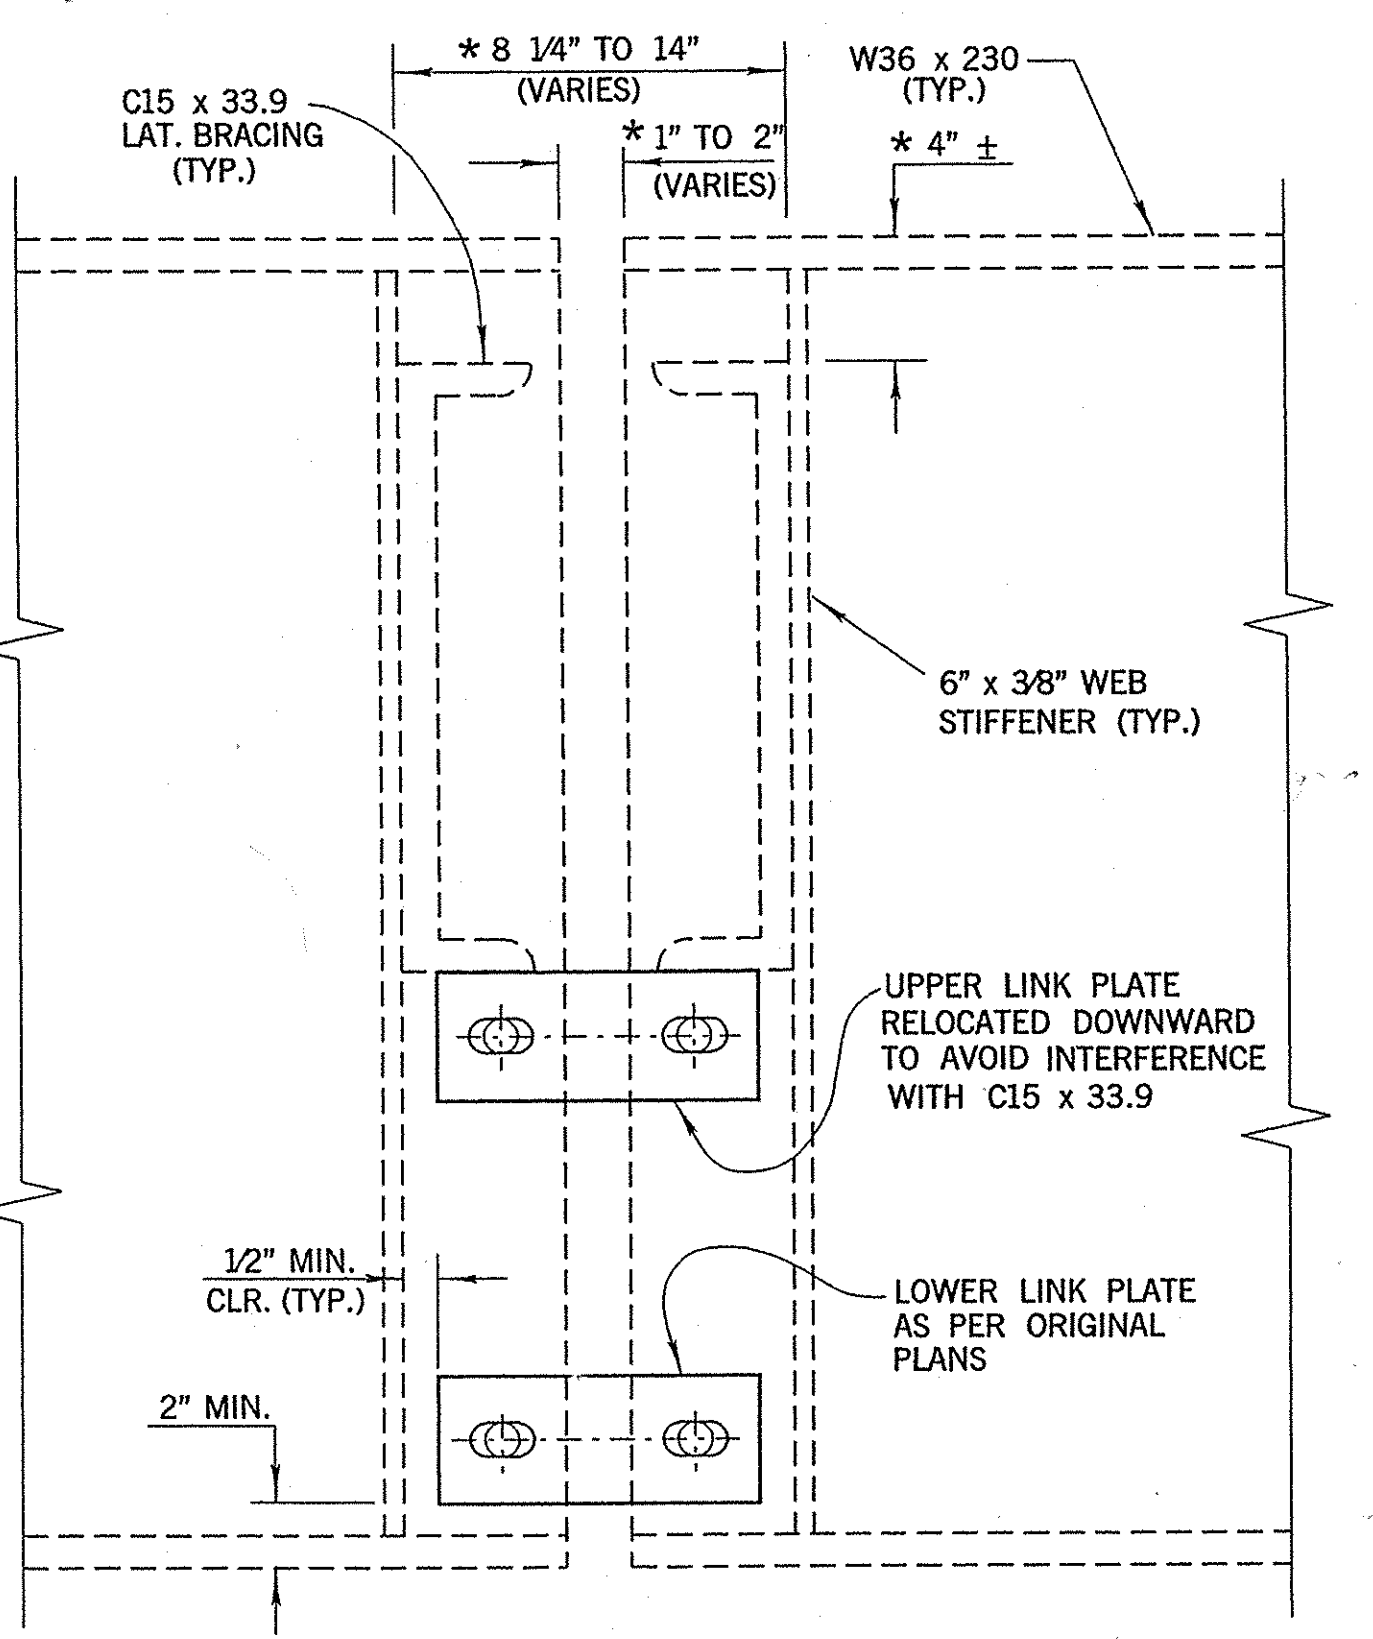
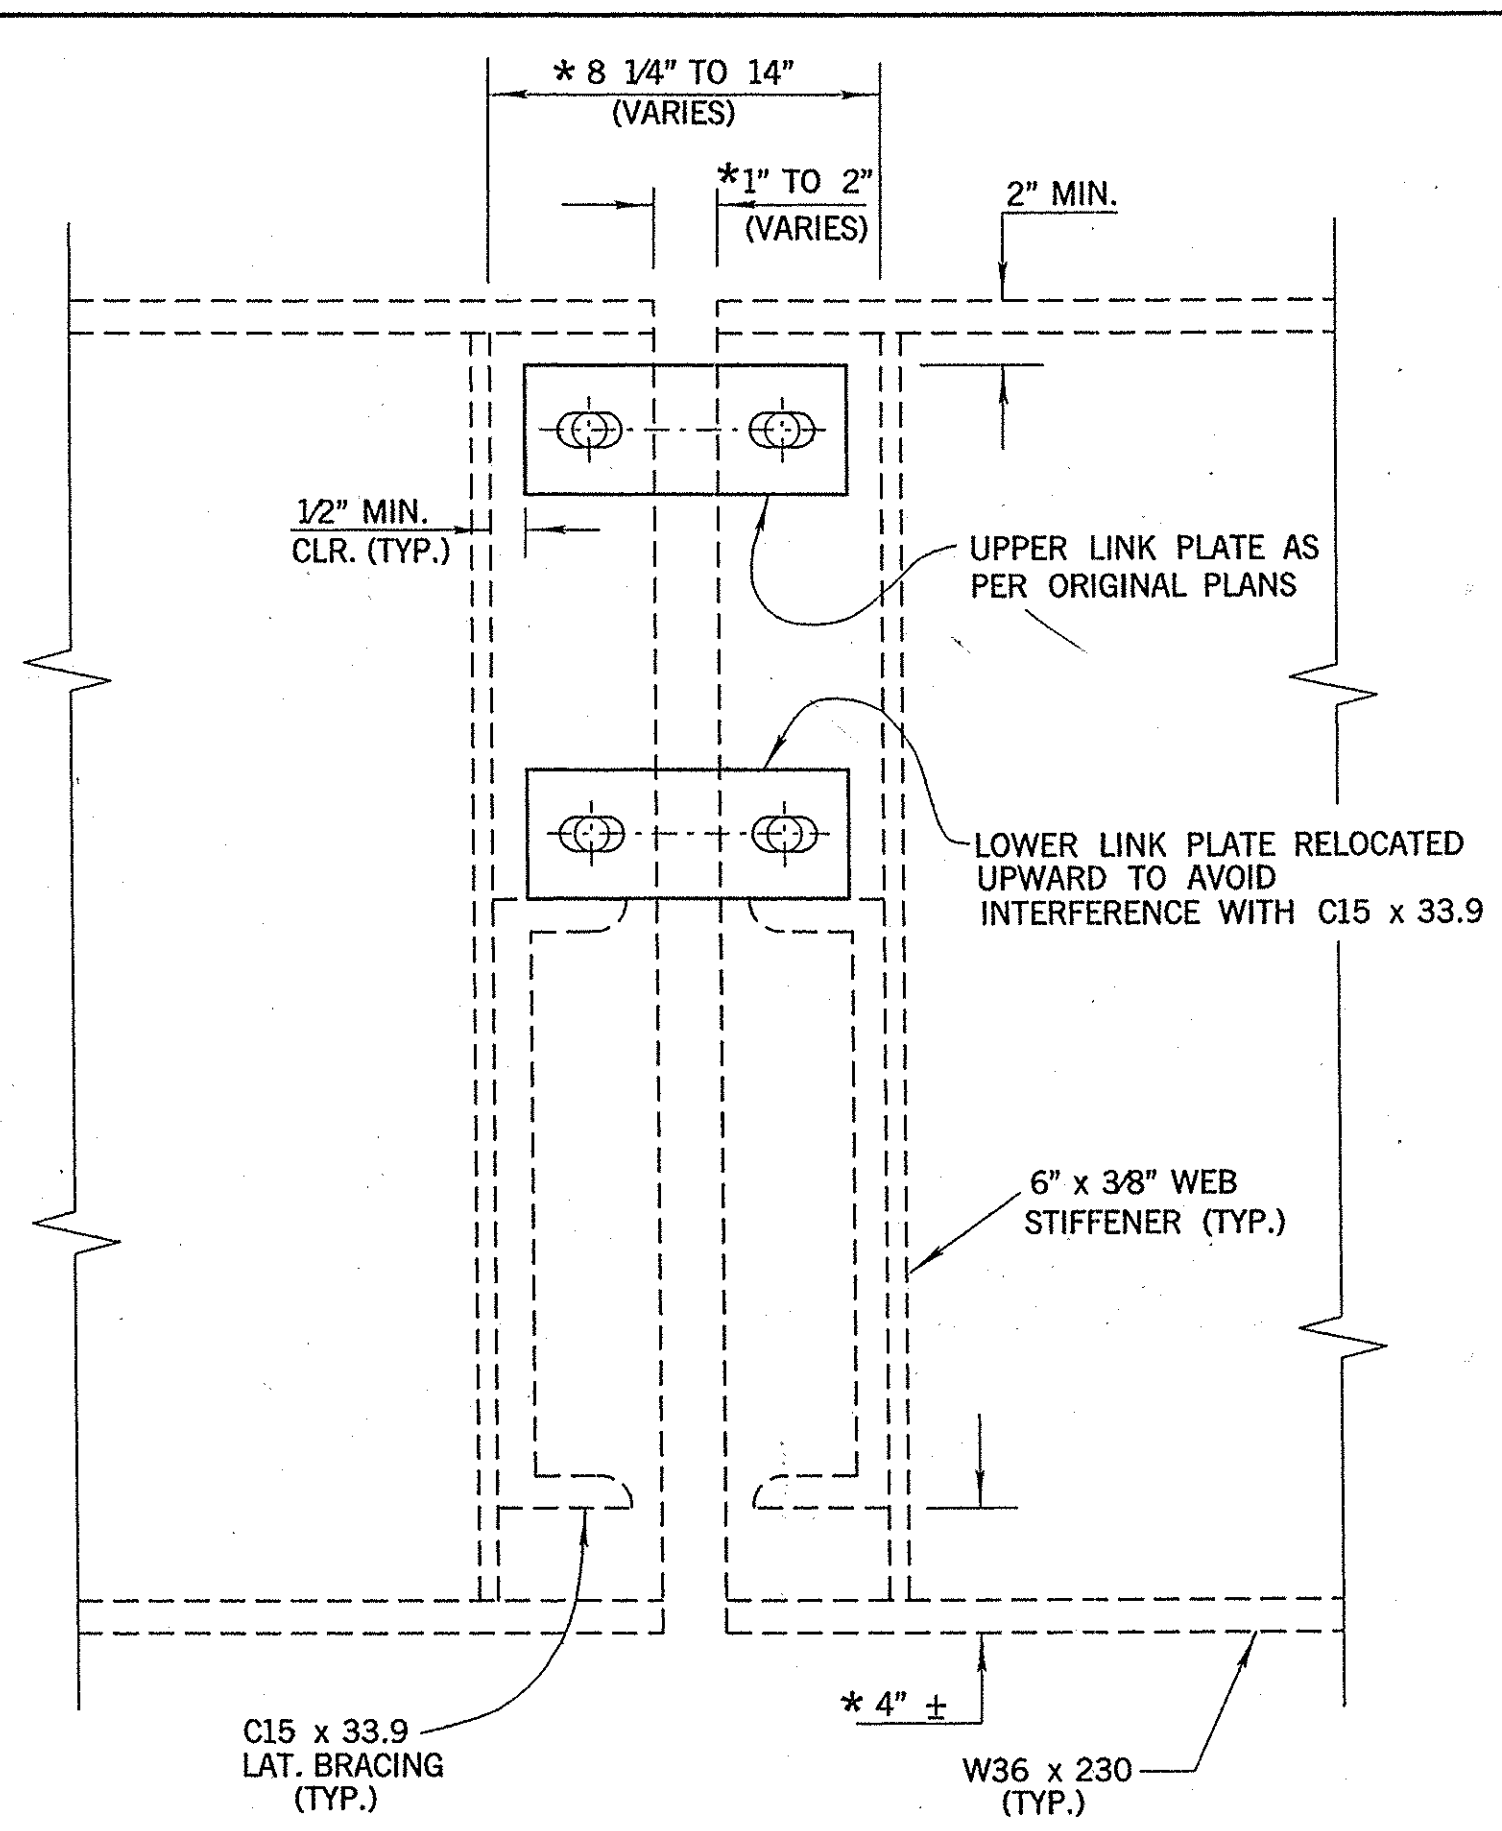
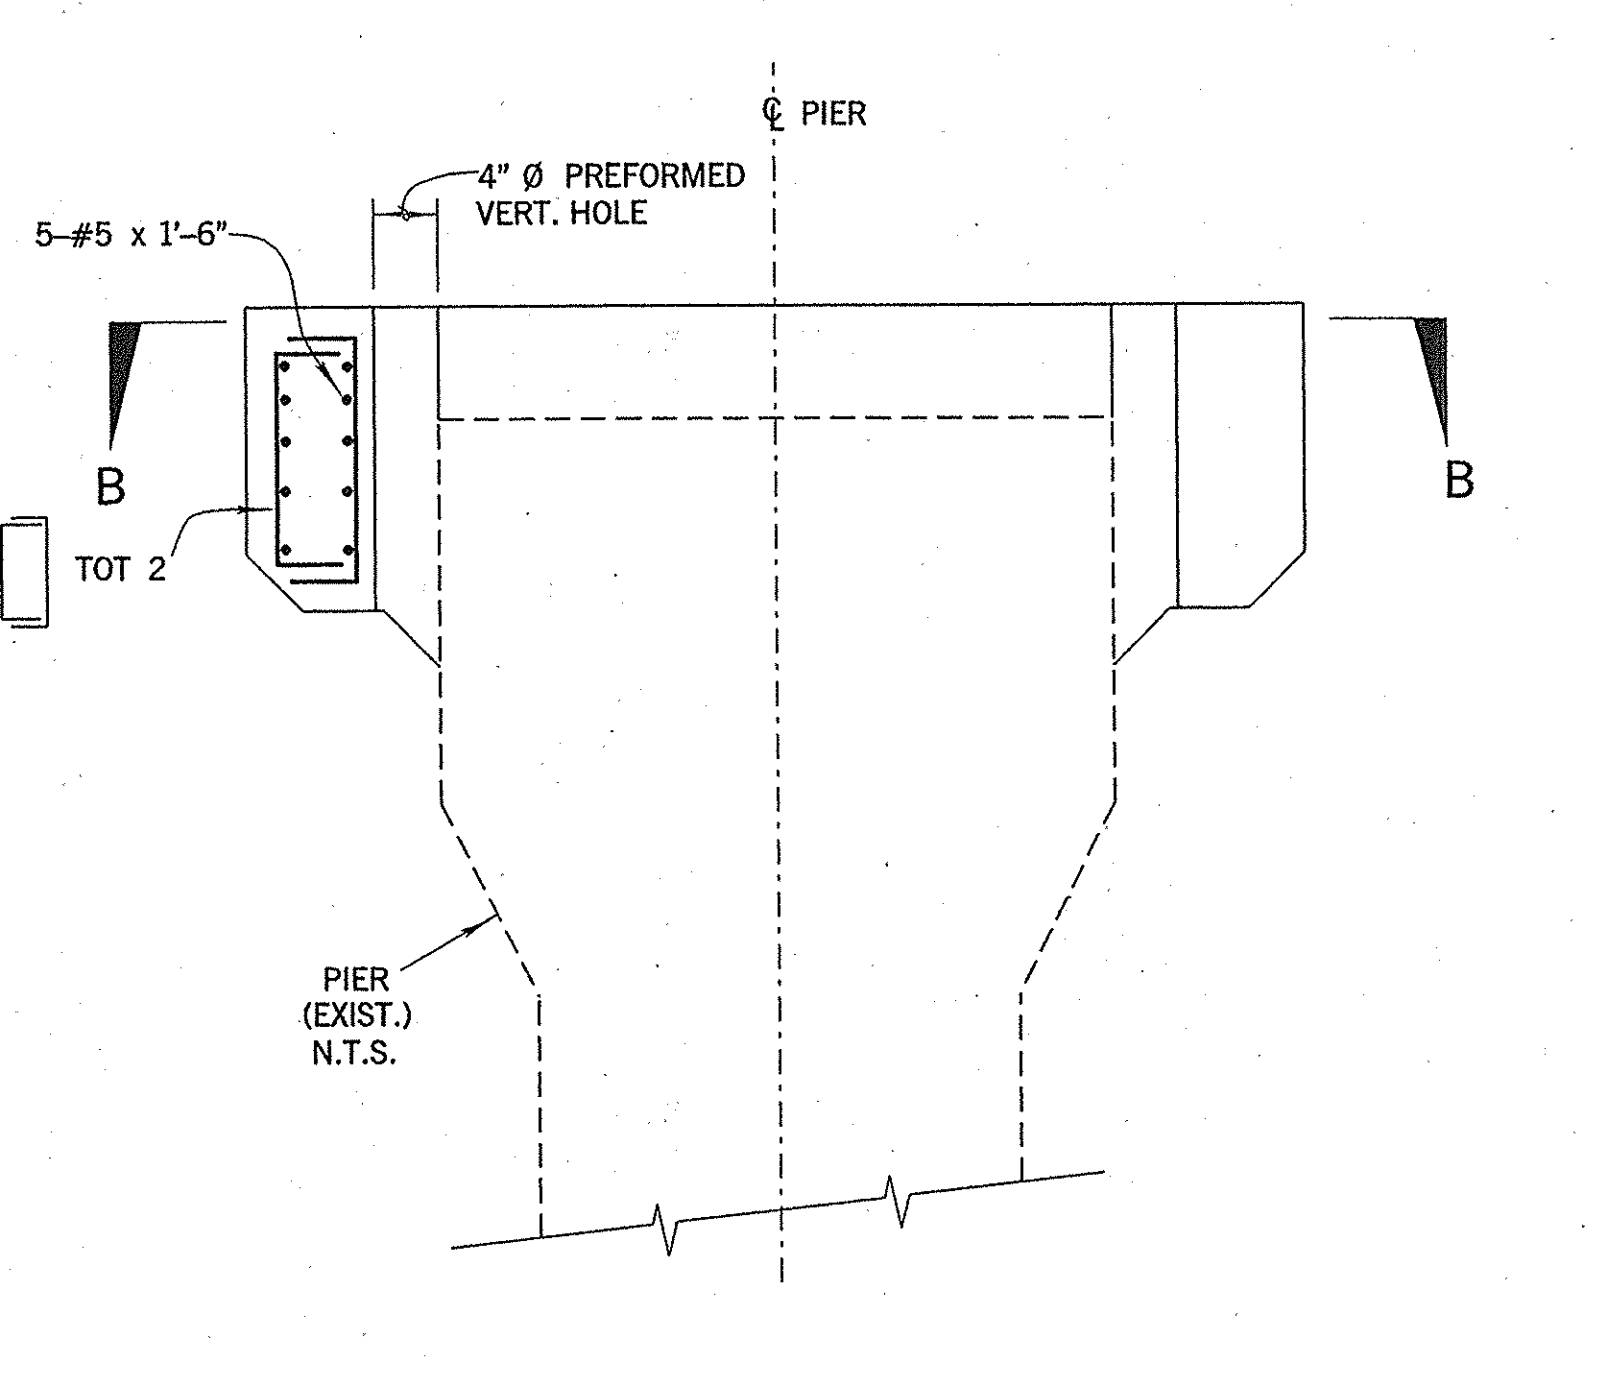


DIST	COUNTY	ROUTE	POST MILES TOTAL PROJECT	SHEET NO.	TOTAL SHEETS
Rita H. Hinton, Jr. For Chin C. Chen REGISTERED CIVIL ENGINEER Civil, No. C042267					
PLANS APPROVAL DATE					
The State of California or its officers or agents shall not be responsible for the accuracy or completeness of electronic copies of this plan sheet.					

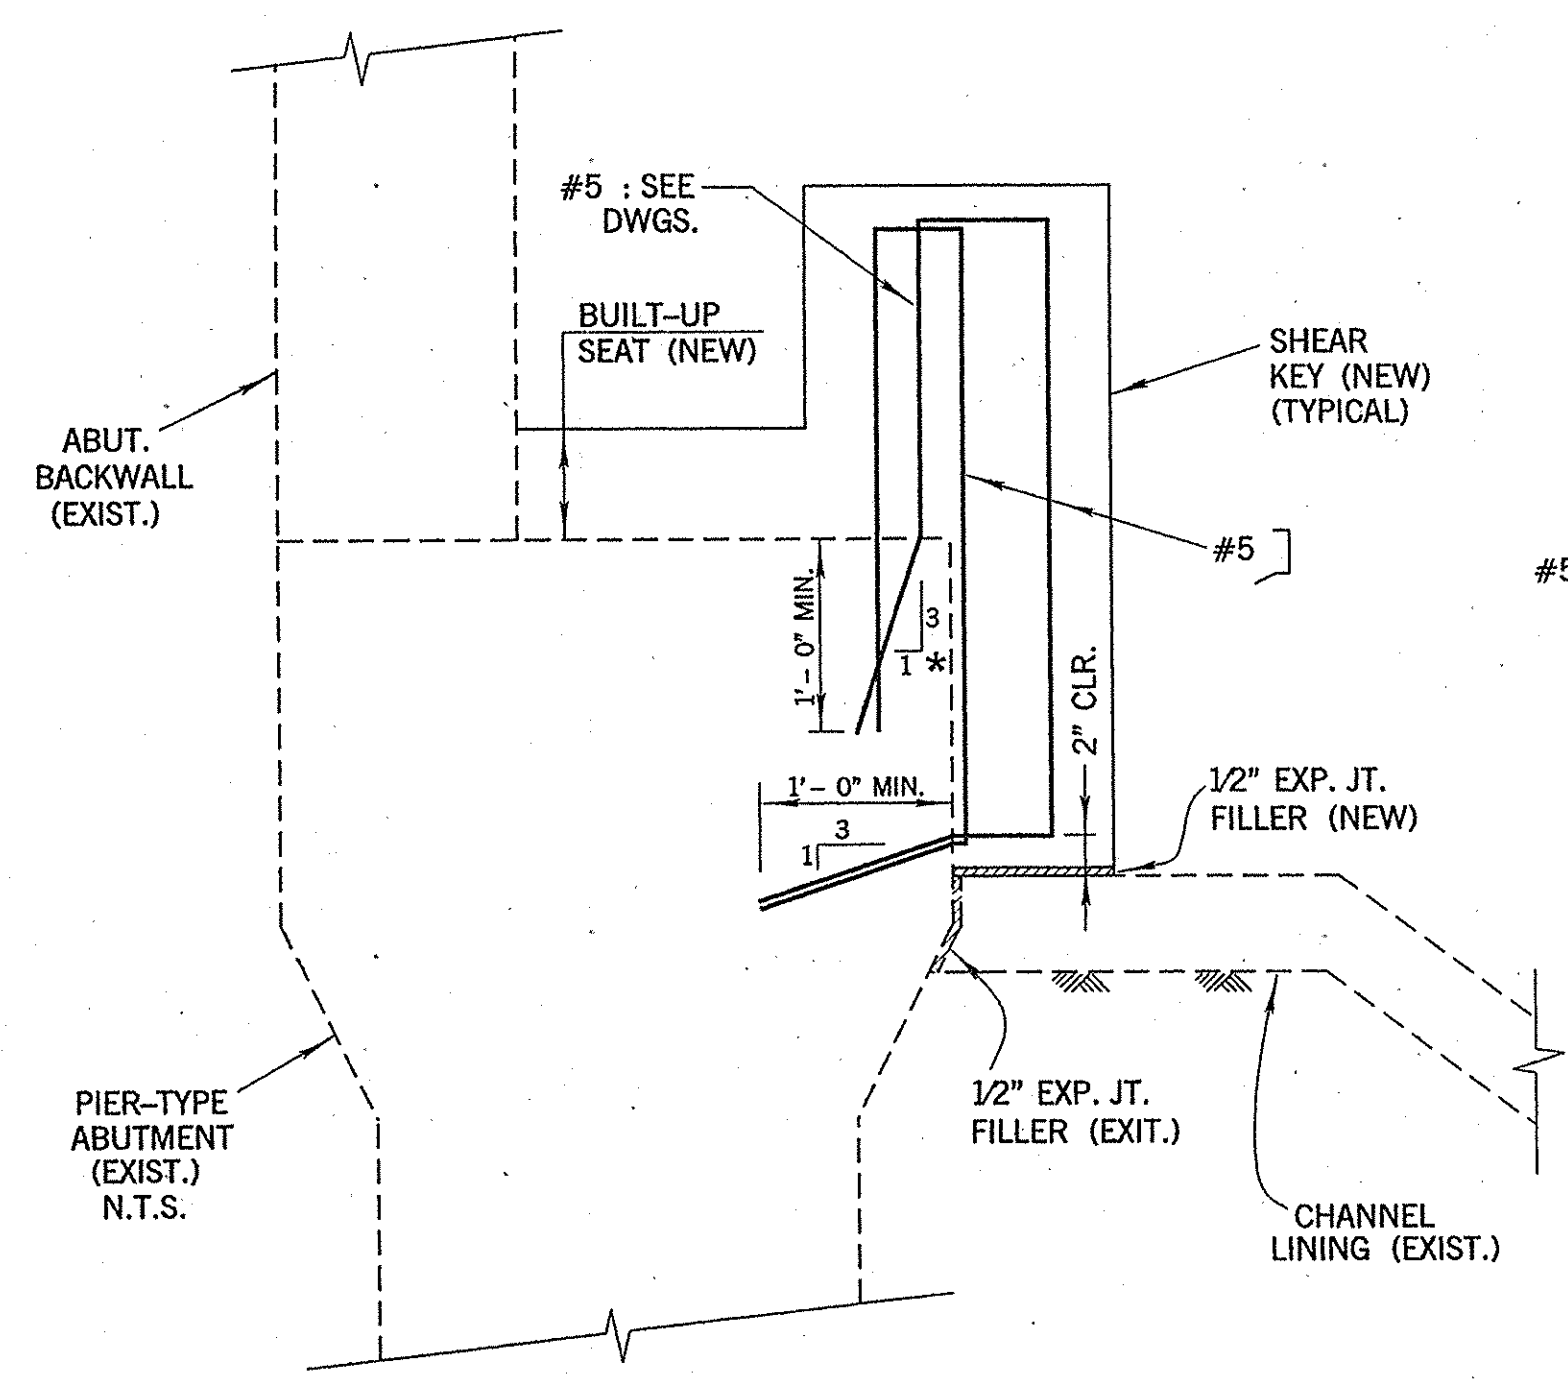

SECTION "A-A" (REFERENCED ON SHEET 18)
SCALE: 1" = 1'-0"

NOTES: 1. ONLY SHEAR KEY DOWEL BARS SHOWN, FOR CLARITY.
2. BUILD PER ORIGINAL DWGS., EXCEPT AS INDICATED HEREIN

* 1:3 SLOPE WHEREVER EDGE DISTANCE IS LESS THAN 3"
FOR REINFORCING NOT SHOWN, SEE SECTION "A-A" ON SHEET 12.

SECTION A-A AT LOCATIONS OF 4" VERT. HOLE (REFERENCED ON SHEET 12)
SCALE: 1" = 1'-0"



NOTES: FOR REINFORCING NOT SHOWN, SEE SECTION "A-A" ON SHEET 12.

VARIATION #1 OF DETAIL "B" FOR CERRITOS BRIDGE (RIGHT) (REFERENCED ON SHEET 13)
NO SCALE

* INDICATES ACTUAL FIELD CONDITION
NOTE: FOR REMAINING DETAILS NOT SHOWN, SEE SHEET 13.

VARIATION #2 OF DETAIL "B" FOR LOS ALAMITOS BRIDGE (REFERENCED ON SHEET 13)
NO SCALE

* INDICATES ACTUAL FIELD CONDITION
NOTE: FOR REMAINING DETAILS NOT SHOWN, SEE SHEET 13.

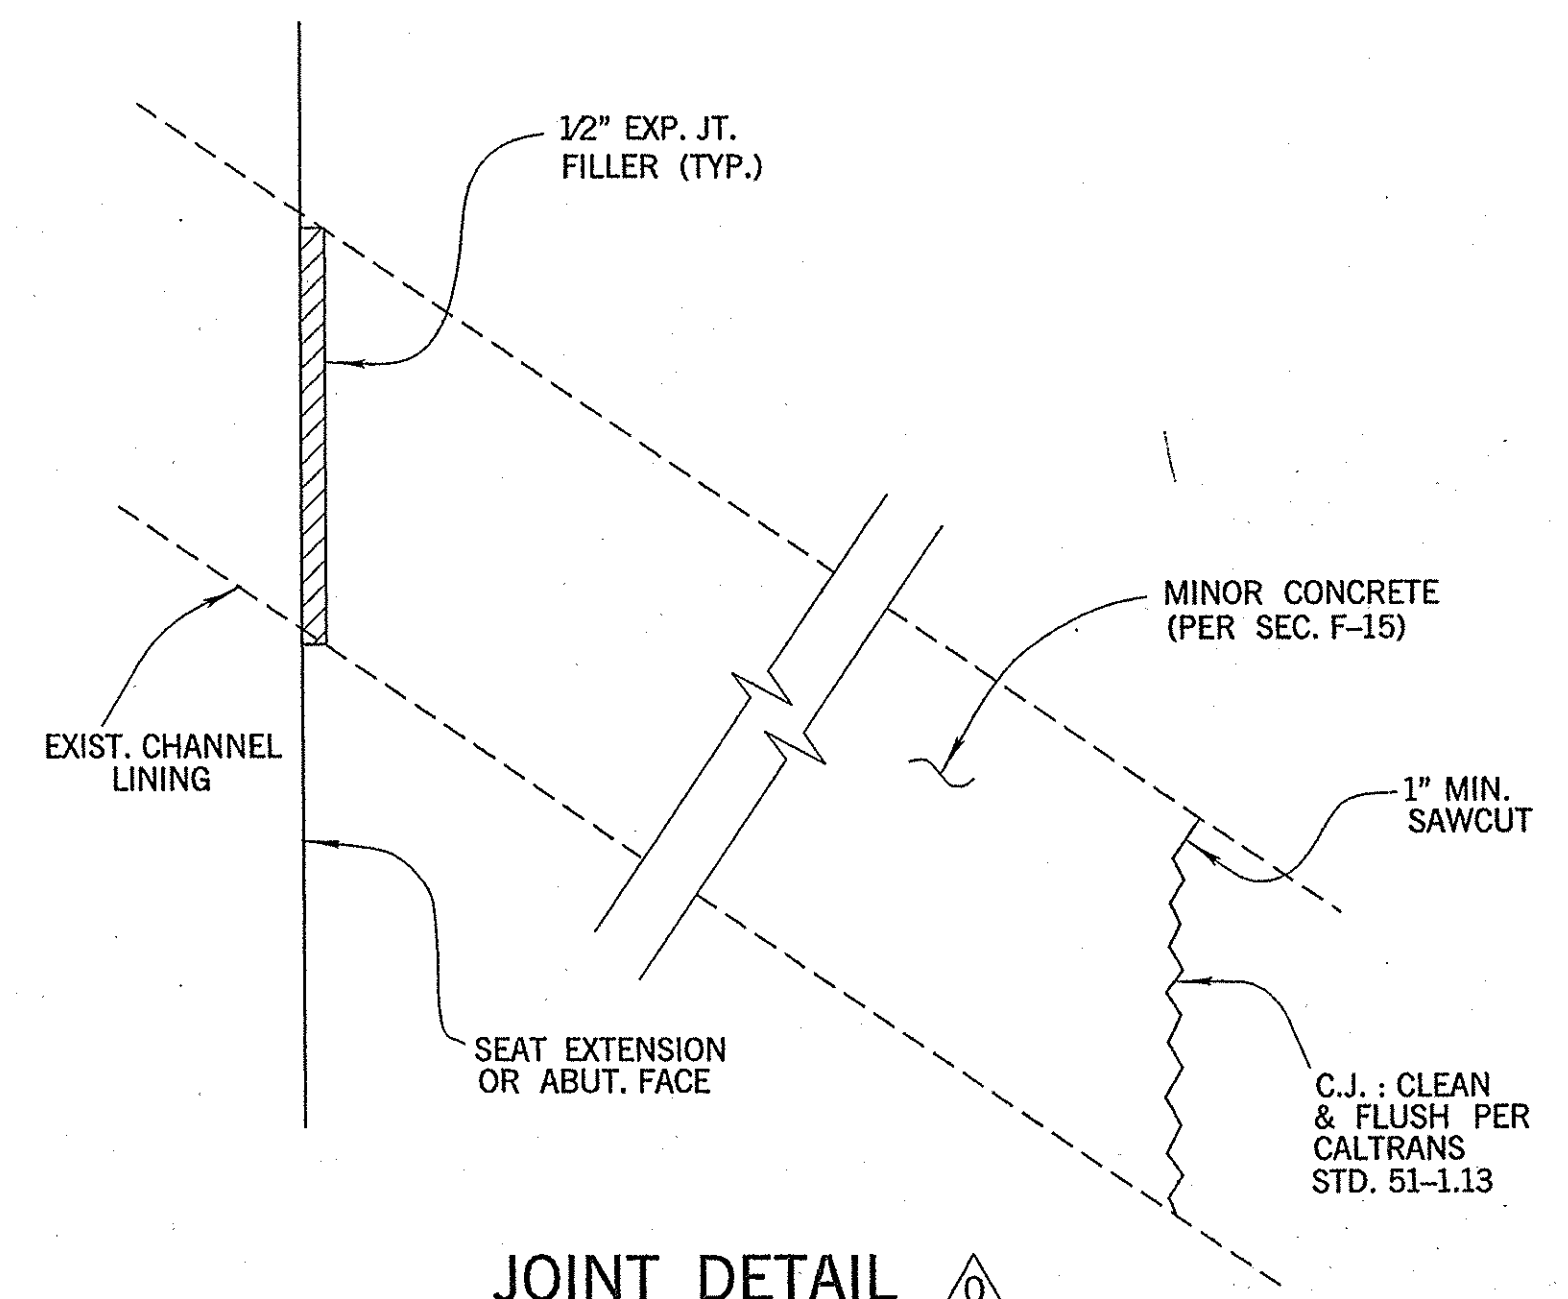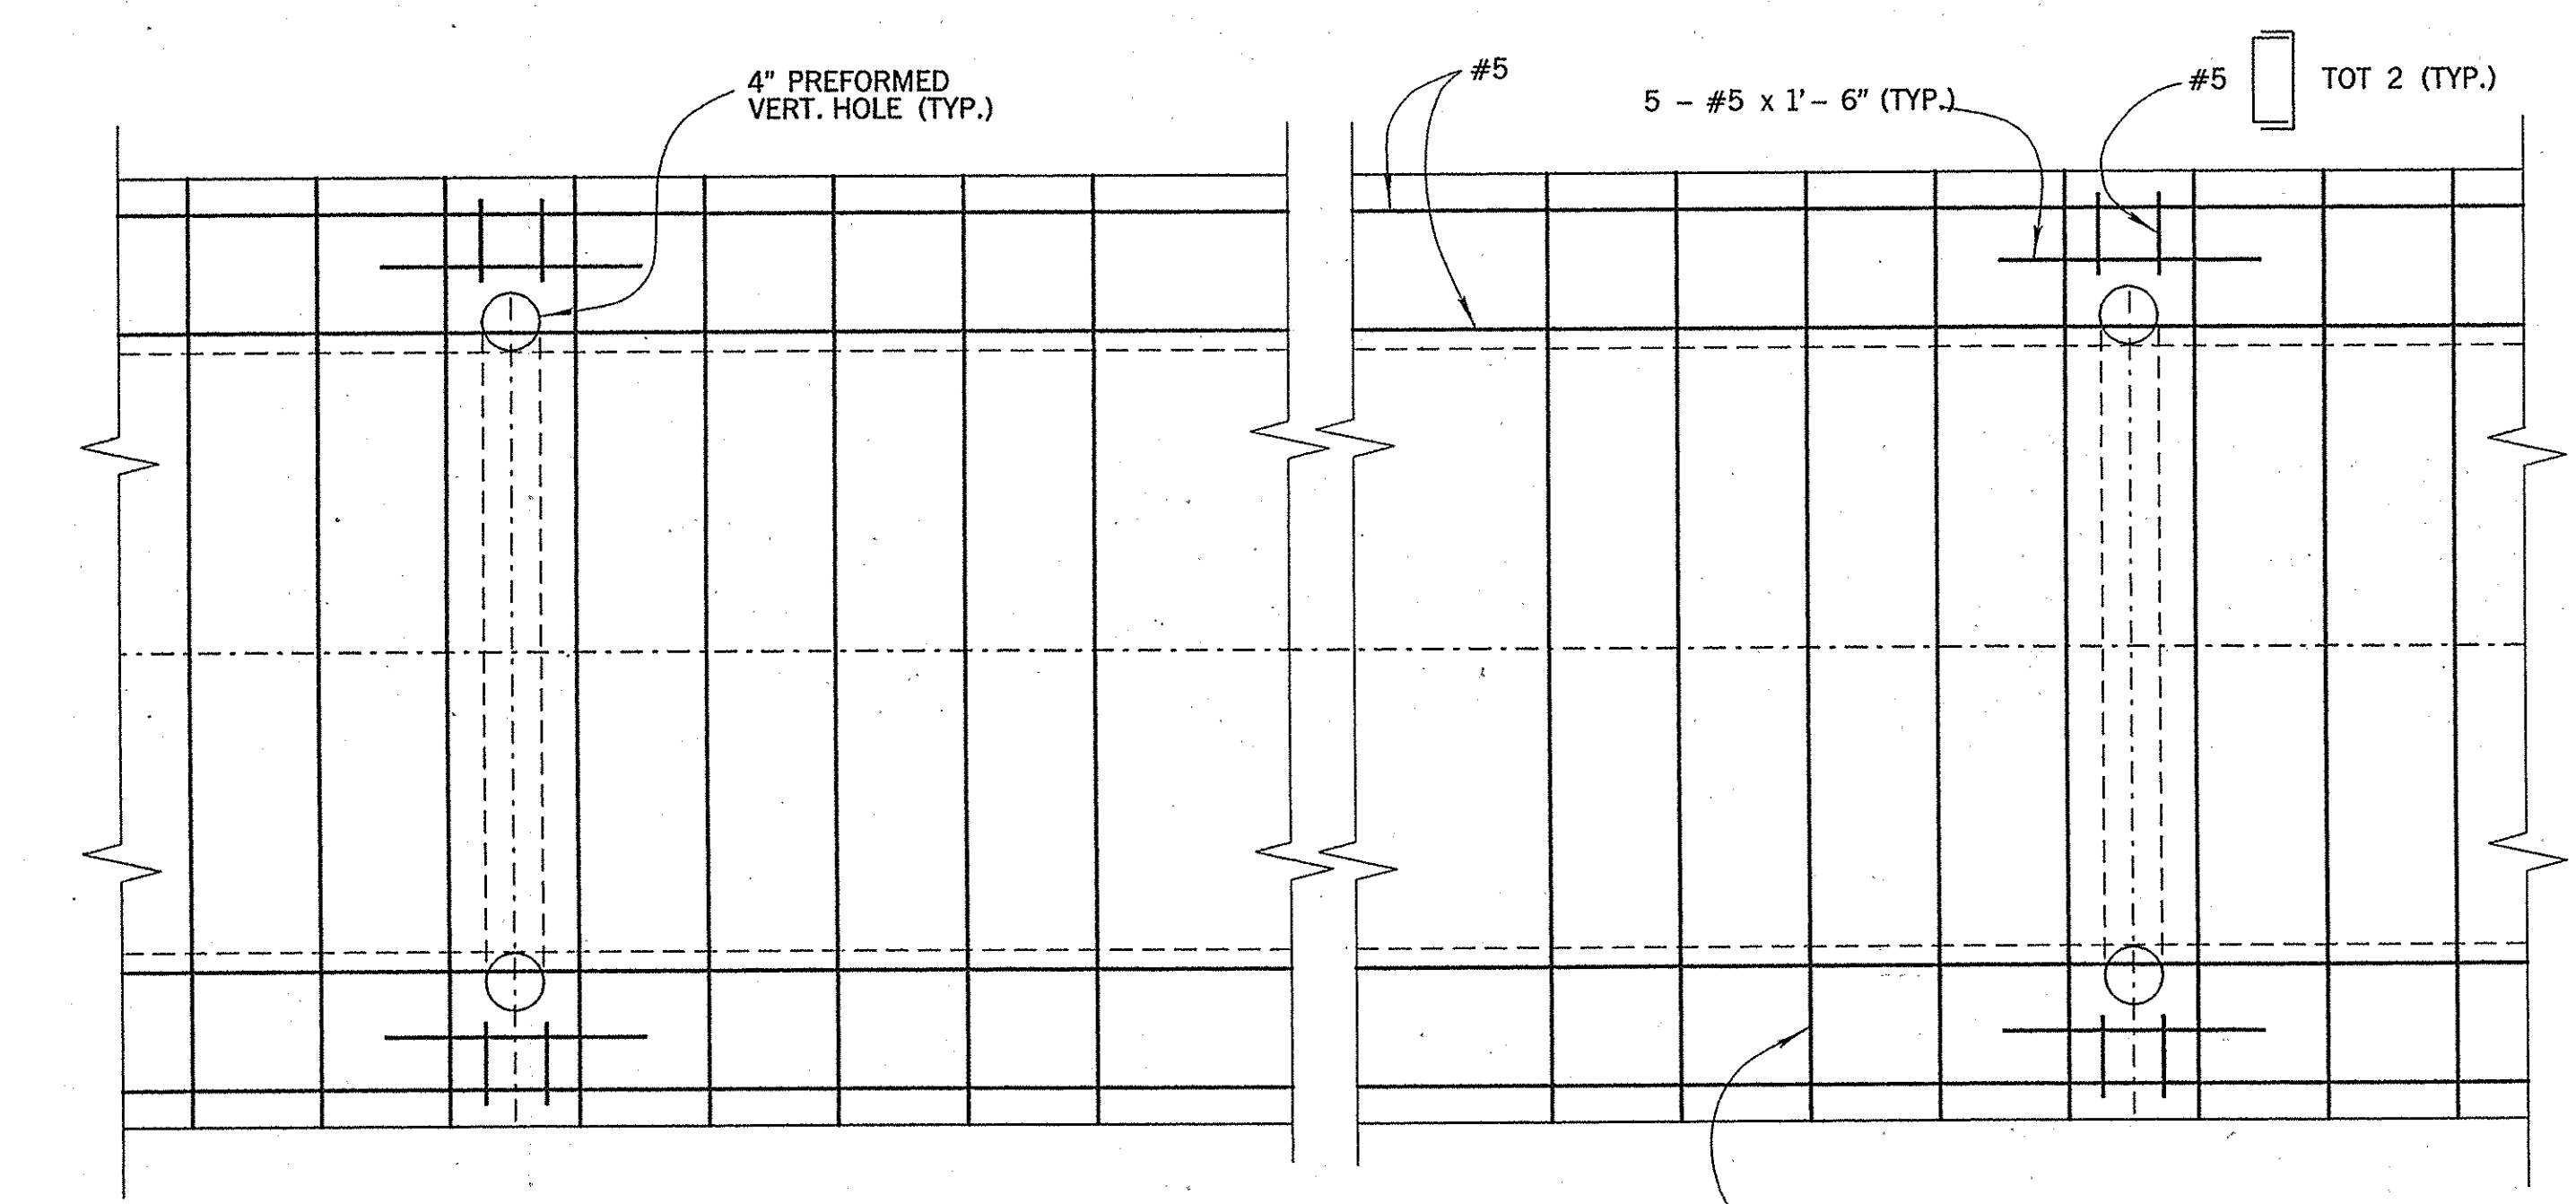

NOTES: FOR REINFORCING NOT SHOWN
SEE "SECTION A-A" ON SHEET 12.

SECTION B-B (REFERENCED ON SHEET 12)
SCALE: 1" = 1'-0"

JOINT DETAIL (REFERENCED ON SHEETS 6 & 18.)

RECORD DRAWING

MARK	DATE	DESCRIPTIONS	BY	CH'D
3	4/8/96	RFI #9: Alternative link plate positions due to existing interference	C.C.C./R.W.H.	
2	9/7/95	RFI #6: Additional rebar around vertical formed holes	C.C.C./R.W.H.	
1	8/22/95	RFI #4: Shear key modifications due to pier-type abutment condition	C.C.C./R.W.H.	
0	8/3/95	RFI #1: Provide R&R details for existing channel lining	C.C.C./R.W.H.	

SUPPLEMENTAL SHEET

EARTHQUAKE RETROFIT PROJECT NO. C05	
LOS ALAMITOS BLVD. BR. & CERRITOS AVE. BR. (RL) RETROFIT	
MISCELLANEOUS DETAILS	
REVISION DATES (PRELIMINARY STAGE ONLY)	SHEET OF
	18S 18

DESIGN	BY CHIN C. CHEN	CHECKED	PREPARED FOR THE STATE OF CALIFORNIA DEPARTMENT OF TRANSPORTATION	CHIN C. CHEN PROJECT ENGINEER	BRIDGE NO. 55C-0052
DETAILS	BY CHIN C. CHEN	CHECKED			55C-0264 RL
QUANTITIES	BY	CHECKED			POST MILE
ORIGINAL SCALE IN INCHES FOR REDUCED PLANS				CU EA	DISREGARD PRINTS BEARING EARLIER REVISION DATES