





INDEX OF DRAWINGS

SHEET NO.	TITLE
1.	LOCATION MAP
2.	PLAN & PROFILE, STATION 122 + 68.93 TO 134 + 30.69
3.	R.C. TERRACED CHANNEL DETAILS
4.	VERTICAL WALL RAMP & TRANSITION DETAILS
5.	MISC. STRUCTURAL DETAILS
6.	DROP STRUCTURE DETAILS
7.	DROP STRUCTURE DETAILS
8.	LOCAL DRAINAGE DETAILS
9.	SOIL BORINGS & MISC. DETAILS
10.	PAYLINES

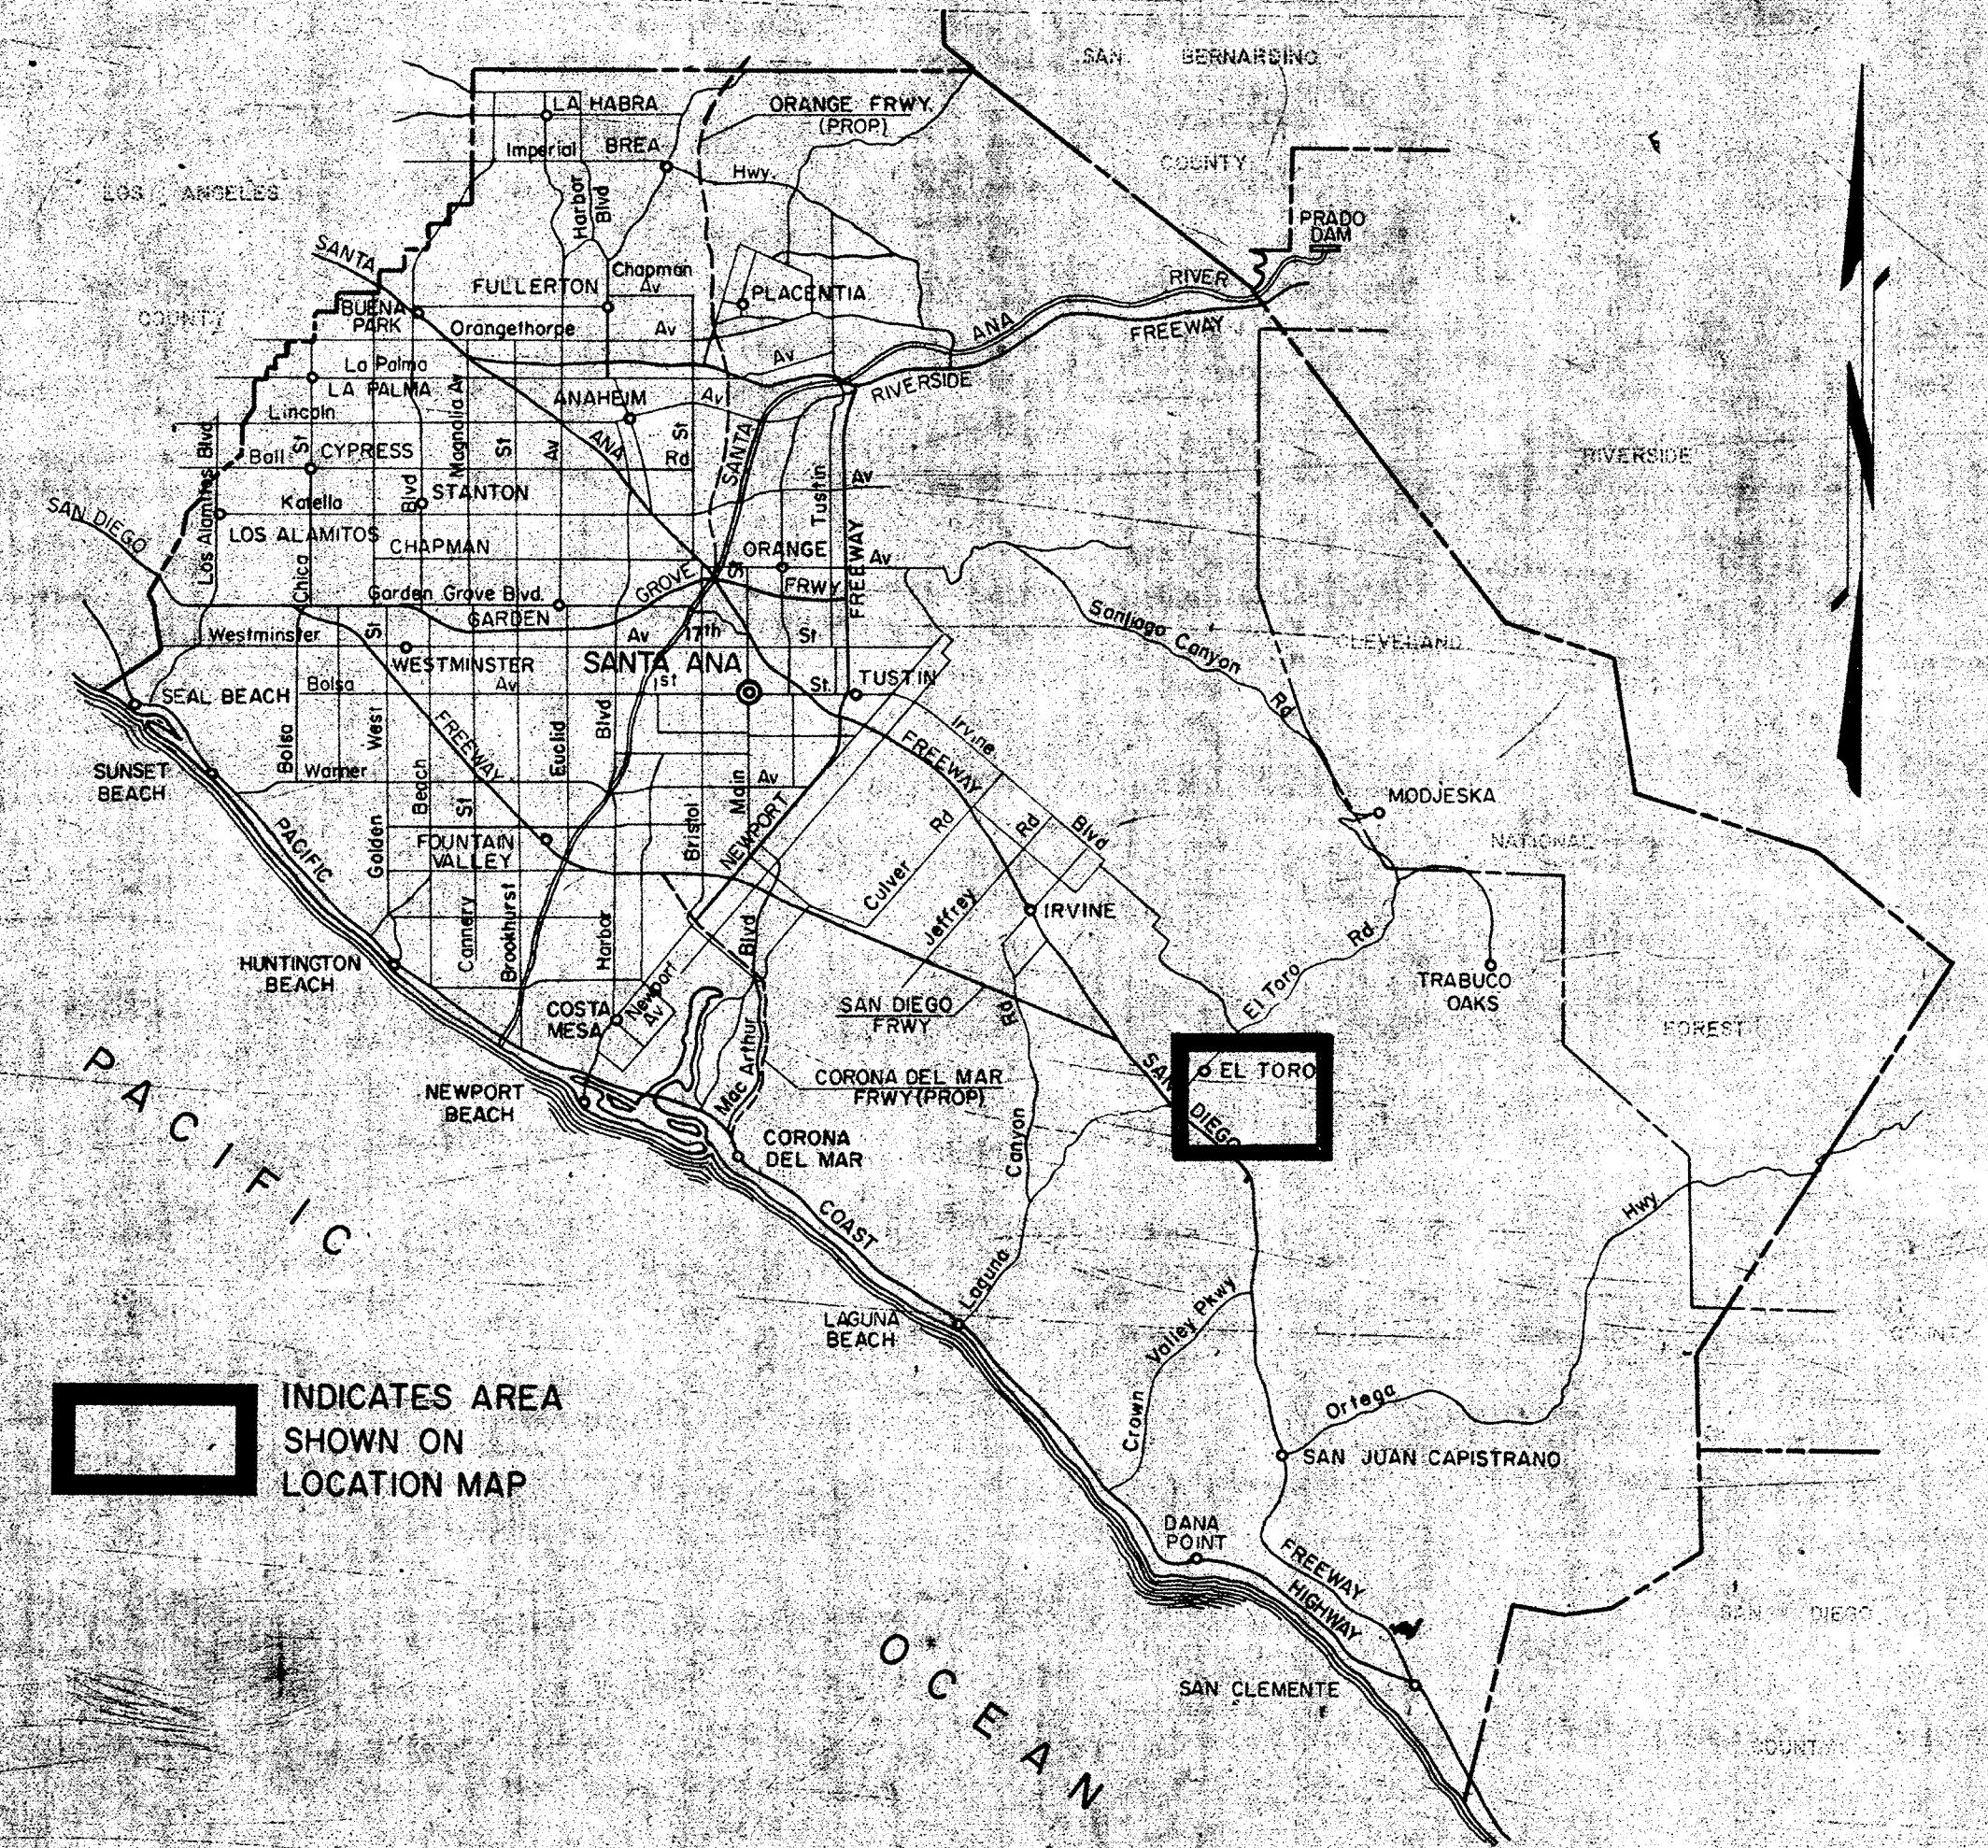

ORANGE COUNTY, CALIFORNIA VICINITY MAP

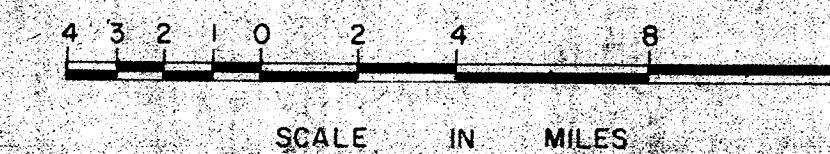


PLANS FOR THE CONSTRUCTION OF THAT PORTION OF **ALISO CREEK CHANNEL**

FROM
470' SOUTH OF LOS ALISOS BOULEVARD
TO
690' NORTH OF LOS ALISOS BOULEVARD
FACILITY NO. JOI
MARCH 1973

AS BUILT

LOCATION MAP

SCALE 1" = 600'

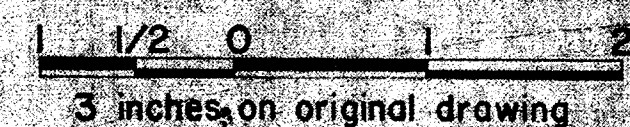

APPROVED: _____
CHIEF ENGINEER

APPROVED: *M. J. [Signature]*
As to portion within
County Roads
COUNTY ROAD
COMMISSIONER

(11097)
LOS ALISOS BLVD BRIDGE
Sheet 2 of 10
Red. 22.5:1
Sepia

ORANGE COUNTY FLOOD CONTROL DISTRICT
SANTA ANA CALIFORNIA

DWG. NO. JOI-101-2

SHEET 1 OF 10 SHEETS