

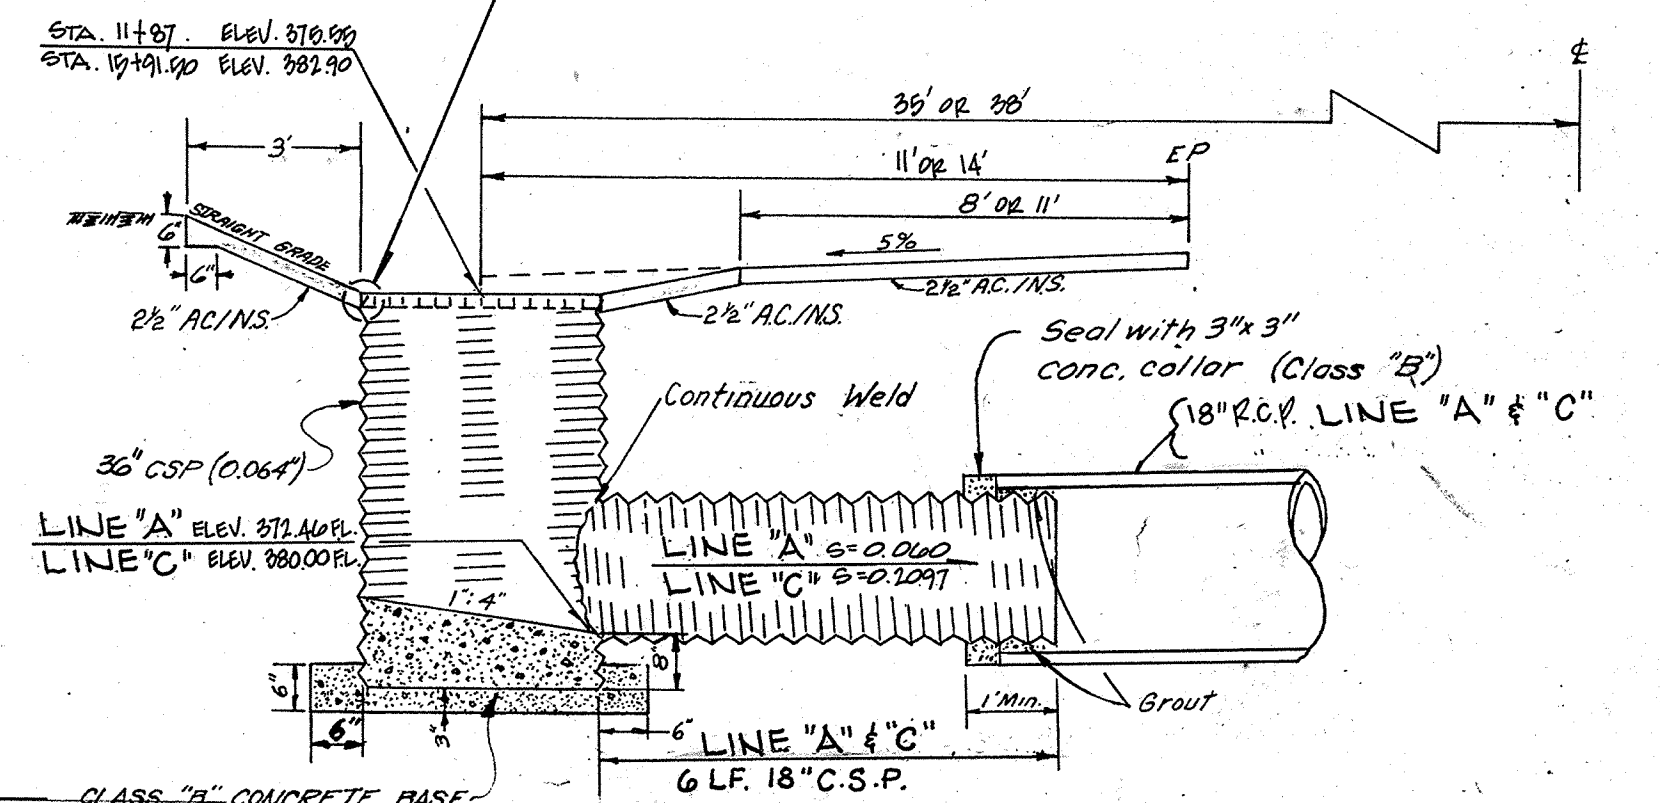
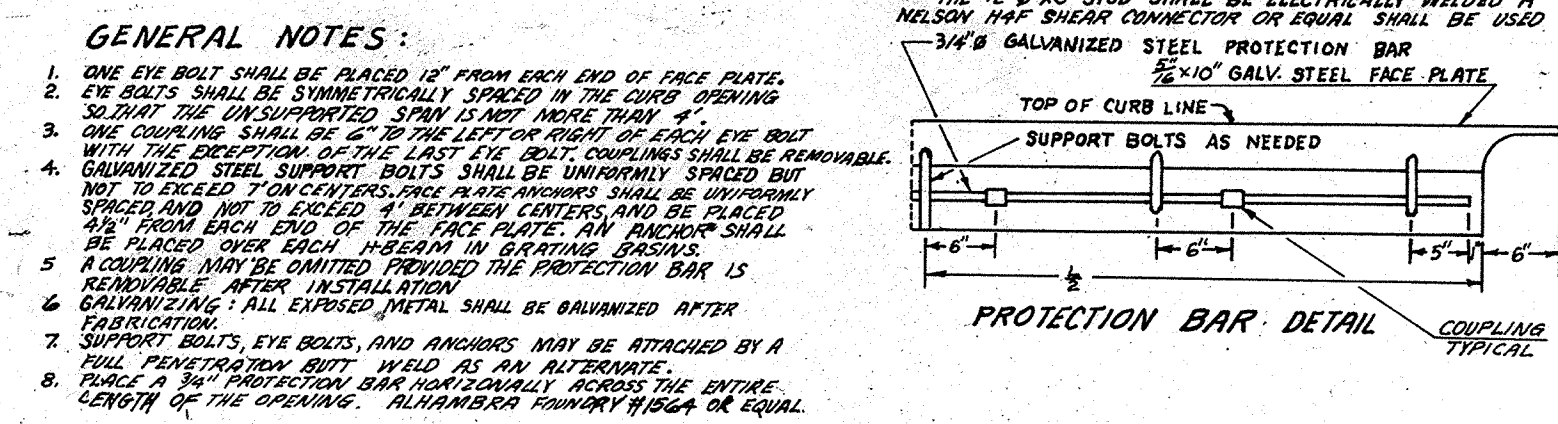
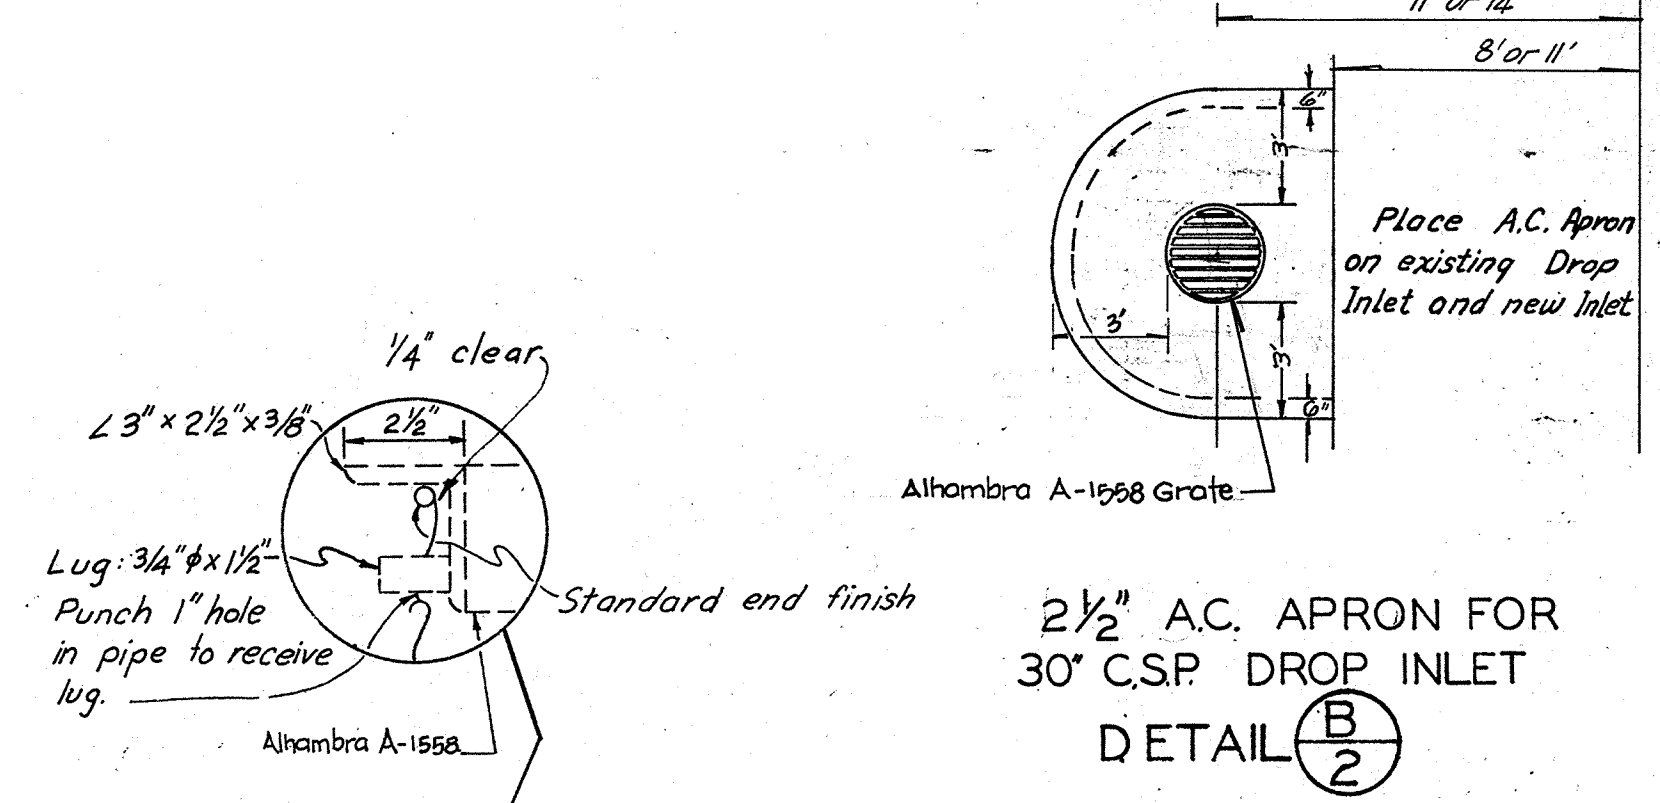
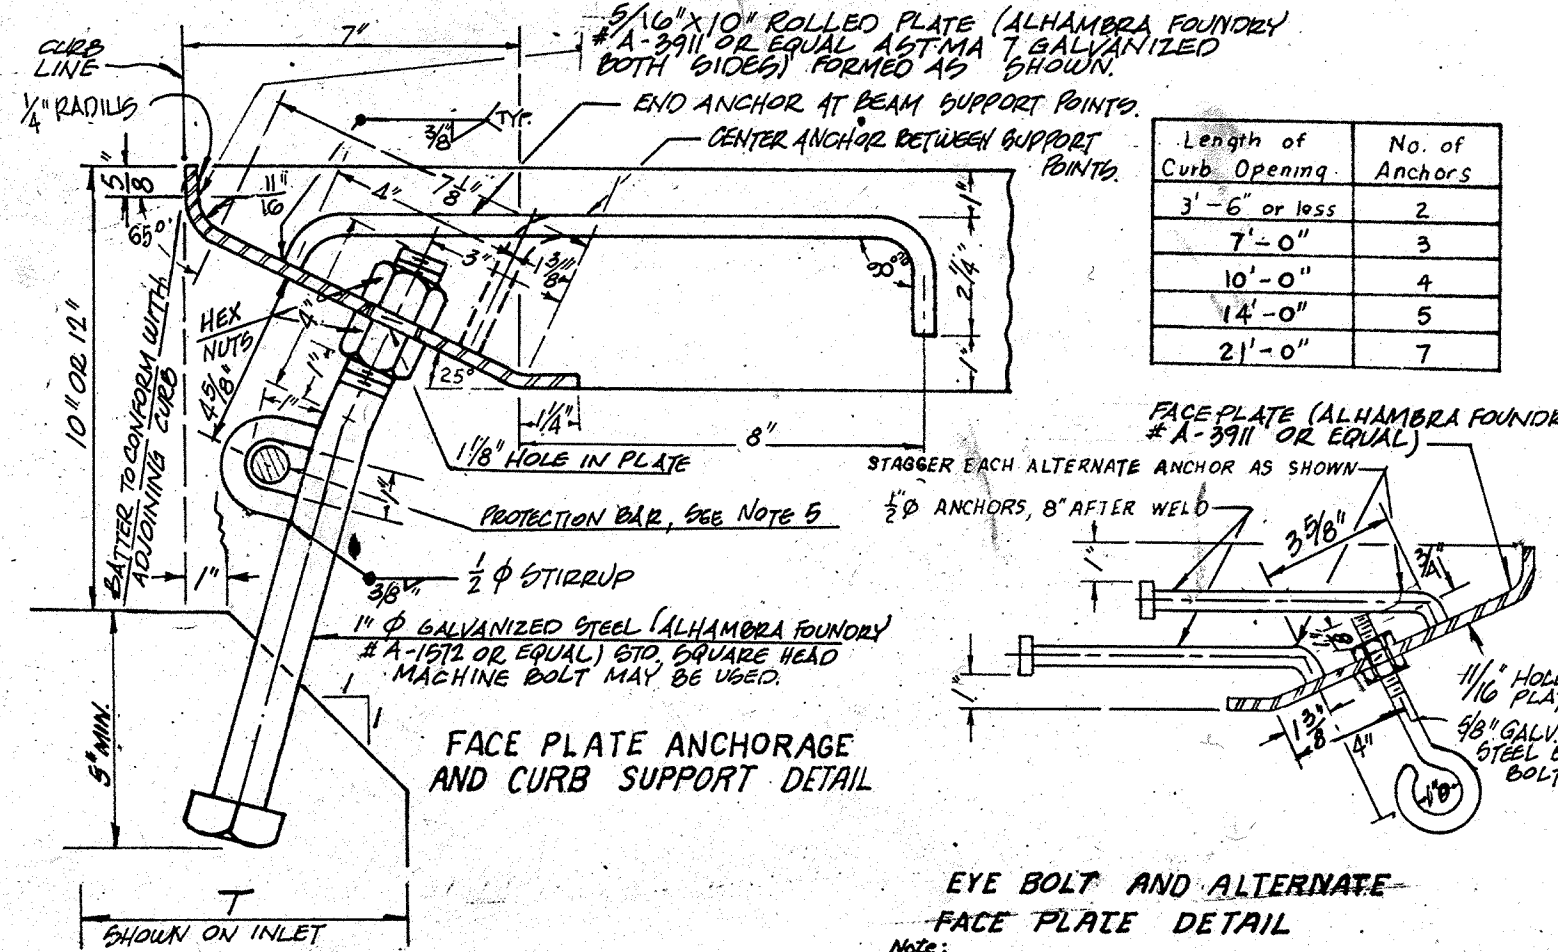
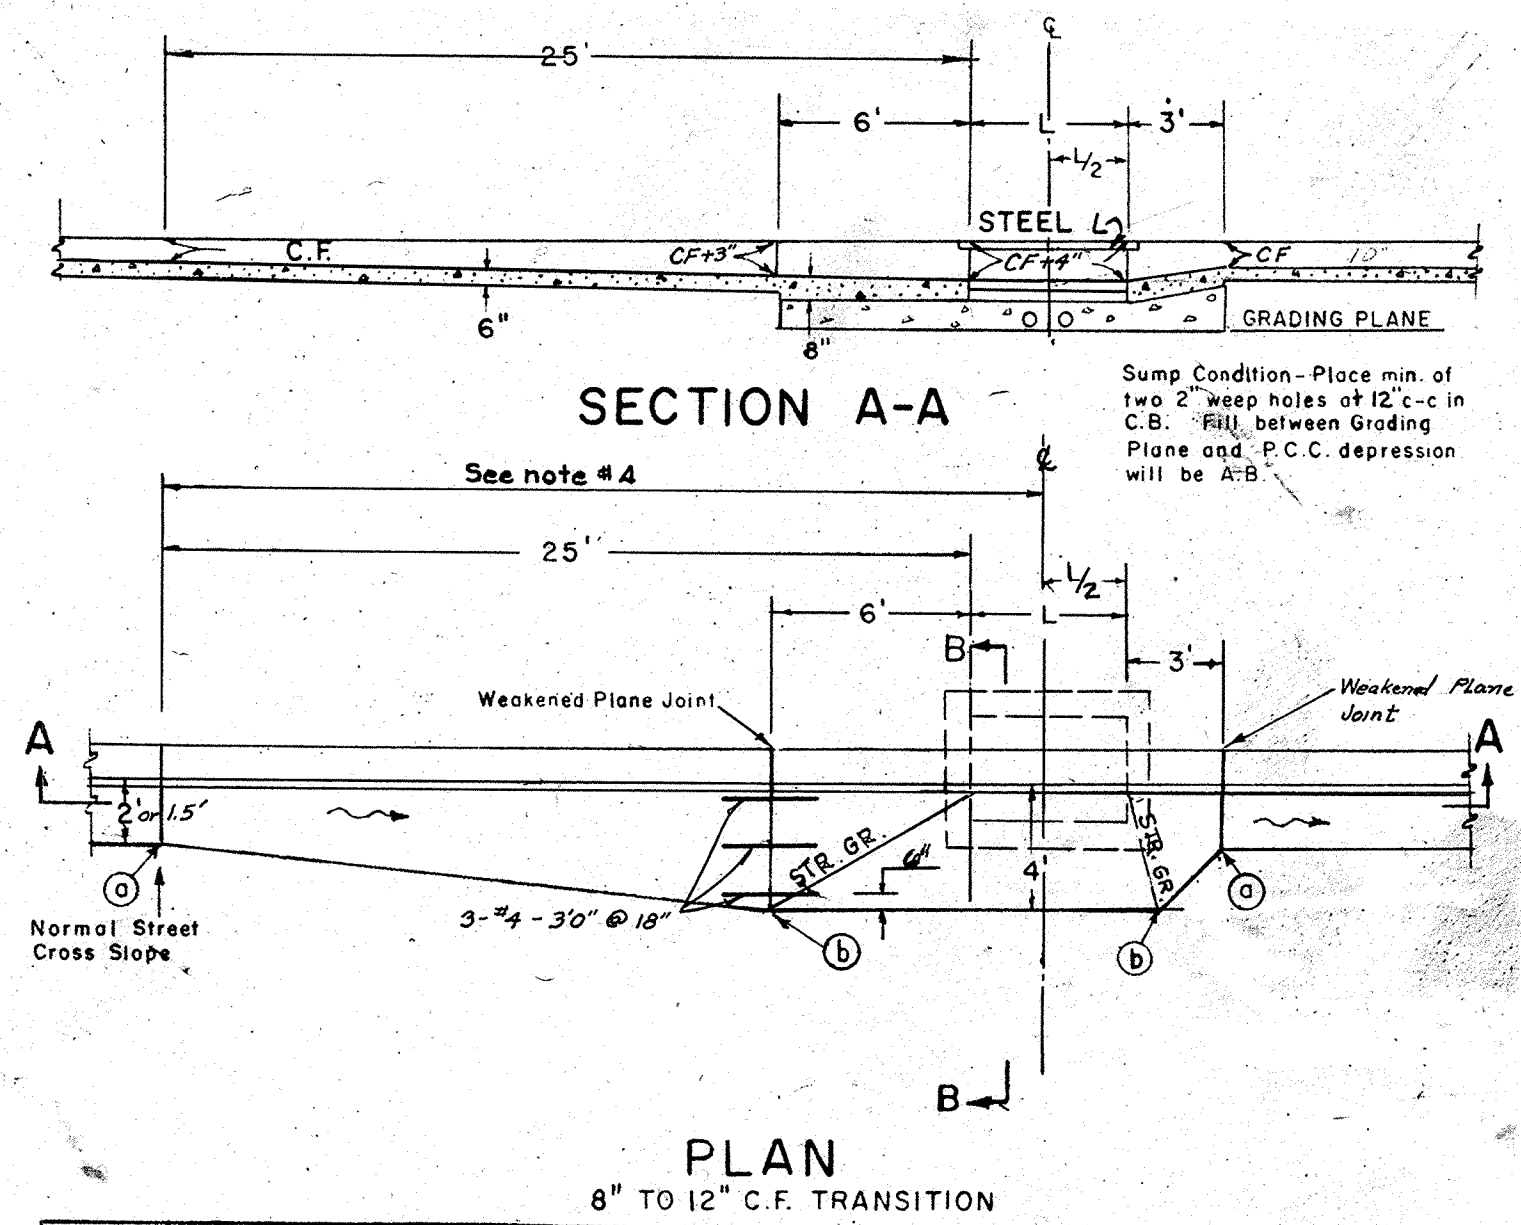
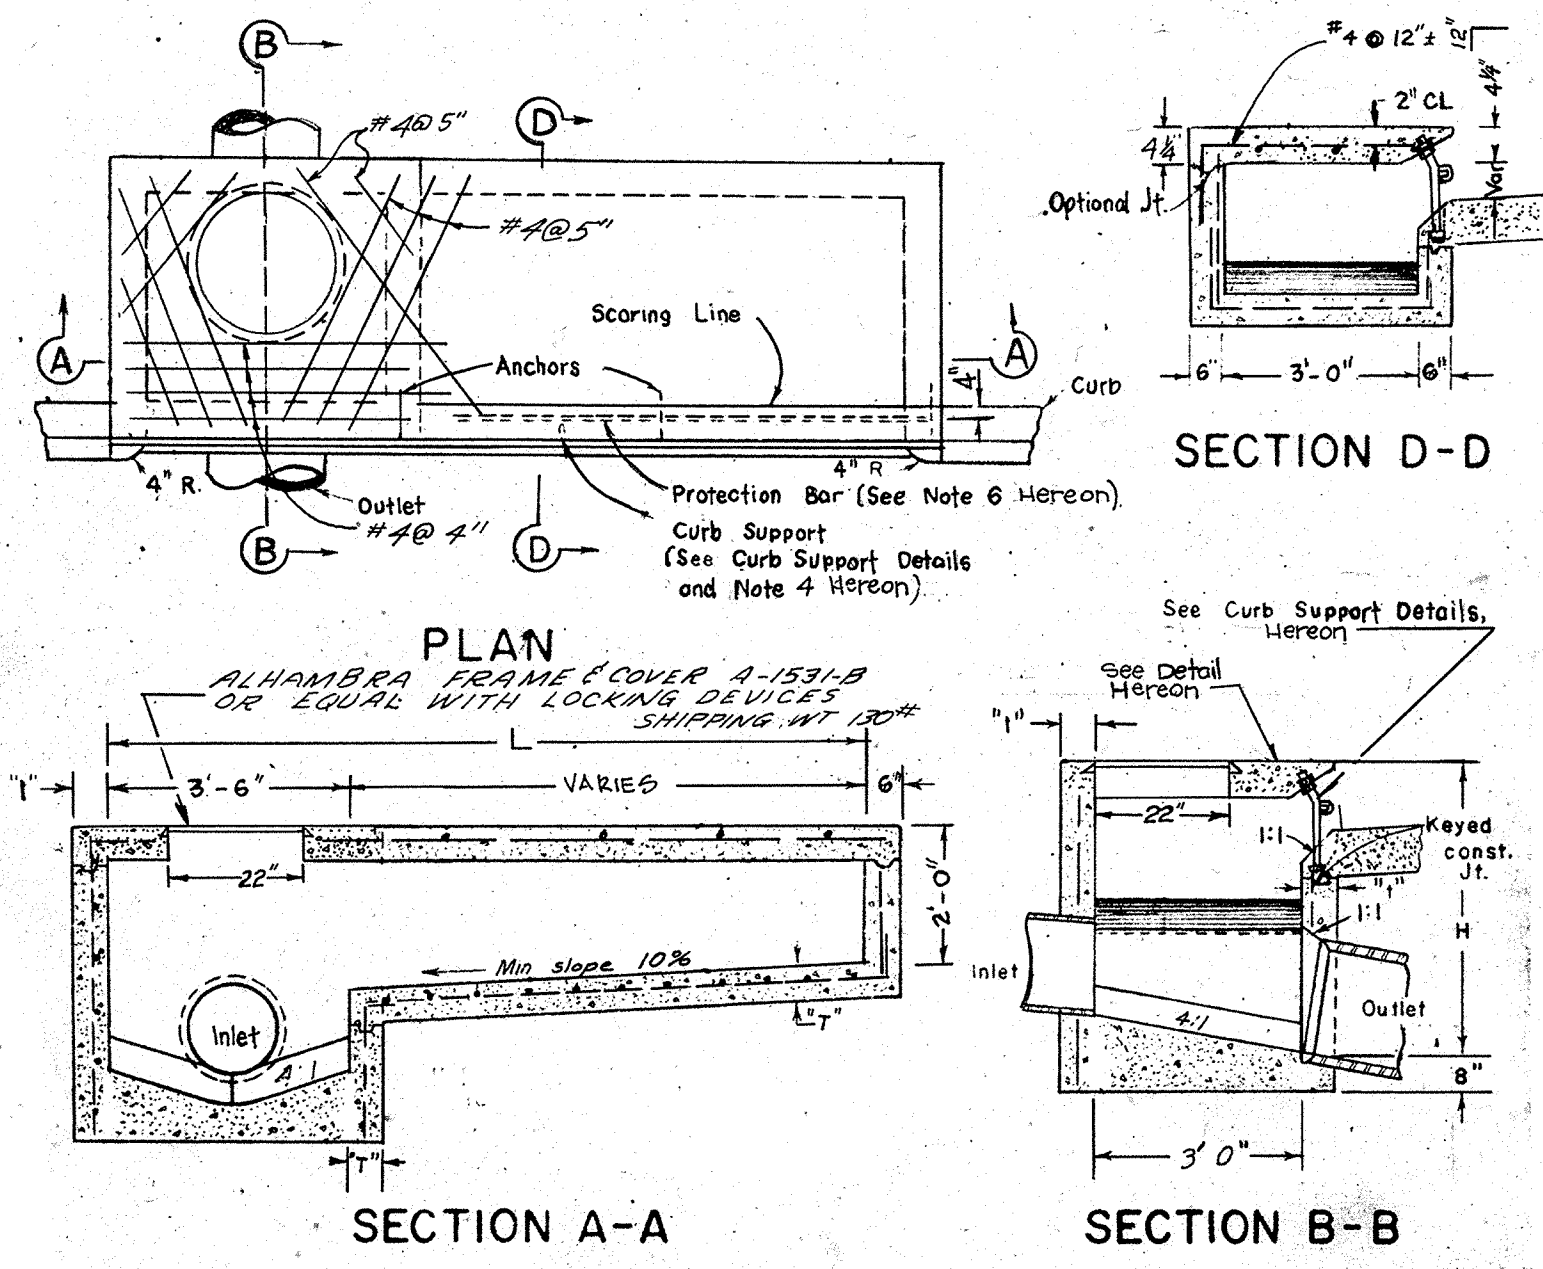
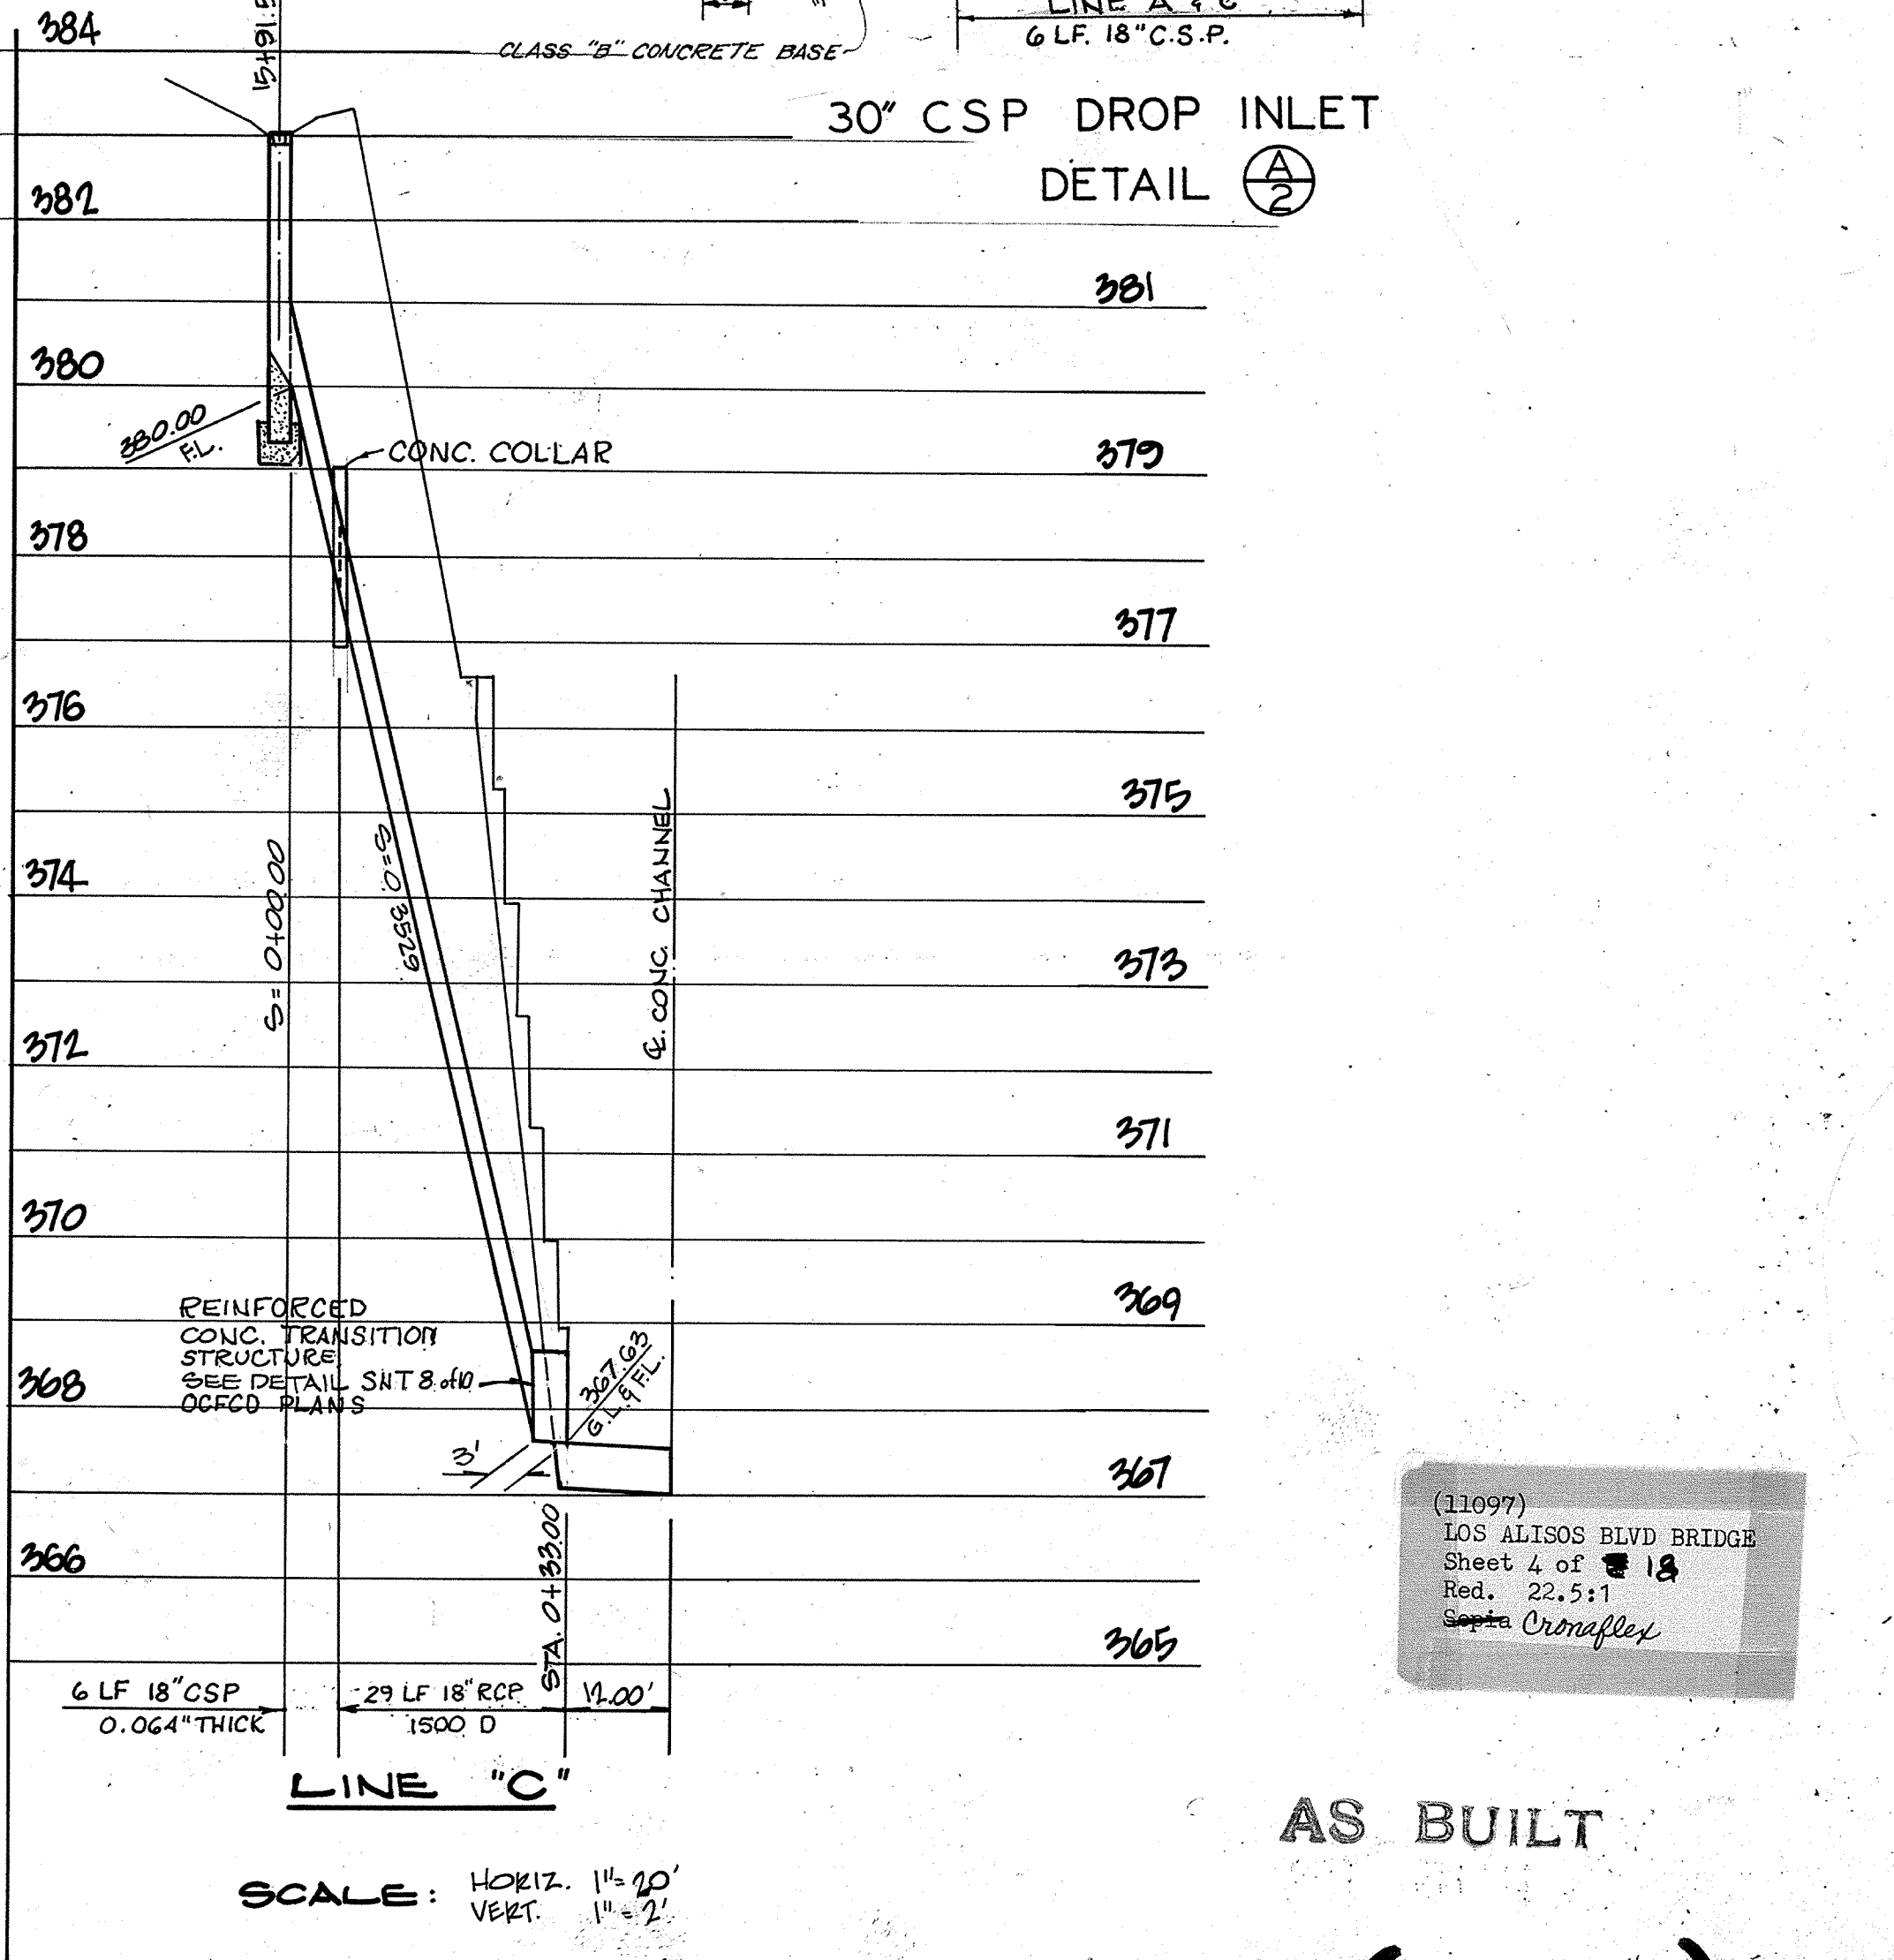
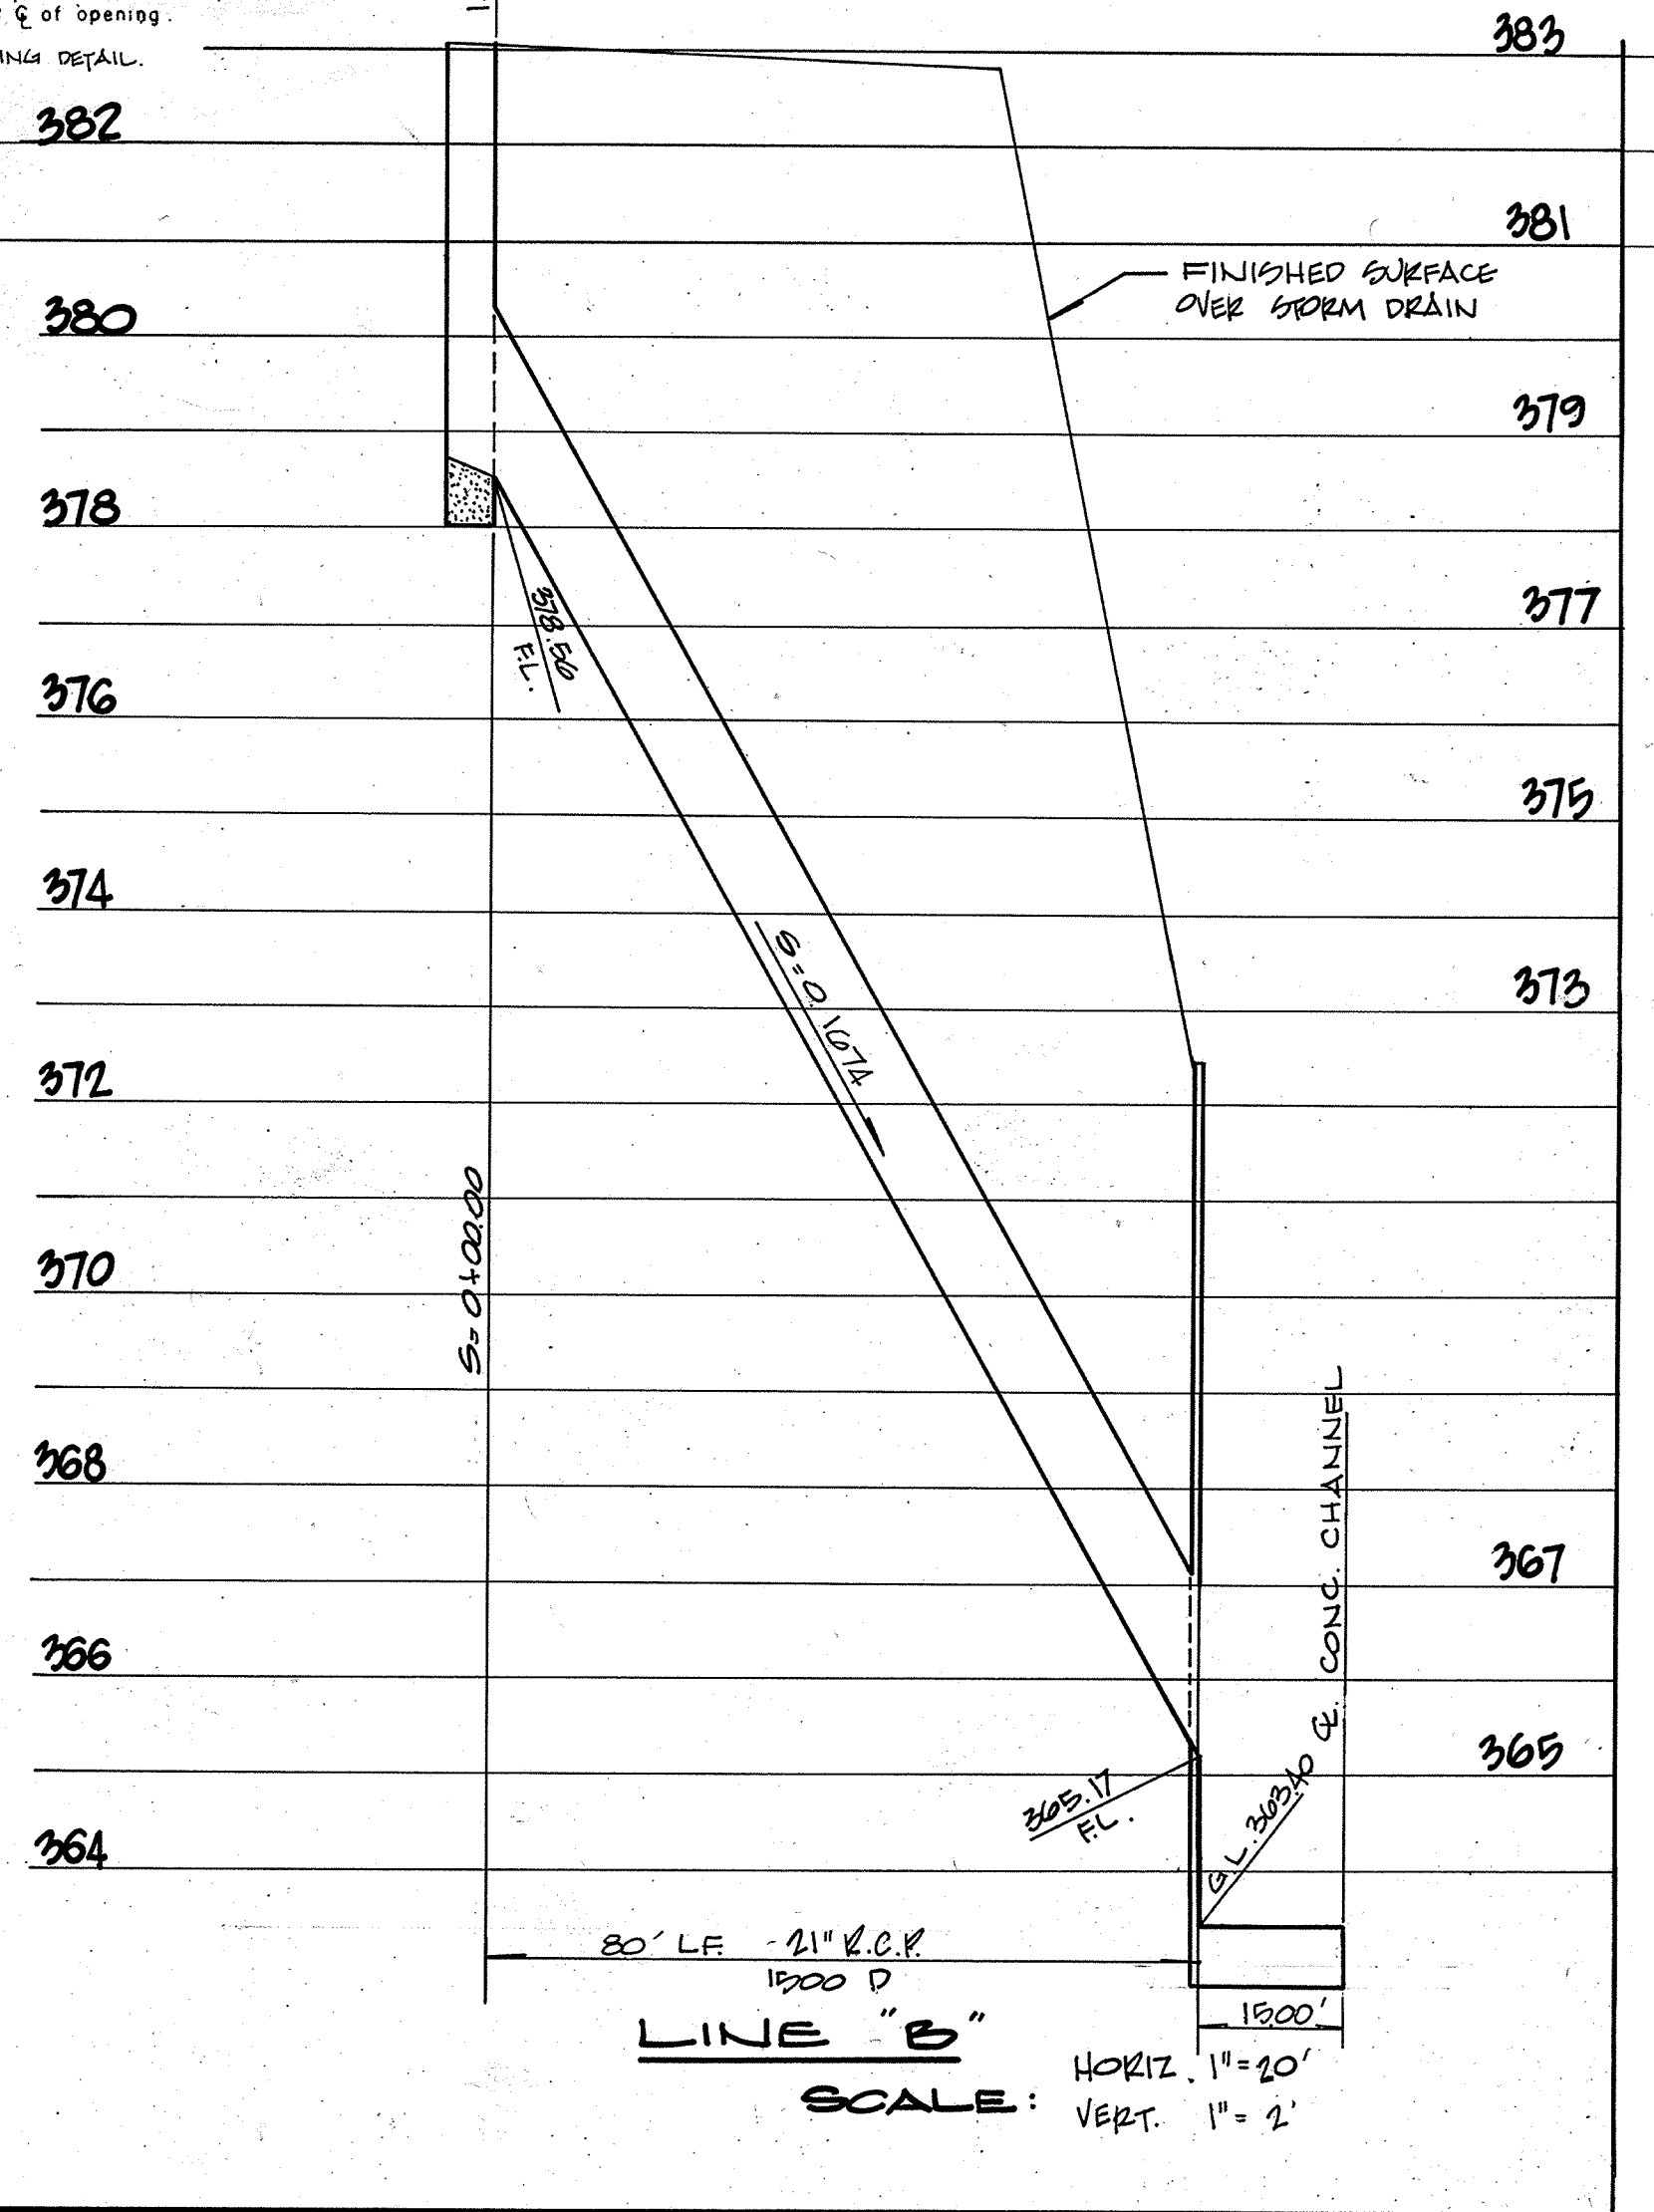


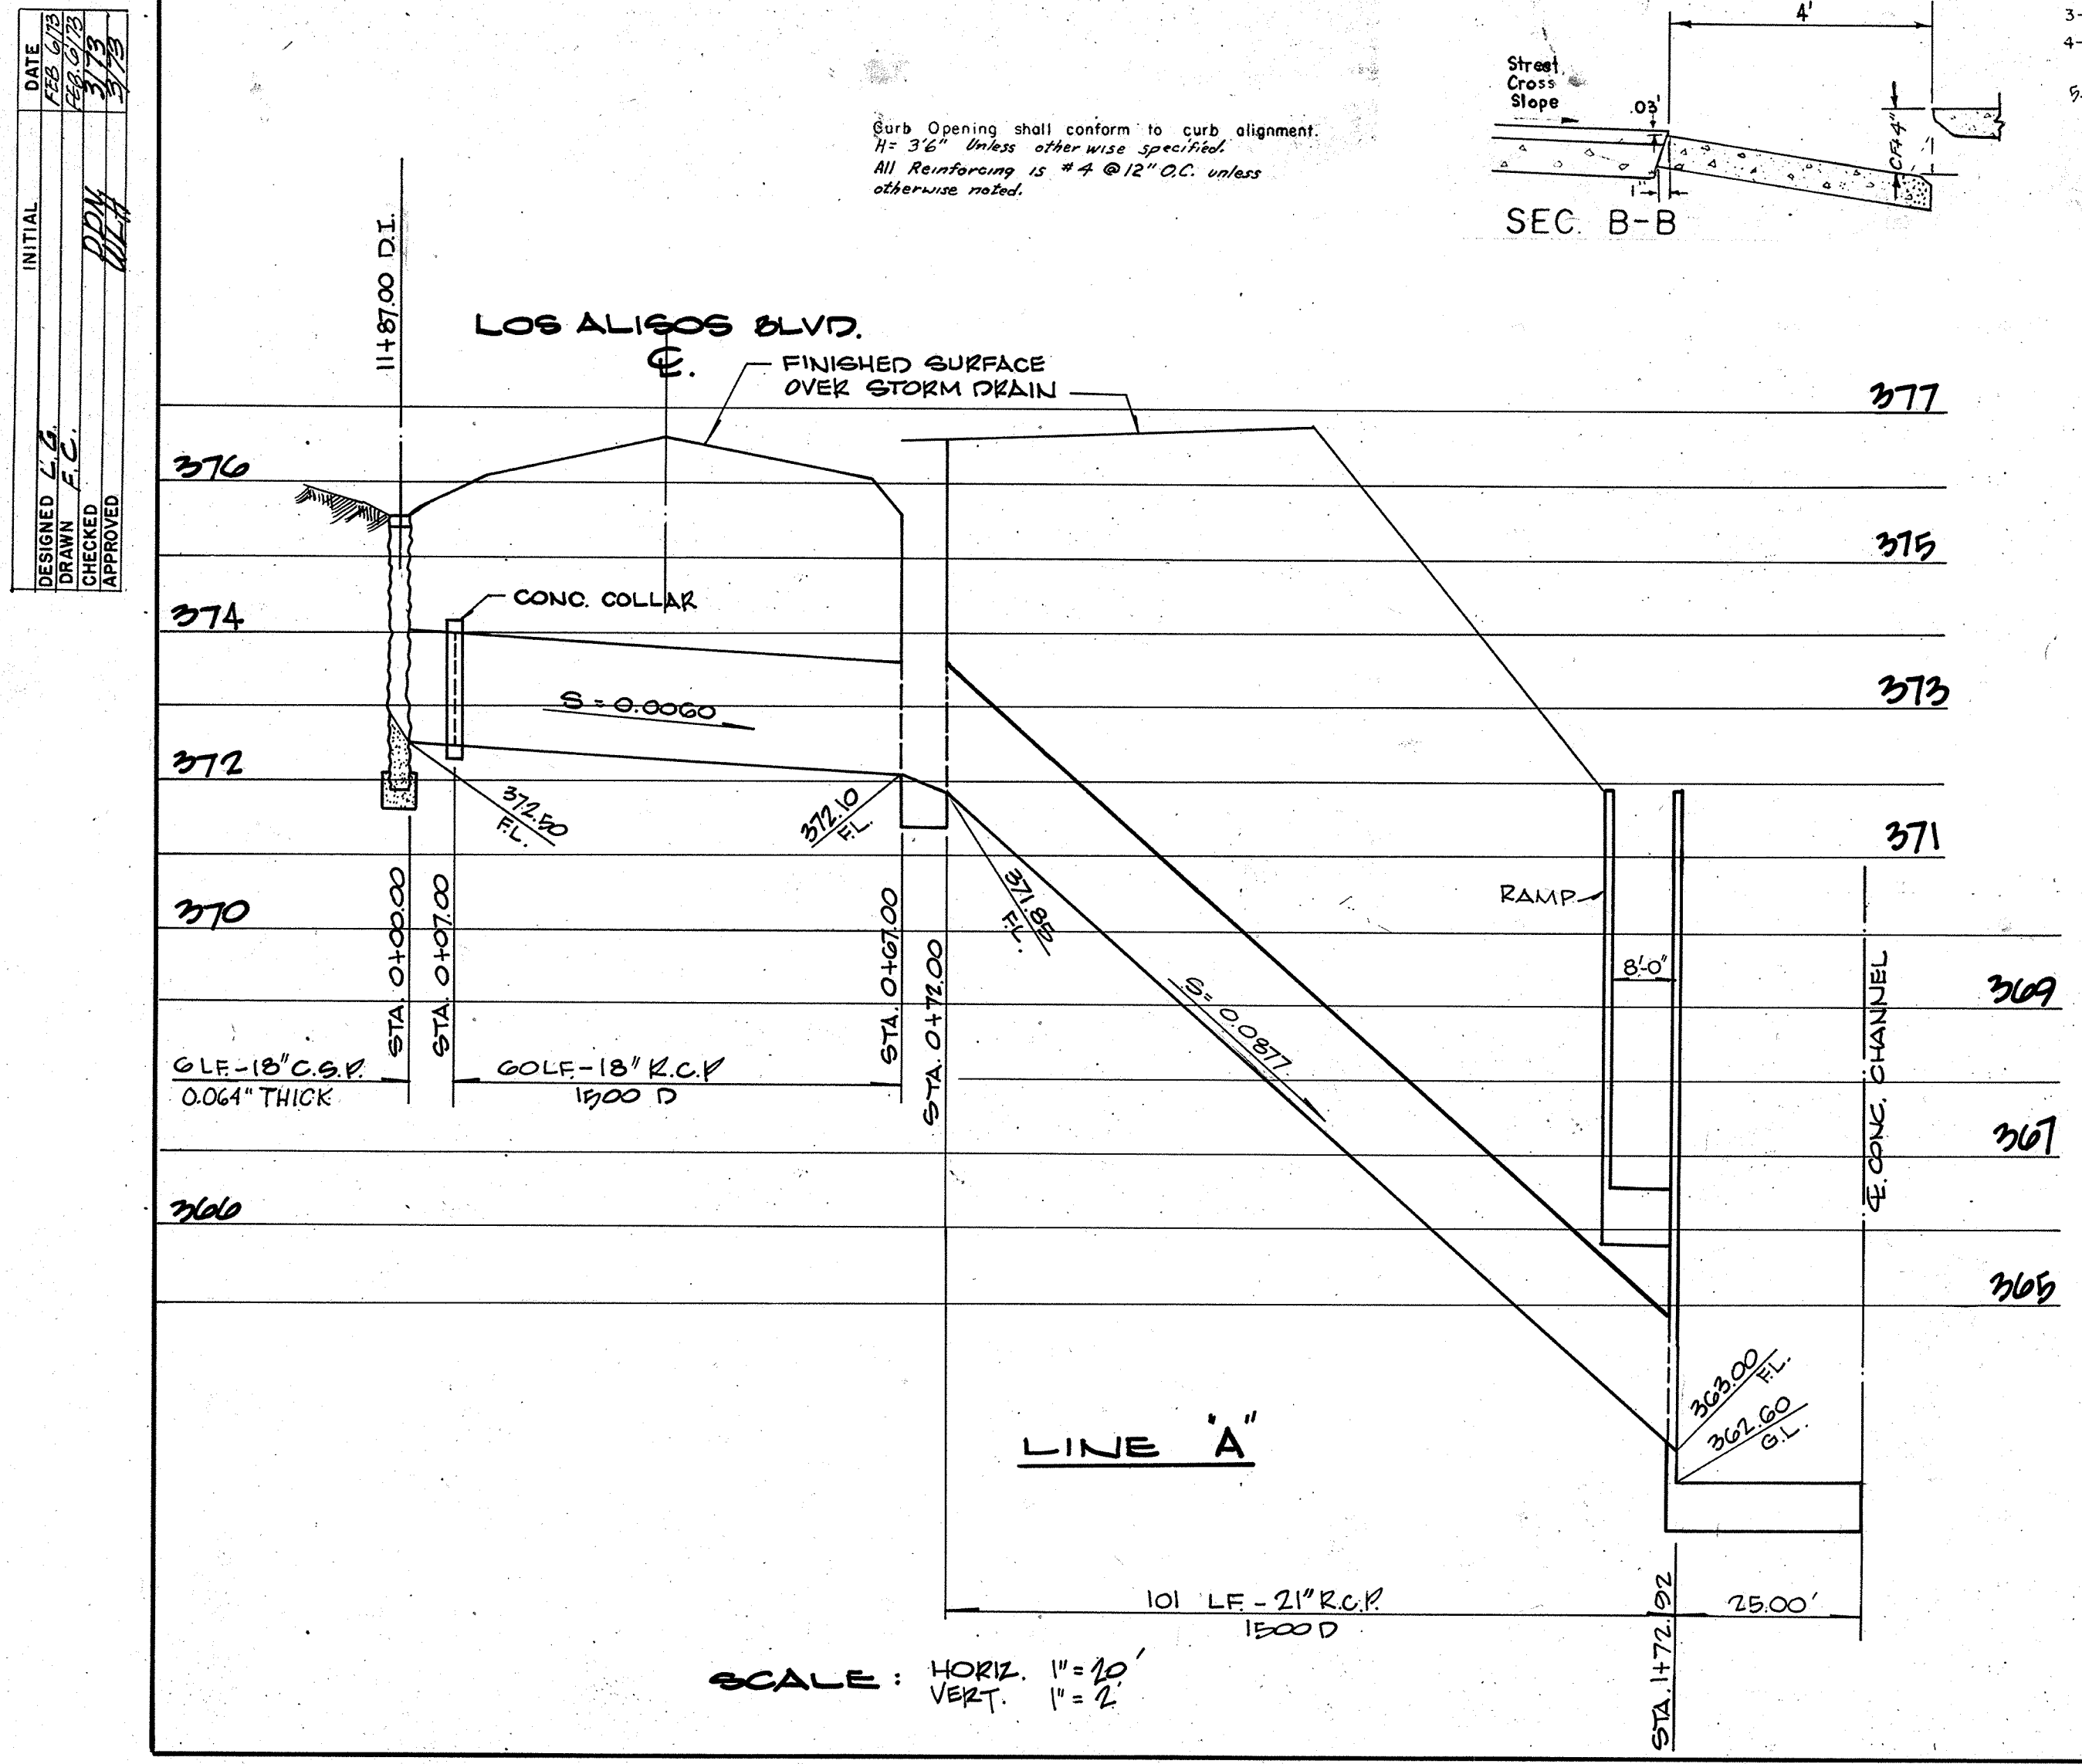

POINT	8" To 12" C.F. TRANS. Distance below T.C.	6" To 10" C.F. TRANS. Distance below T.C.
a	.50	.38
b	.47	.34

- NOTES
- 1-Local depression
 - 2-Local depression whether grate is
 - 3-"L" Length of op
 - 4-In sump condition symmetrical about
 - 5-SEE CURB OPEN

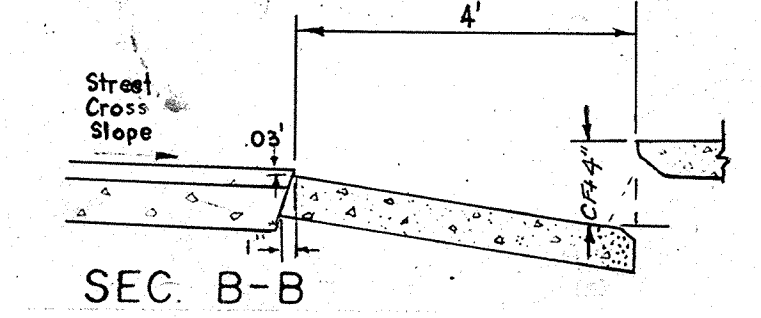

(11097)
LOS ALISOS BLVD BRIDGE
Sheet 4 of 18
Red. 22.5:1
Sopria Cronaflex

AS BUILT

(11097) W.O. 72398