
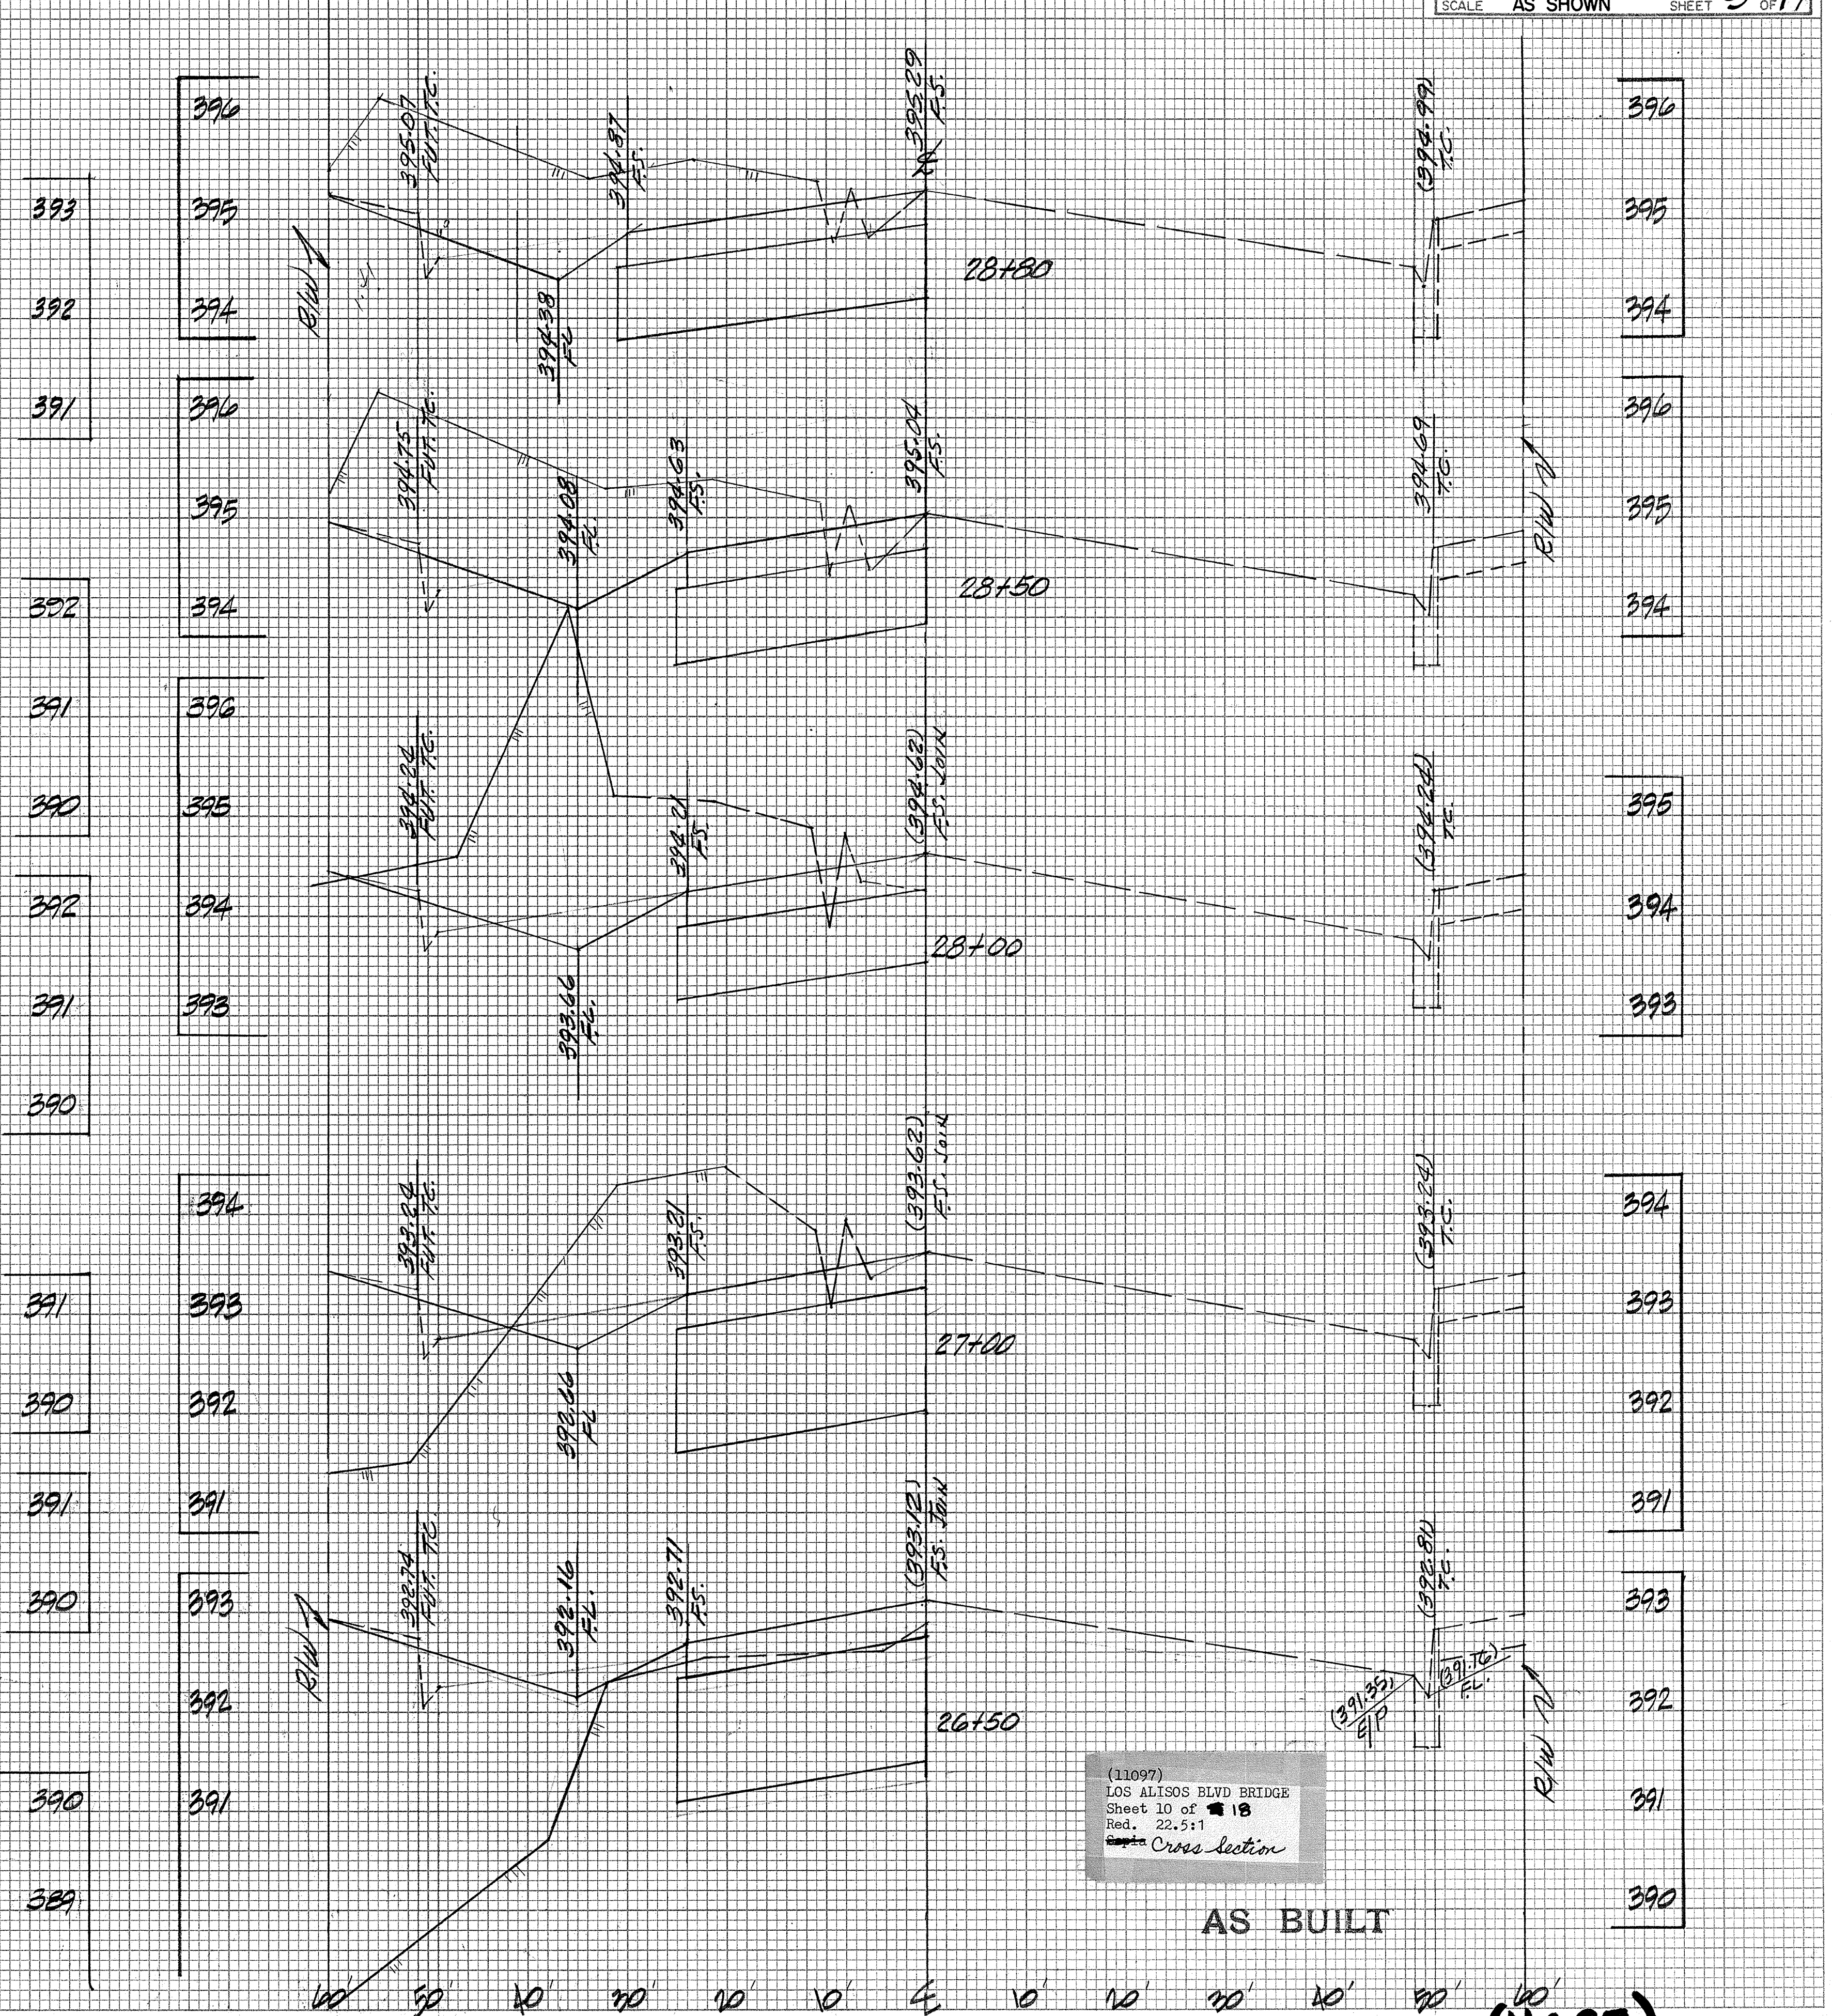


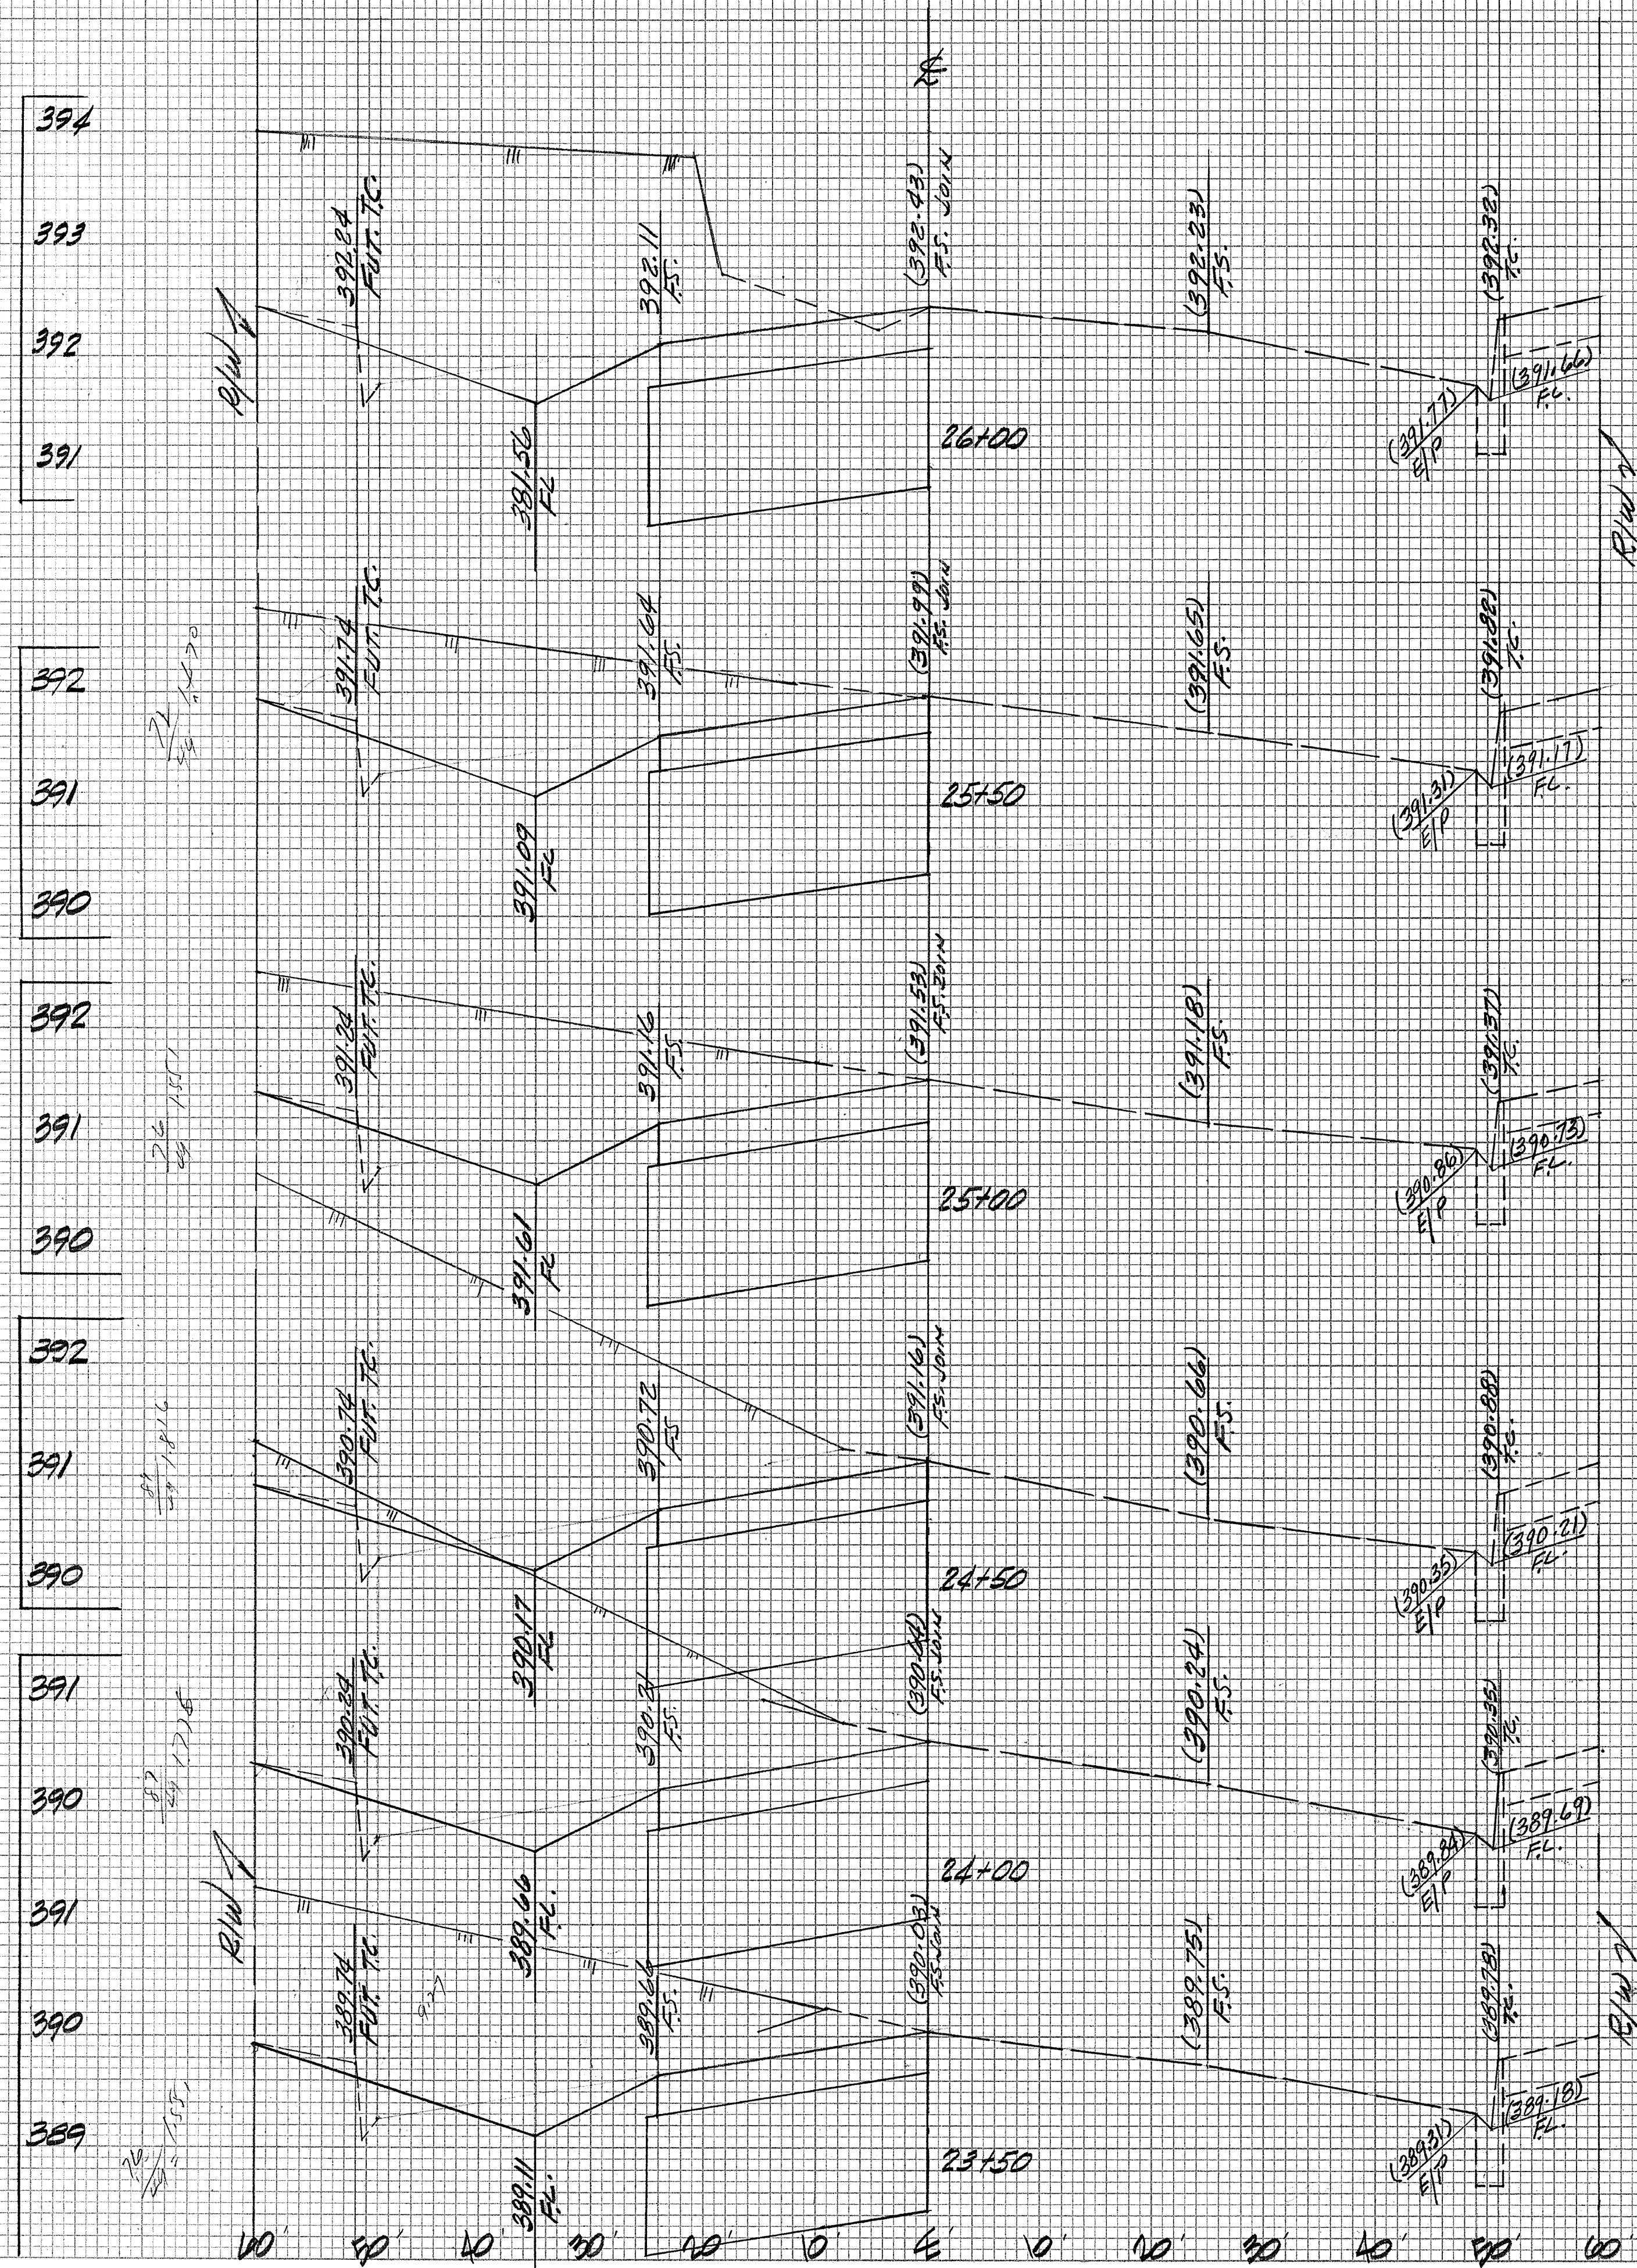

(11097)
LOS ALISOS BLVD BRIDGE
Sheet 10 of 18
Red. 22.5:1
~~Supra~~ Cross Section

AS BUILT