

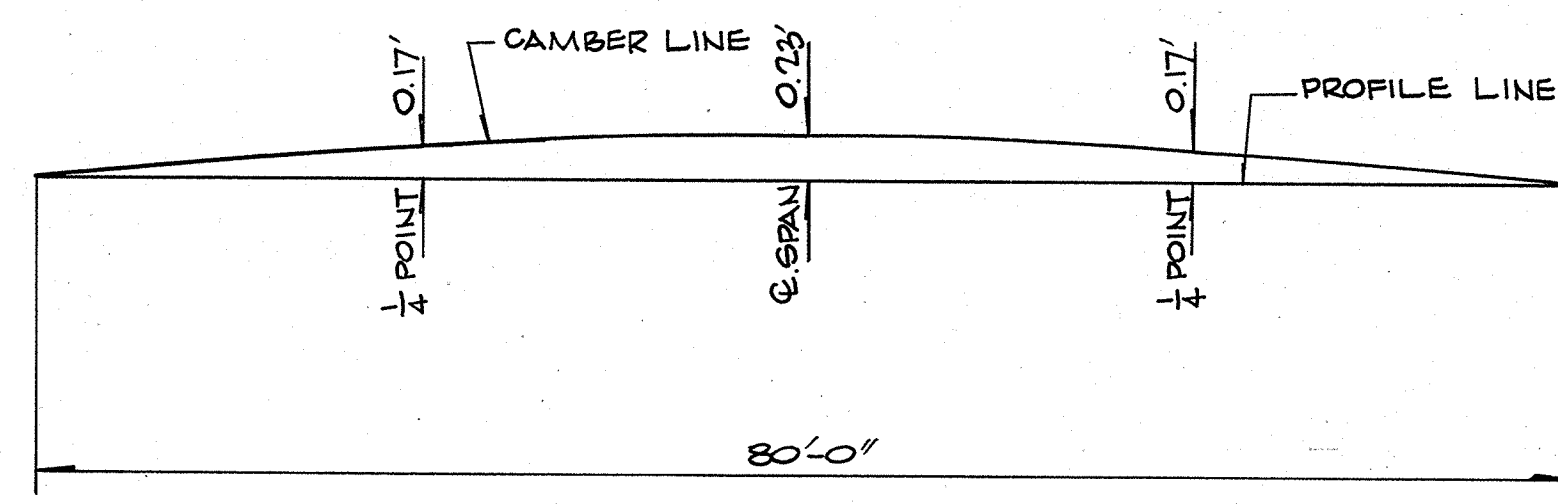


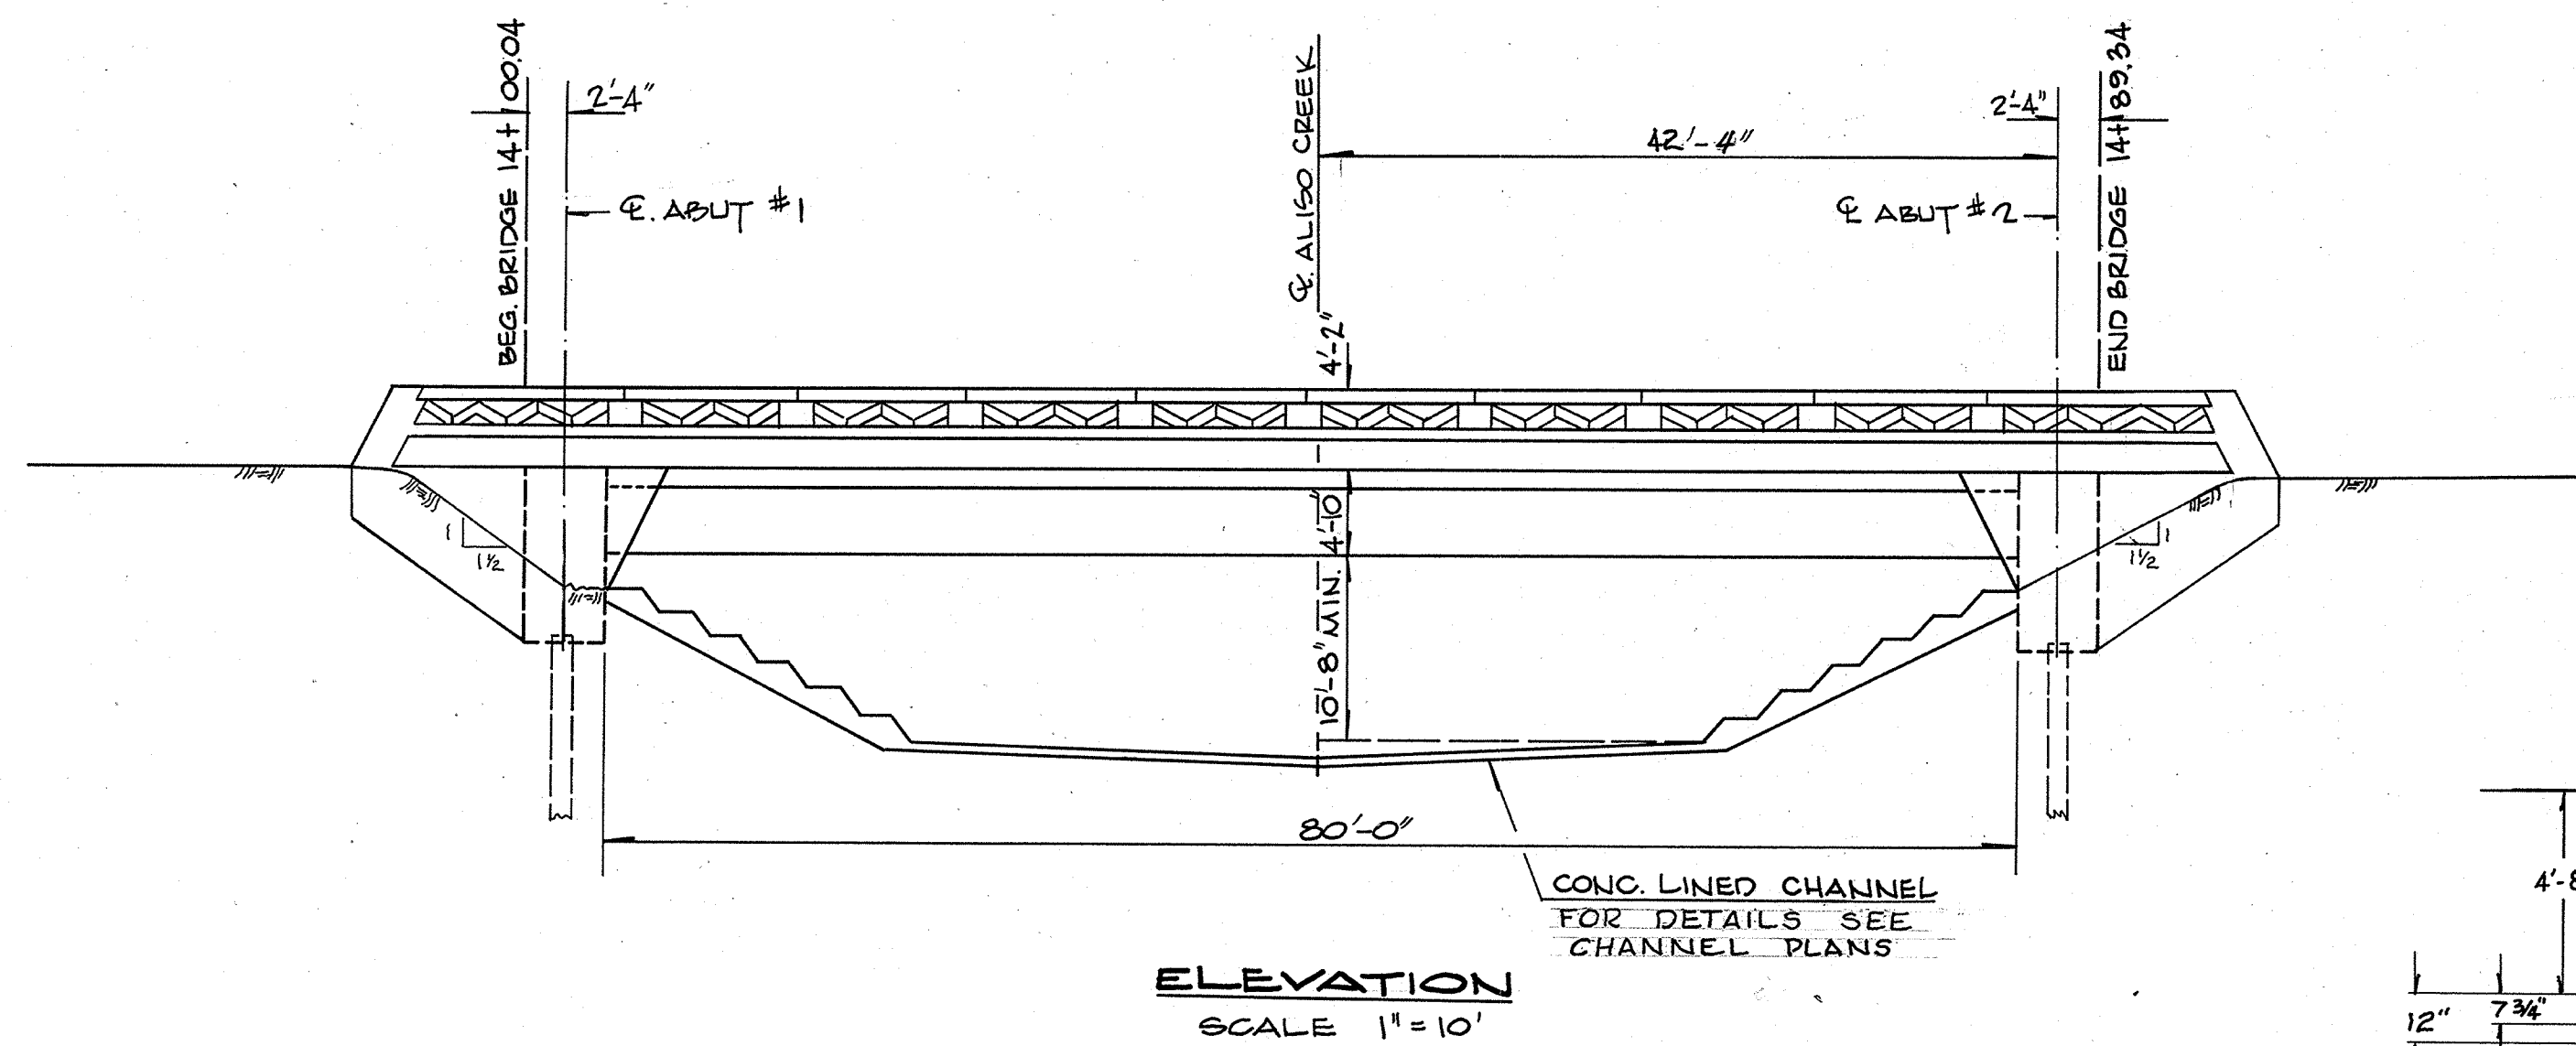

NOTE:

THE TOTAL DEFLECTION WILL BE REACHED ABOUT FOUR YEARS AFTER FALSEWORK REMOVAL. FOR VALUES AT TIME OF FALSEWORK REMOVAL DIVIDE THOSE SHOWN BY FOUR. THE AMOUNT OF CAMBER FOR CONSTRUCTION SHALL BE DETERMINED BY THE ENGINEER.

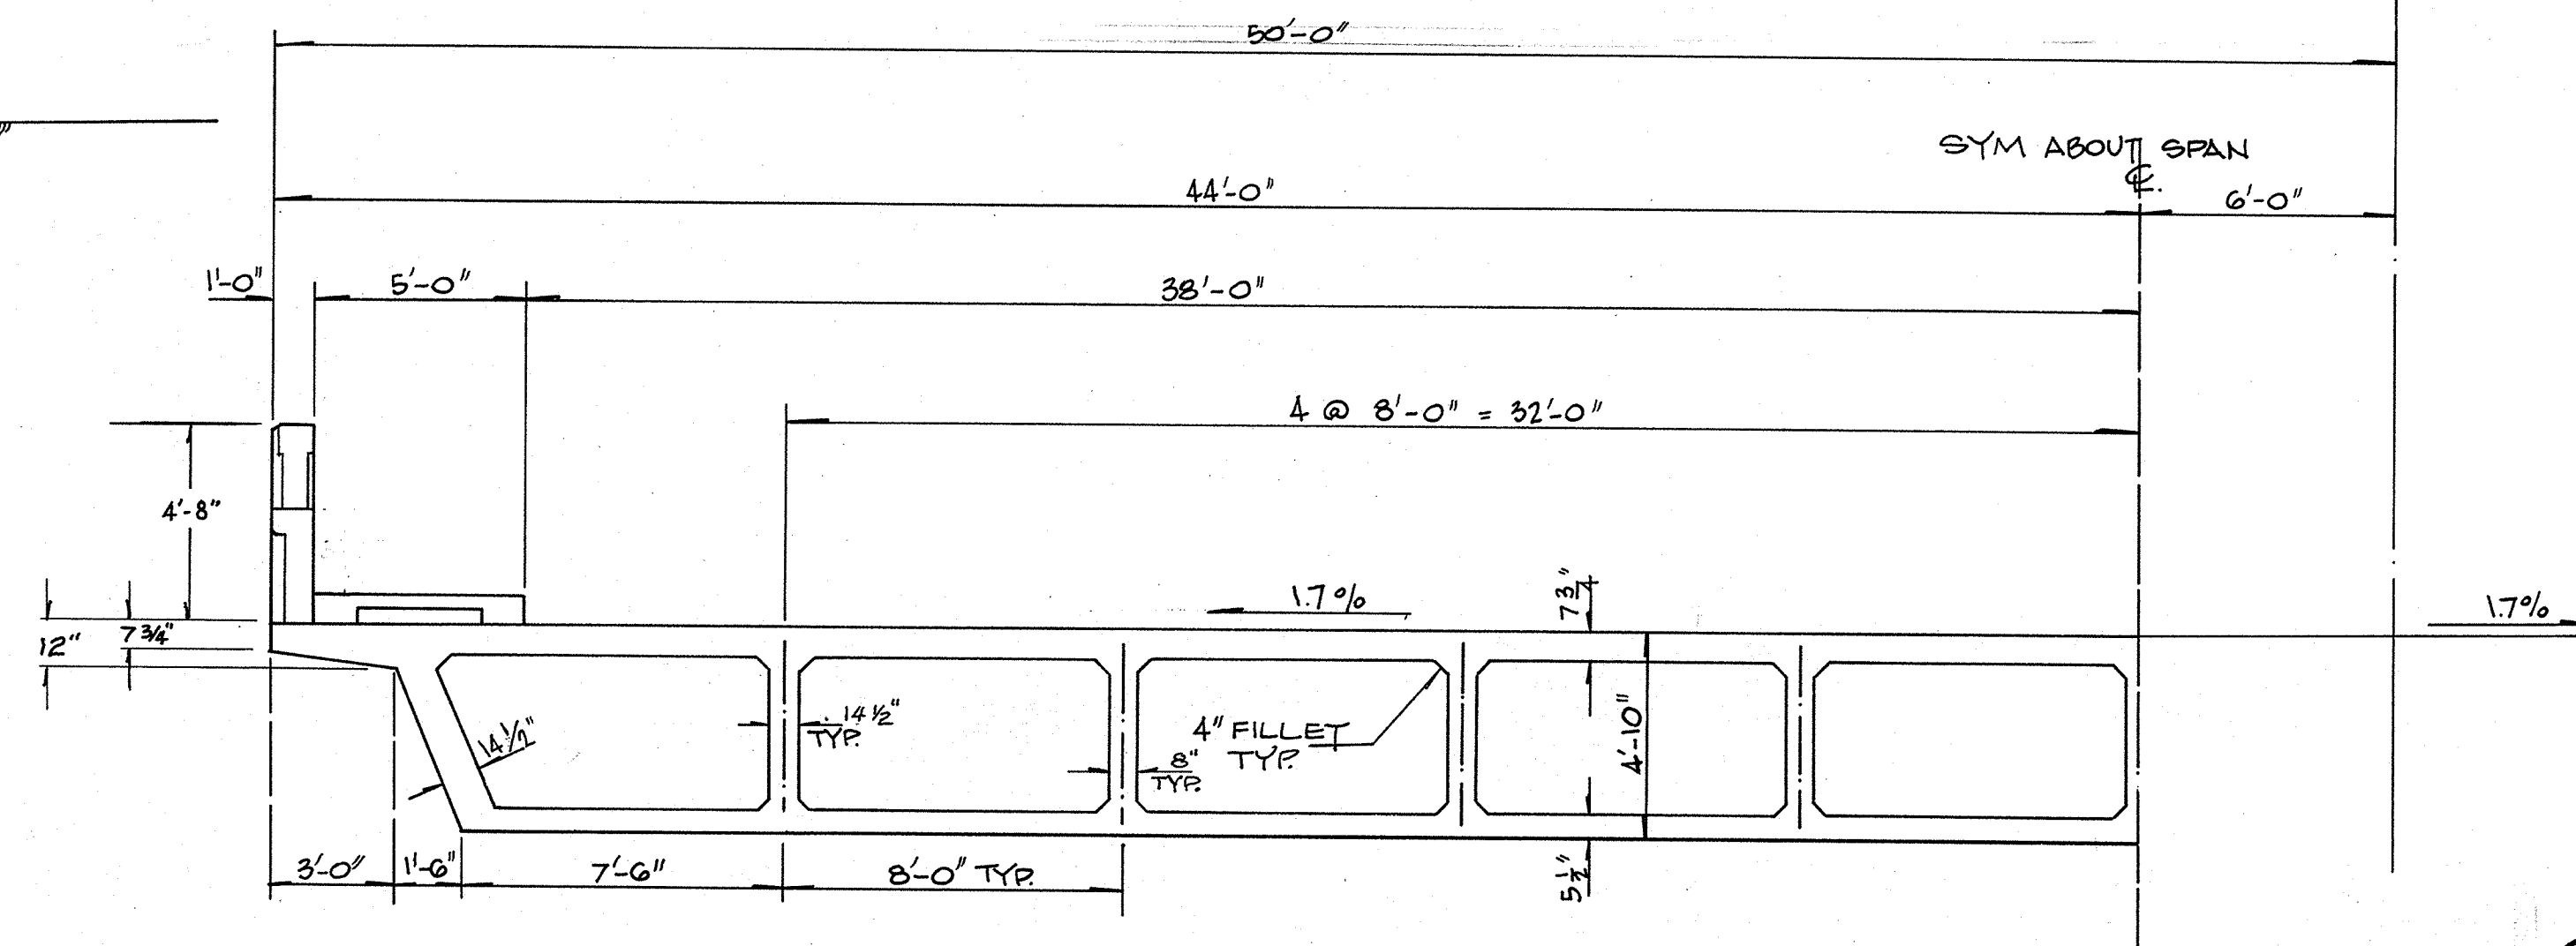

GENERAL NOTES

SPECIFICATIONS:

DESIGN: A.A.S.H.O. DATED 1969 WITH SUBSEQUENT REVISIONS, AND CALIFORNIA DIVISION OF HIGHWAYS BRIDGE PLANNING AND DESIGN MANUAL.

CONSTRUCTION:
STANDARD SPECIFICATIONS, DIVISION OF HIGHWAYS,
CALIF. DATED JAN. 1971 AND THE SPECIAL PROVISIONS

LIVE LOADING:

H20 - SIG-44

UNIT STRESSES:

REINFORCING STEEL :

f_s TENSION = 24,000 P.S.I.; 10,000 P.S.I. IN SLAB

CONCRETE: $f_c = 1,300$ P.S.I.; 1,200 P.S.I. IN SLAB
 $f_c' = 3,150$ P.S.I. @ 28 DAYS.
 $n = 10$
 $V_c = 60$ P.S.I.

FILE LOADING:

45 TONS, CLASS 45-1 PER SHEET NO 15,

REINFORCEMENT:


EMBEDMENT IS CLEAR TO OUTSIDE OF BAR AND IS 2" TO MAIN REINFORCEMENT, EXCEPT AS NOTED. BACKING FOR HOOKS IS FOUR DIAMETERS, EXCEPT AS NOTED. WHERE REINFORCING BARS ARE SPLICED THEY SHALL HAVE A 40 DIAMETERS LAP UNLESS OTHERWISE NOTED.

CONCRETE:

CLASS "A" USING TYPE II PORTLAND CEMENT.
(COLORED AS PER SPEC. PROVISIONS)

BENCH MARK:

JOI - III-G
R.R SPIKE W'LY. SIDE OF POWER POLE #1961254E,
74' ± N'LY. OF MUIRLANDS, 150' E'LY. OF CREEK.
ELEV. 402.93

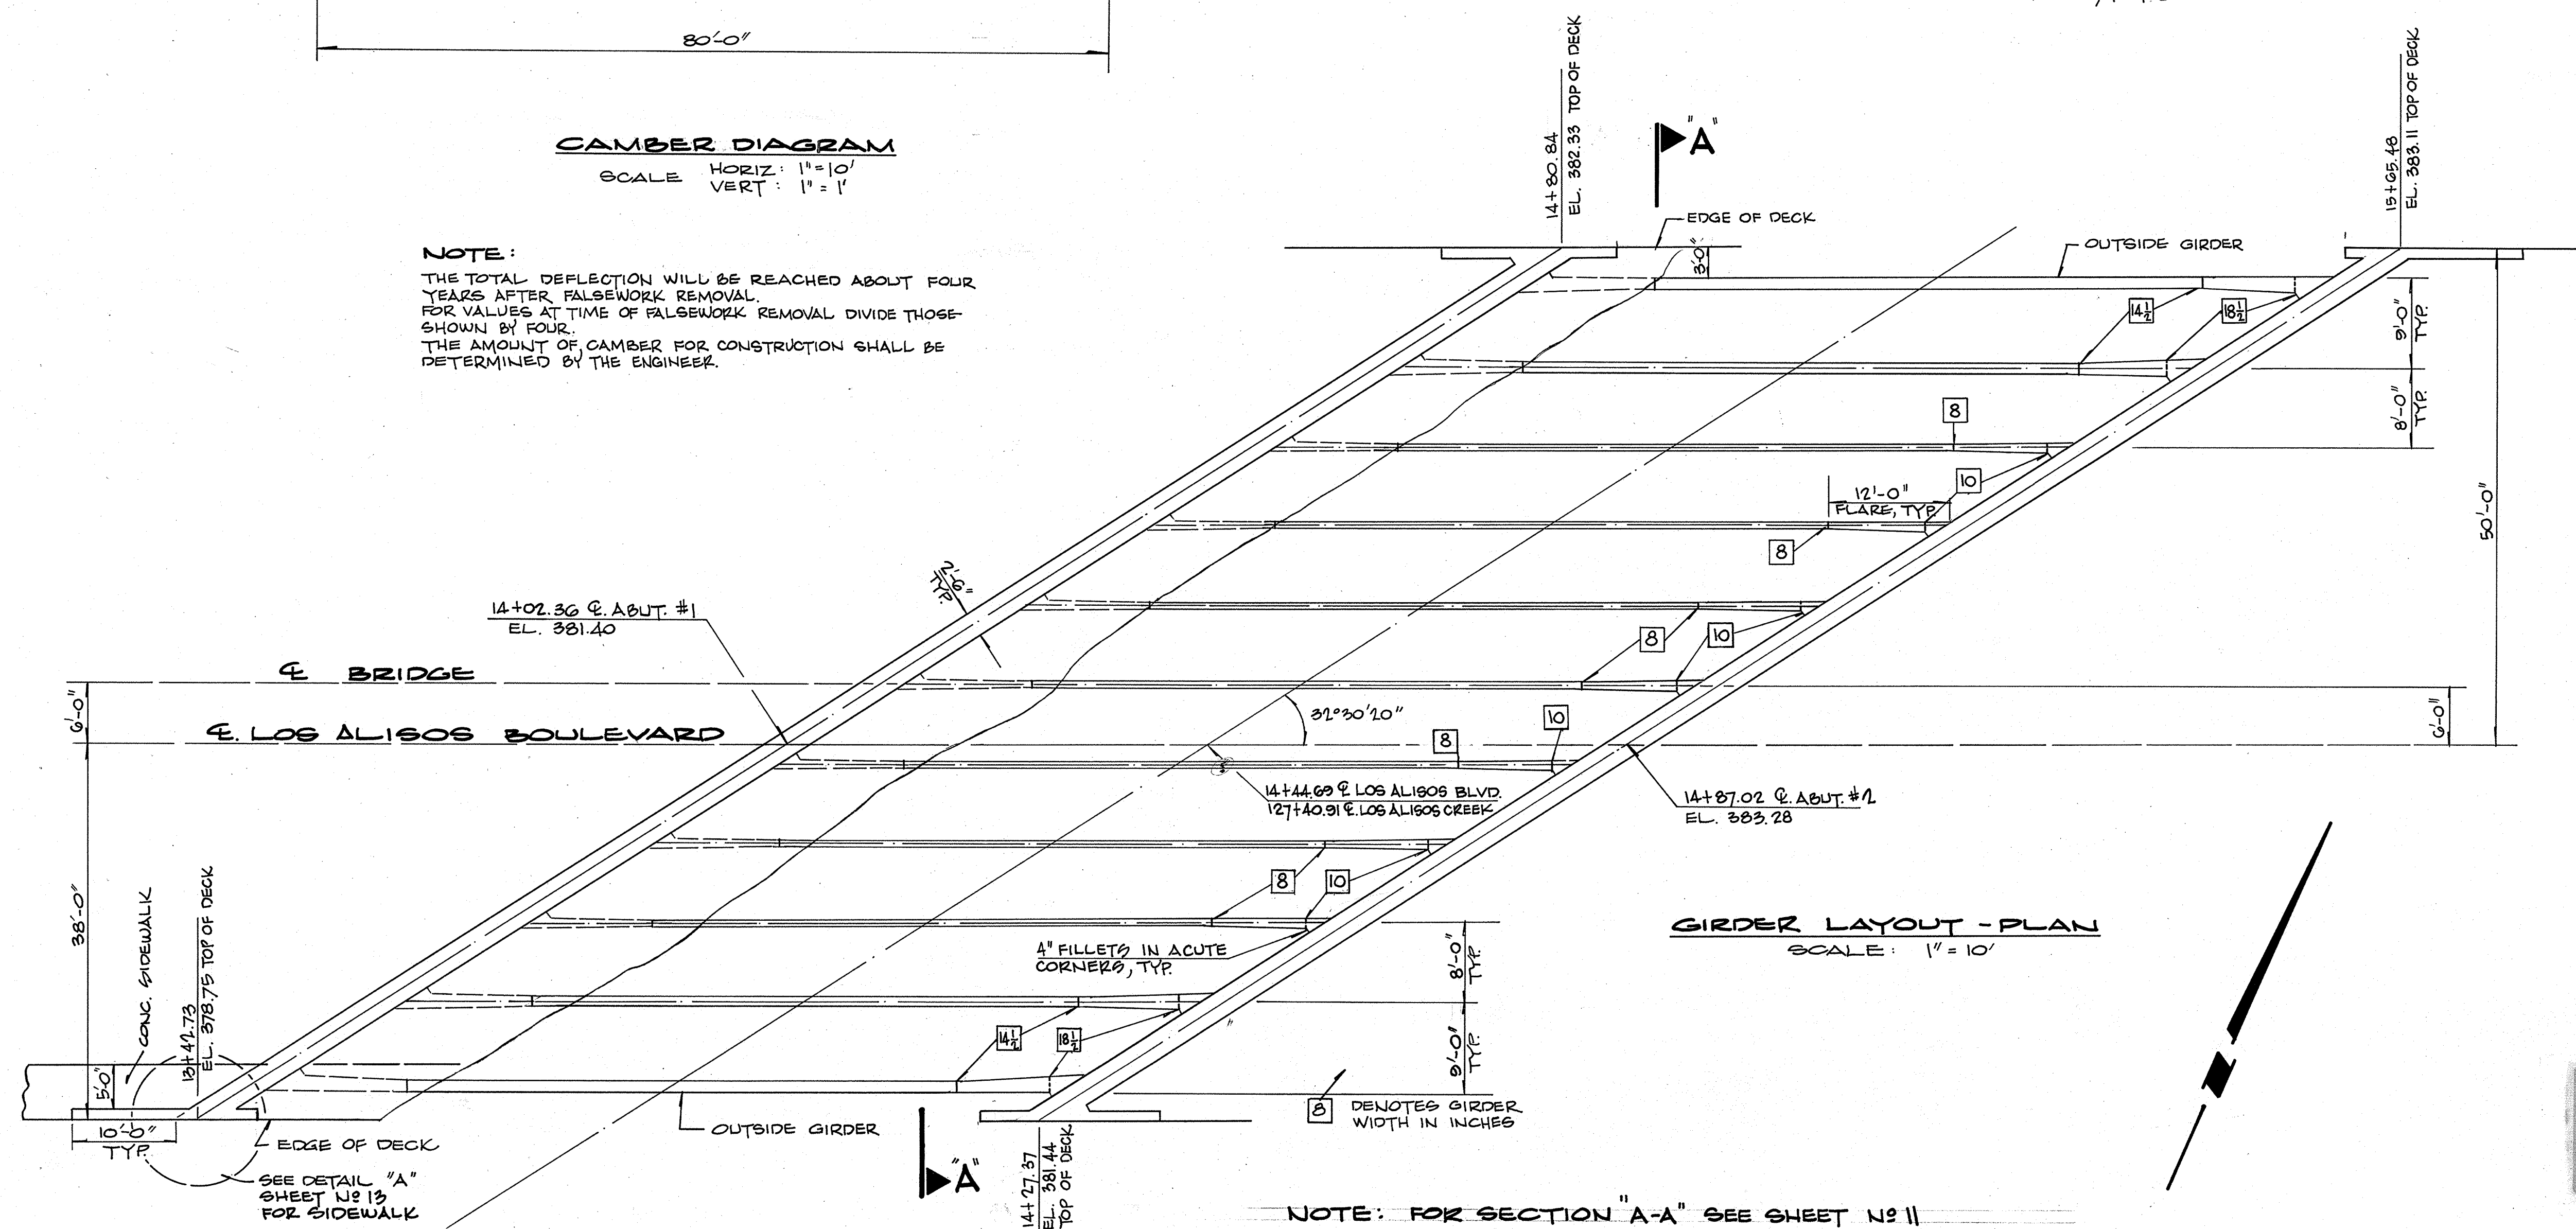

NOTE: FOR SECTION "A-A" SEE SHEET NO 11

AS BUILT

ORANGE COUNTY ROAD DEPARTMENT

LOS ALISOS BLVD.
BRIDGE AL-12
OVER
ALISO CREEK

GENERAL PLAN

F 1151-64.1
SCALE AS NOTED

SHEET 10 OF 17

(11097)
LOS ALISOS BLVD BRIDGE
Sheet 11 of 18
Red. 22.5:1
Scale 1/2"

(41097)

142 07239