

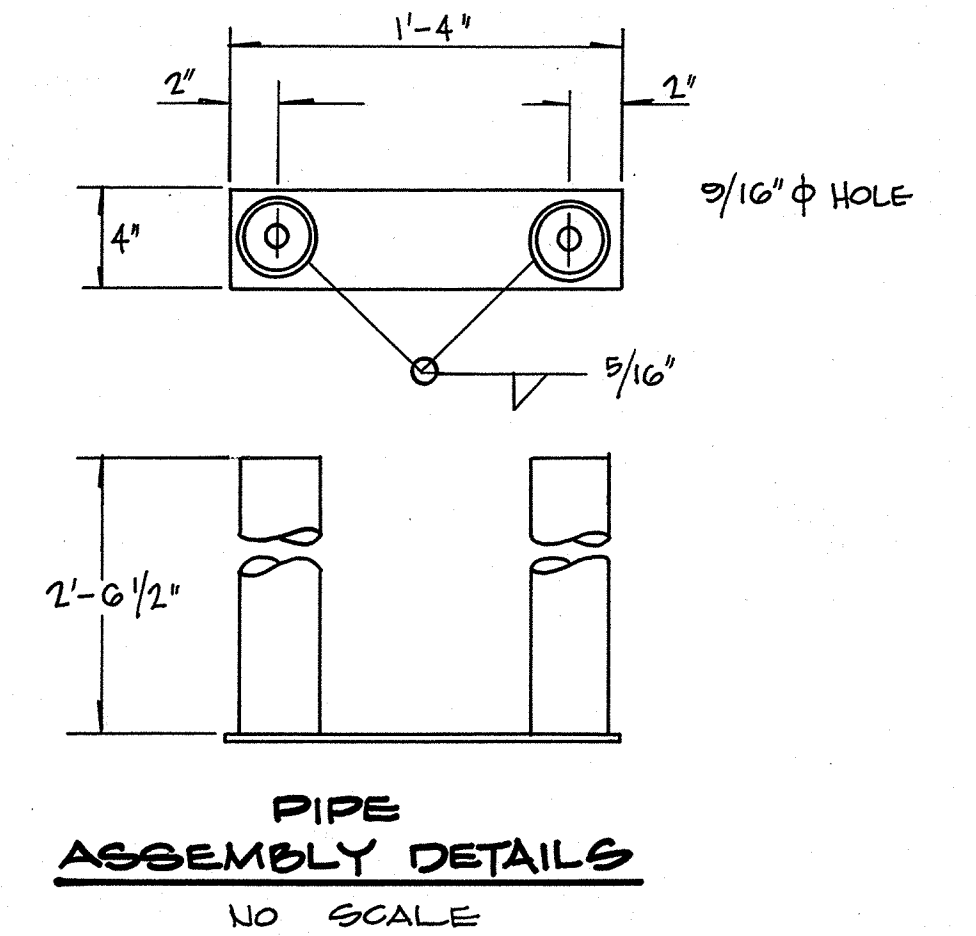
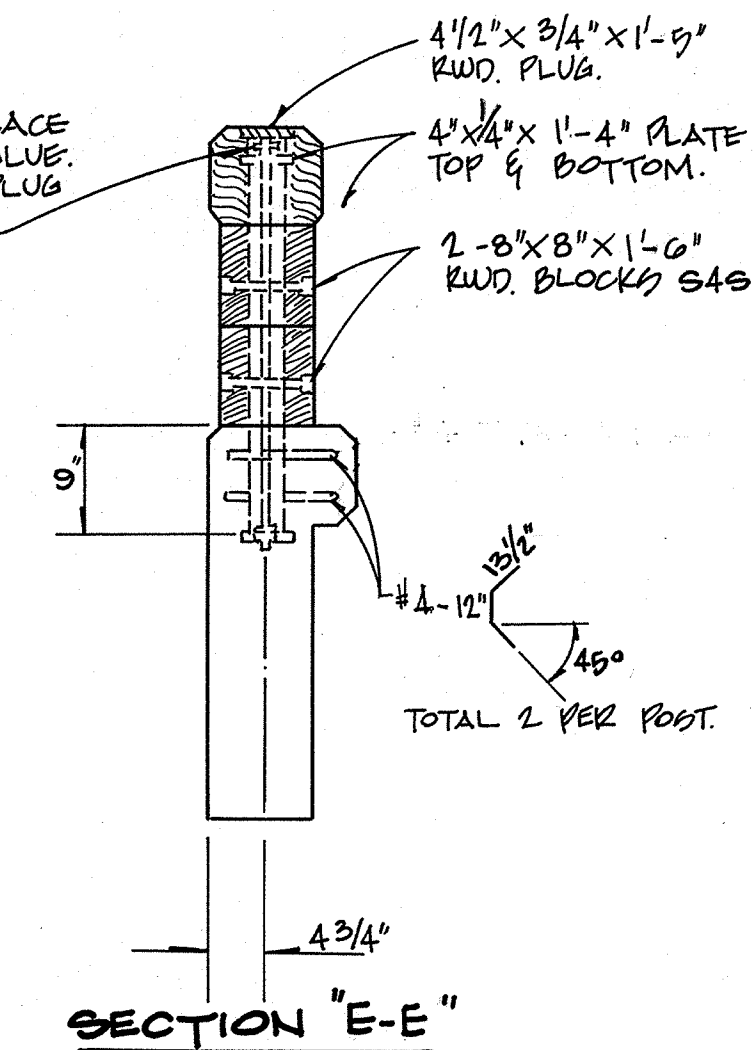
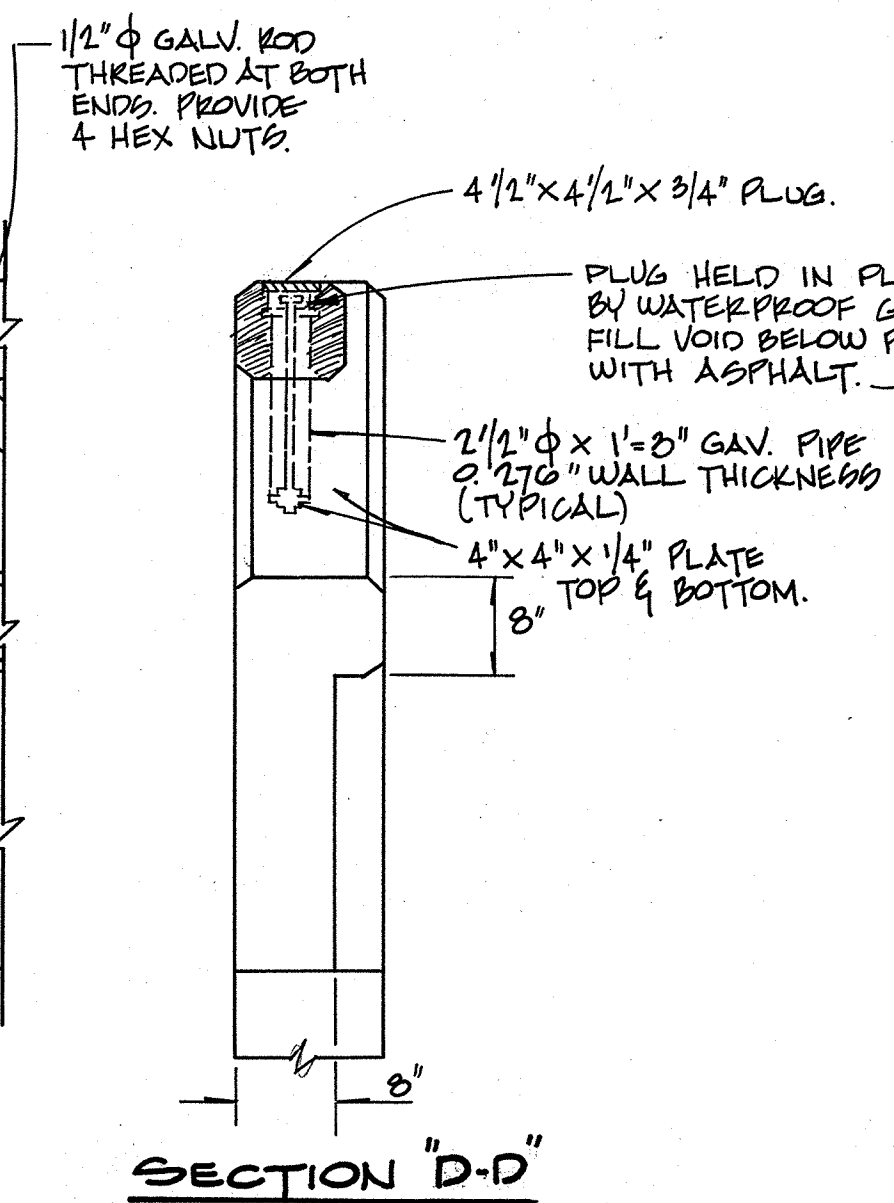
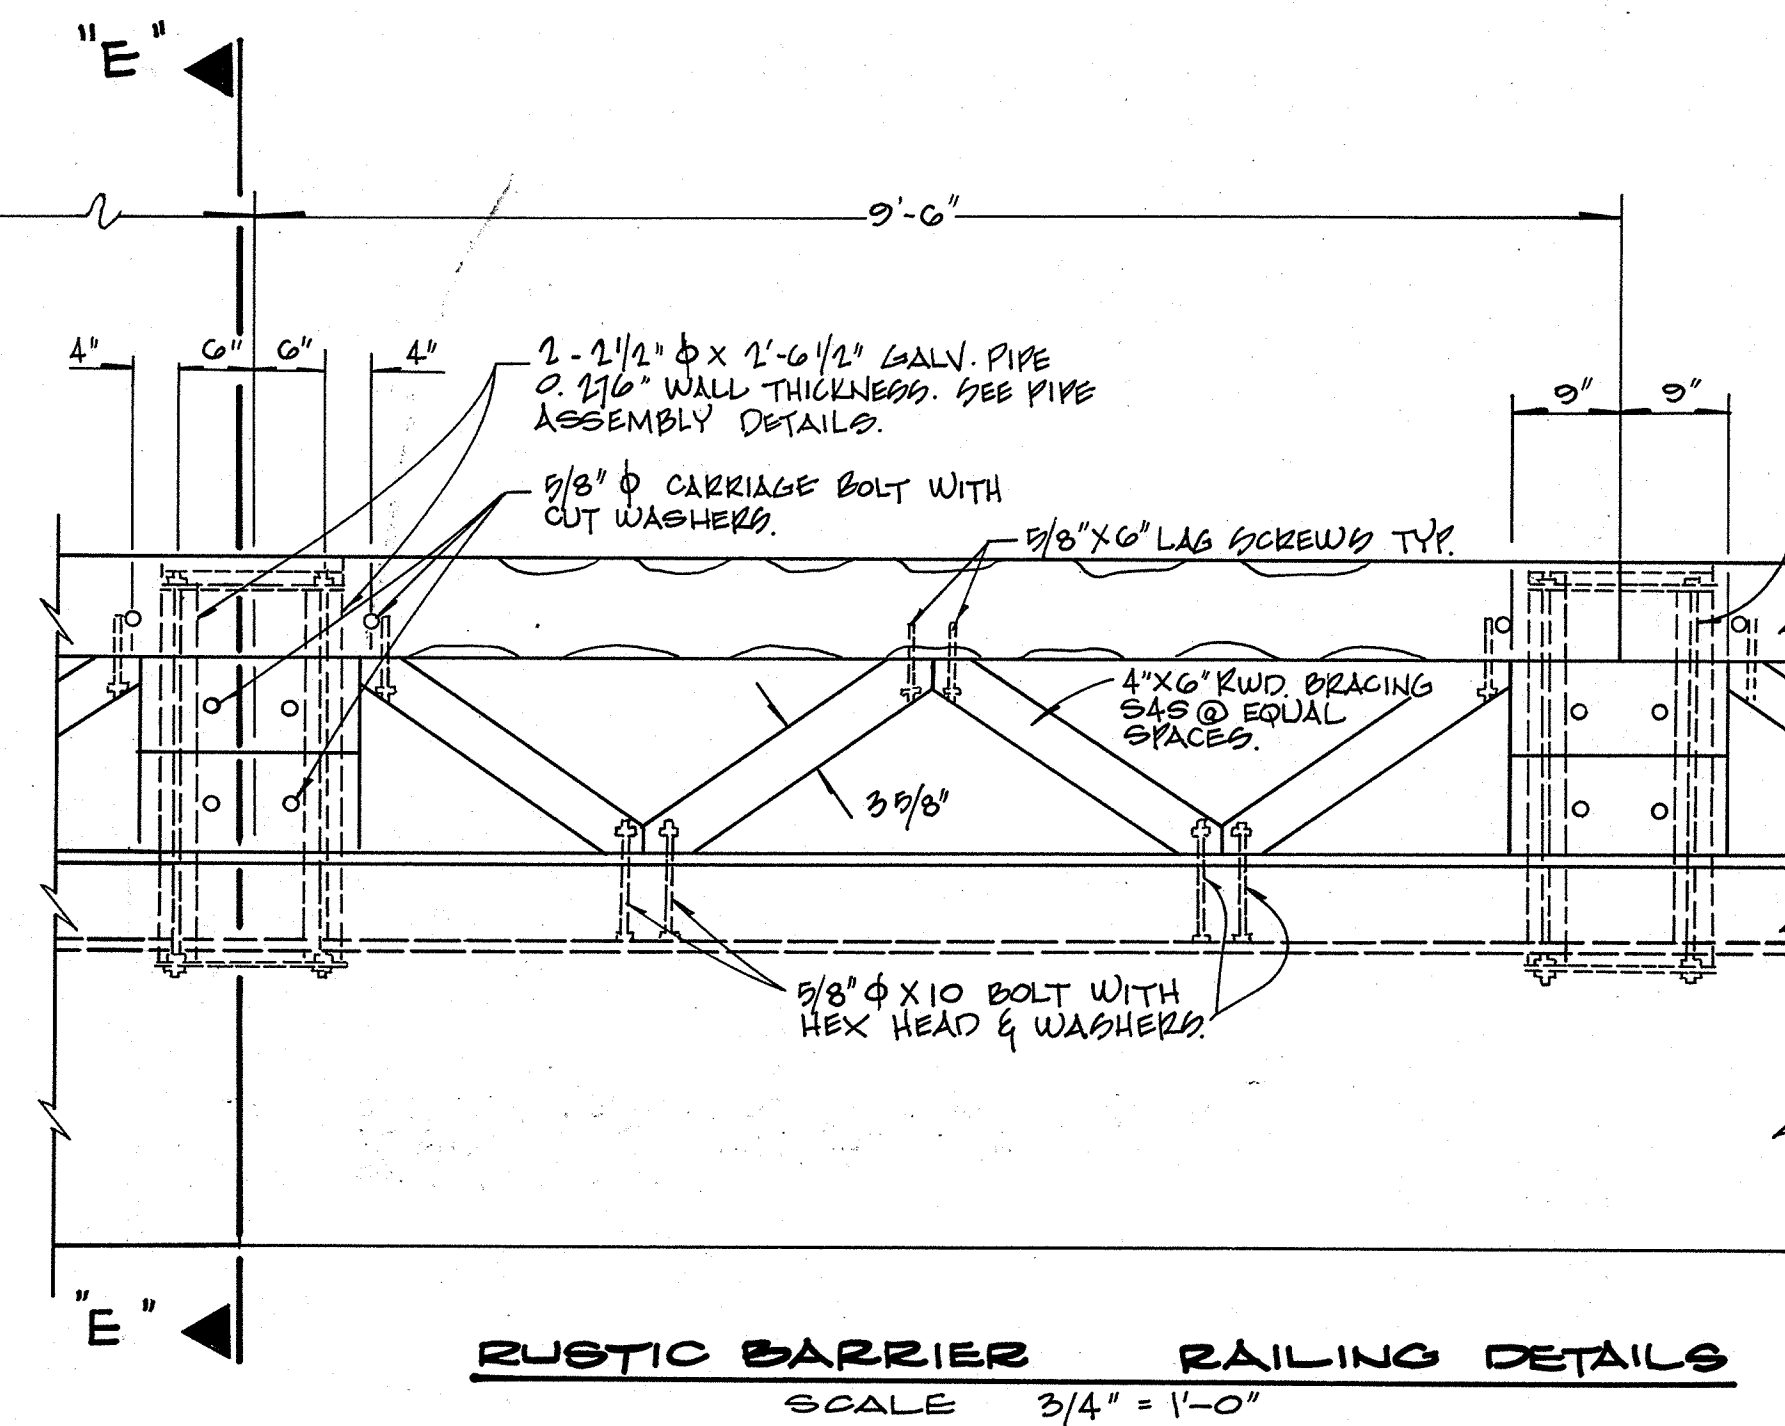
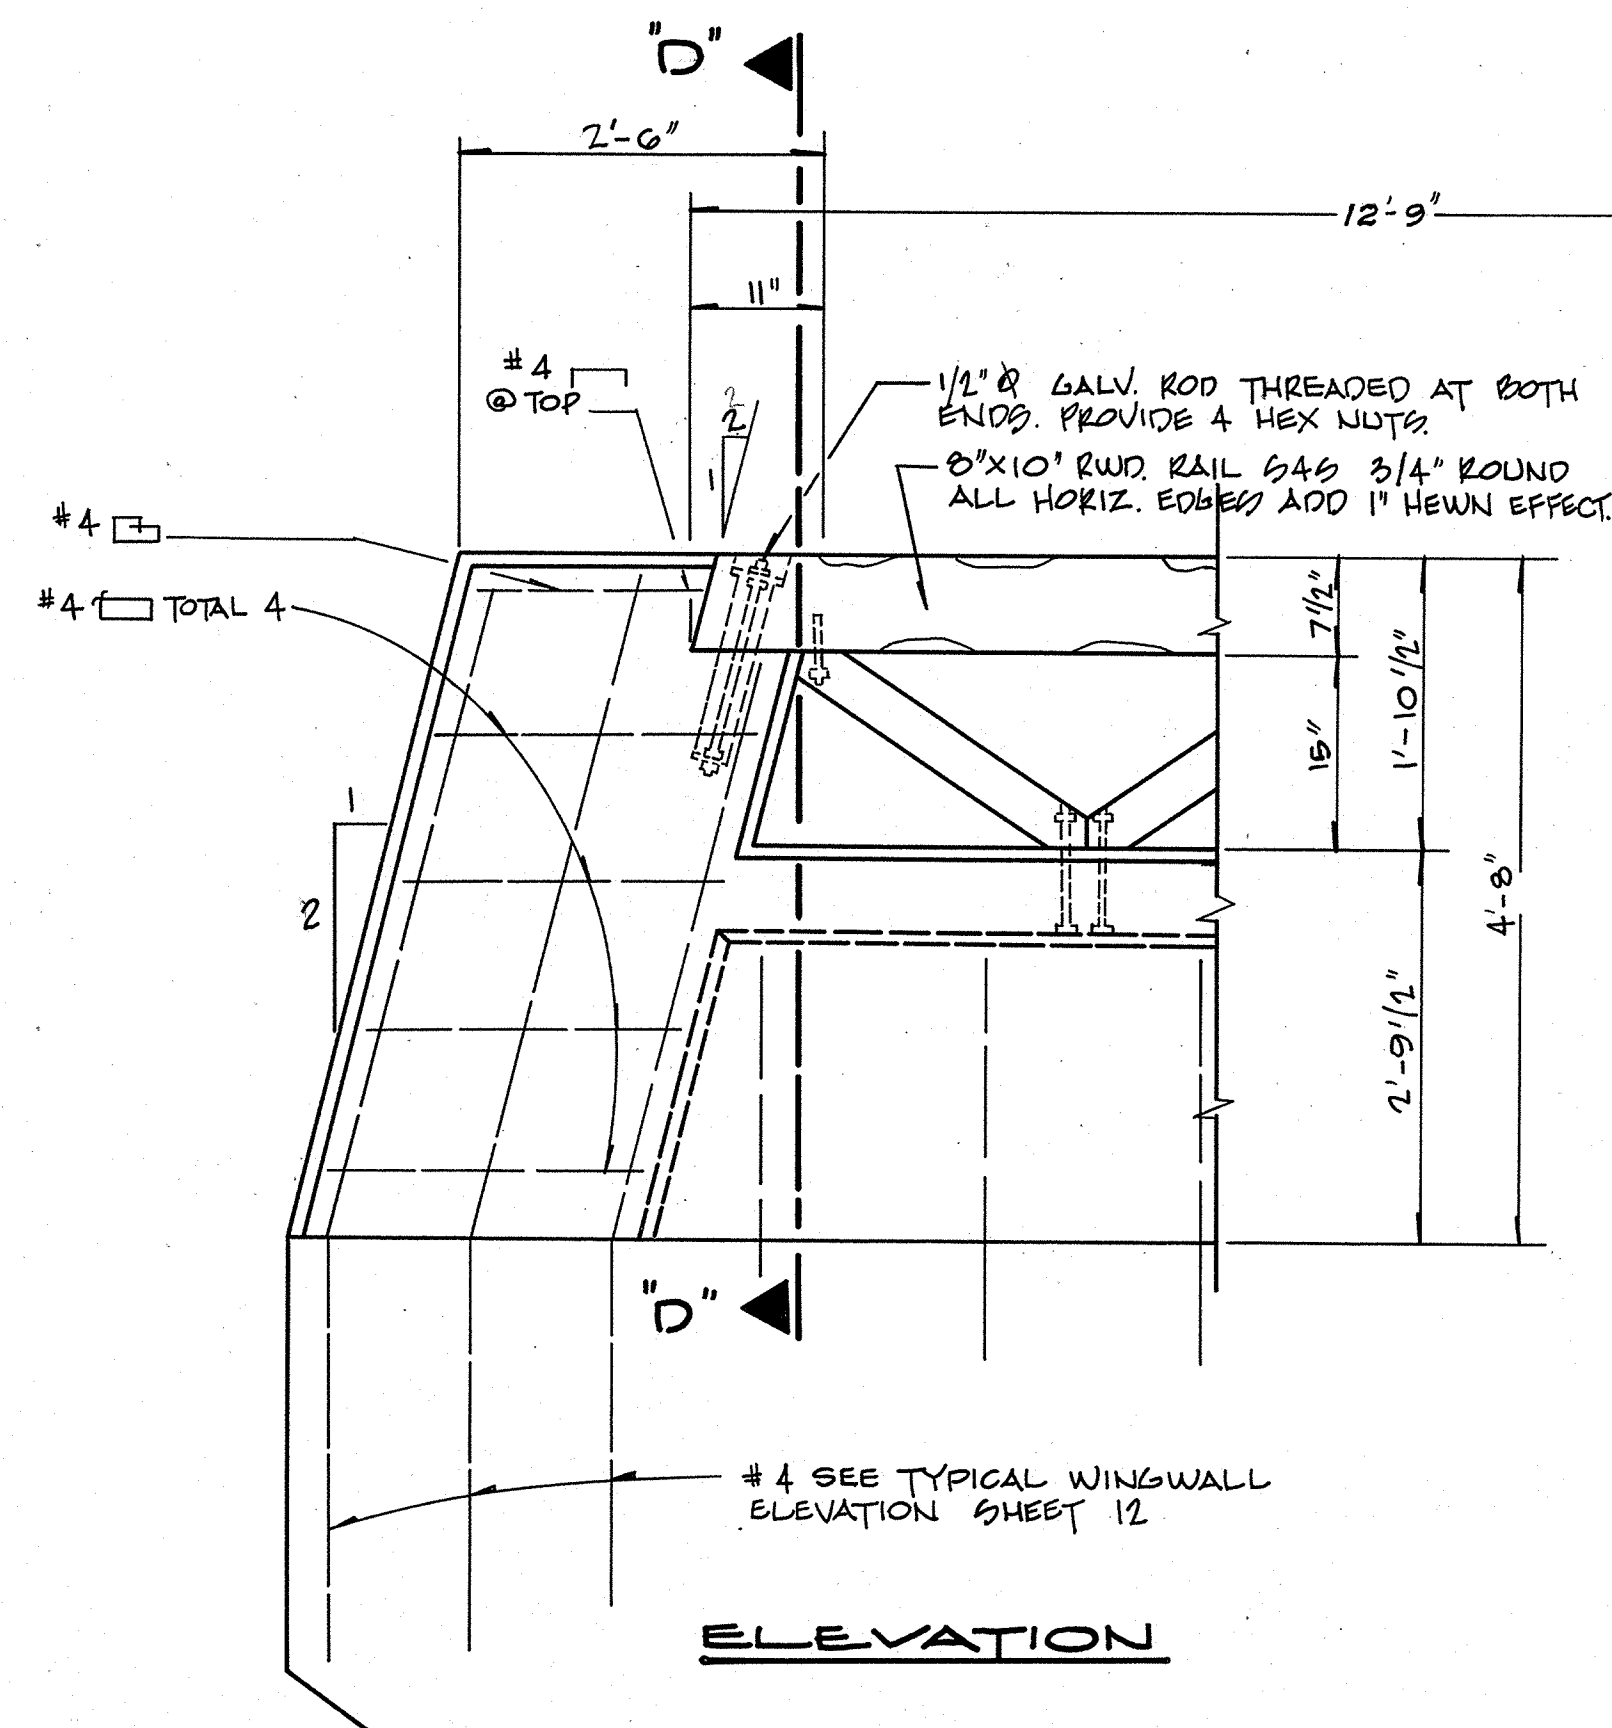
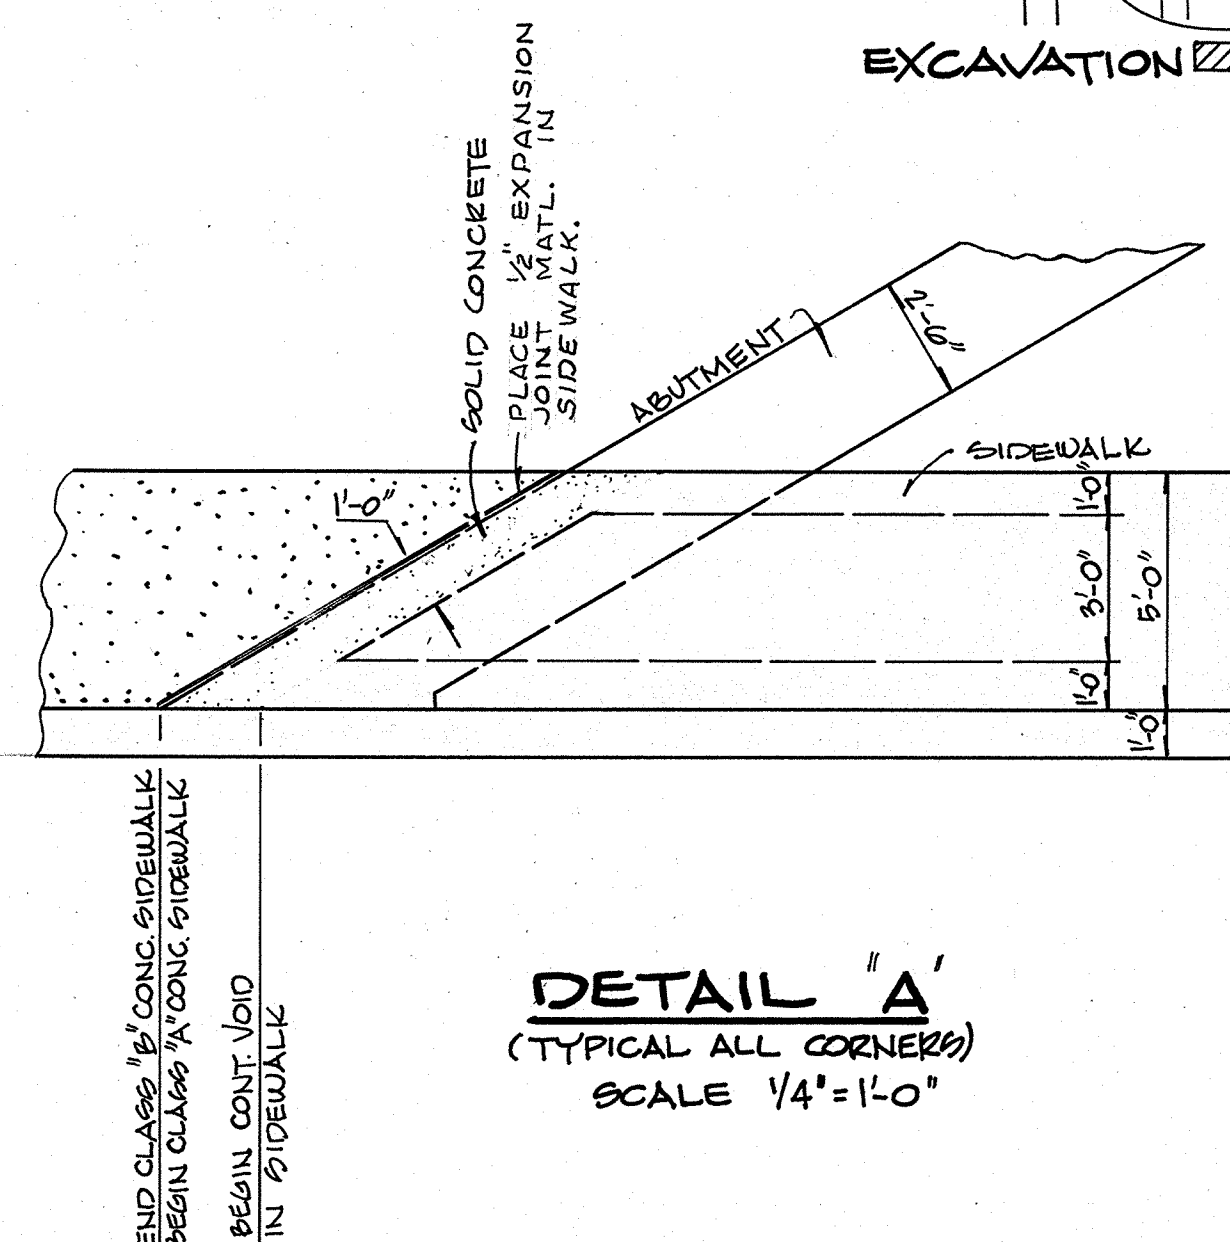
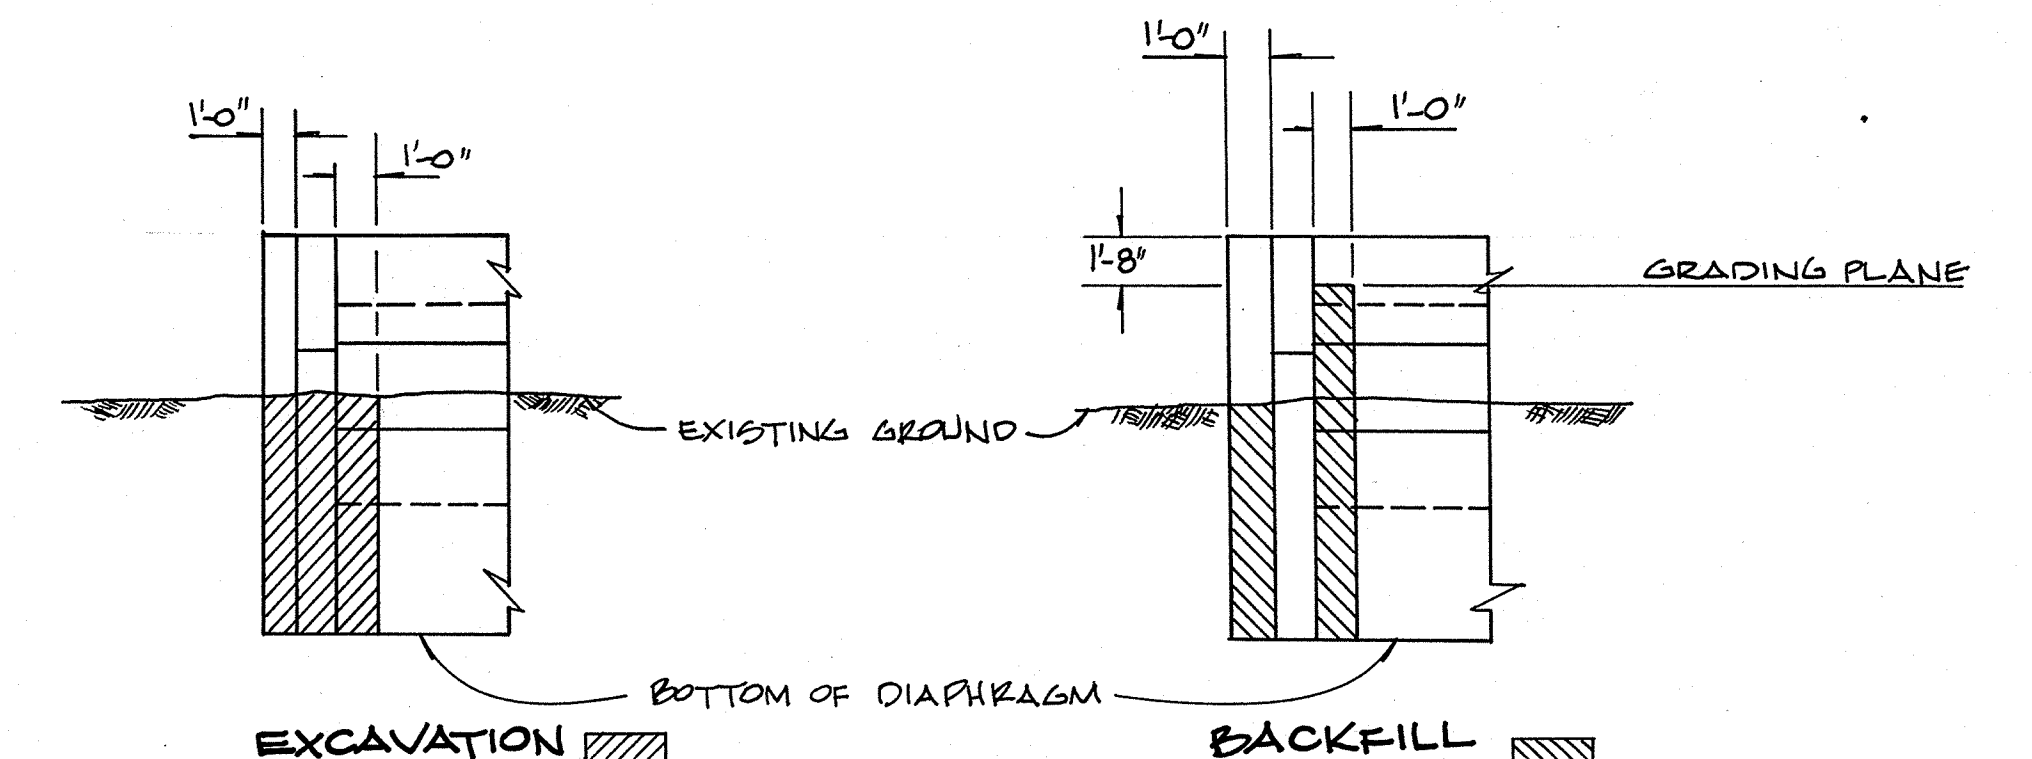


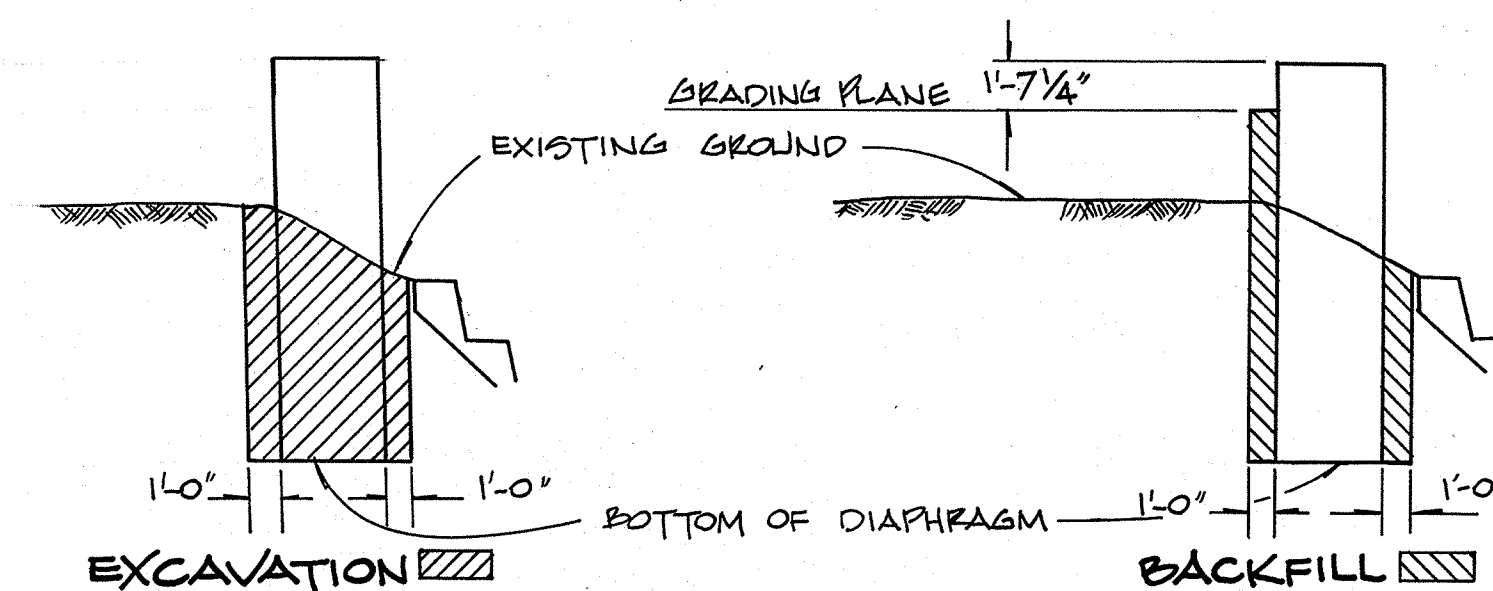

- # NOTES:
- 1.-----RAILING SHALL CONFORM TO HORIZONTAL AND VERTICAL ALIGNMENT.
 - 2.-----POSTS SHALL BE NORMAL TO RAILING.
 - 3.-----COUNTERSINK ALL LAG SCREWS & BOLTS AT TIMBER CONNECTIONS.
 - 4.-----WALLS ARE TO BE BACKFILLED BEFORE RAILING IS PLACED.
 - 5.-----ALL REINFORCEMENT IN PARAPET WALLS SHALL HAVE A CLEAR COVERAGE OF 1".
 - 6.-----REDWOOD POSTS AND RAILS SHALL BE SELECT HEART GRADE REDWOOD.
 - 7.-----ALL TIMBER CONNECTORS SHALL BE GALVANIZED.

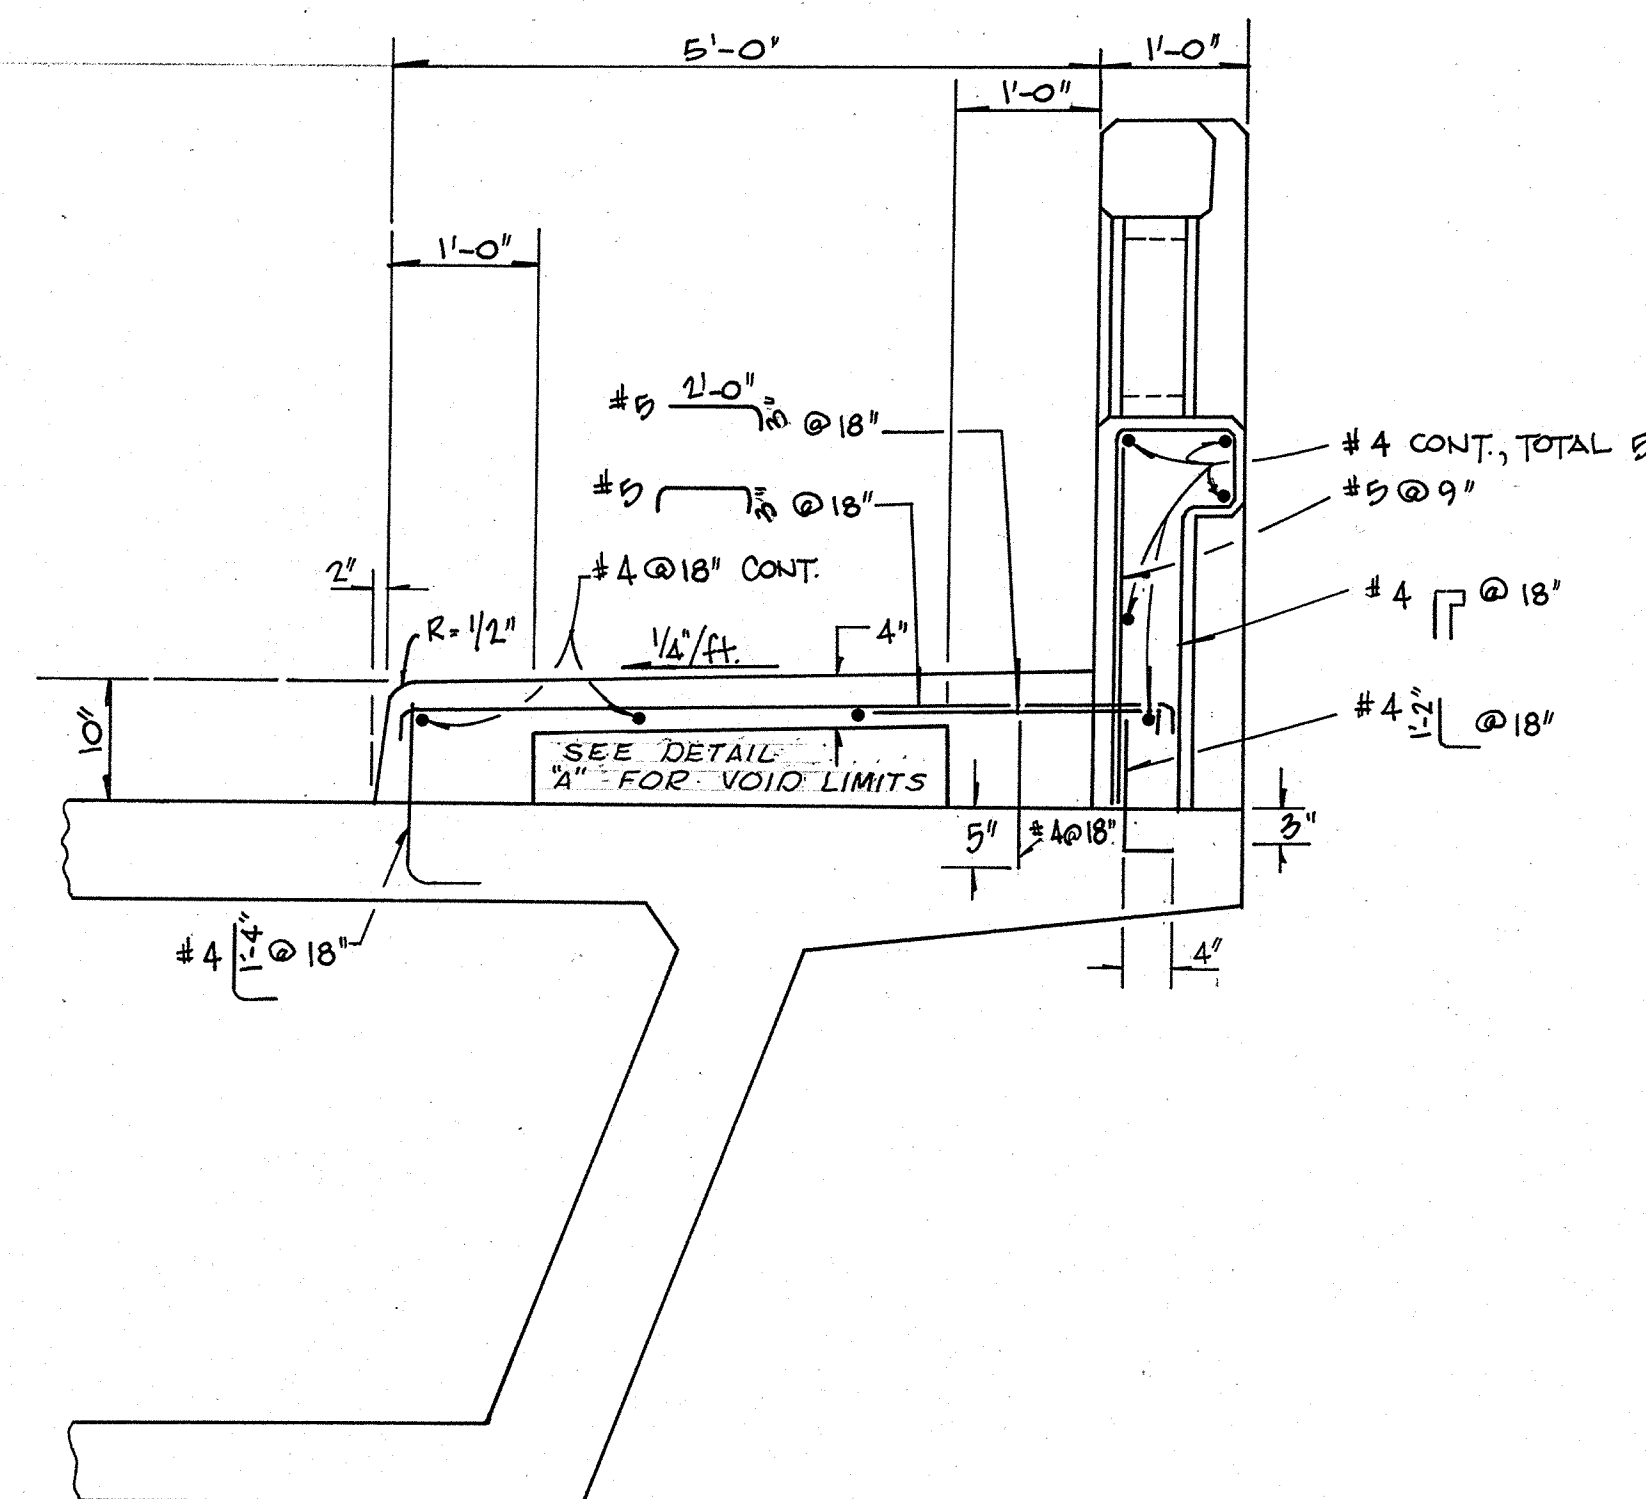

DETAIL 'A'
(TYPICAL ALL CORNERS)
SCALE 1/4" = 1'-0"

STRUCTURAL EXCAVATION AND BACKFILL DETAILS
NO SCALE

AS BUILT

(11097)
LOS ALISOS BLVD. BRIDGE
Sheet 14 of 18
Red. 22.5:1
3x Linen

ORANGE COUNTY ROAD DEPARTMENT

LOS ALIBOS BLVD.
BRIDGE AL-12
OVER
ALISO CREEK

SIDEWALK, RUSTIC BARRIER RAILING
DETAILS,
AND STRUCTURAL EXCAVATION & BACKFILL

AS NOTED

PET 12 OF 17

(11097)

0 72398