
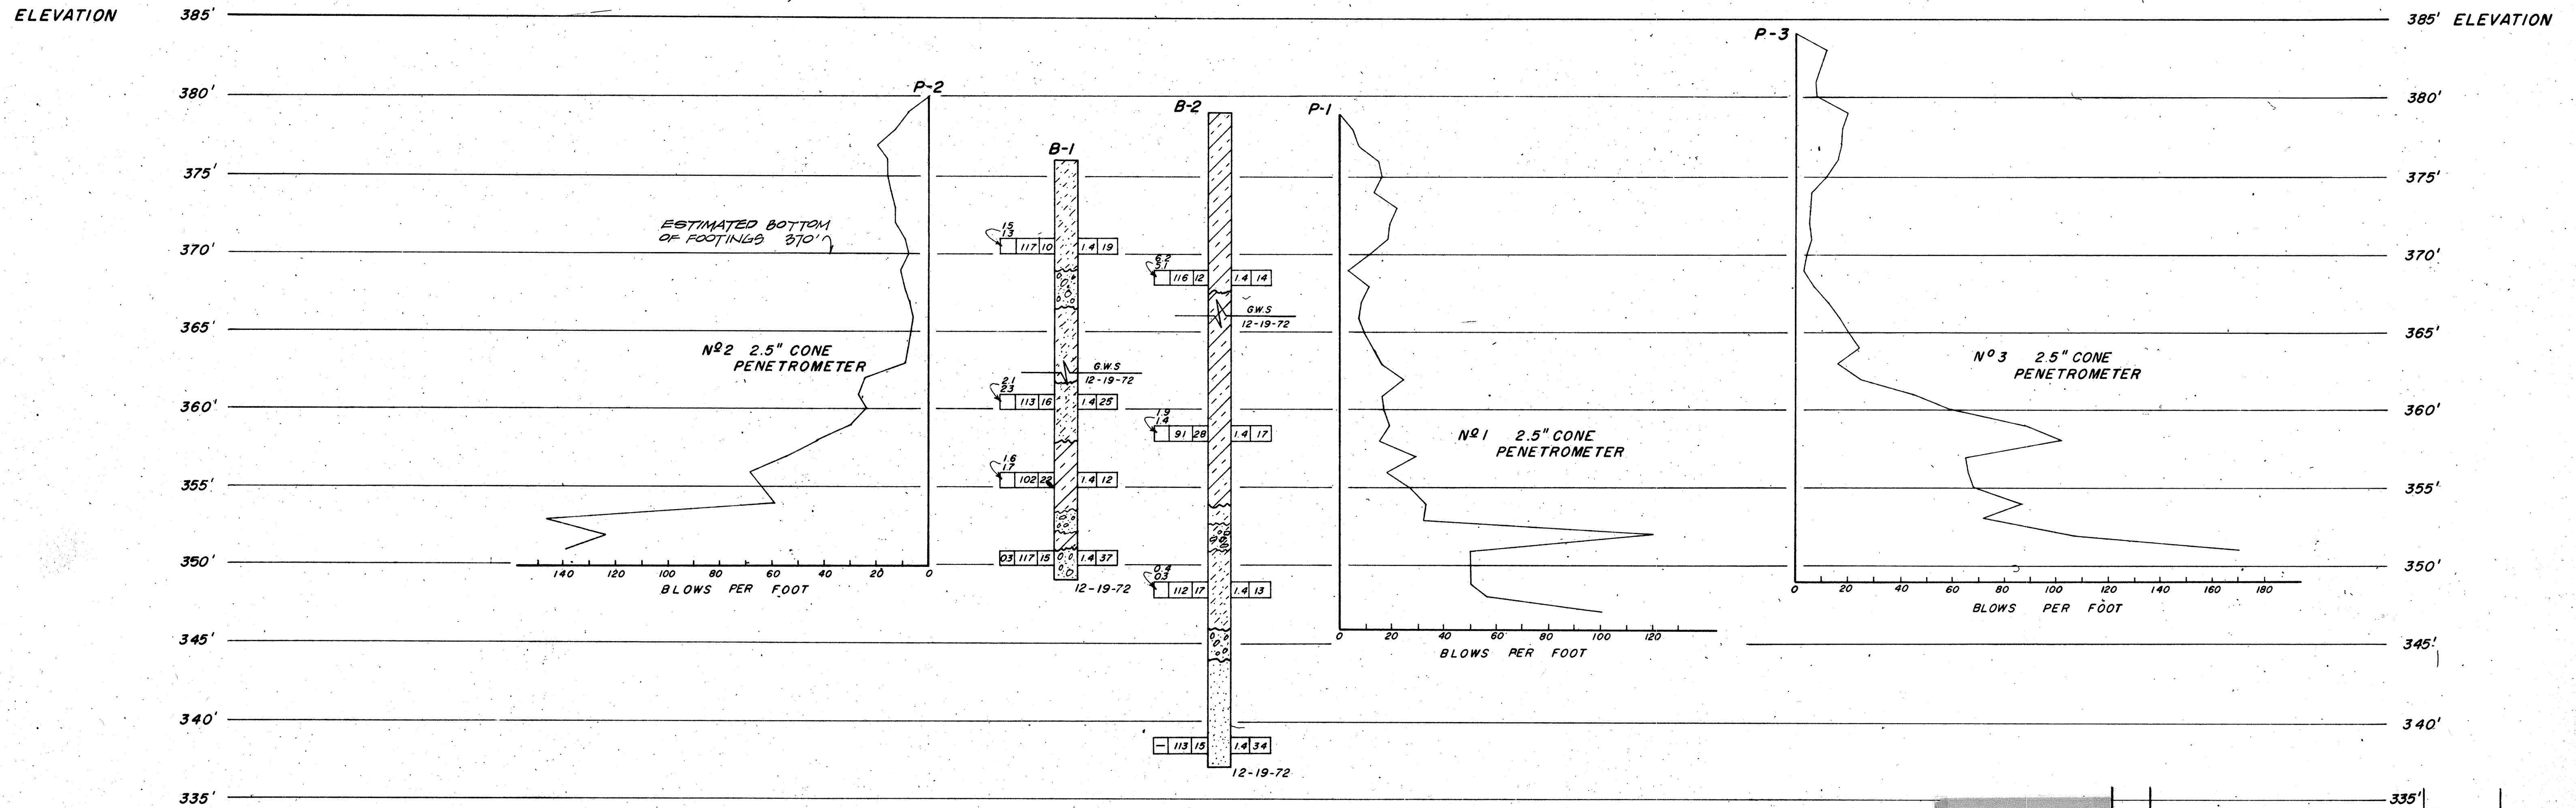


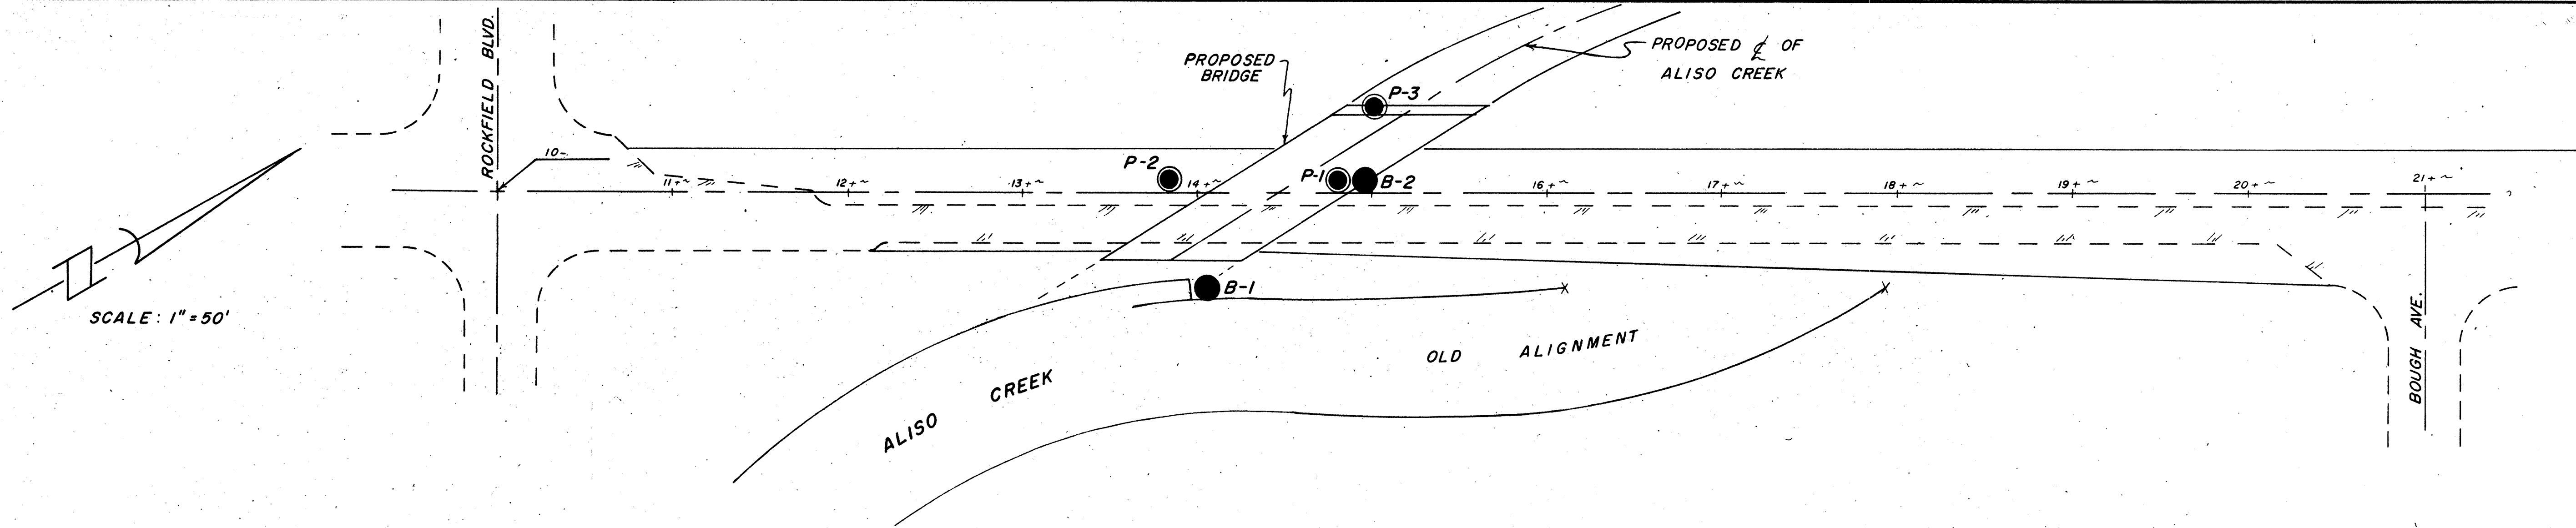


FIELD STUDY BY S. STALMOY
DRAWN BY R. W. PARSONS
CHECKED BY S. J.

(11097)
LOS ALISOS BLVD BRIDGE
Sheet 17 of 18
Red. 22.5:1
Cronaflex


AS BUILT

1-9-72 DATE REVISION R.W. PARSONS DRAWN BY S. J. CHECKED BY

LEGEND OF EARTH MATERIALS

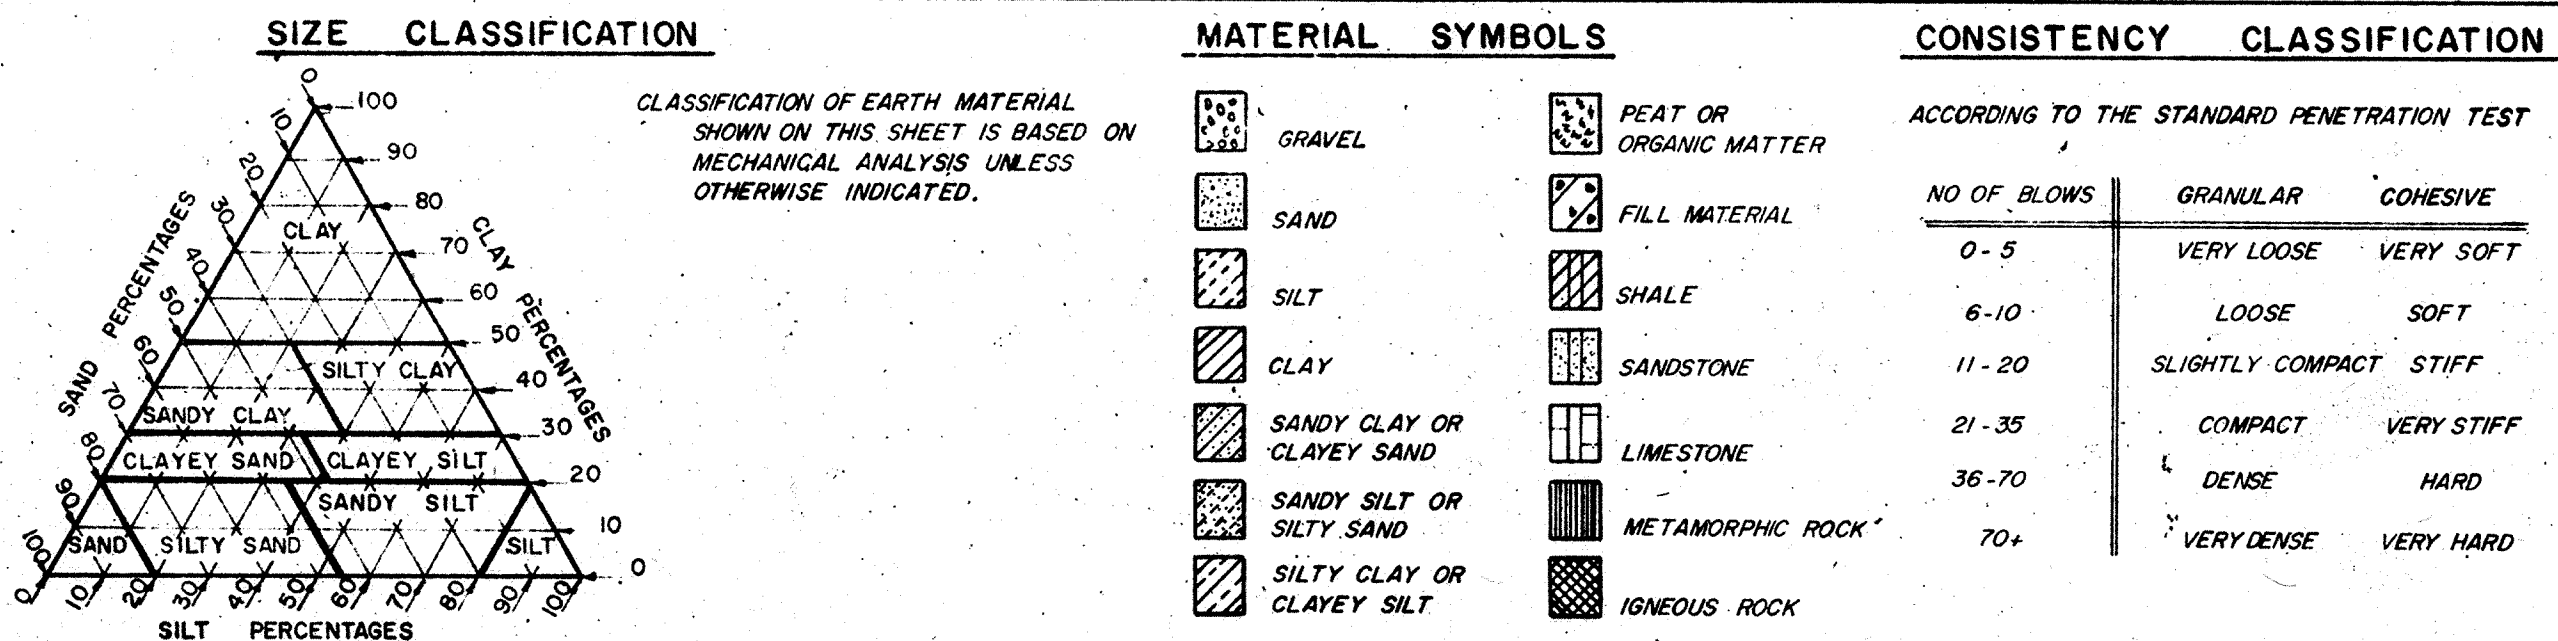

LEGEND OF BORING OPERATIONS

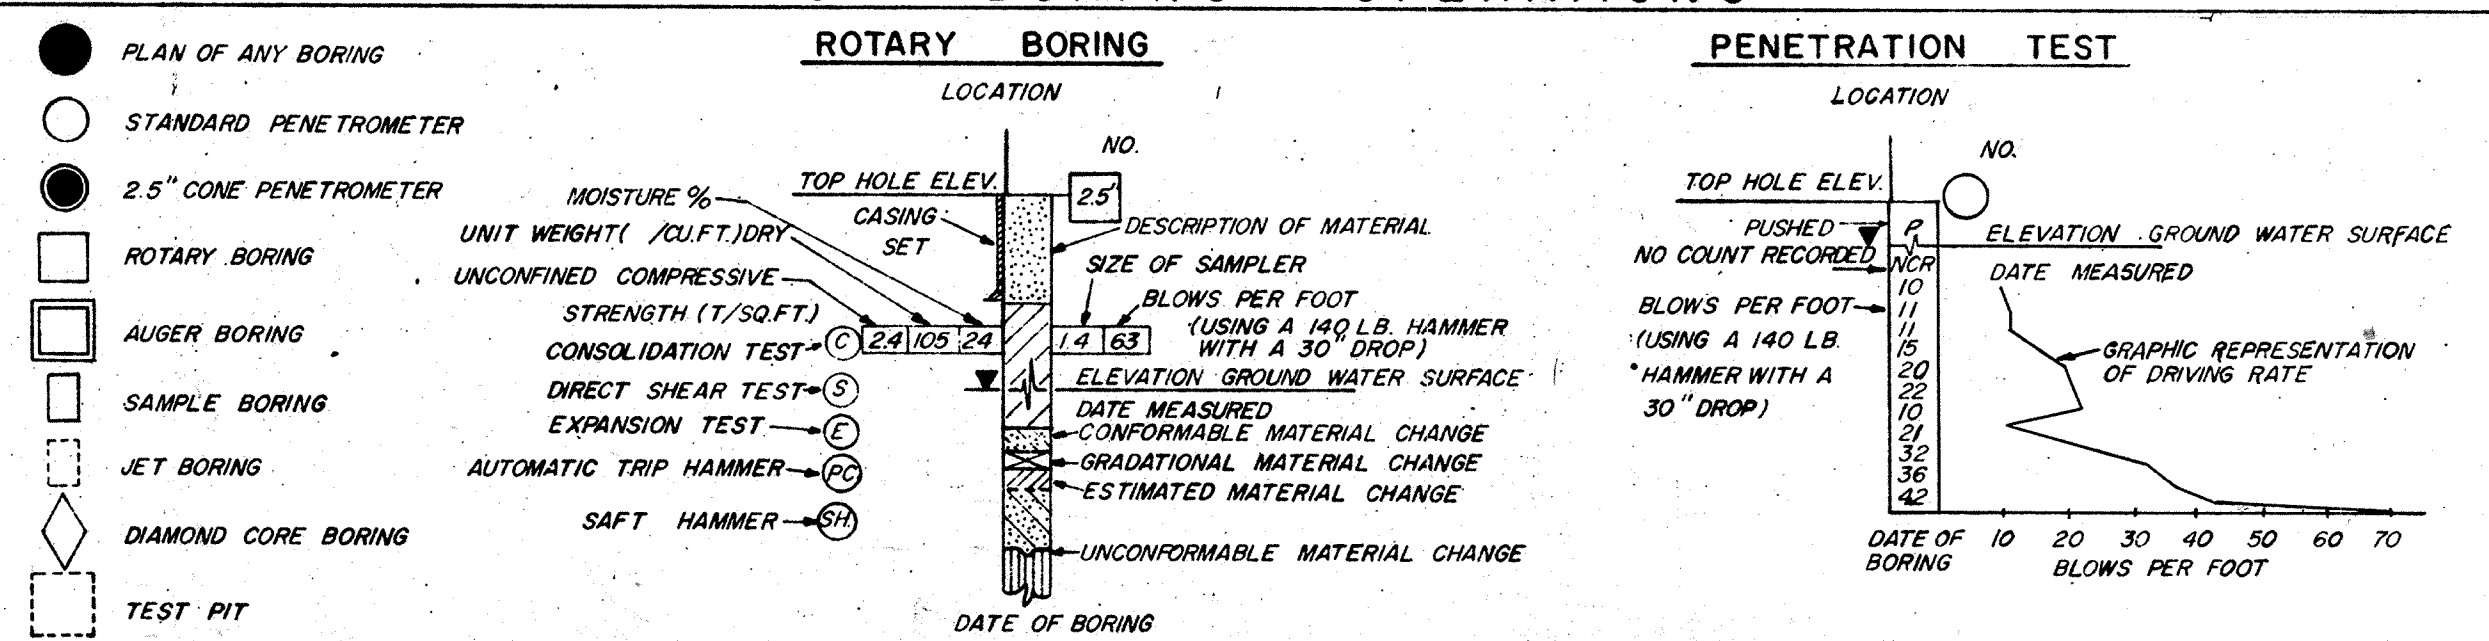

ORANGE COUNTY ROAD DEPARTMENT
MATERIALS LABORATORY
LOG OF TEST BORINGS
FOR
PROPOSED
LOS ALISOS BRIDGE
OVER
ALISO CREEK

SCALE - SHOWN BRIDGE AL-12 DRAWING (11097)