

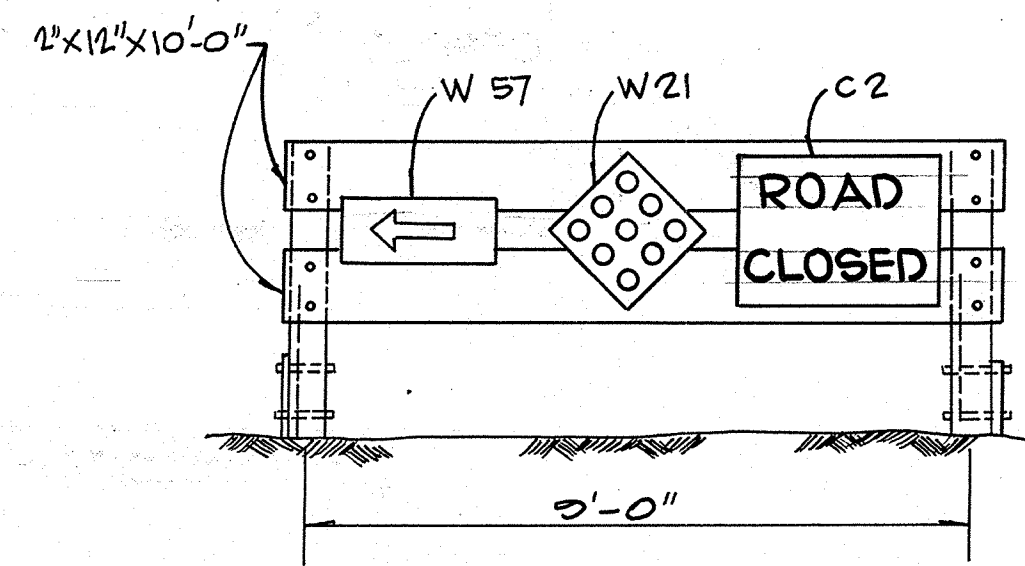


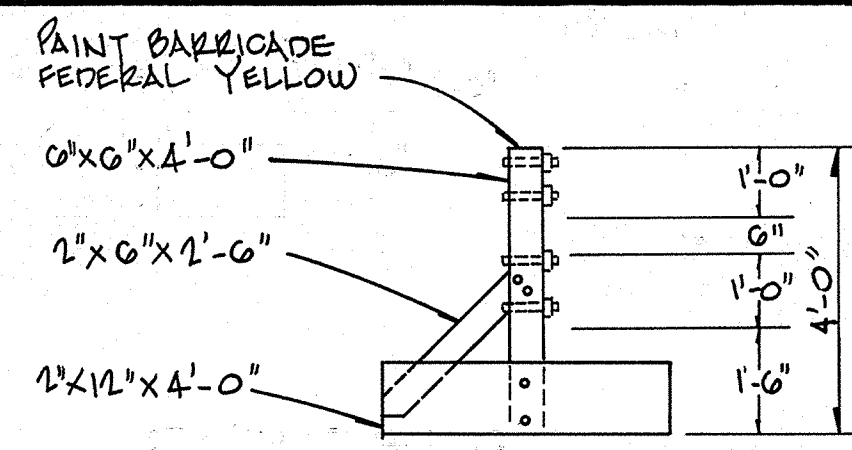


PORTABLE TIMBER BARRICADES

NO SCALE



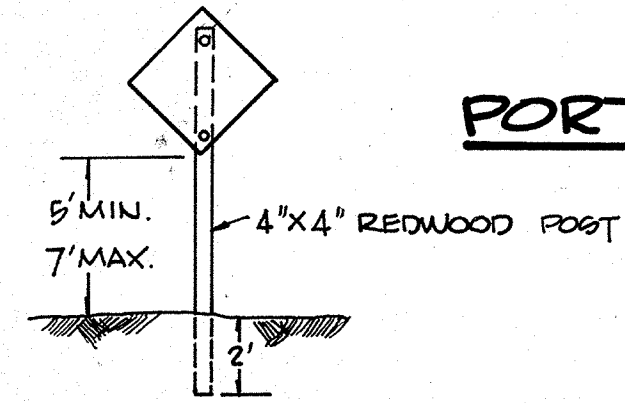


ROADSIDE SIGN C-19

NO SCALE


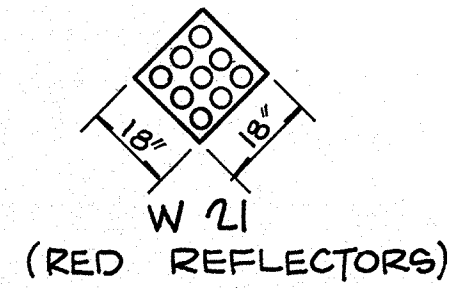


ALL ROADSIDE SIGNS SHALL
CONFORM TO CURRENT MUTCD
& STATE OF CALIFORNIA
SIGN CHART

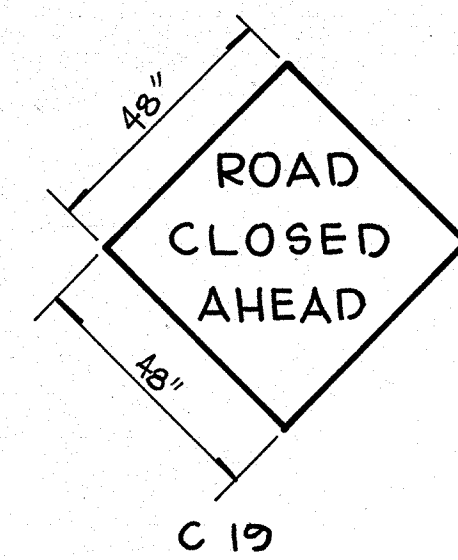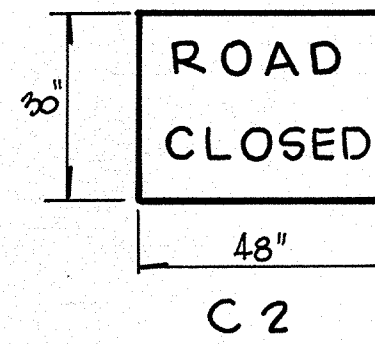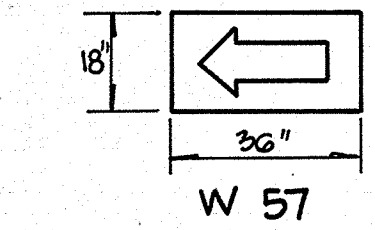


ROADSIDE SIGN DETAILS

NO SCALE

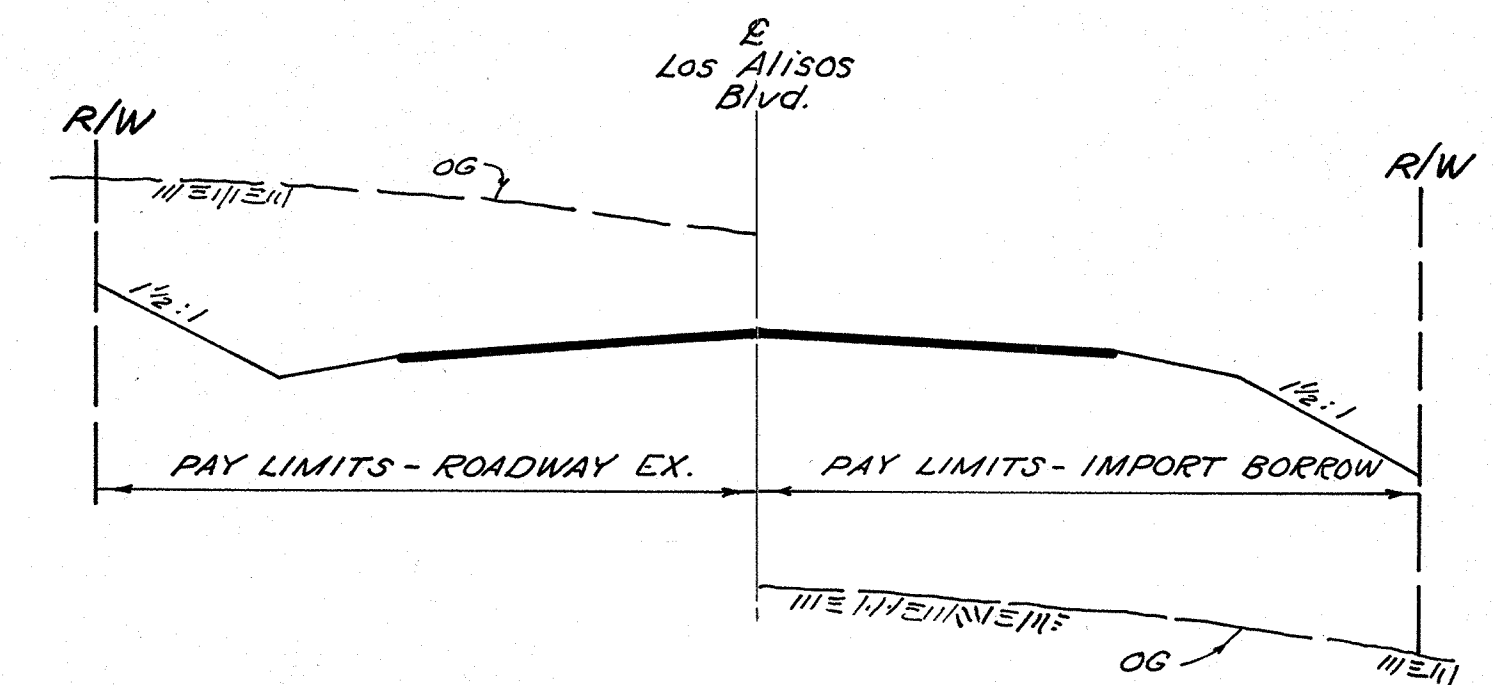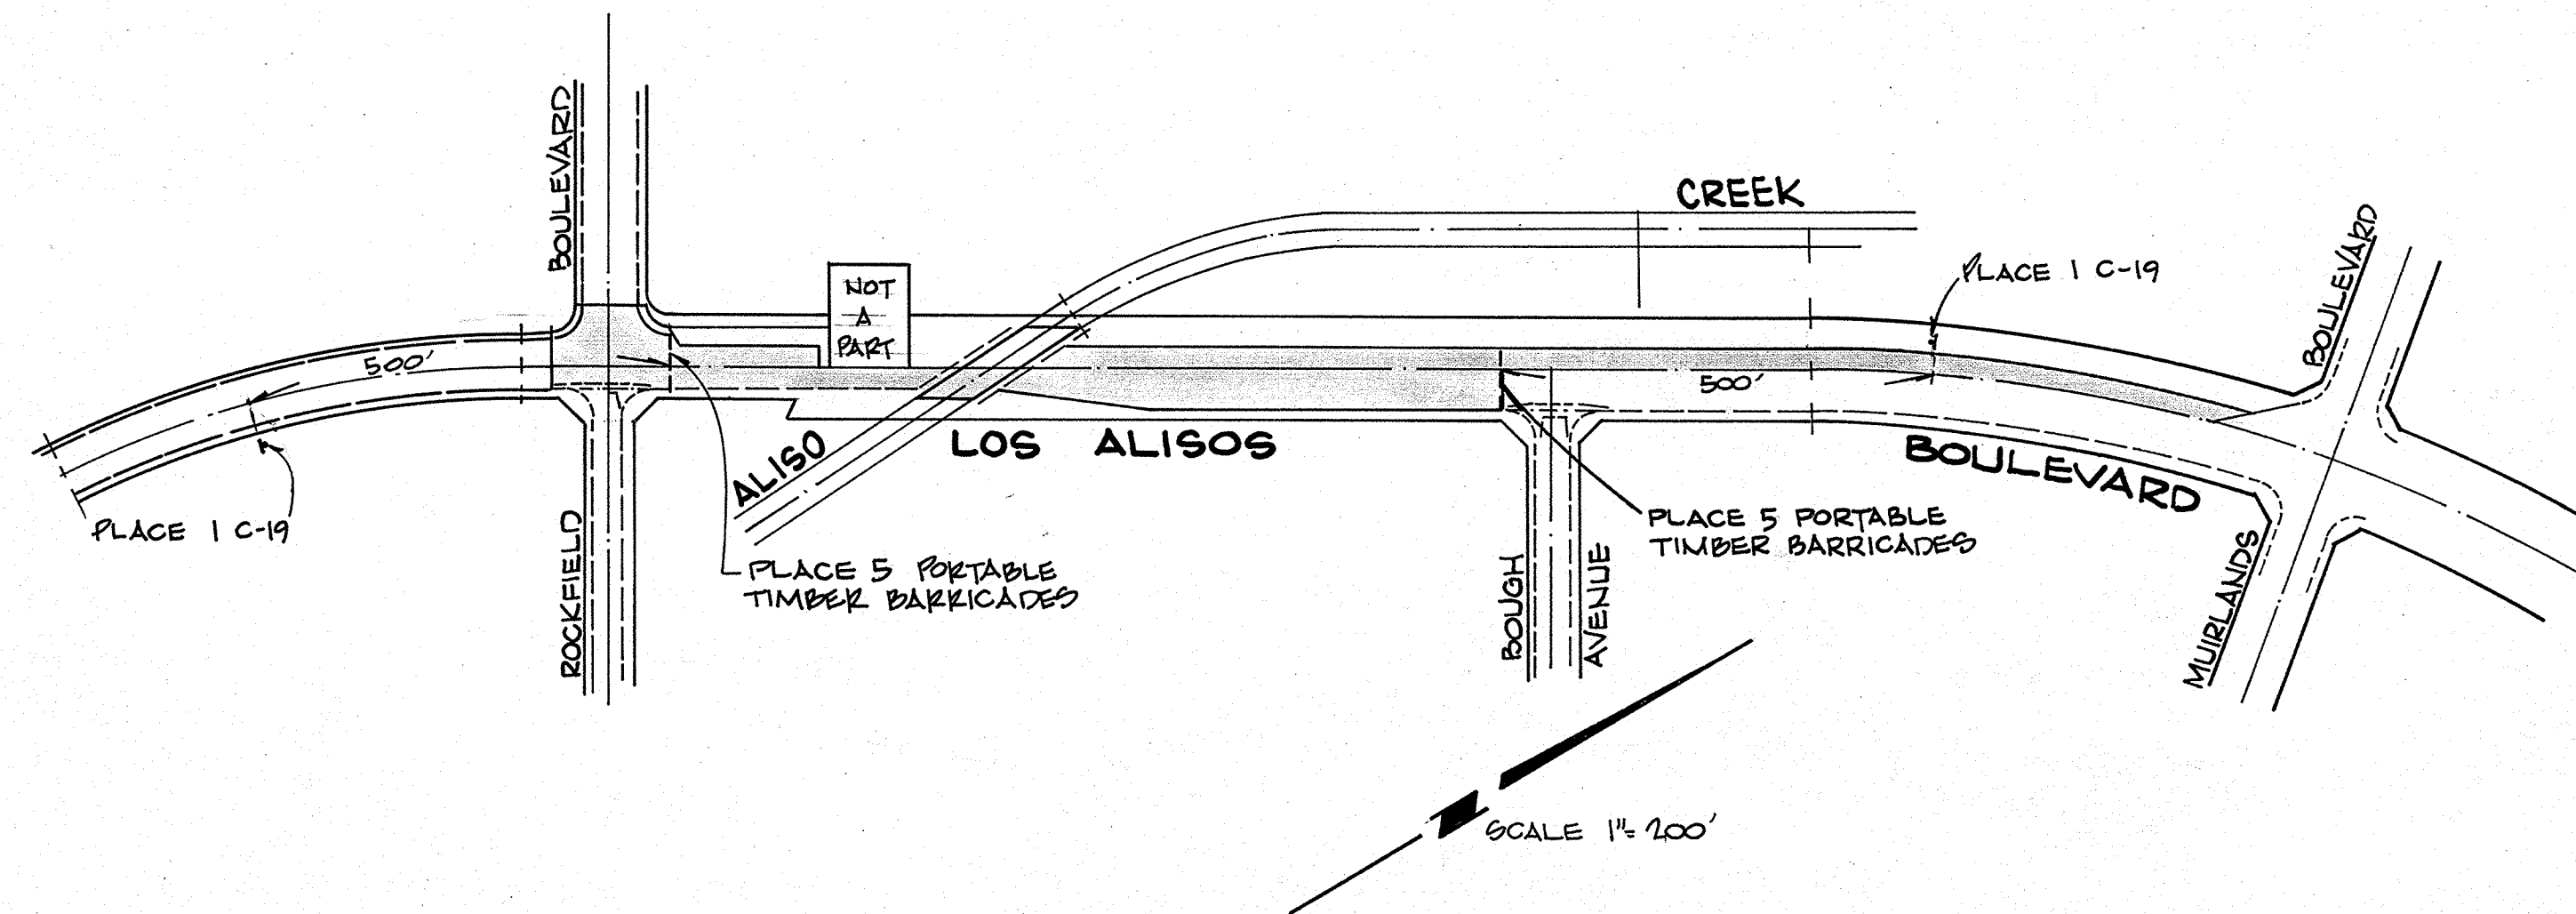

EARTHWORK PAY LIMITS
(FOR ROAD WORK ITEMS ONLY)
NO SCALE

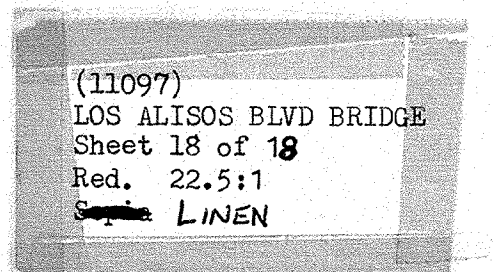

AS BUILT

ORANGE COUNTY ROAD DEPARTMENT	
LOS ALISOS BLVD. BRIDGE AL-12 OVER ALISO CREEK	
ROAD CLOSURE	
11097-04.1 SCALE SHEET 17 OF 17	W.D. 112598

(11097)

11097-04.1