




CHANNEL PROFILE
 SCALE: 1"=5' VERT. 1"=50' HORIZ.

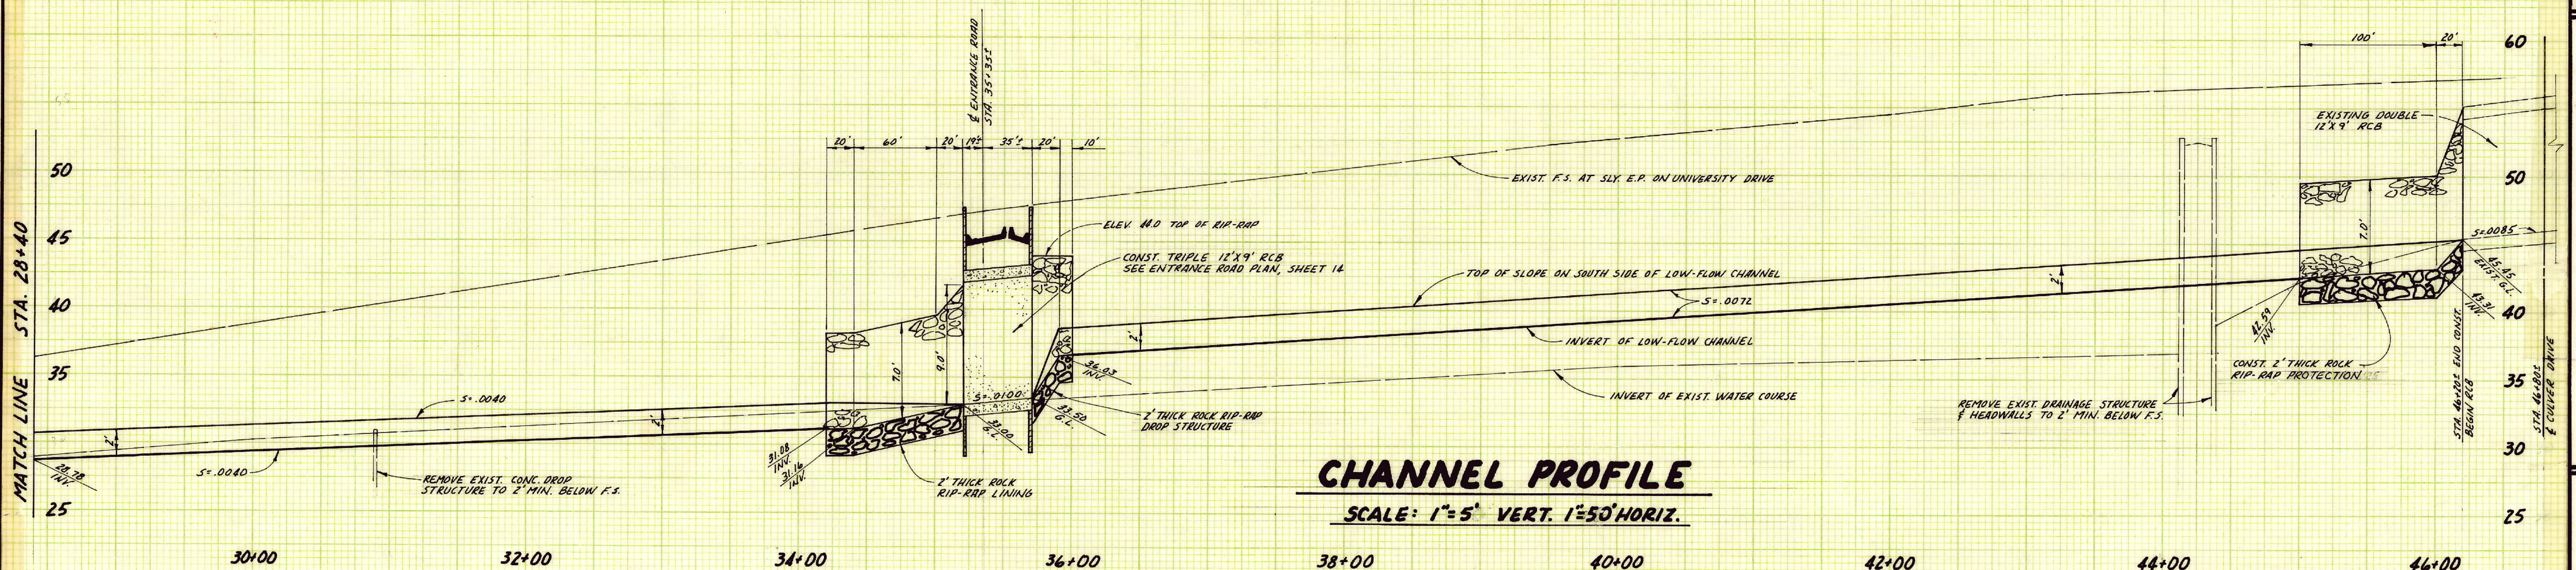


CHANNEL PROFILE
 SCALE: 1"=5' VERT. 1"=50' HORIZ.

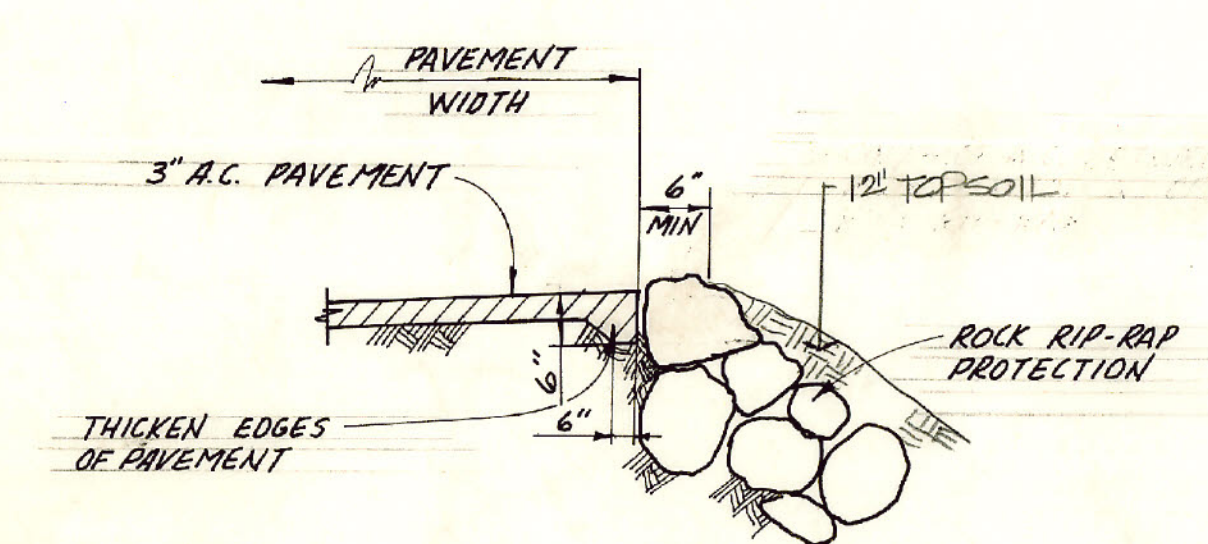

**DETAIL
EXIT ROAD PROTECTION**
 NO SCALE

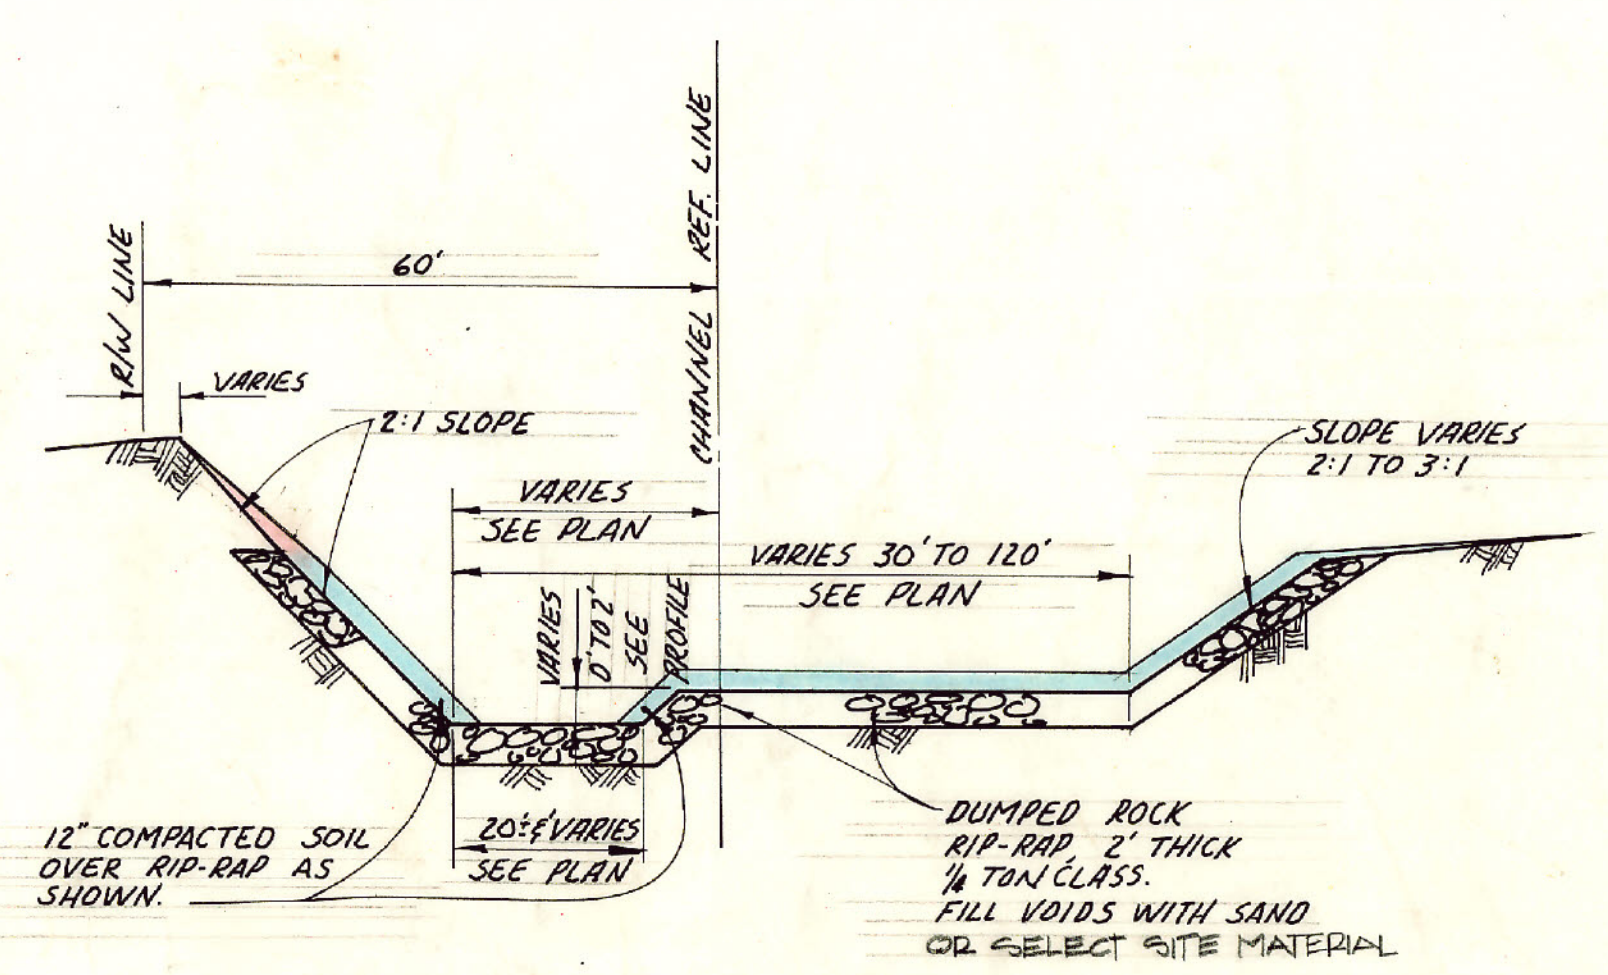

TYPICAL RIP-RAP SECTION
 NO SCALE

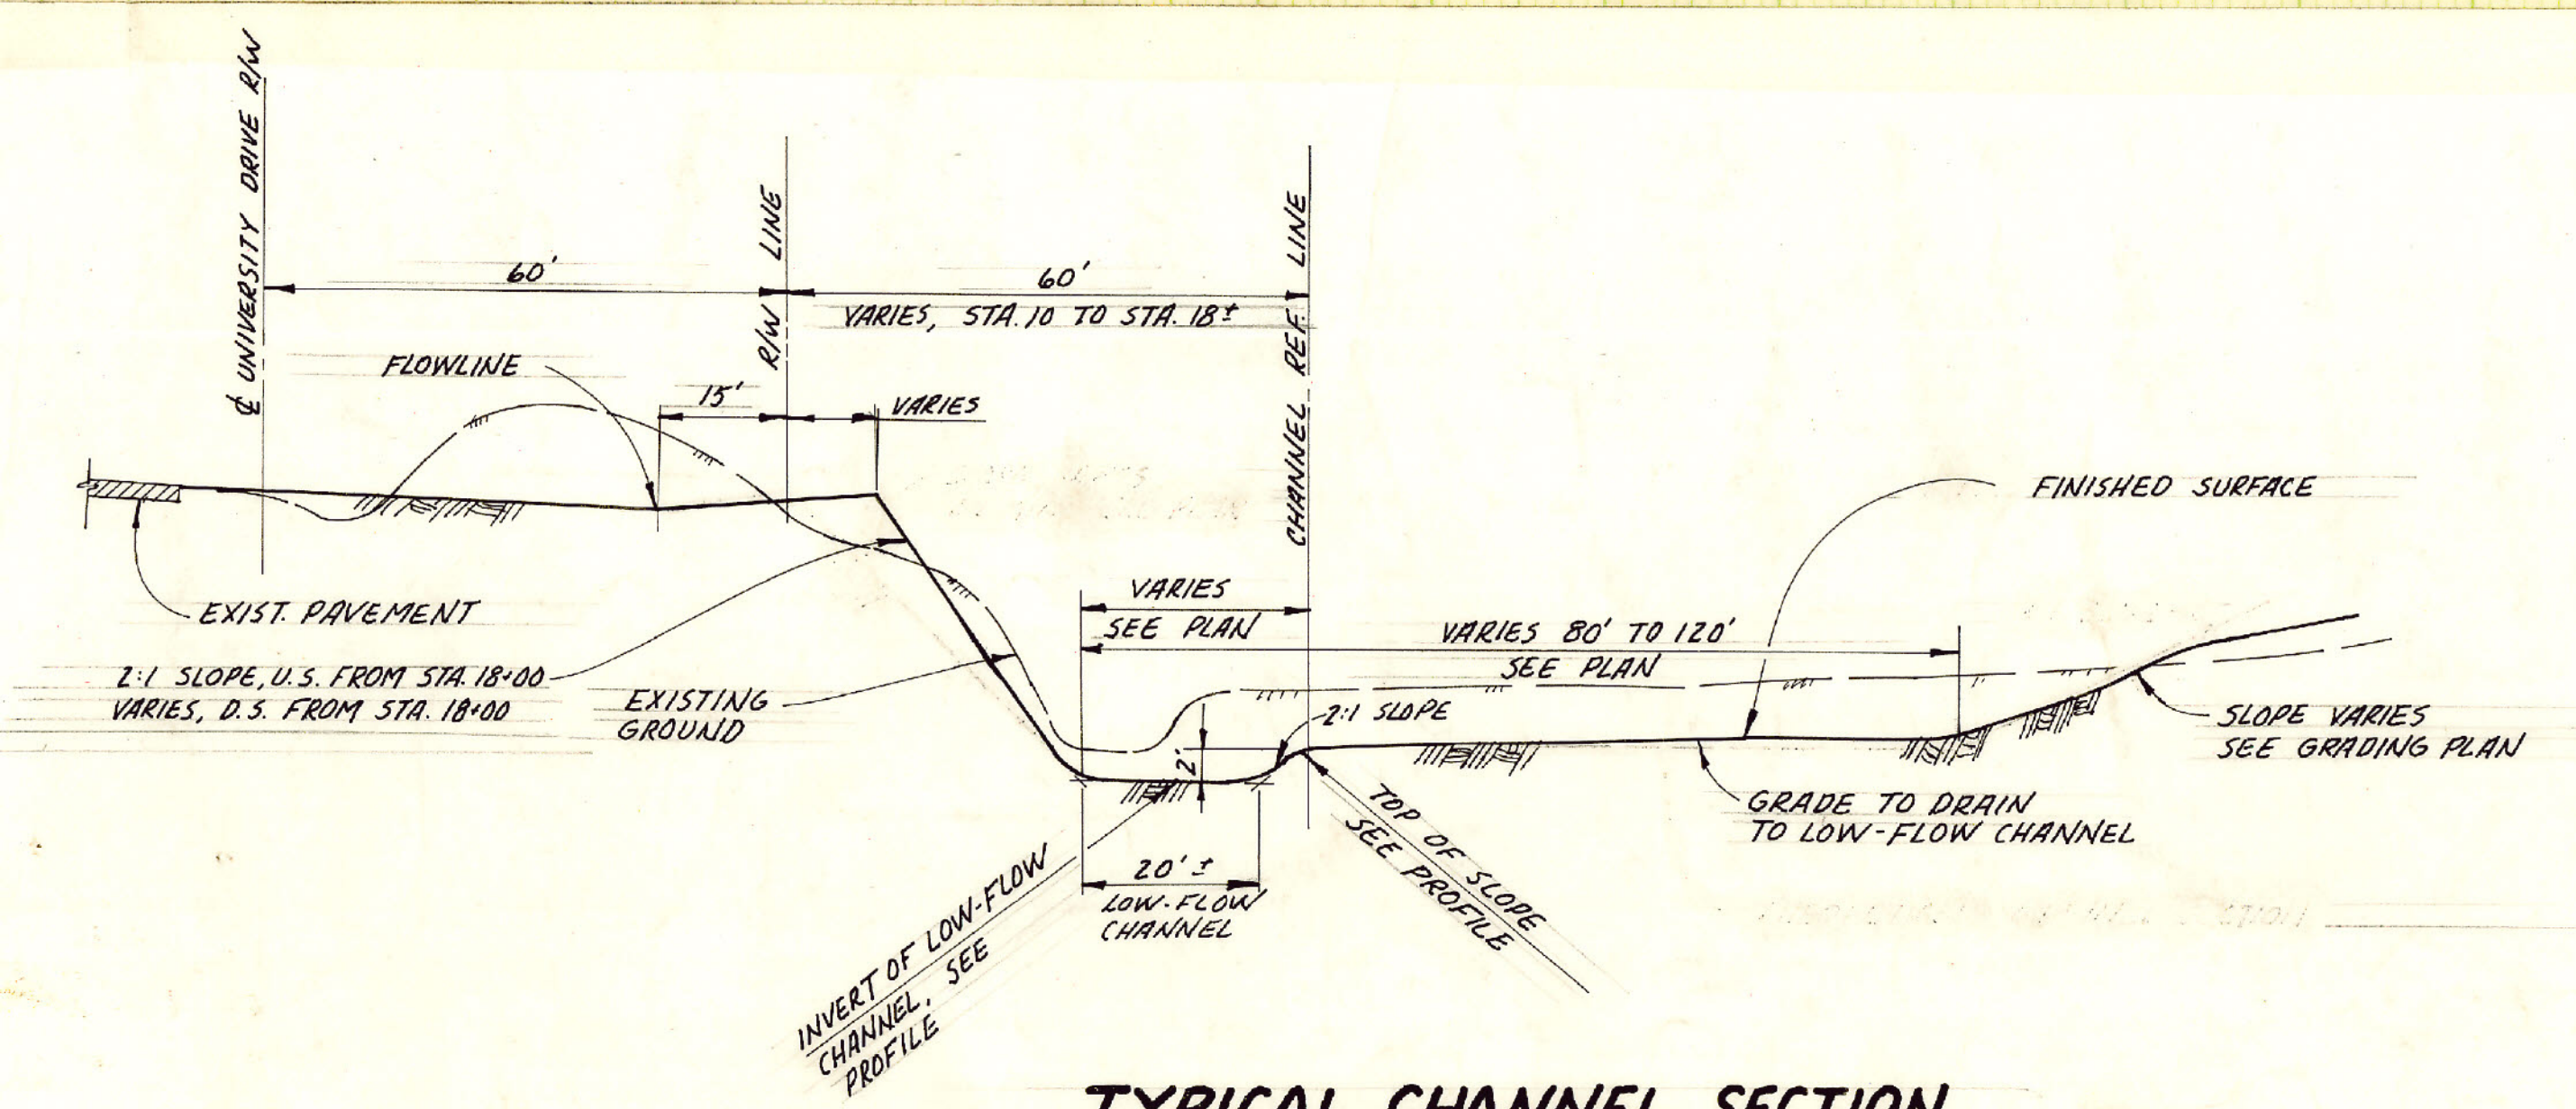

TYPICAL CHANNEL SECTION
 NO SCALE

PROJECT LANDSCAPE ARCHITECTS: JONES/PETERSON ASSOC. INC. 218 E. BROADWAY, ANAHEIM, CALIF. 92801 TEL: 714/772-3110	
ARCHITECTURAL CONSULTANTS: MORRIS LOHRBACH ASSOC. INC. 541 W. 17TH ST., ANAHEIM, CALIF. 92801 TEL: 714/772-3110	
ENGINEERING CONSULTANTS: TOUPS ENGINEERING, INC. 1801 N. COLLEGE, SANTA ANA, CALIF. 92701 TEL: 714/441-4401	
REVISIONS SYM. DESCRIPTION DATE APPROV.	FLOOD CONTROL CHANNEL PROFILE & SECTIONS
JOB NO. 16-1001-14 DESIGN 007 DRAWN JFE CHECK DVM/1007 DATE 4/12/72	UNIVERSITY REGIONAL PARK BUILDING SERVICES DEPARTMENT COUNTY OF ORANGE
PE E CFE SATISFACTORY TO DATE APPROVED FOR COUNTY DIR. BLDG. SERVICES DATE 5-8-72	PLAN NO. SHEET NO. C-10 OF 14 SHEETS