
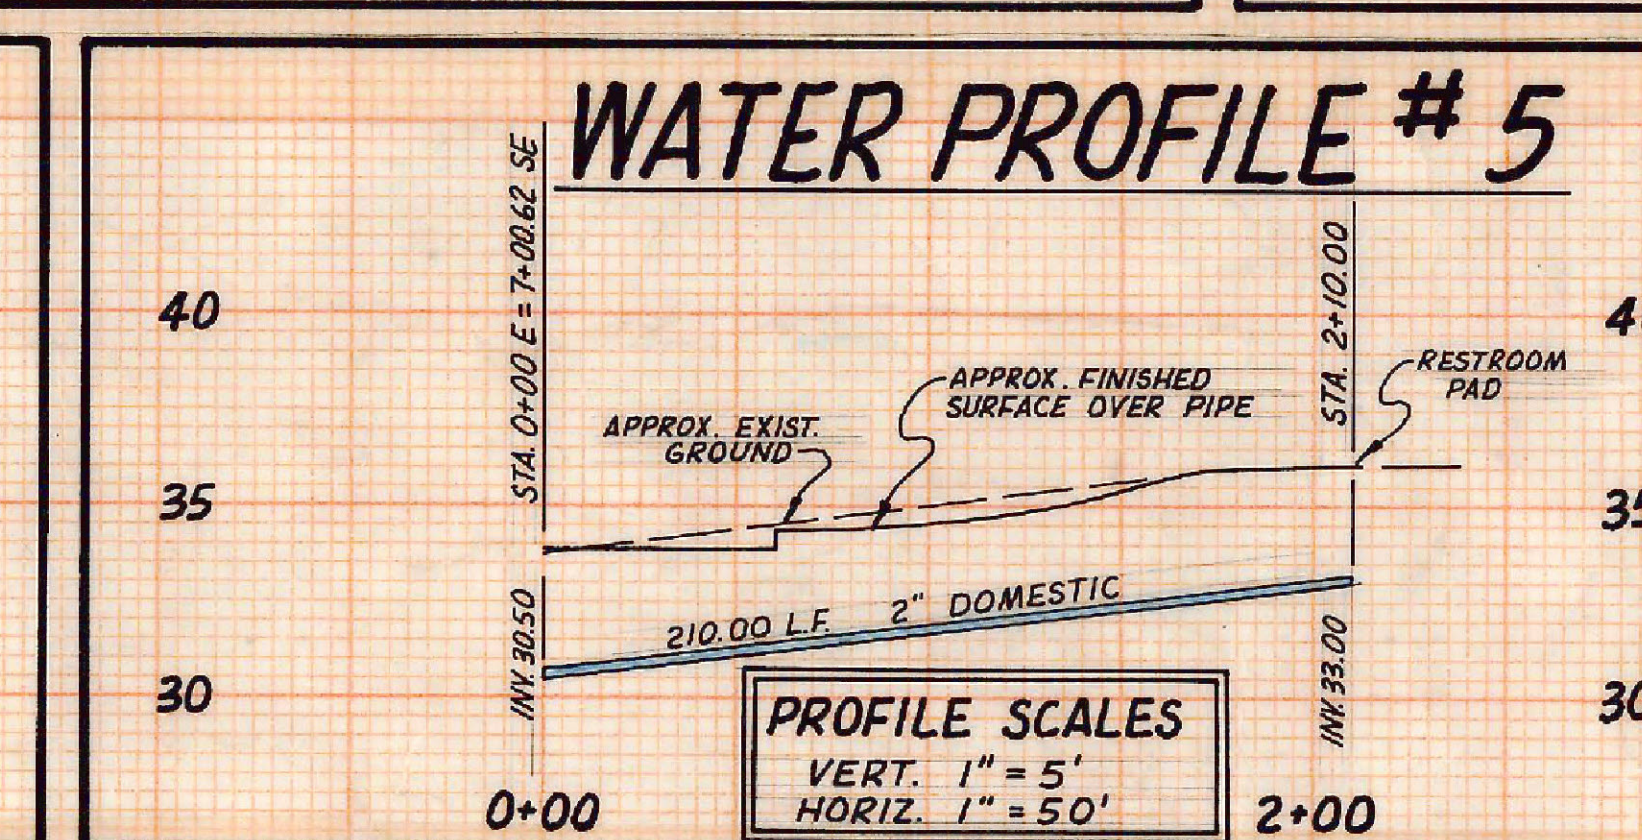
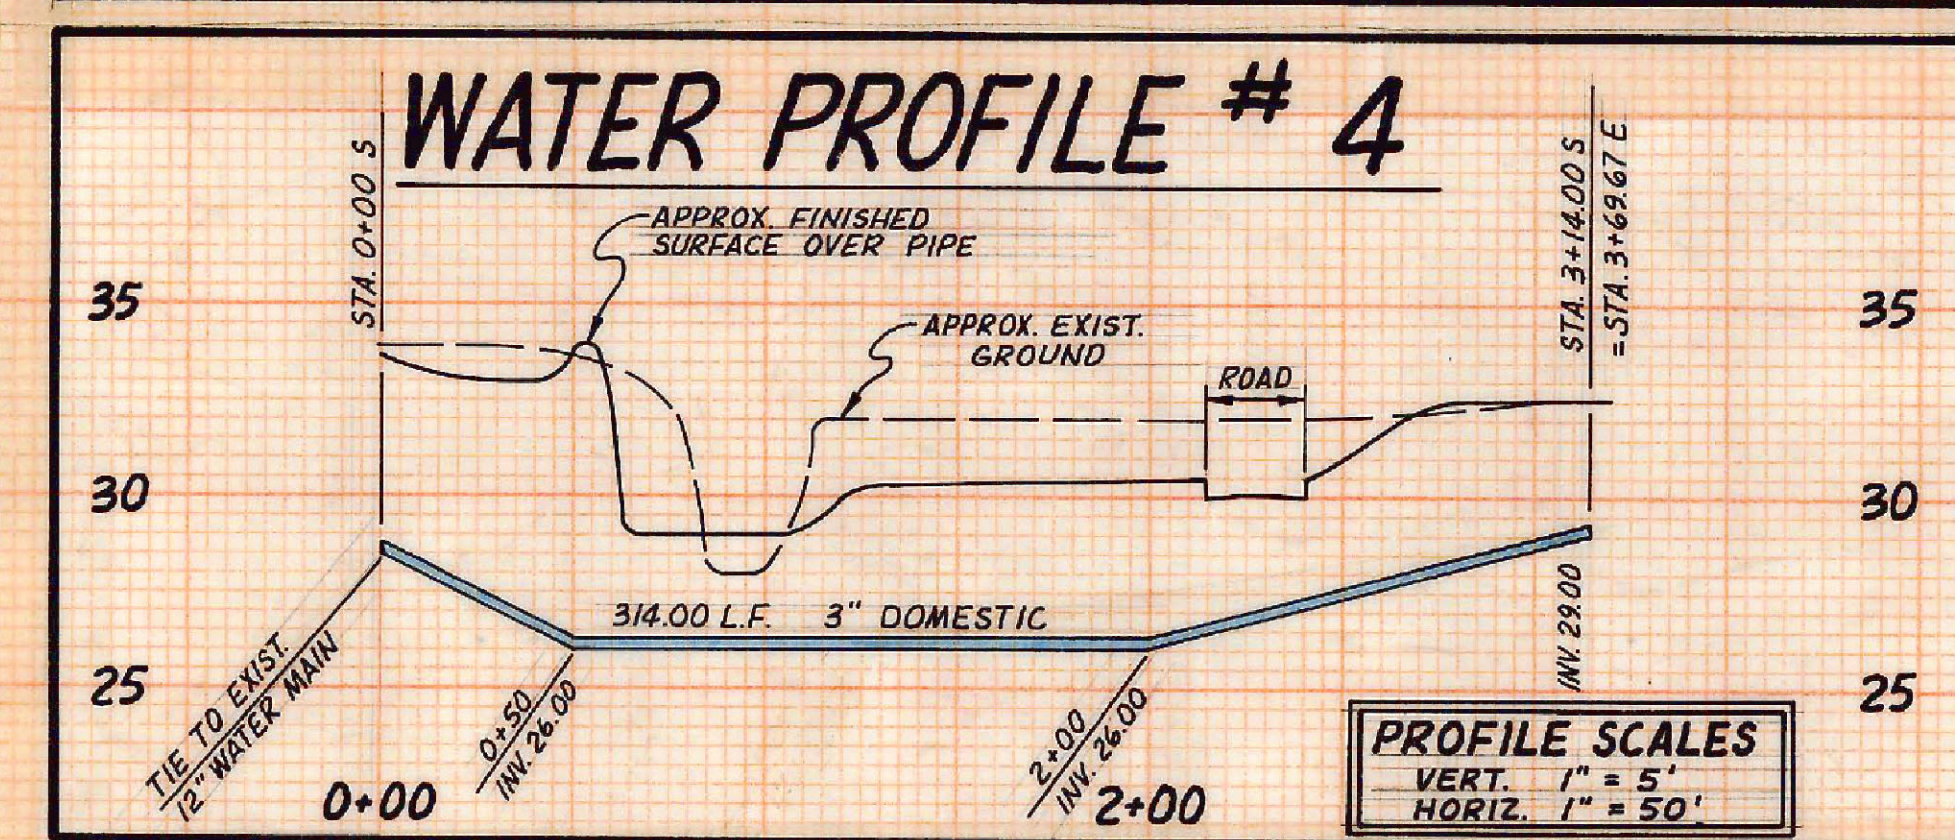
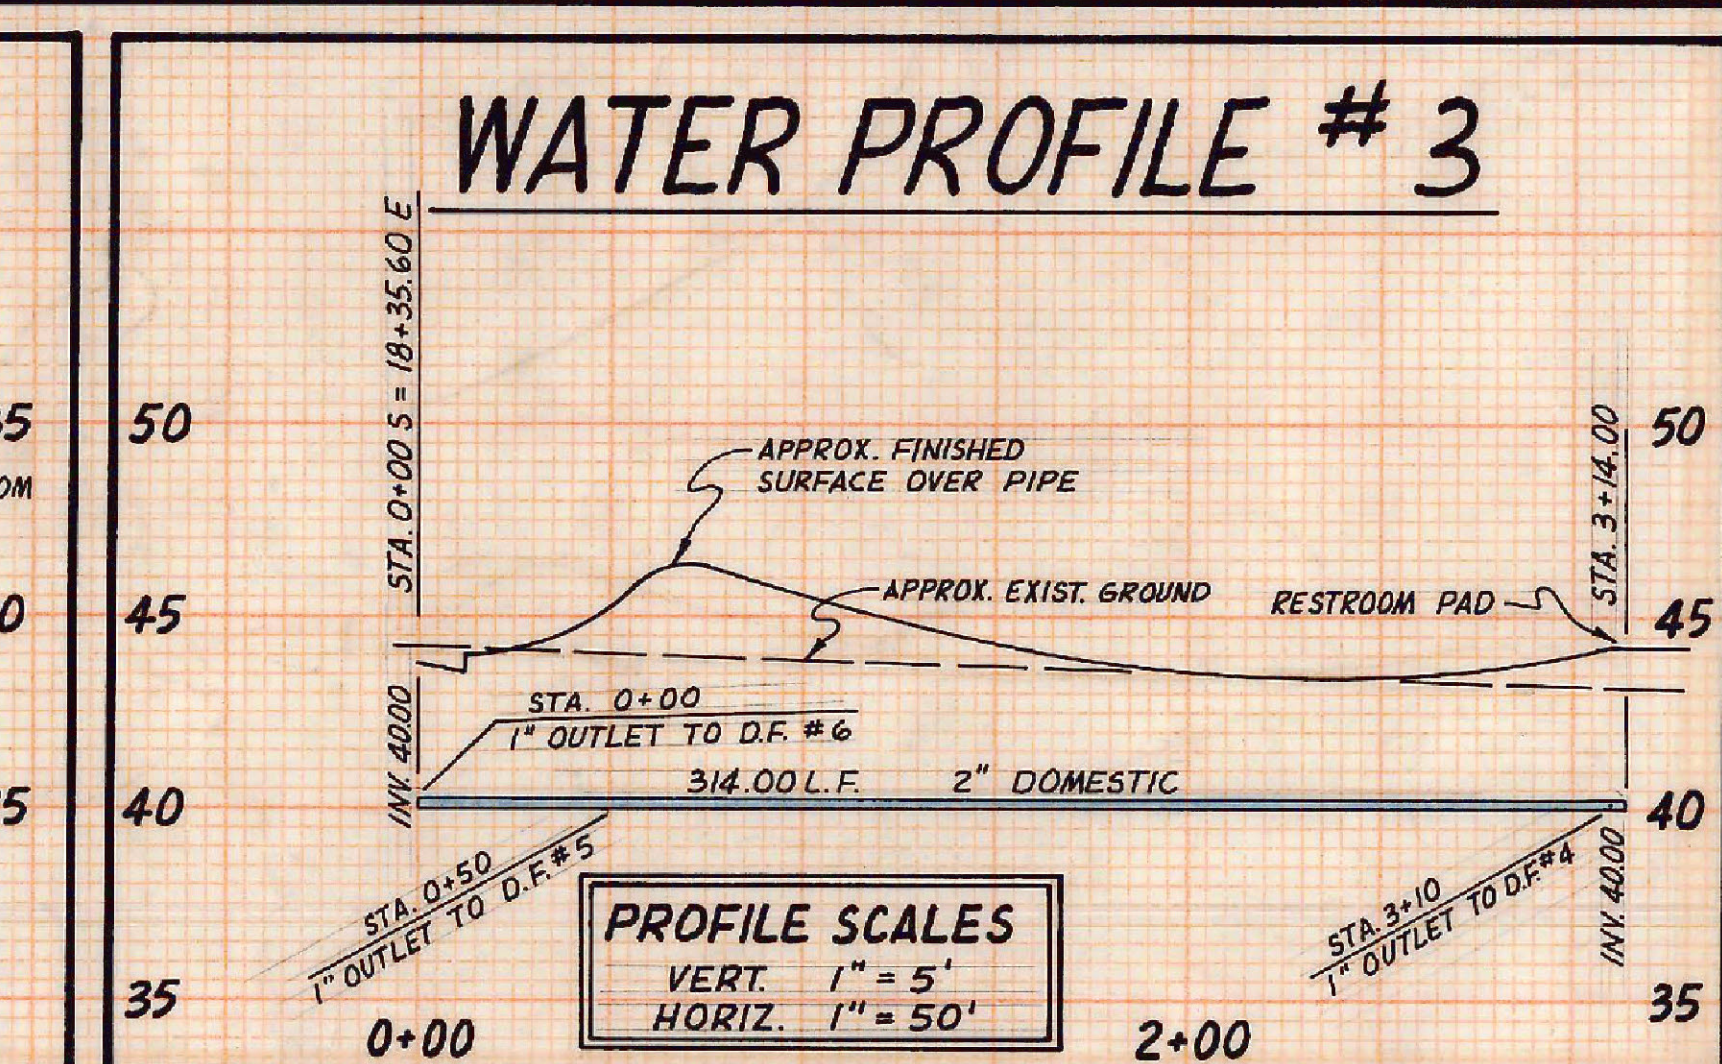
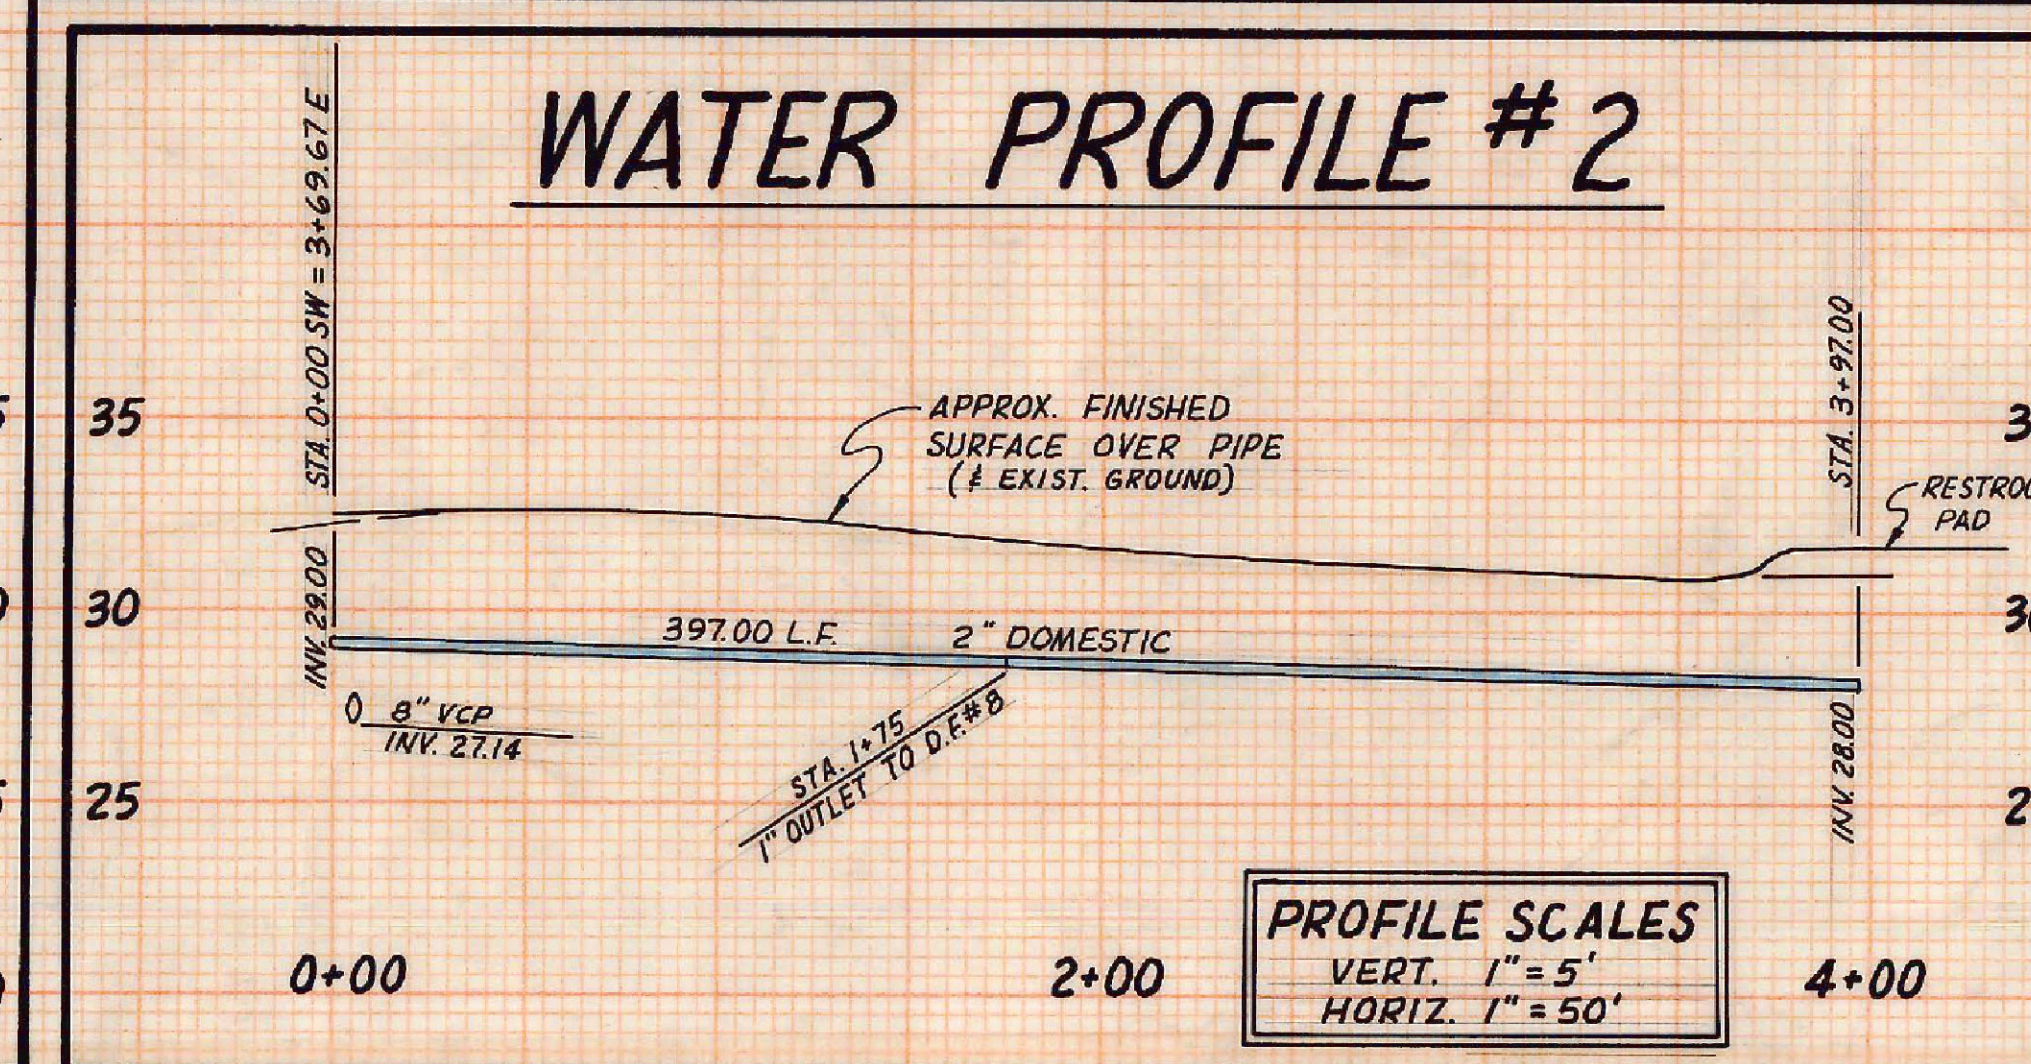
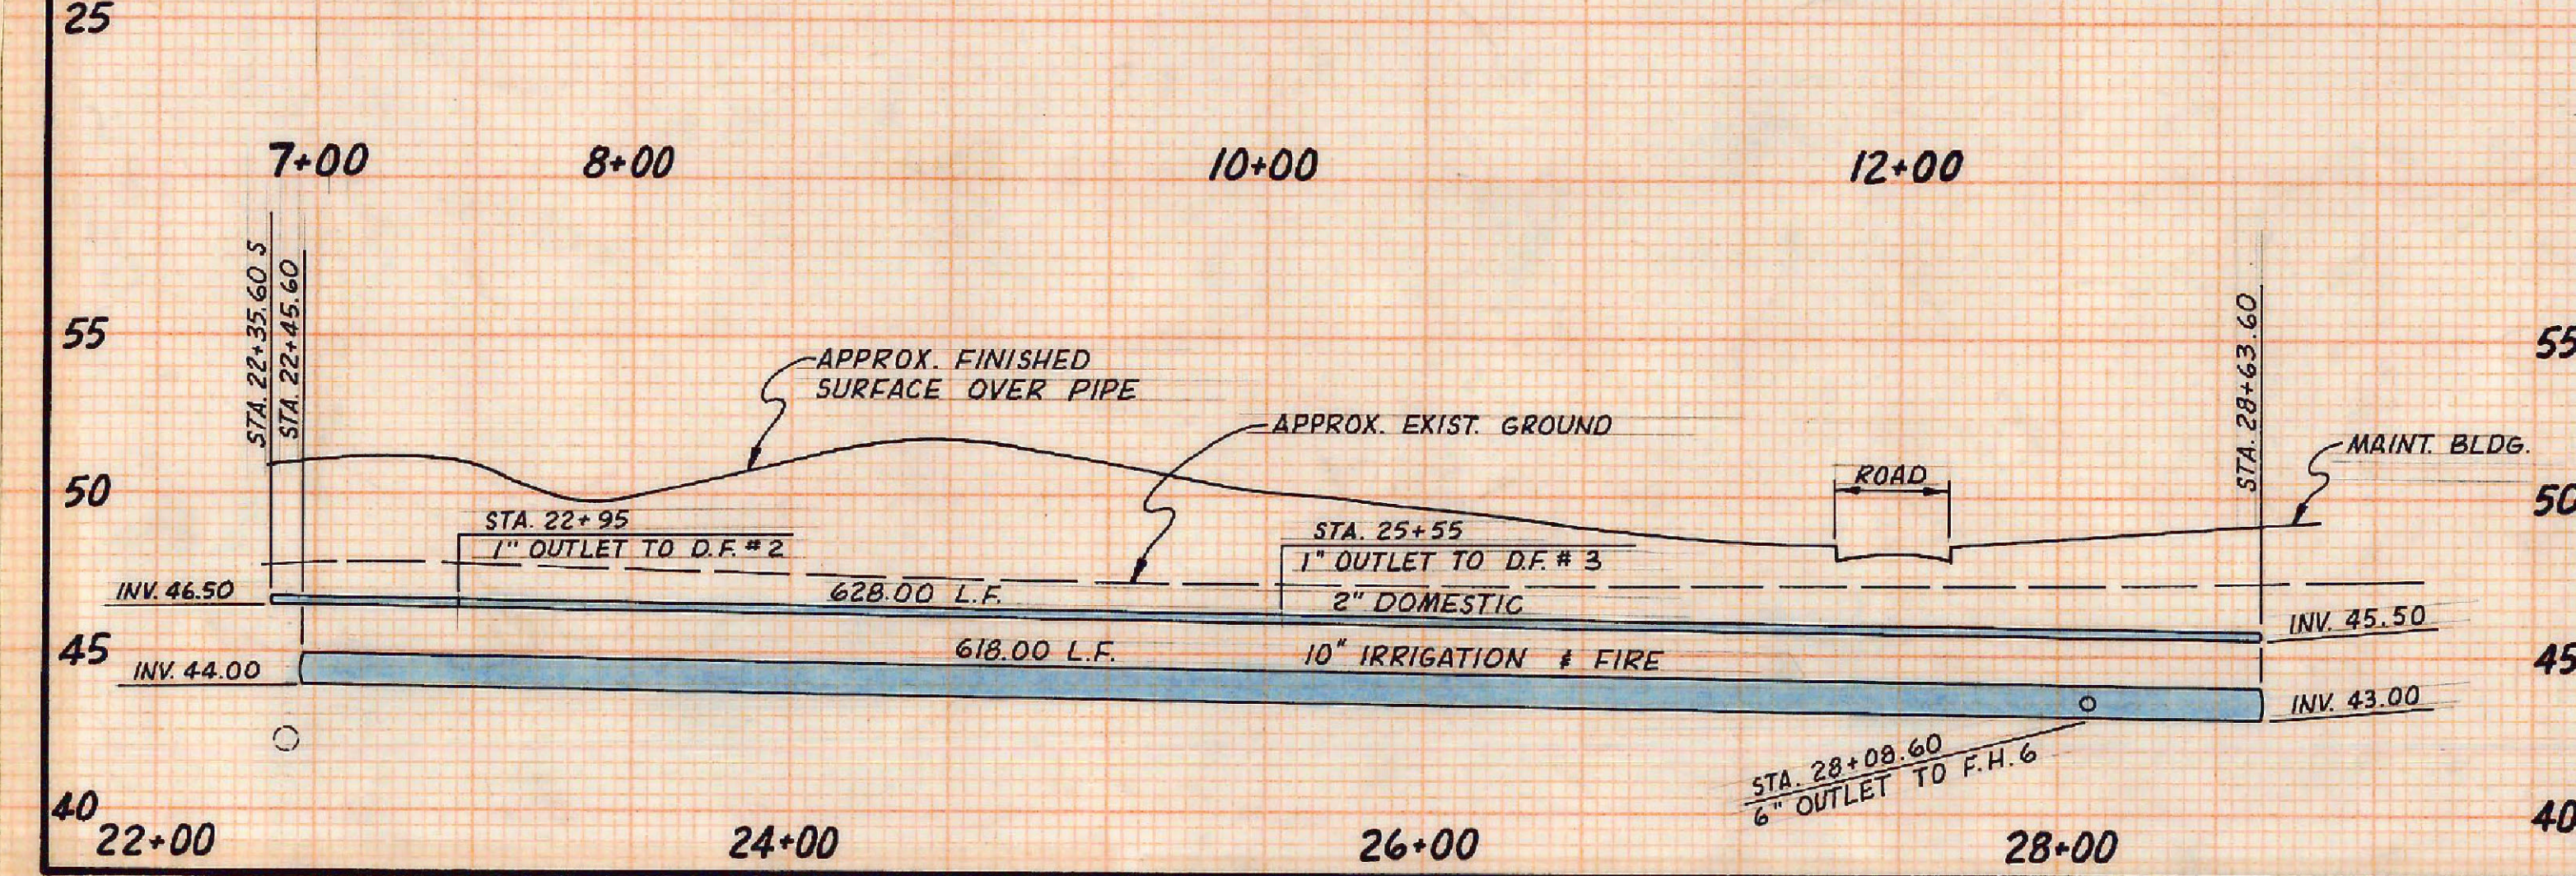


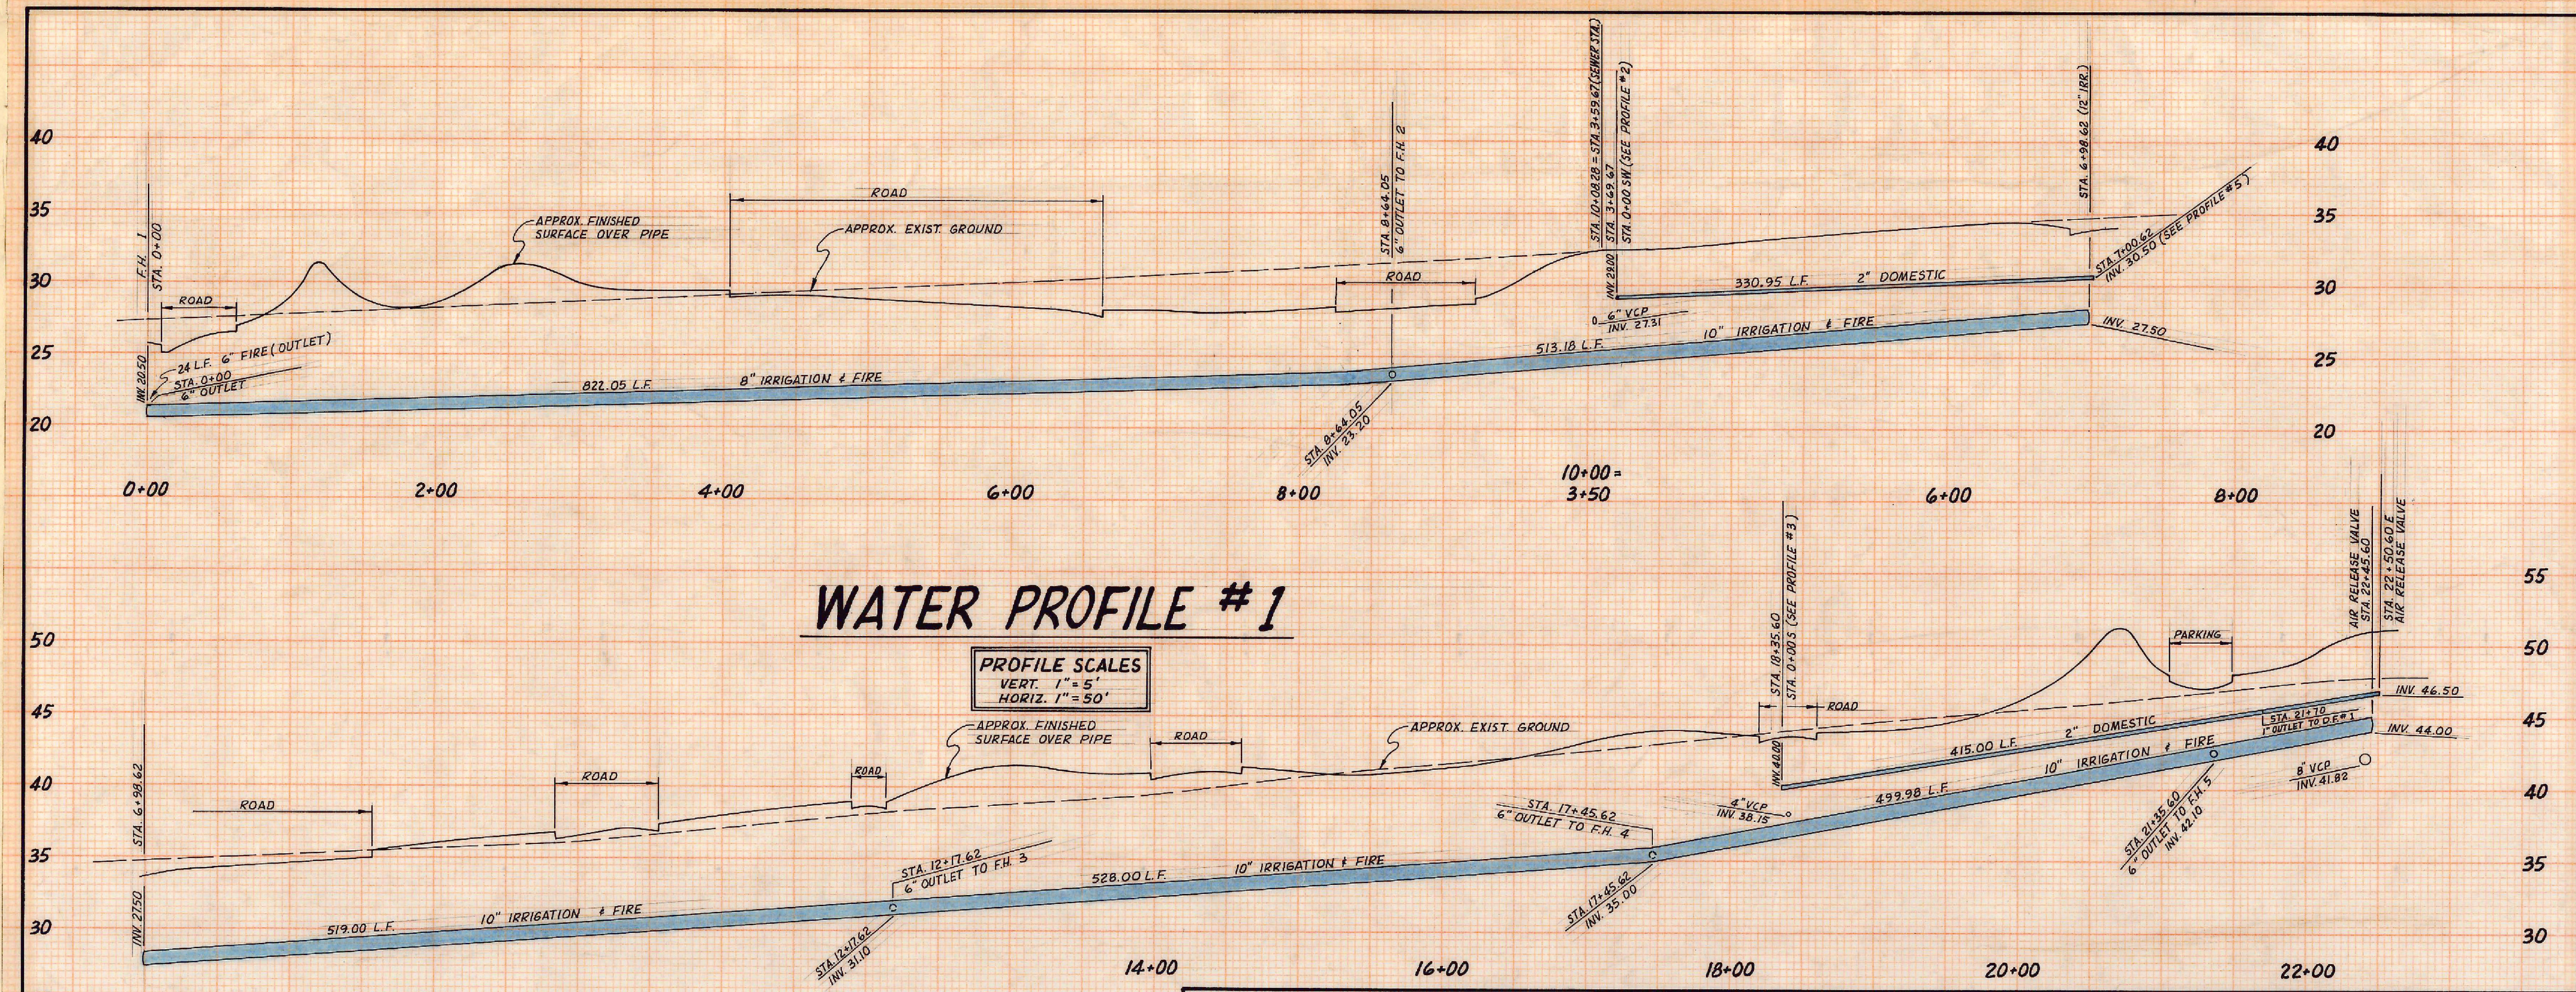

REVISIONS DATE DESCRIPTION _____ _____		JONES/PETERSON ASSOC. INC. 218 E. BROADWAY, ANAHEIM, CALIF. 92731-1110 ARCHITECTURAL CONSULTANTS MORRIS LOEBACH ASSOC. INC. 1811 IRVINE BLVD., IRTN, CALIF. 92614-5073 ENGINEERING CONSULTANTS TOPEKA ENGINEERING, INC. 1011 JONES BLVD., IRTN, CALIF. 92614-5073
WATER LINE PROFILES DESIGN: KZA DRAWN: REK CHECK: DIVM DATE: 4/12/92		
UNIVERSITY REGIONAL PARK PROJECT NO. 03-1-400-14 BUILDING SERVICES DEPARTMENT COUNTY OF ORANGE		SHEET NO. C-8 OF 14 SHEETS