



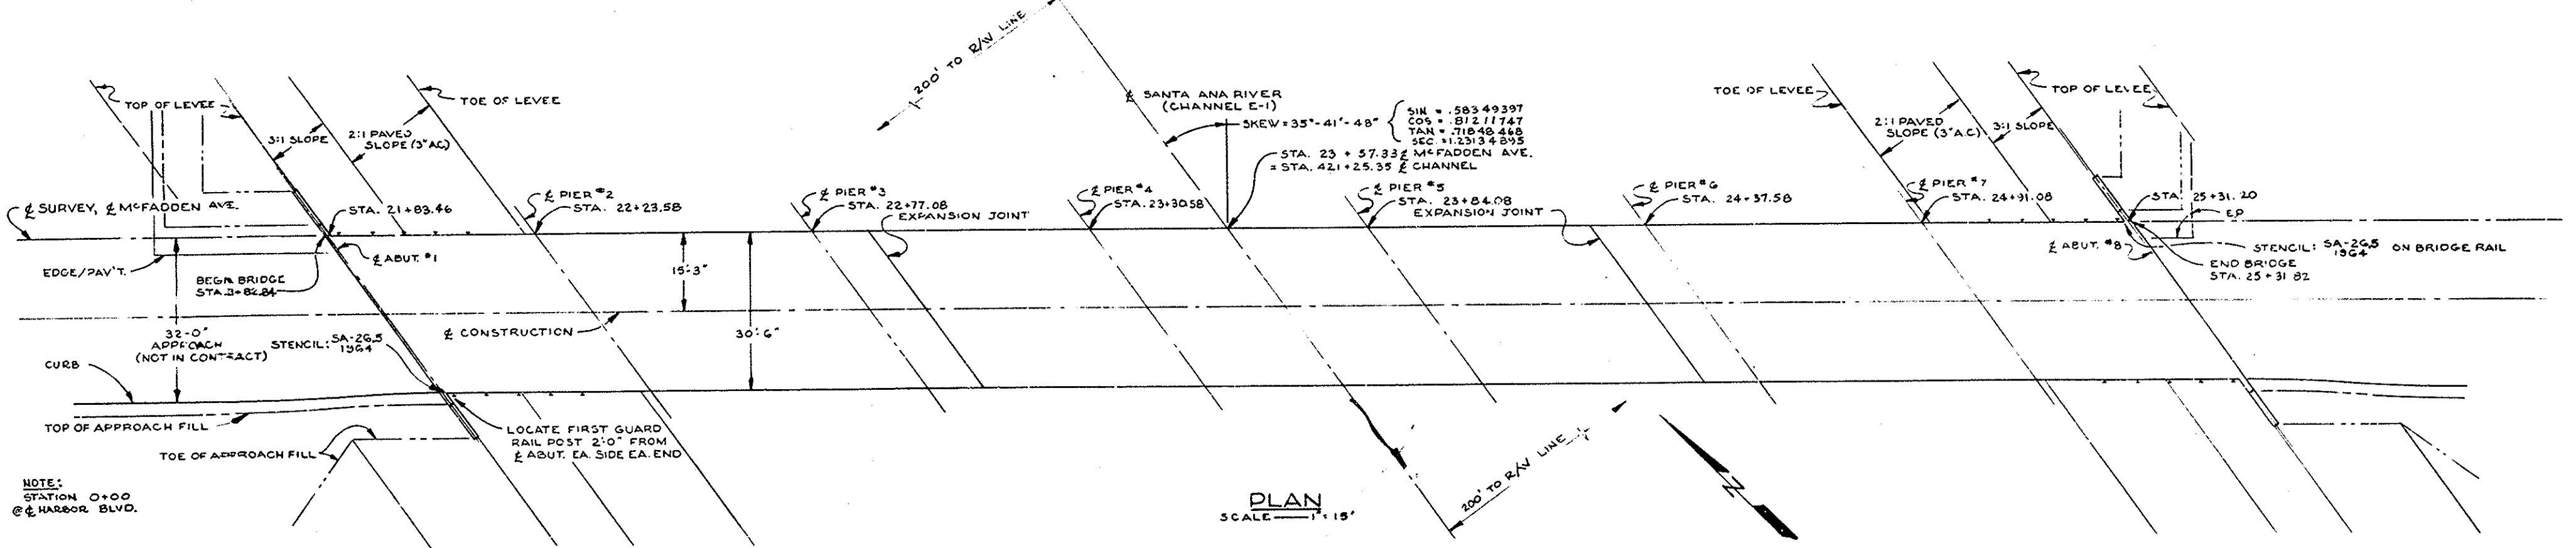


TABLE OF ELEVATIONS
AMOUNT OF DUMBER FOR CONSTRUCTION WILL BE DETERMINED BY THE ENGINEER IN FIELD

	ELEV. 1	2	3	4
ABUT. #1	81.88	81.54	77.86	77.57
MS-2	82.18	81.78	78.15	78.81
PIER 3	82.43	81.94	78.40	77.99
MS-3	82.50	81.98	78.46	78.01
PIER 4	82.49	81.93	78.45	77.97
MS-4	82.43	81.83	78.39	77.87
PIER 5	82.20	81.54	78.15	77.59
MS-5	81.80	81.08	77.75	77.13
PIER 6	81.40	80.64	77.34	76.70
MS-6				
PIER 7				
MS-7				
ABUT. 8				

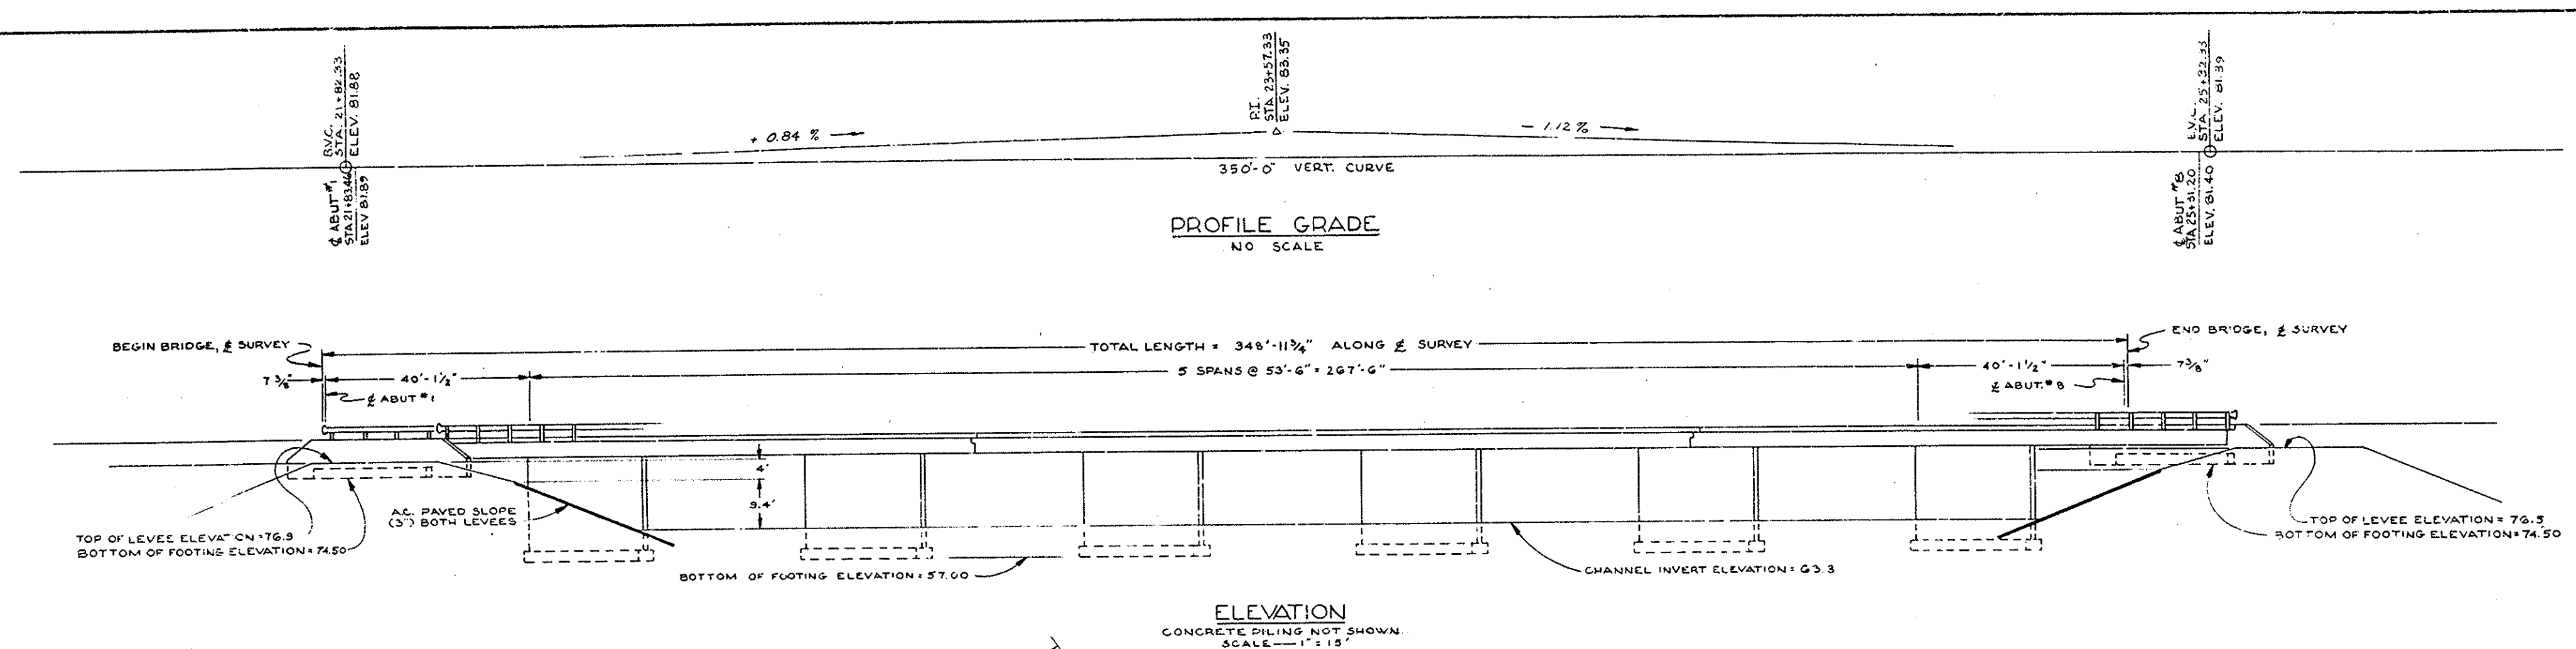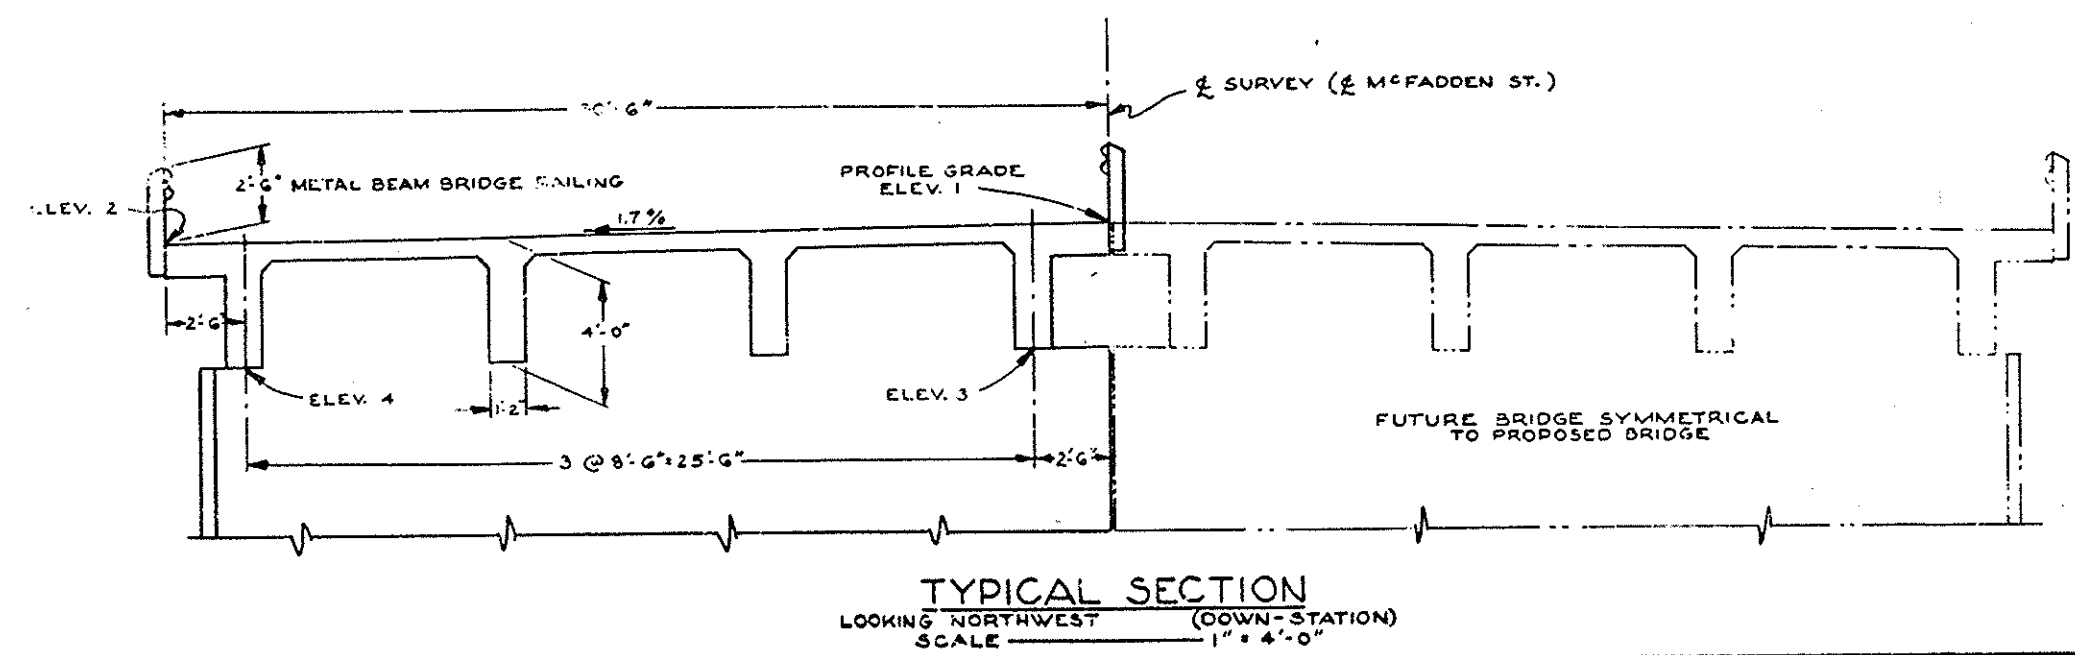

BENCH MARK
OCS STANDARD MONUMENT, A HEXAGONAL BAR SET IN CONCRETE, ABOUT 1' BELOW SURFACE, IN CAPPED WELL, @ $\pm$ INTERSECTION OF HARBOR BLVD. & MCFADDEN ST. (SUGAR AVE)
IF - 80 - 59 1962 ELEV. 63.603

Sta. 26.5
Const. of McFadden Ave. Bridge (Channel E-1)
Sheet 14 of 14
Red. 30:1 Scale 1" = 15'
Vellum Pencil Sketch

MICROFILMED
DEC 28 1964

SANTA ANA COUNTY HIGHWAY DEPARTMENT

MCFADDEN AVENUE BRIDGE
OVER
SANTA ANA RIVER
GENERAL PLAN

AS SHOWN SHEET 2 OF 14