



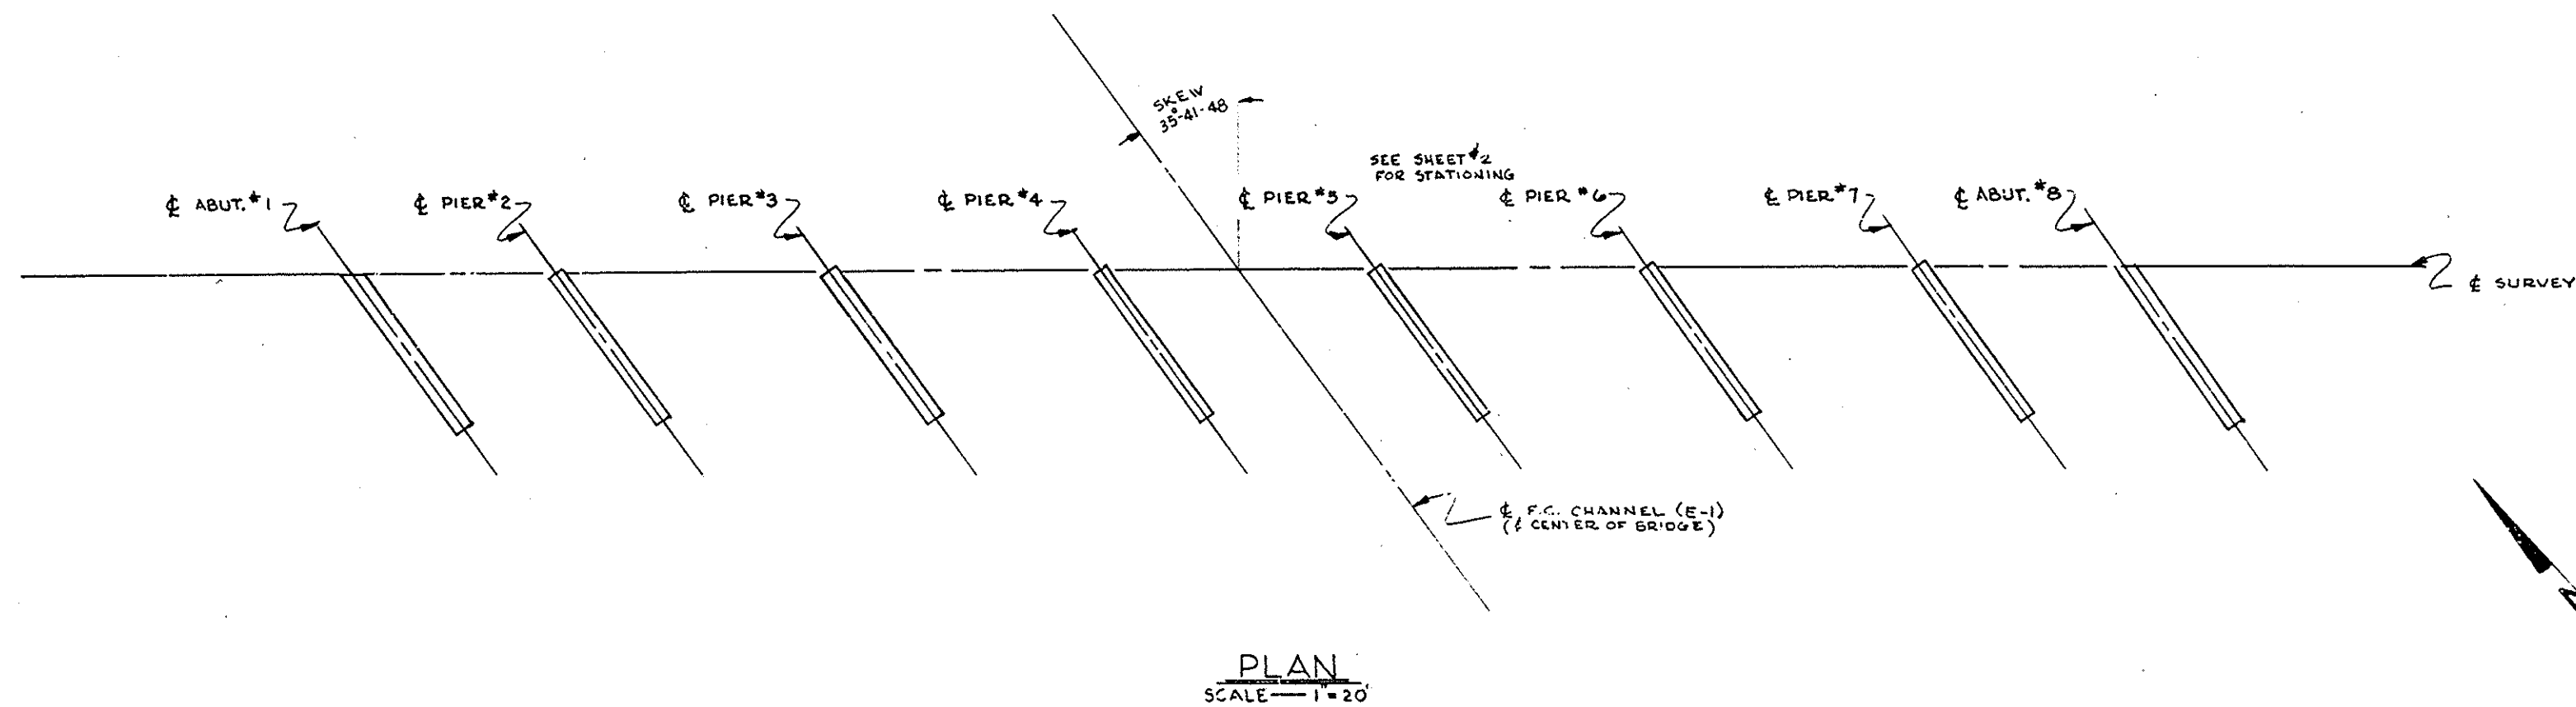

NOTES:

PILE BEARING VALUE: 45 TONS

FOOTING	DOT/FTG. ELEV.	ESTIM. PILE TIP ELEV.	CUTOFF ELEV.
ABUT #1	+74.50	+20.00	+74.75
PIER #2	+57.00		+57.25
#3			
#4			
#5			
#6			
#7	+57.00		+57.25
ABUT #8	+74.50	+20.00	+74.75

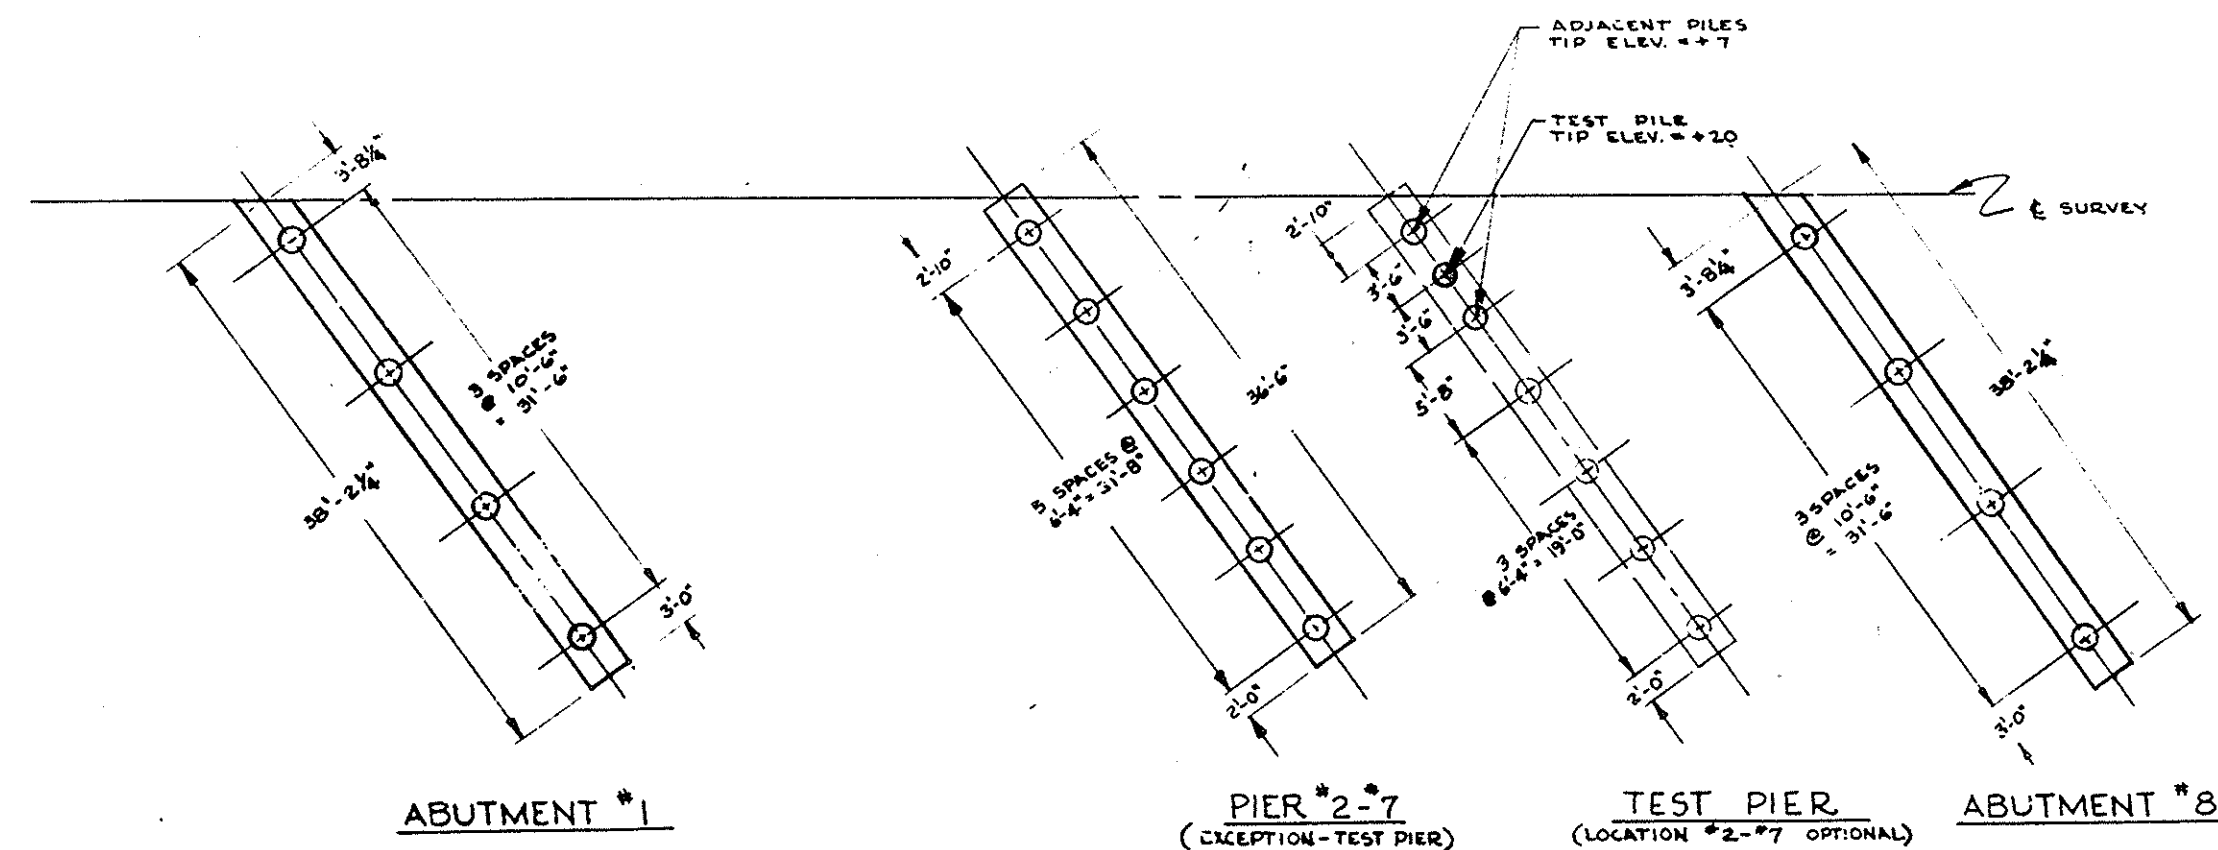

PILE LAYOUT
SCALE 1/8" = 1'-0"

S. A. 26.5
Const. of McFadden Ave. Bridge
(Channel B-1)
Sheet 3 of 14
Red. 20:1 Scale 1" = 20'
Yellow Pencil Sketch

MICROFILMED
DEC 28 1984

COUNTY HIGHWAY DEPARTMENT

**McFADDEN AVE
BRIDGE
over S A RIVER**

FOUNDATION PLAN

NOTED

SHEET 3 OF 14