



SECTION A-A
SCALE $\frac{1}{2}'' = 1'-0''$

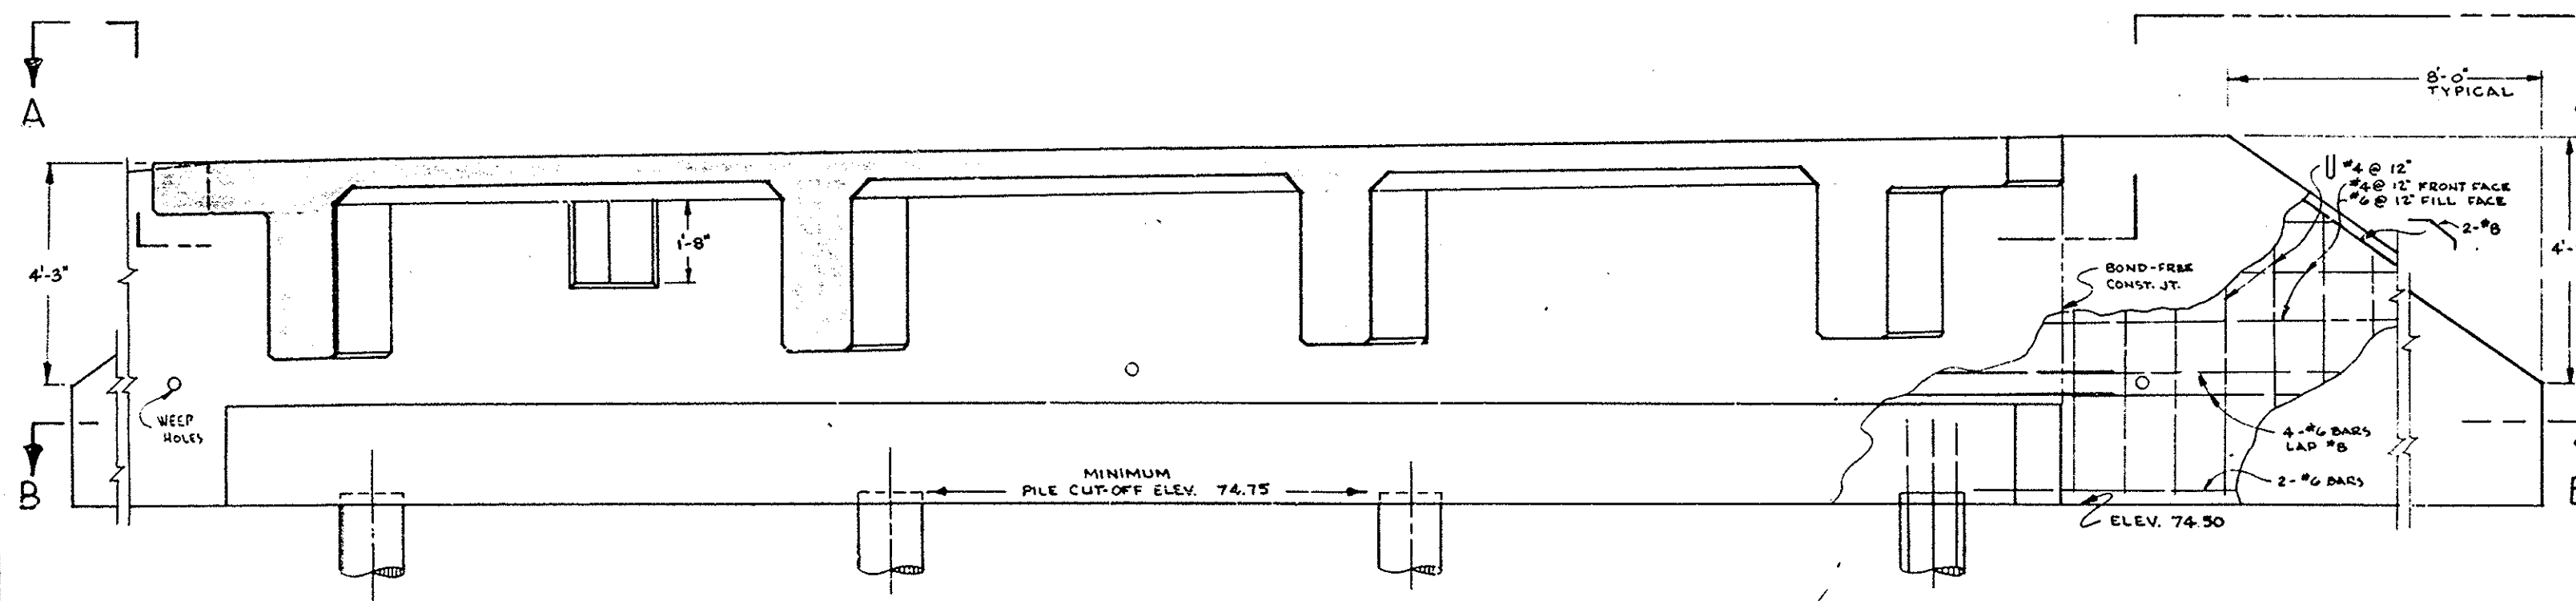


TYPICAL ABUTMENT DETAILS
SCALE $\frac{1}{2}'' = 1'-0''$
ABUTMENT #1 SHOWN
ABUT #2 OPPOSITE HAND

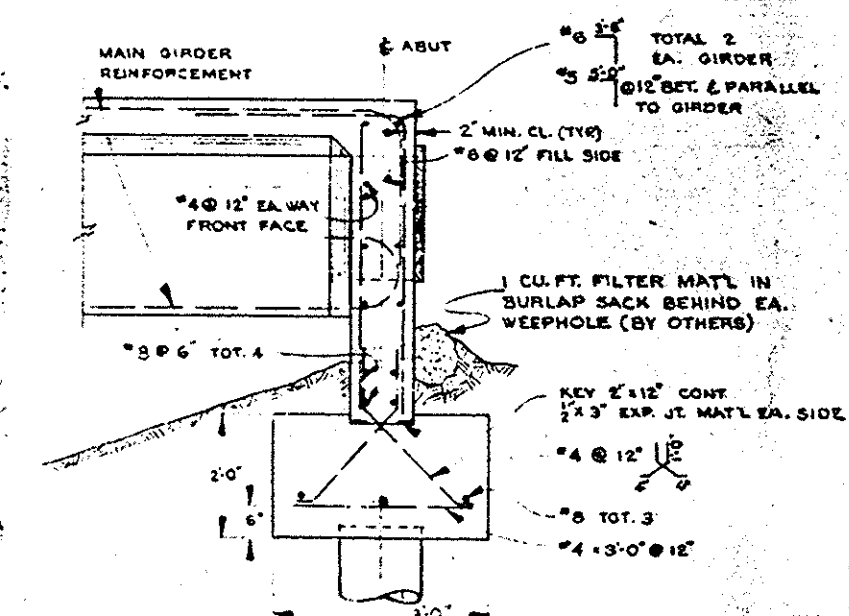

SECTION C-C
SCALE $\frac{1}{2}'' = 1'-0''$

BLOCK BACK OF UNUSED UTILITY OPENINGS WITH
2" MIN LUMBER (RW). EDGE LAP MIN 3" (BY OTHERS).
3" WEEP HOLES @ 8'-0" C-C @ TOP OF FORWARD FILL.

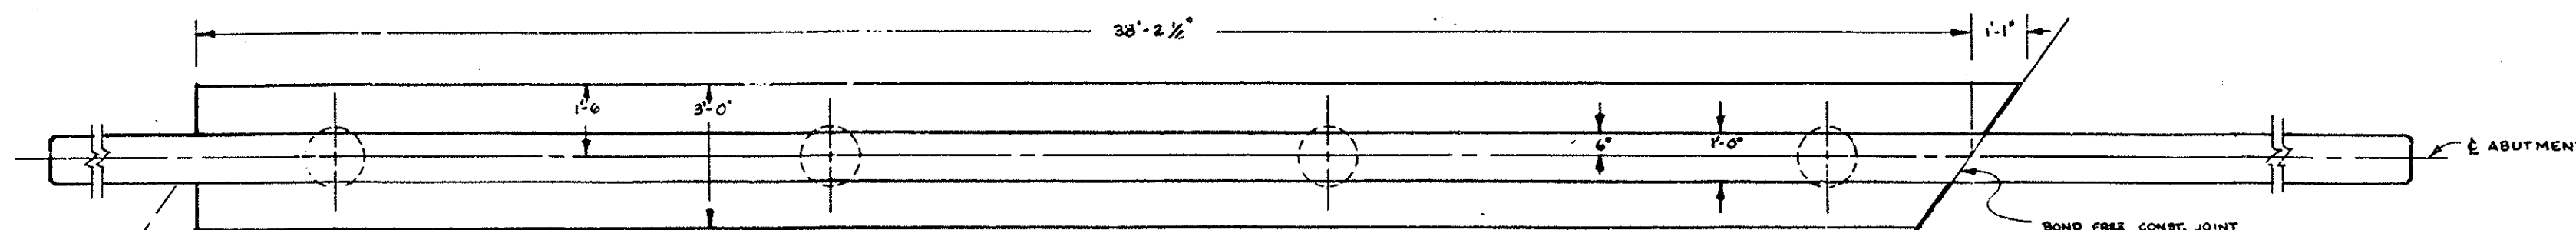

SECTION B-B
SCALE $\frac{1}{2}'' = 1'-0''$

BOND FREE CONST. JOINT
BETWEEN POURS APPLY TECH-KOTE 300V-S OR EQUAL
DOUBLE CHAMFER ABUT WALLS.

U. A. 25.5
Const. of McFadden Ave. Bridge
(Channel E-1)
Sheet 1 of 14
Scale 1" = 1'-0"
Vellum Pencil Sketch

MICROFILMED
DEC 28 1954

ORANGE COUNTY HIGHWAY DEPARTMENT

**McFADDEN AVE
BRIDGE
over S A RIVER**
ABUTMENT DETAIL

SCALE $\frac{1}{2}'' = 1'-0''$

SHEET 4 of 14

SA 265