
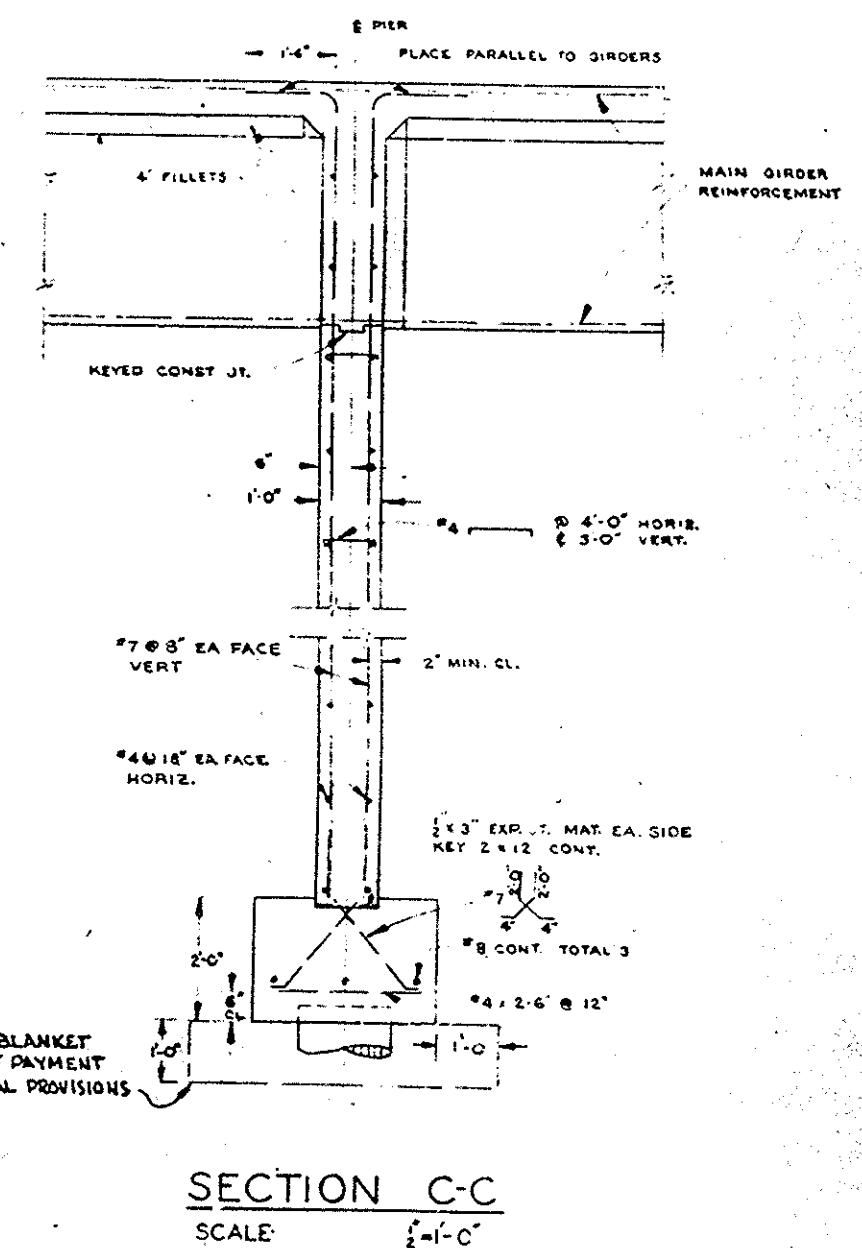
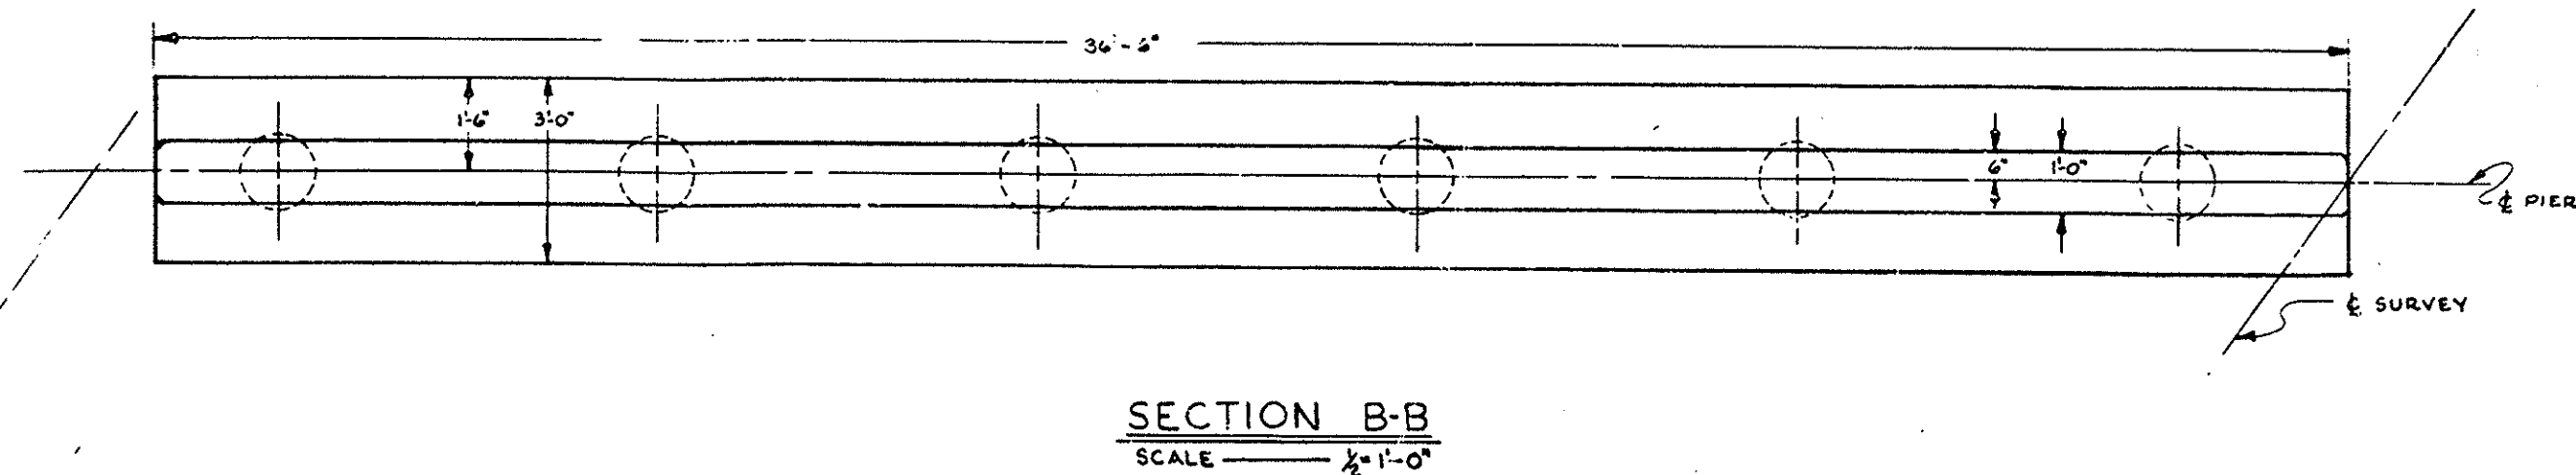
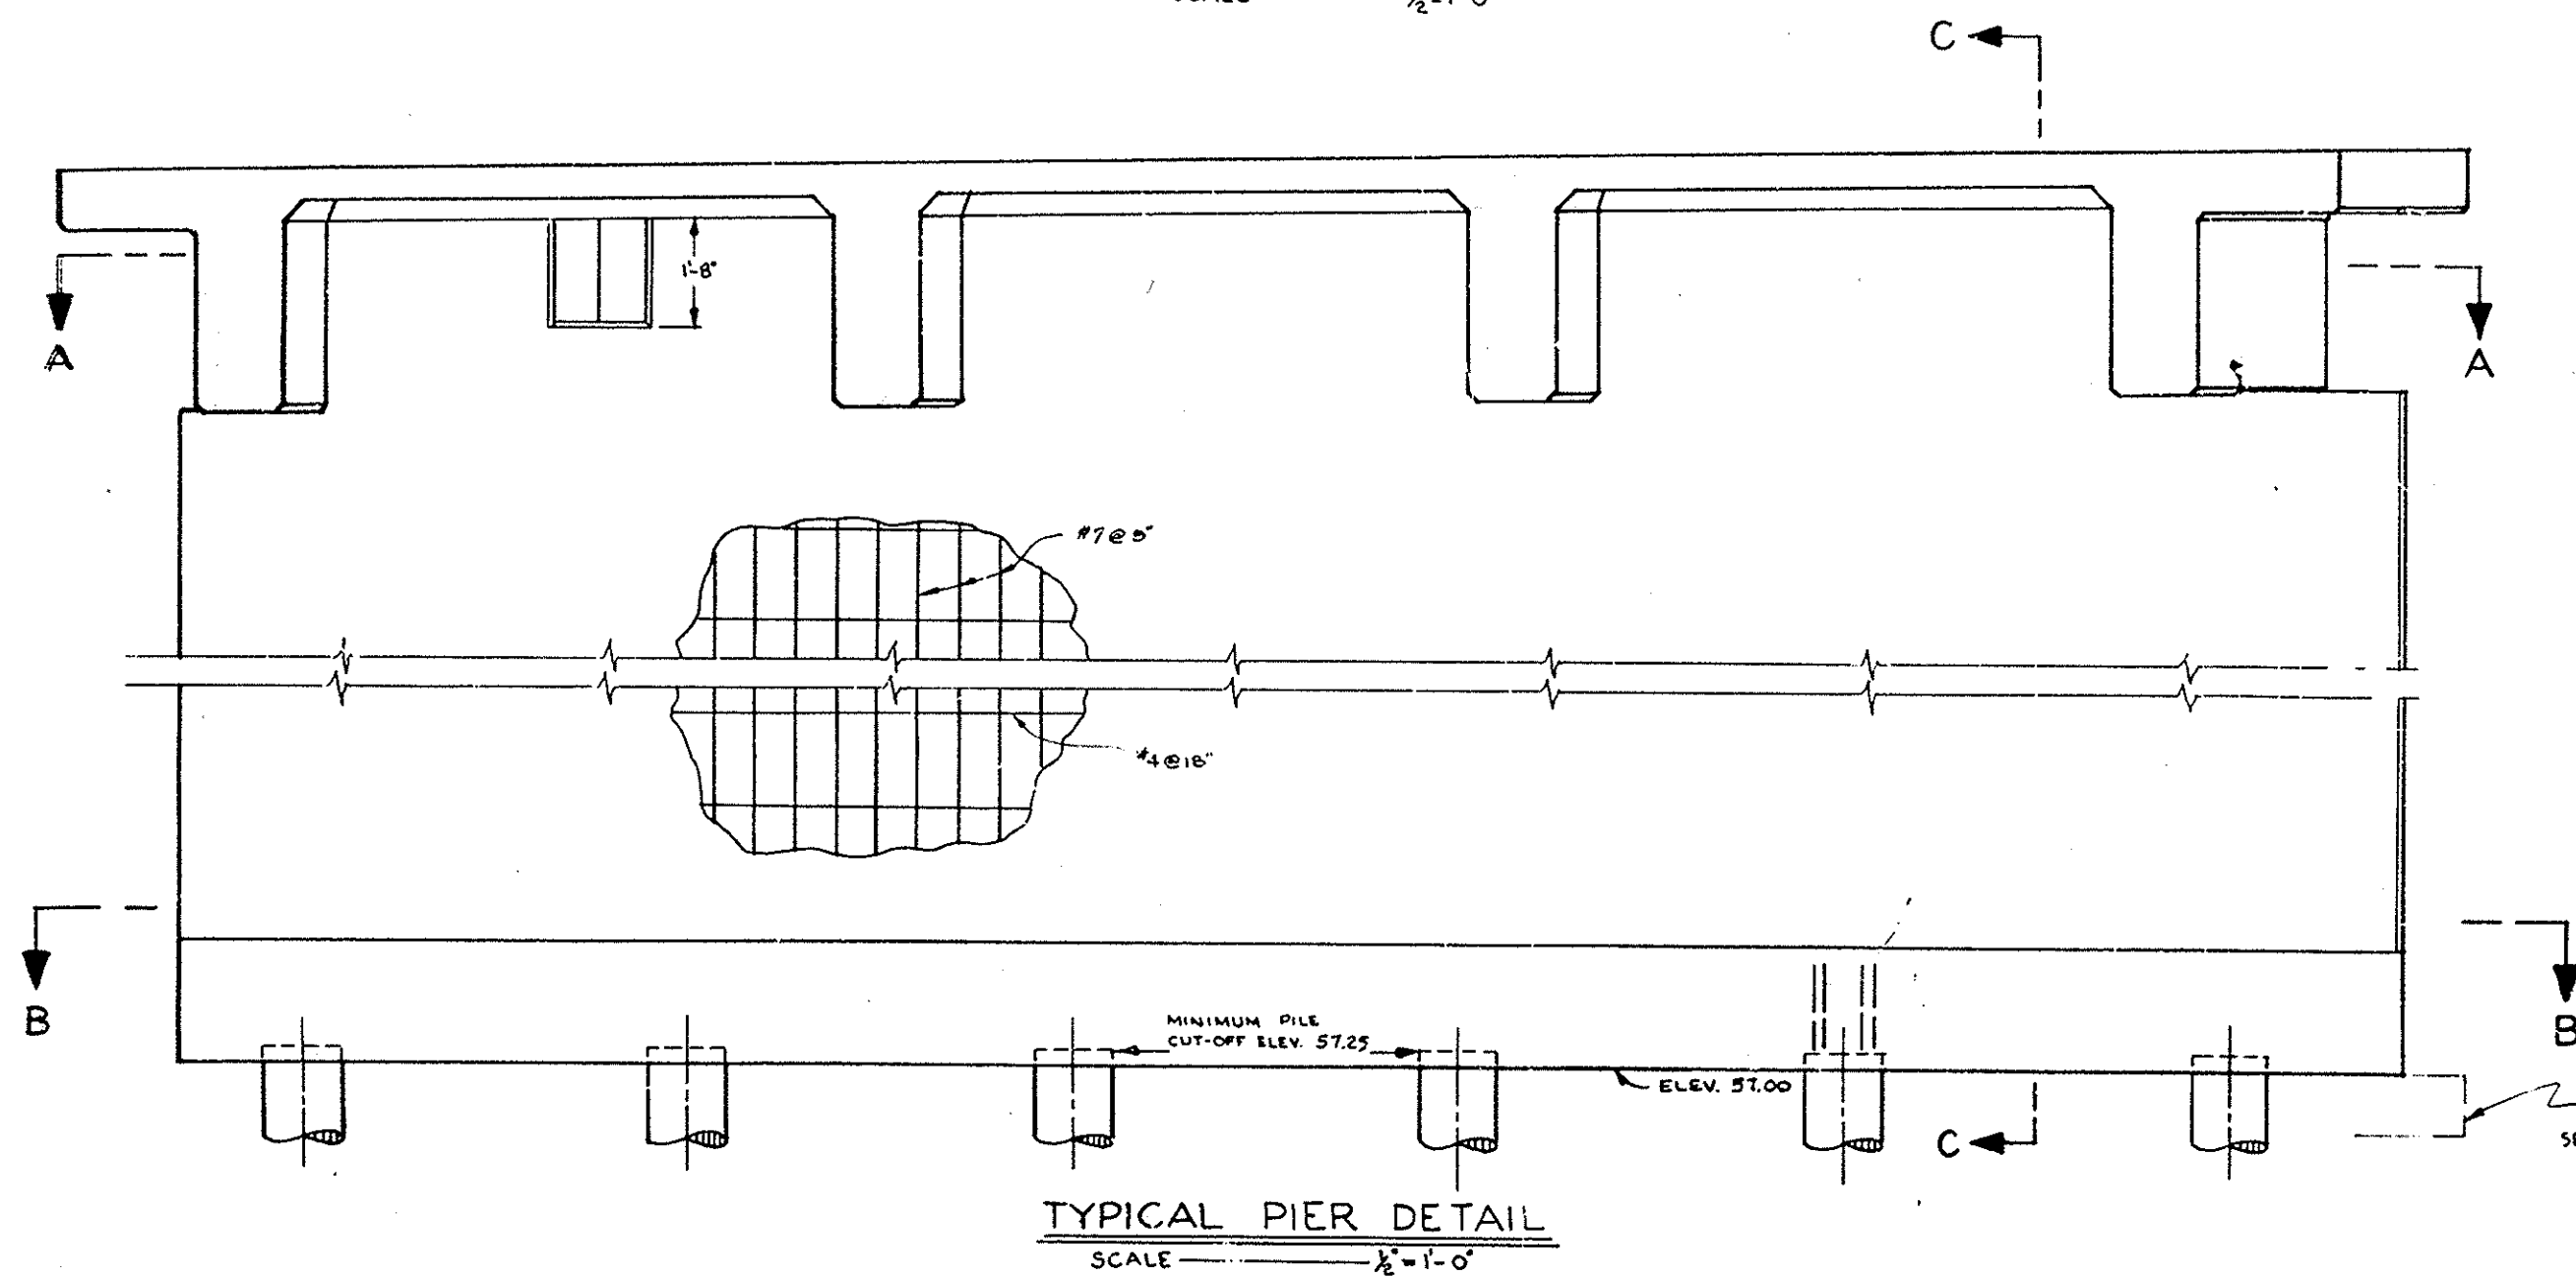


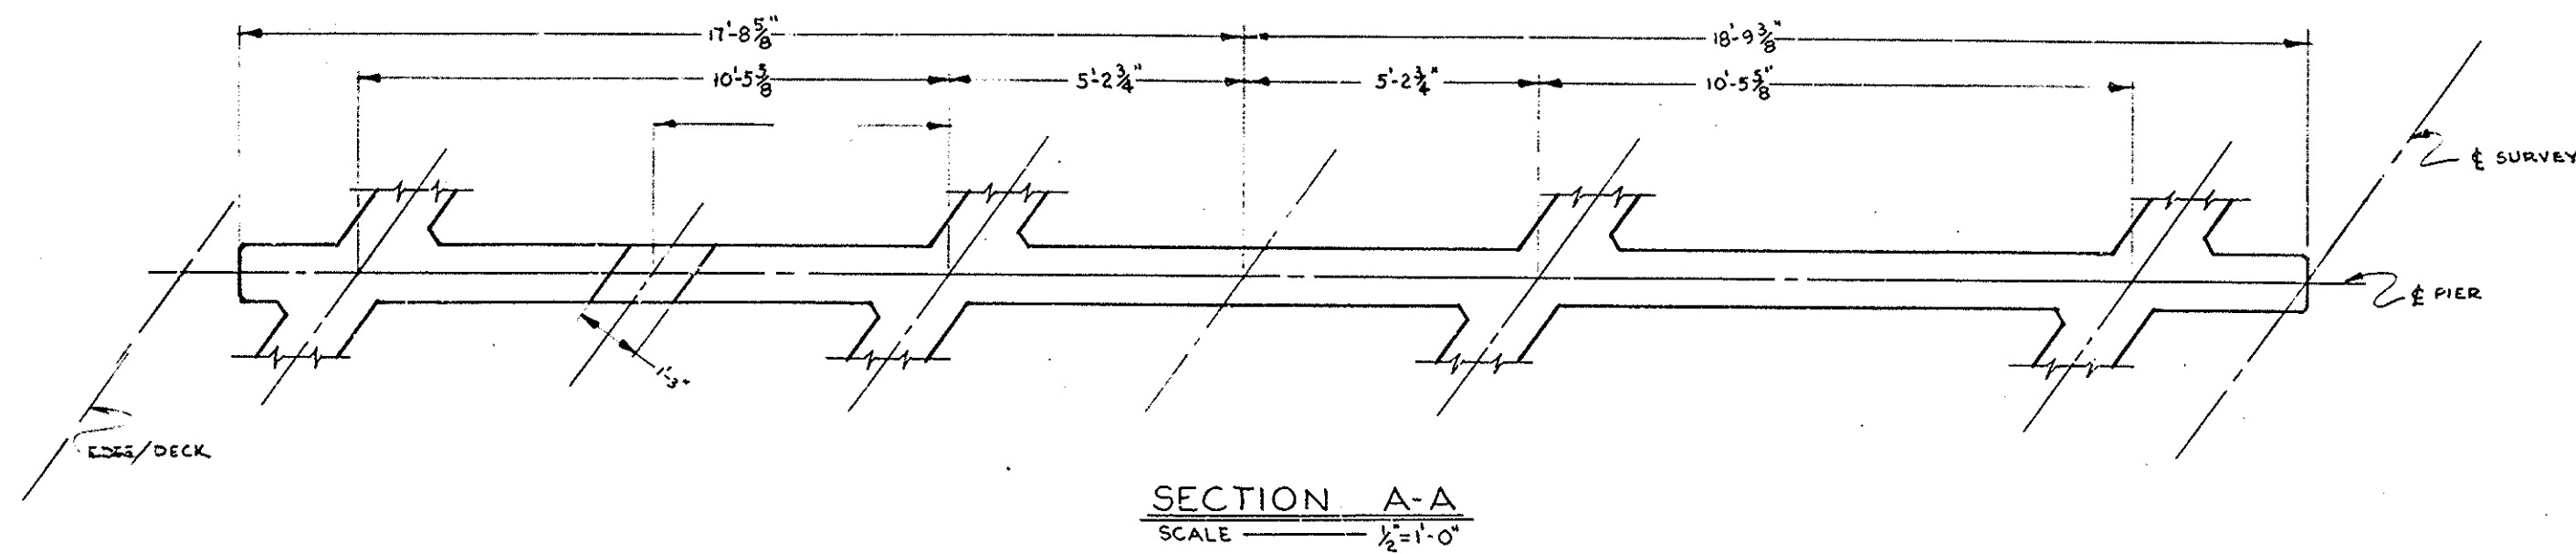

S. A. 24.5
Const. of McFadden Ave. Bridge
(Channel 2-1)
Sheet 5 of 14
Red. 10:1 Scale $\frac{1}{2}'' = 1'-0''$
Vellum pencil sketch

MICROFILMED
DEC 2 1961
GRAND COUNTY HIGHWAY DEPARTMENT
**McFADDEN AVE
BRIDGE
over SA RIVER**
PIER DETAIL
SCALE $\frac{1}{2}'' = 1'-0''$ SHEET 5 OF 14