
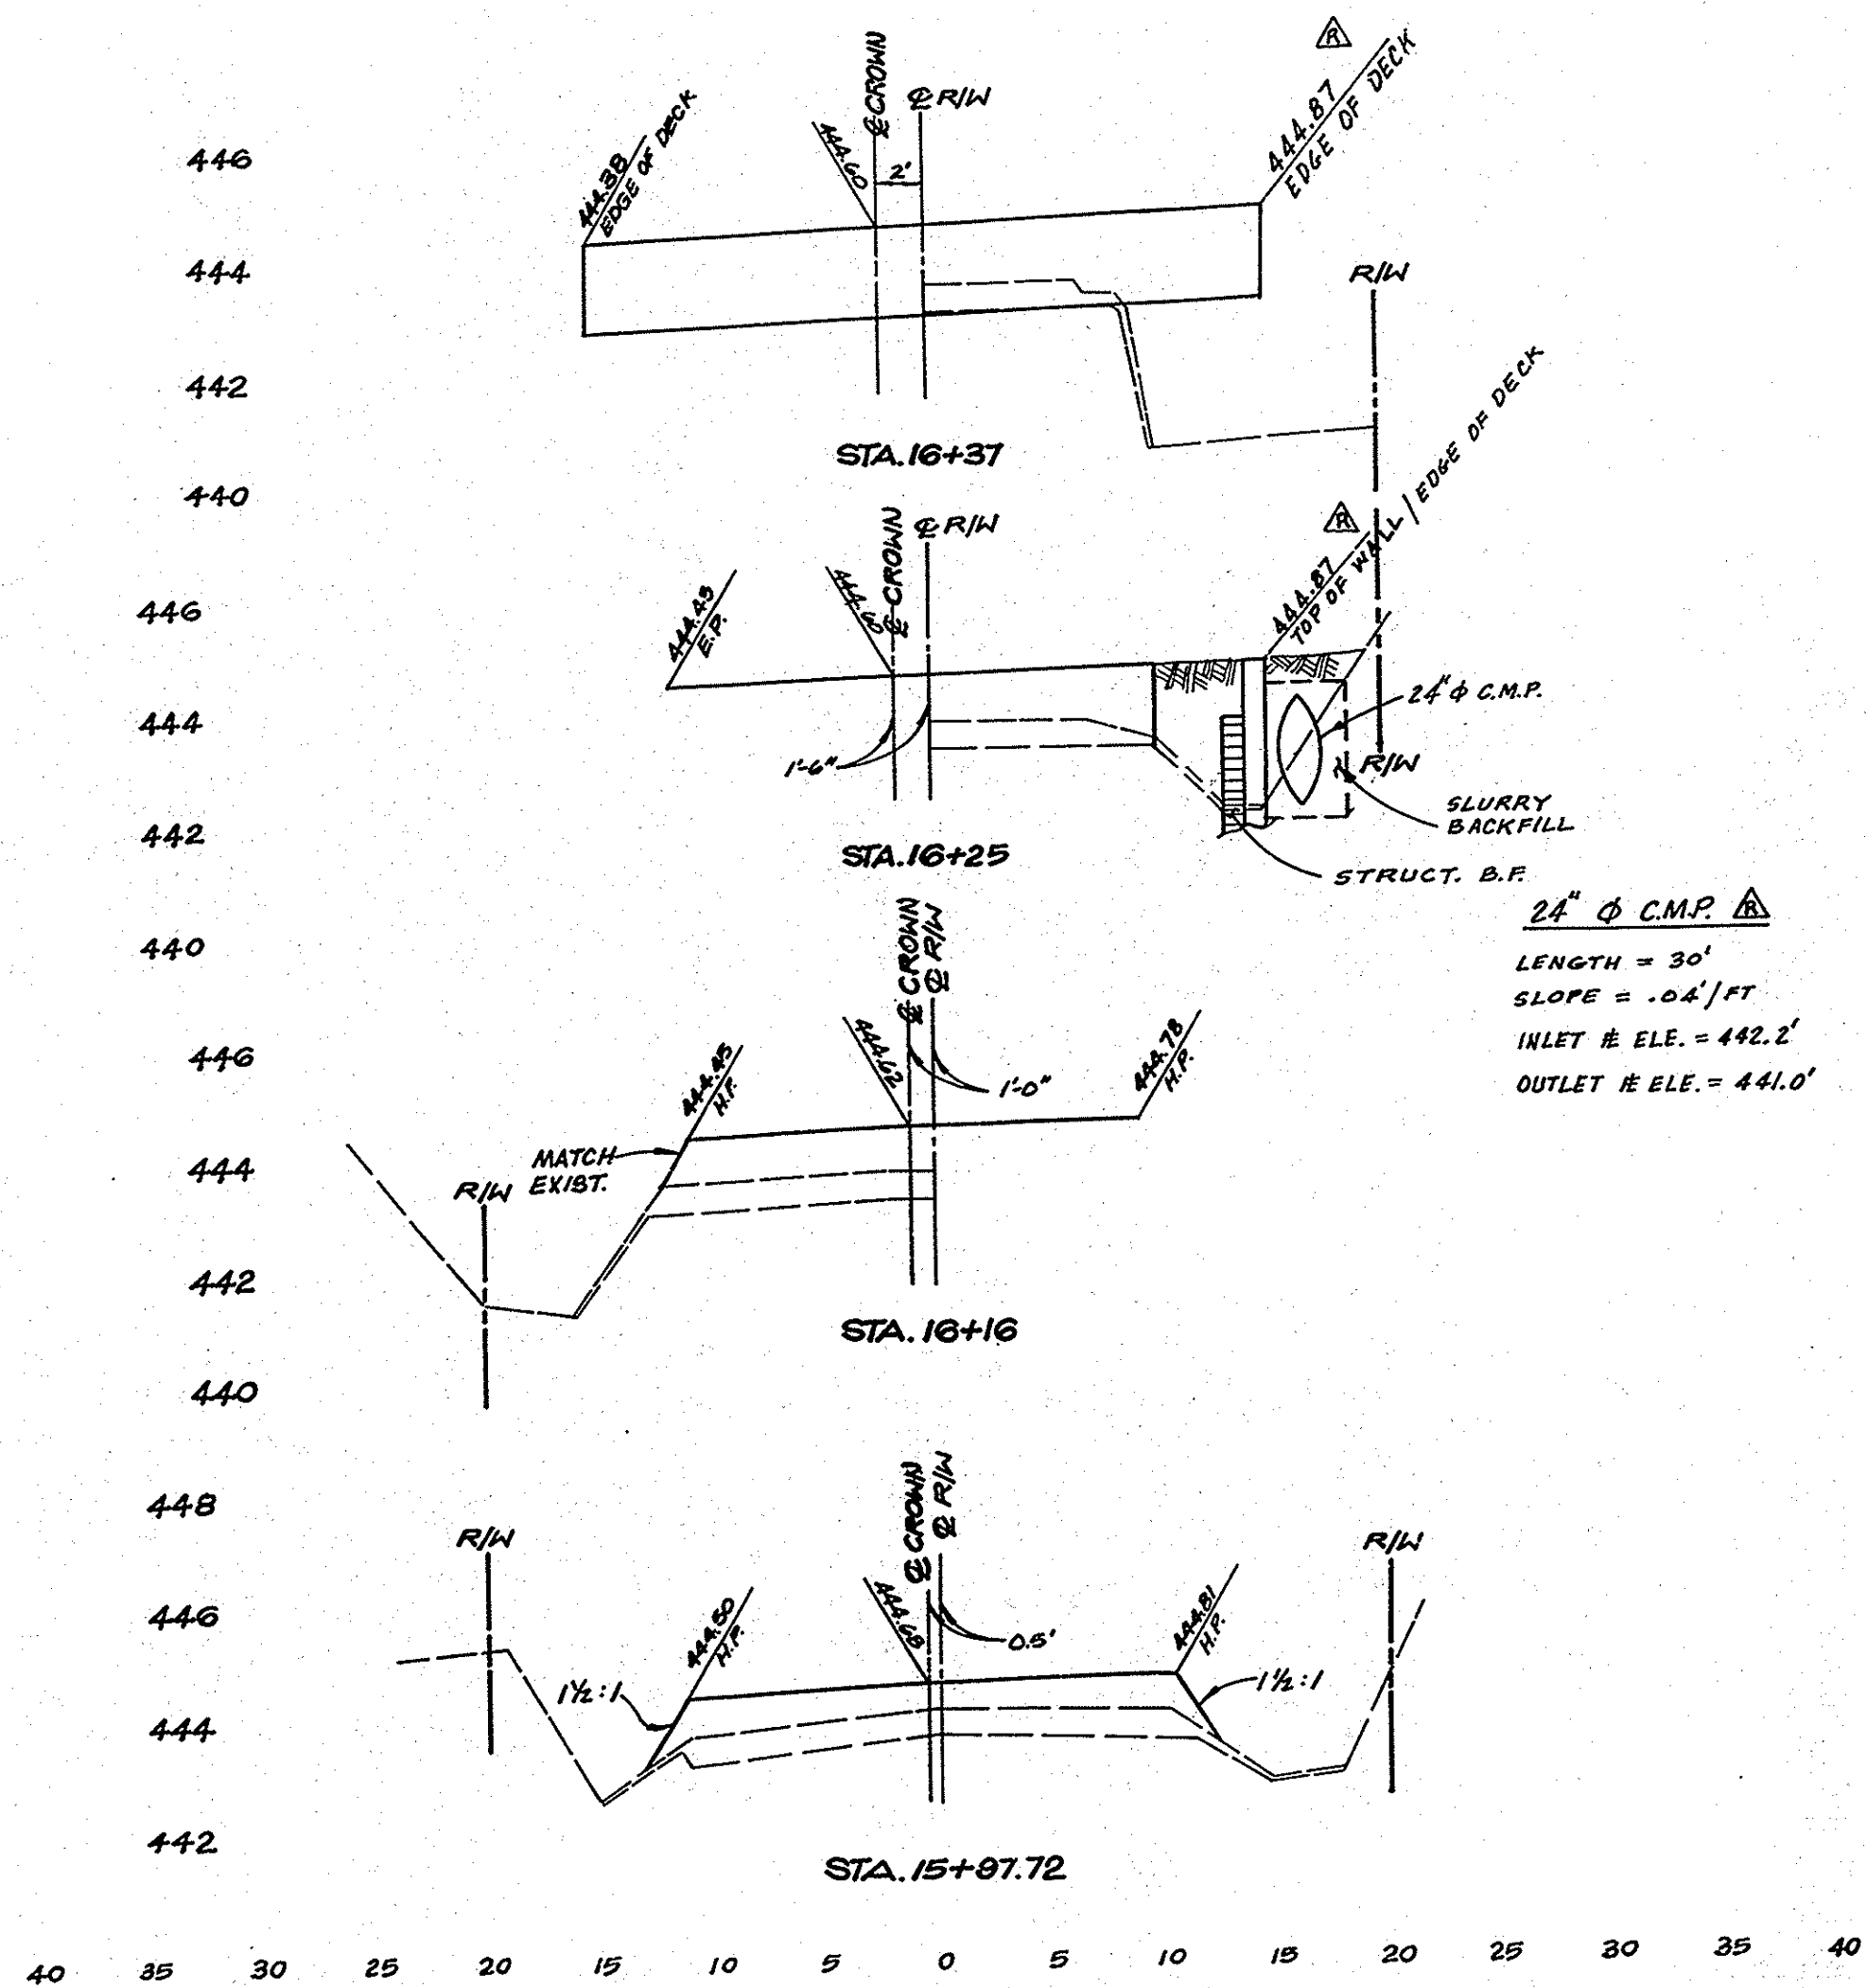


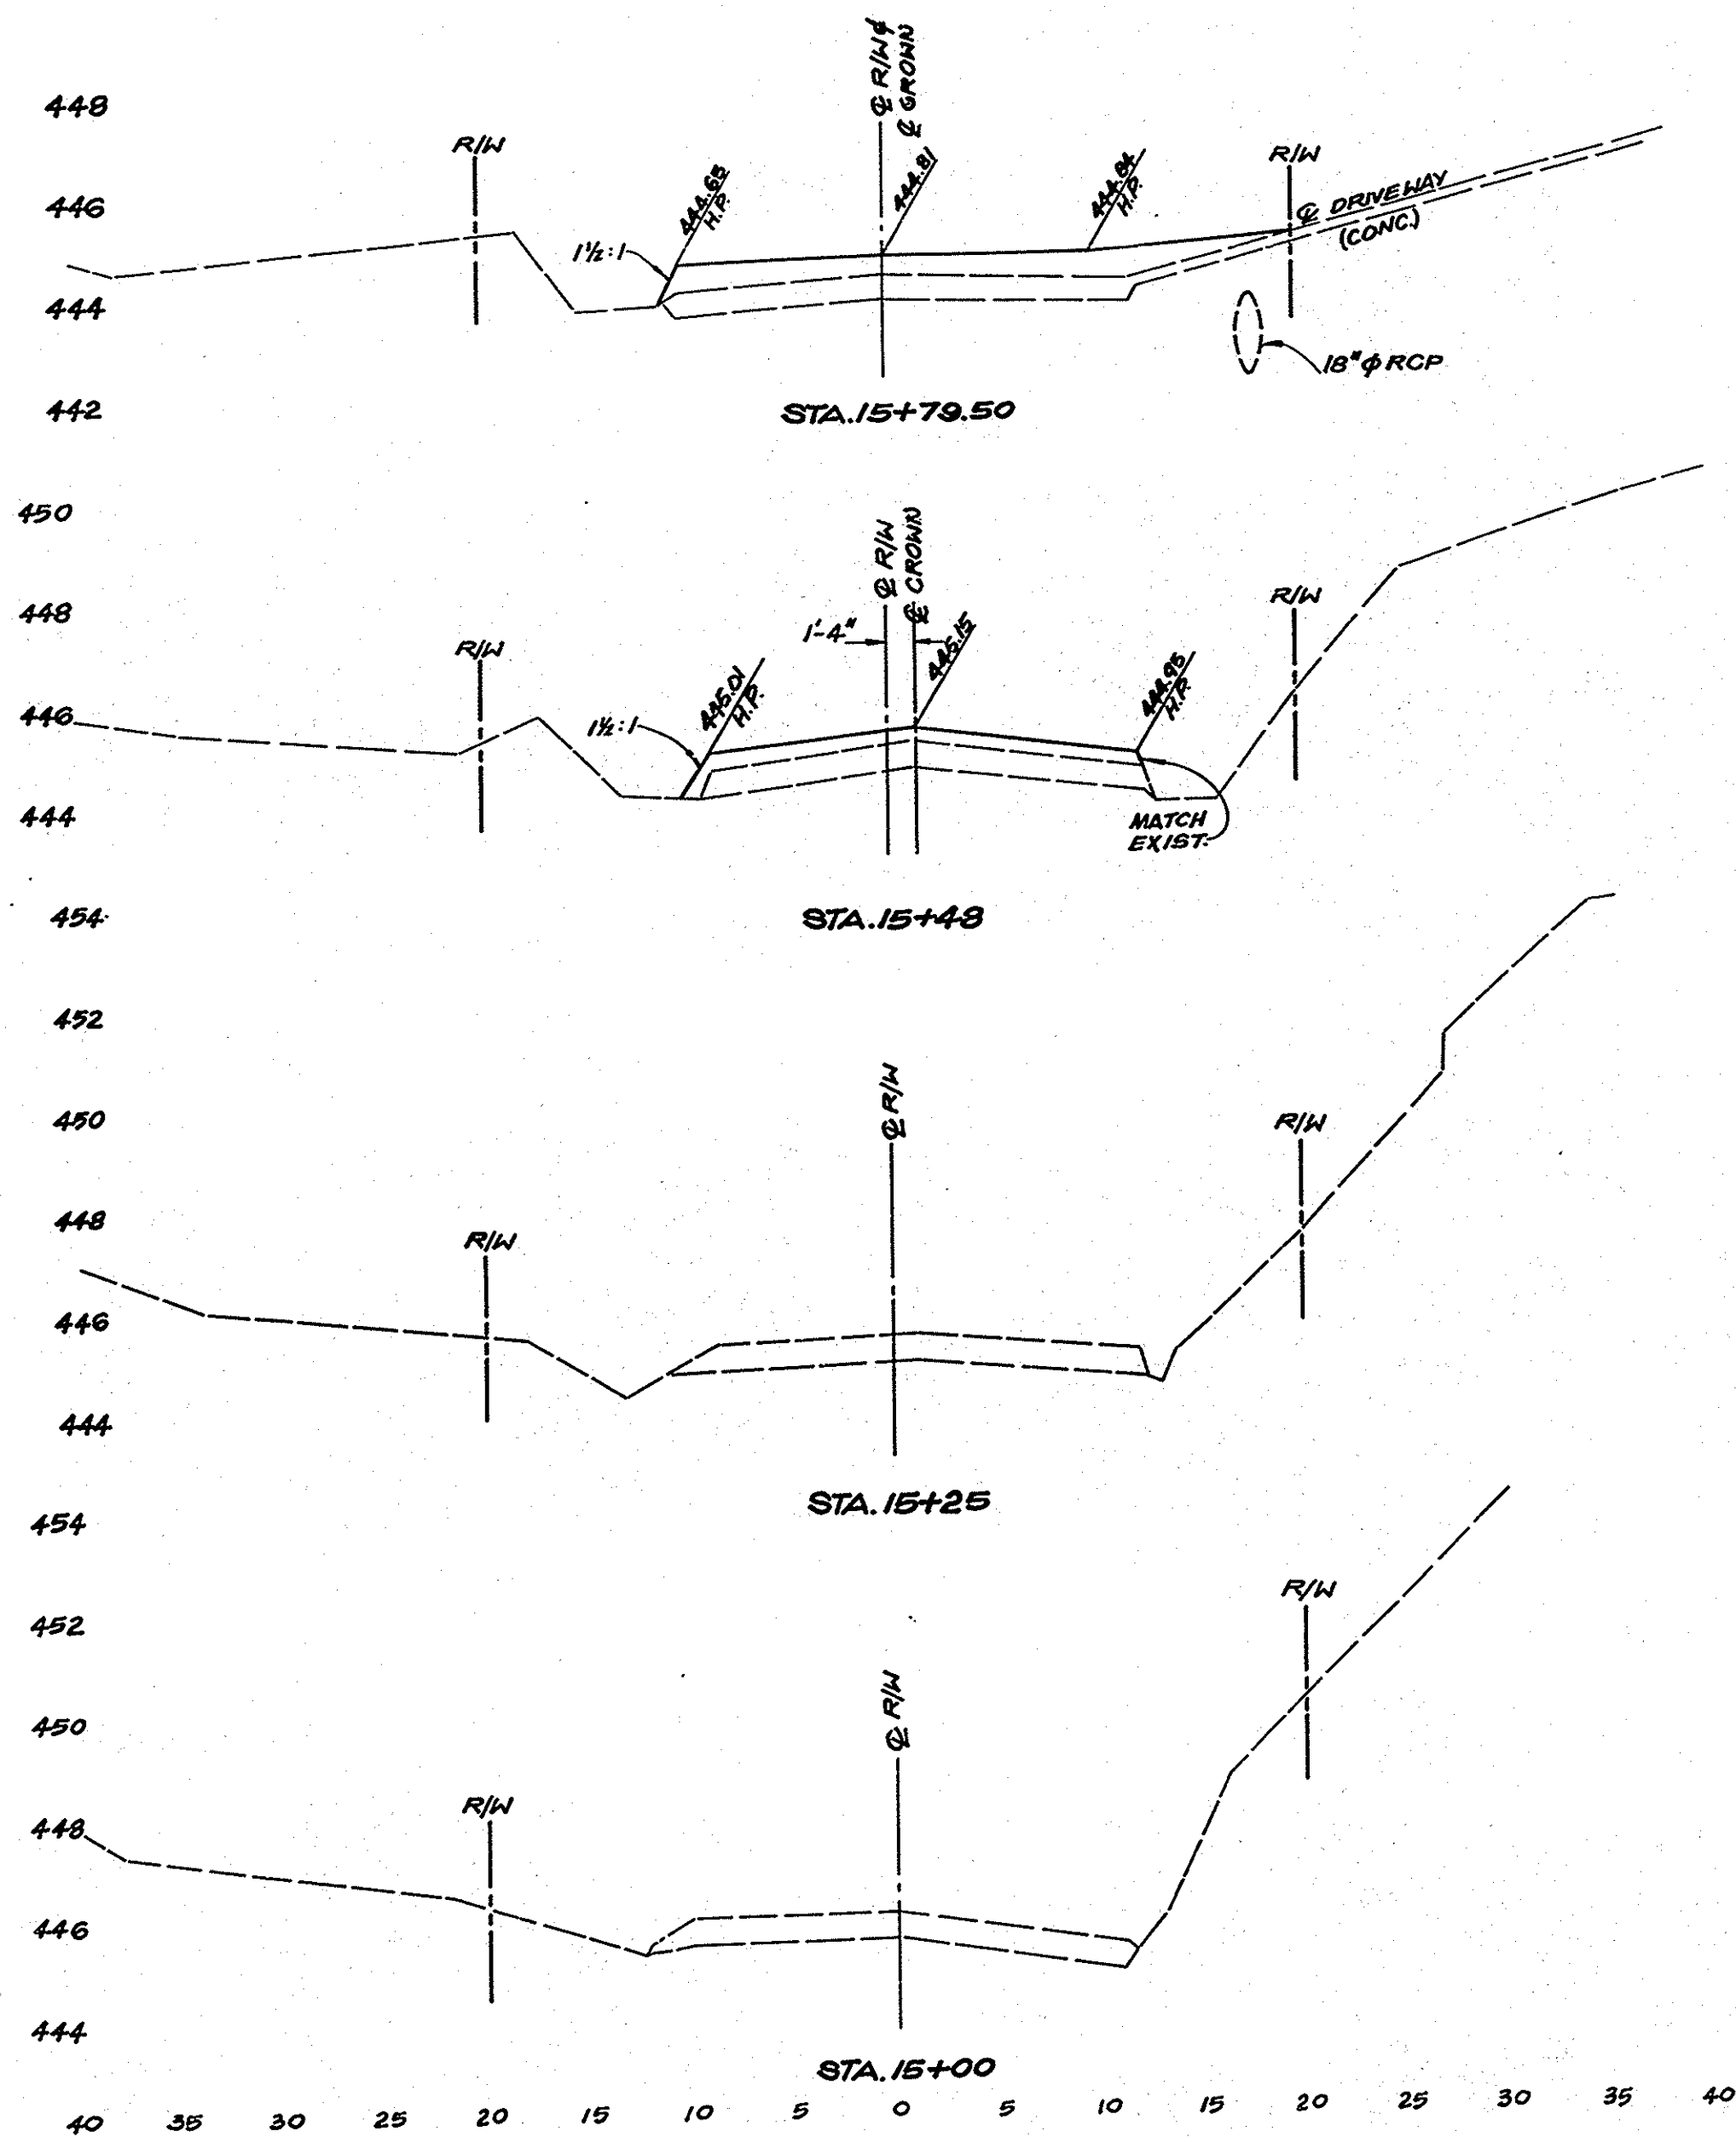

SCALE

H: 1"=5'
V: 1"=2'

MEADS AVENUE BRIDGE
ACROSS
HANDY CREEK CHANNEL (E08S06)

X - SECTIONS

STA. 15+00 TO STA. 16+37

7-2285 BRIDGE WIDENING

R.C.E. 30829

J.D.S.
HP,TCR V.P.R.

7

OF 9

D.R. 12 L150071