
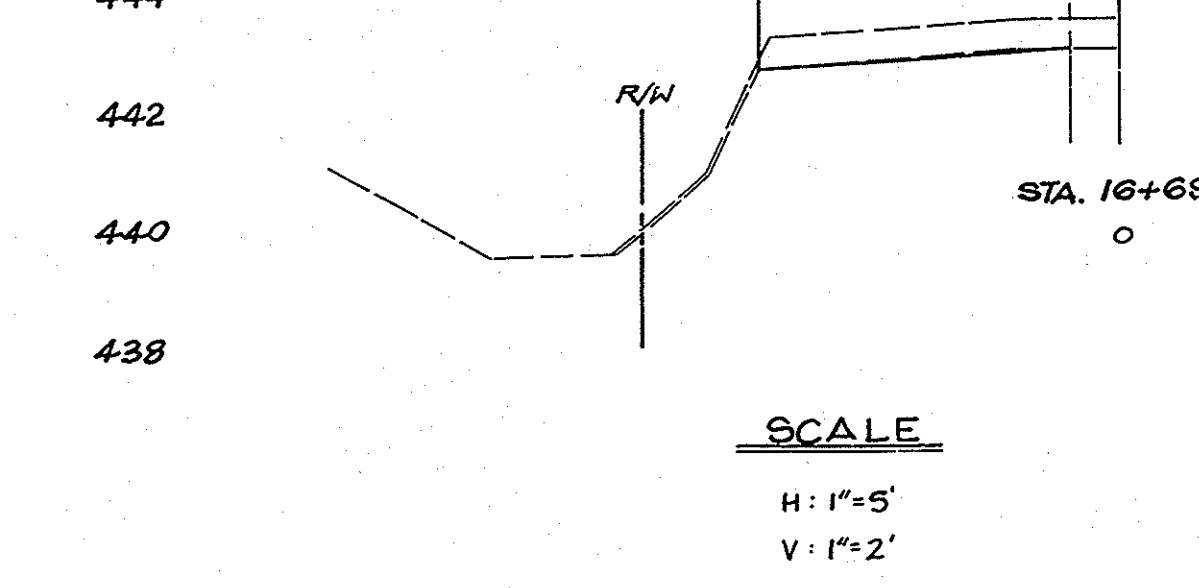
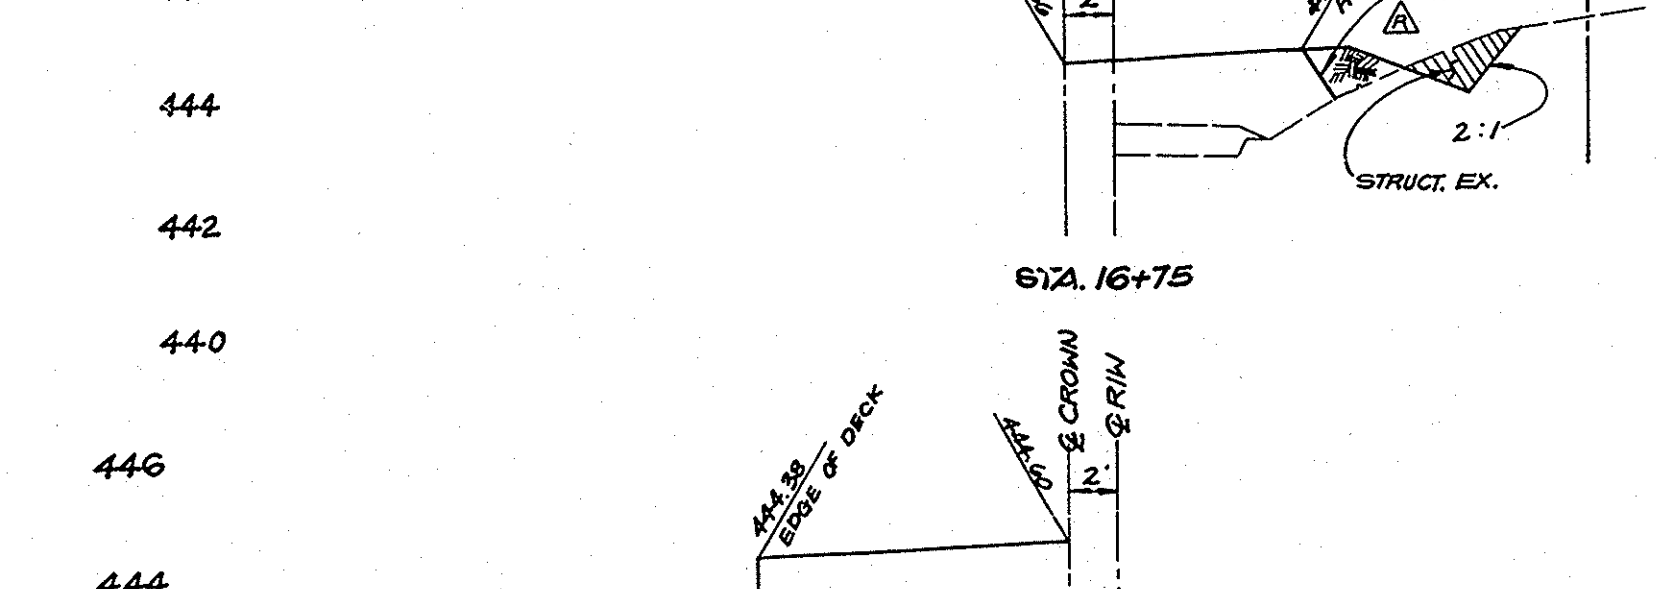
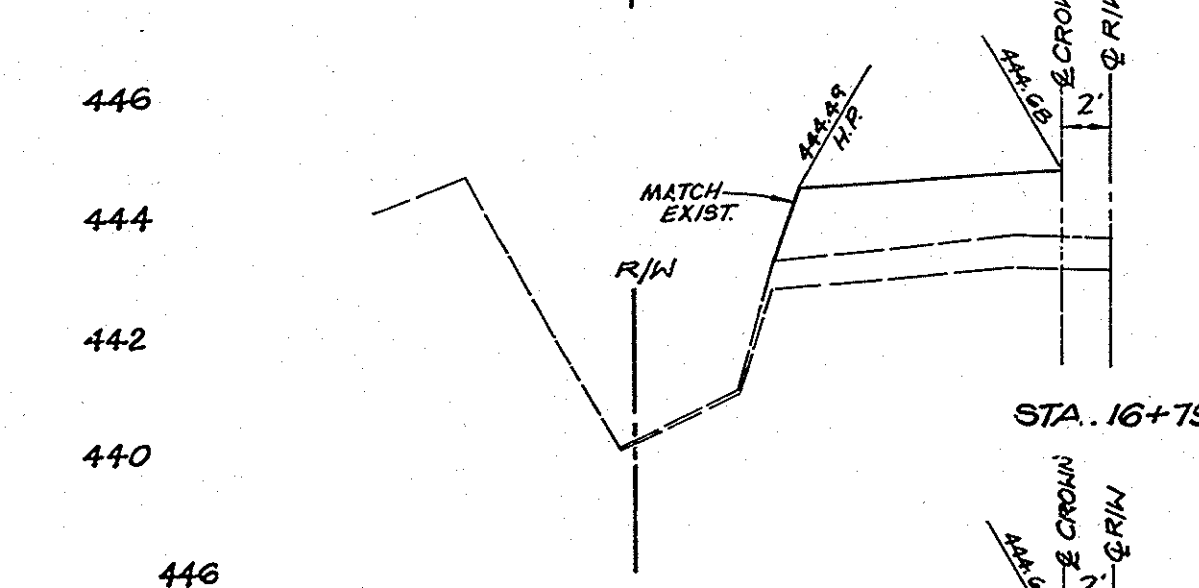
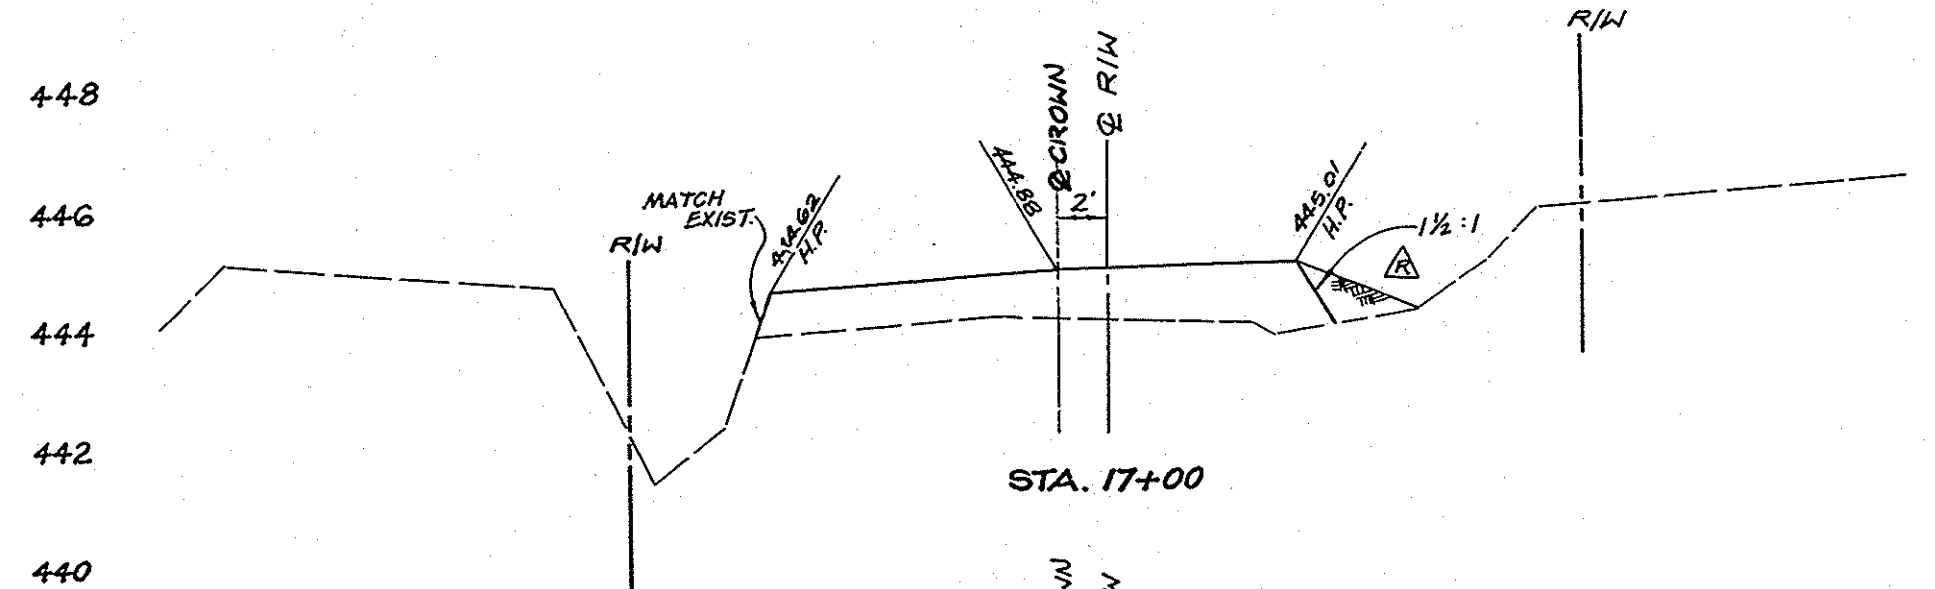
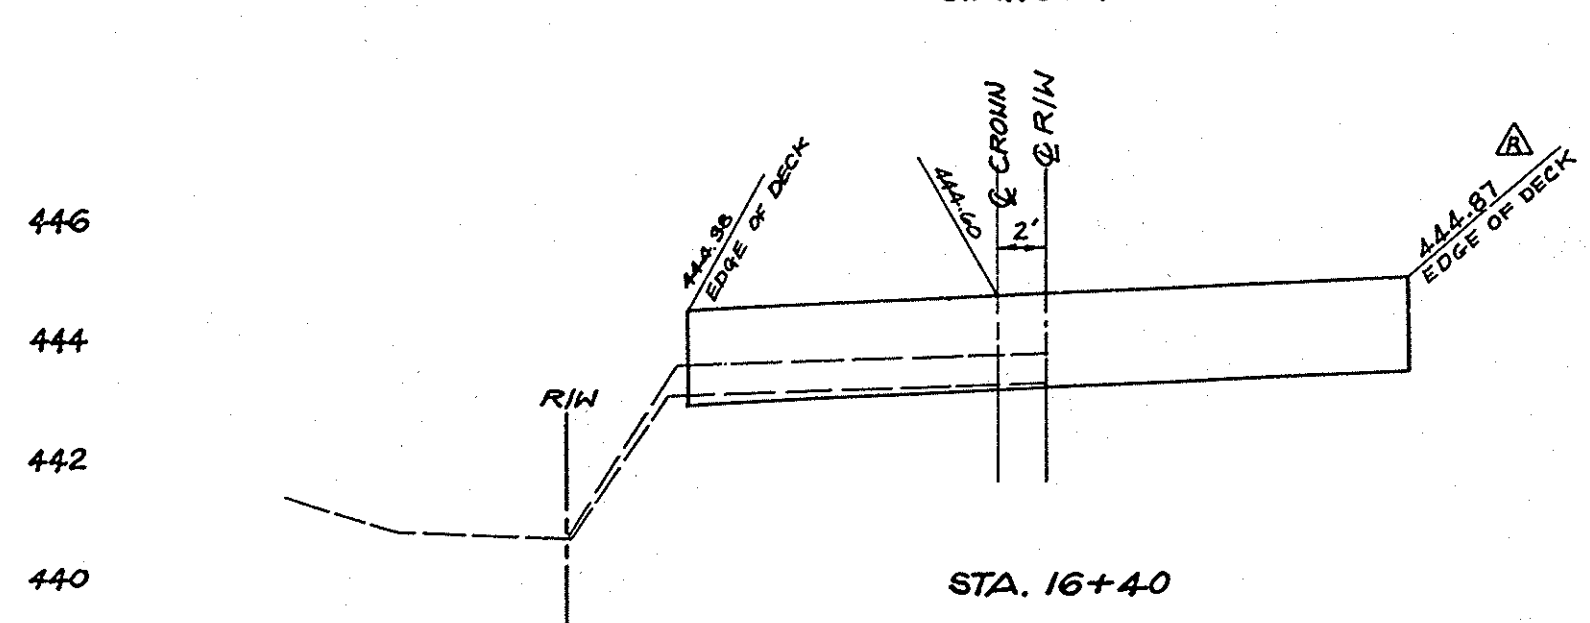
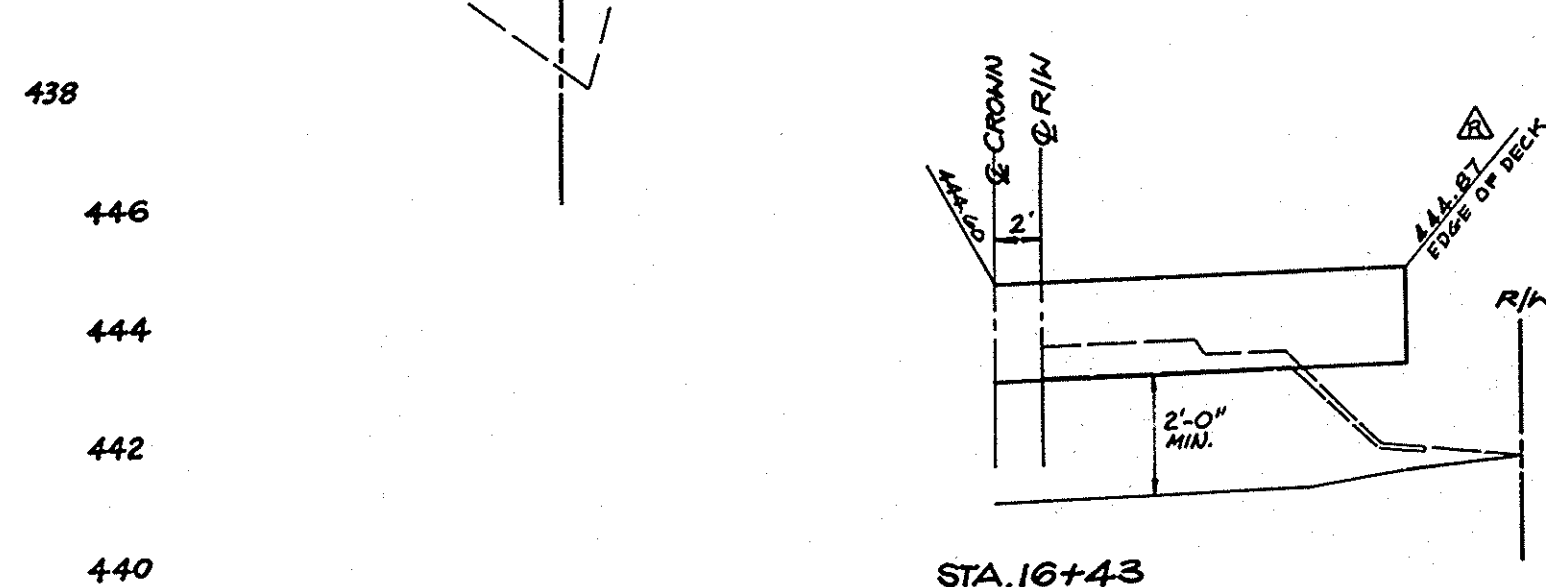
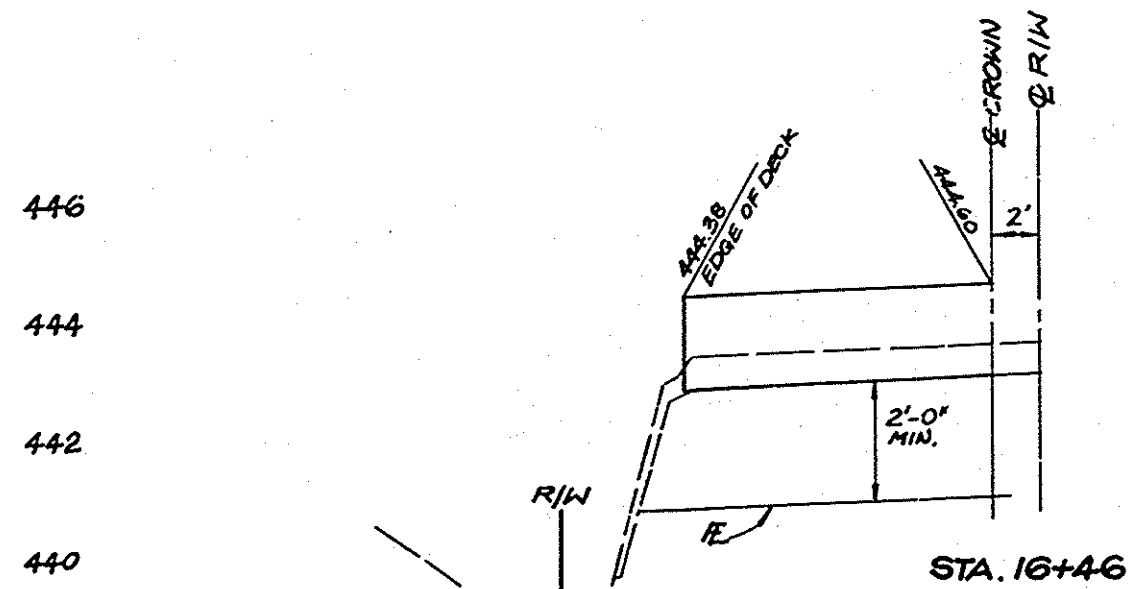


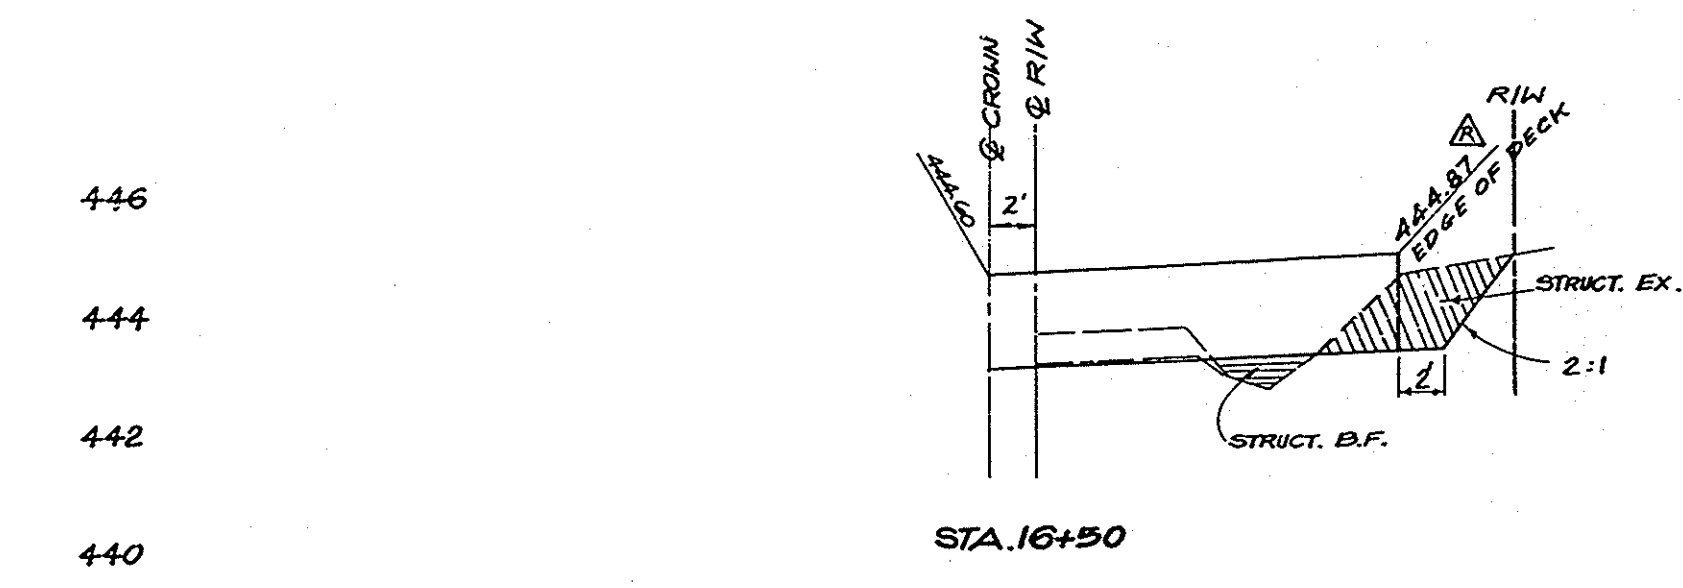

SCALE
H: 1"=5'
V: 1"=2'

MEADS AVENUE BRIDGE
ACROSS
HANDY CREEK CHANNEL (E08S06)

X - SECTIONS
STA. 16+40 TO STA. 17+00

1-22-85 BRIDGE WIDENING

J.D.S.
H.P., T.C.R. V.P.R.

R.C.E. 30829

8
OF 9

DR. 12 (1500)