


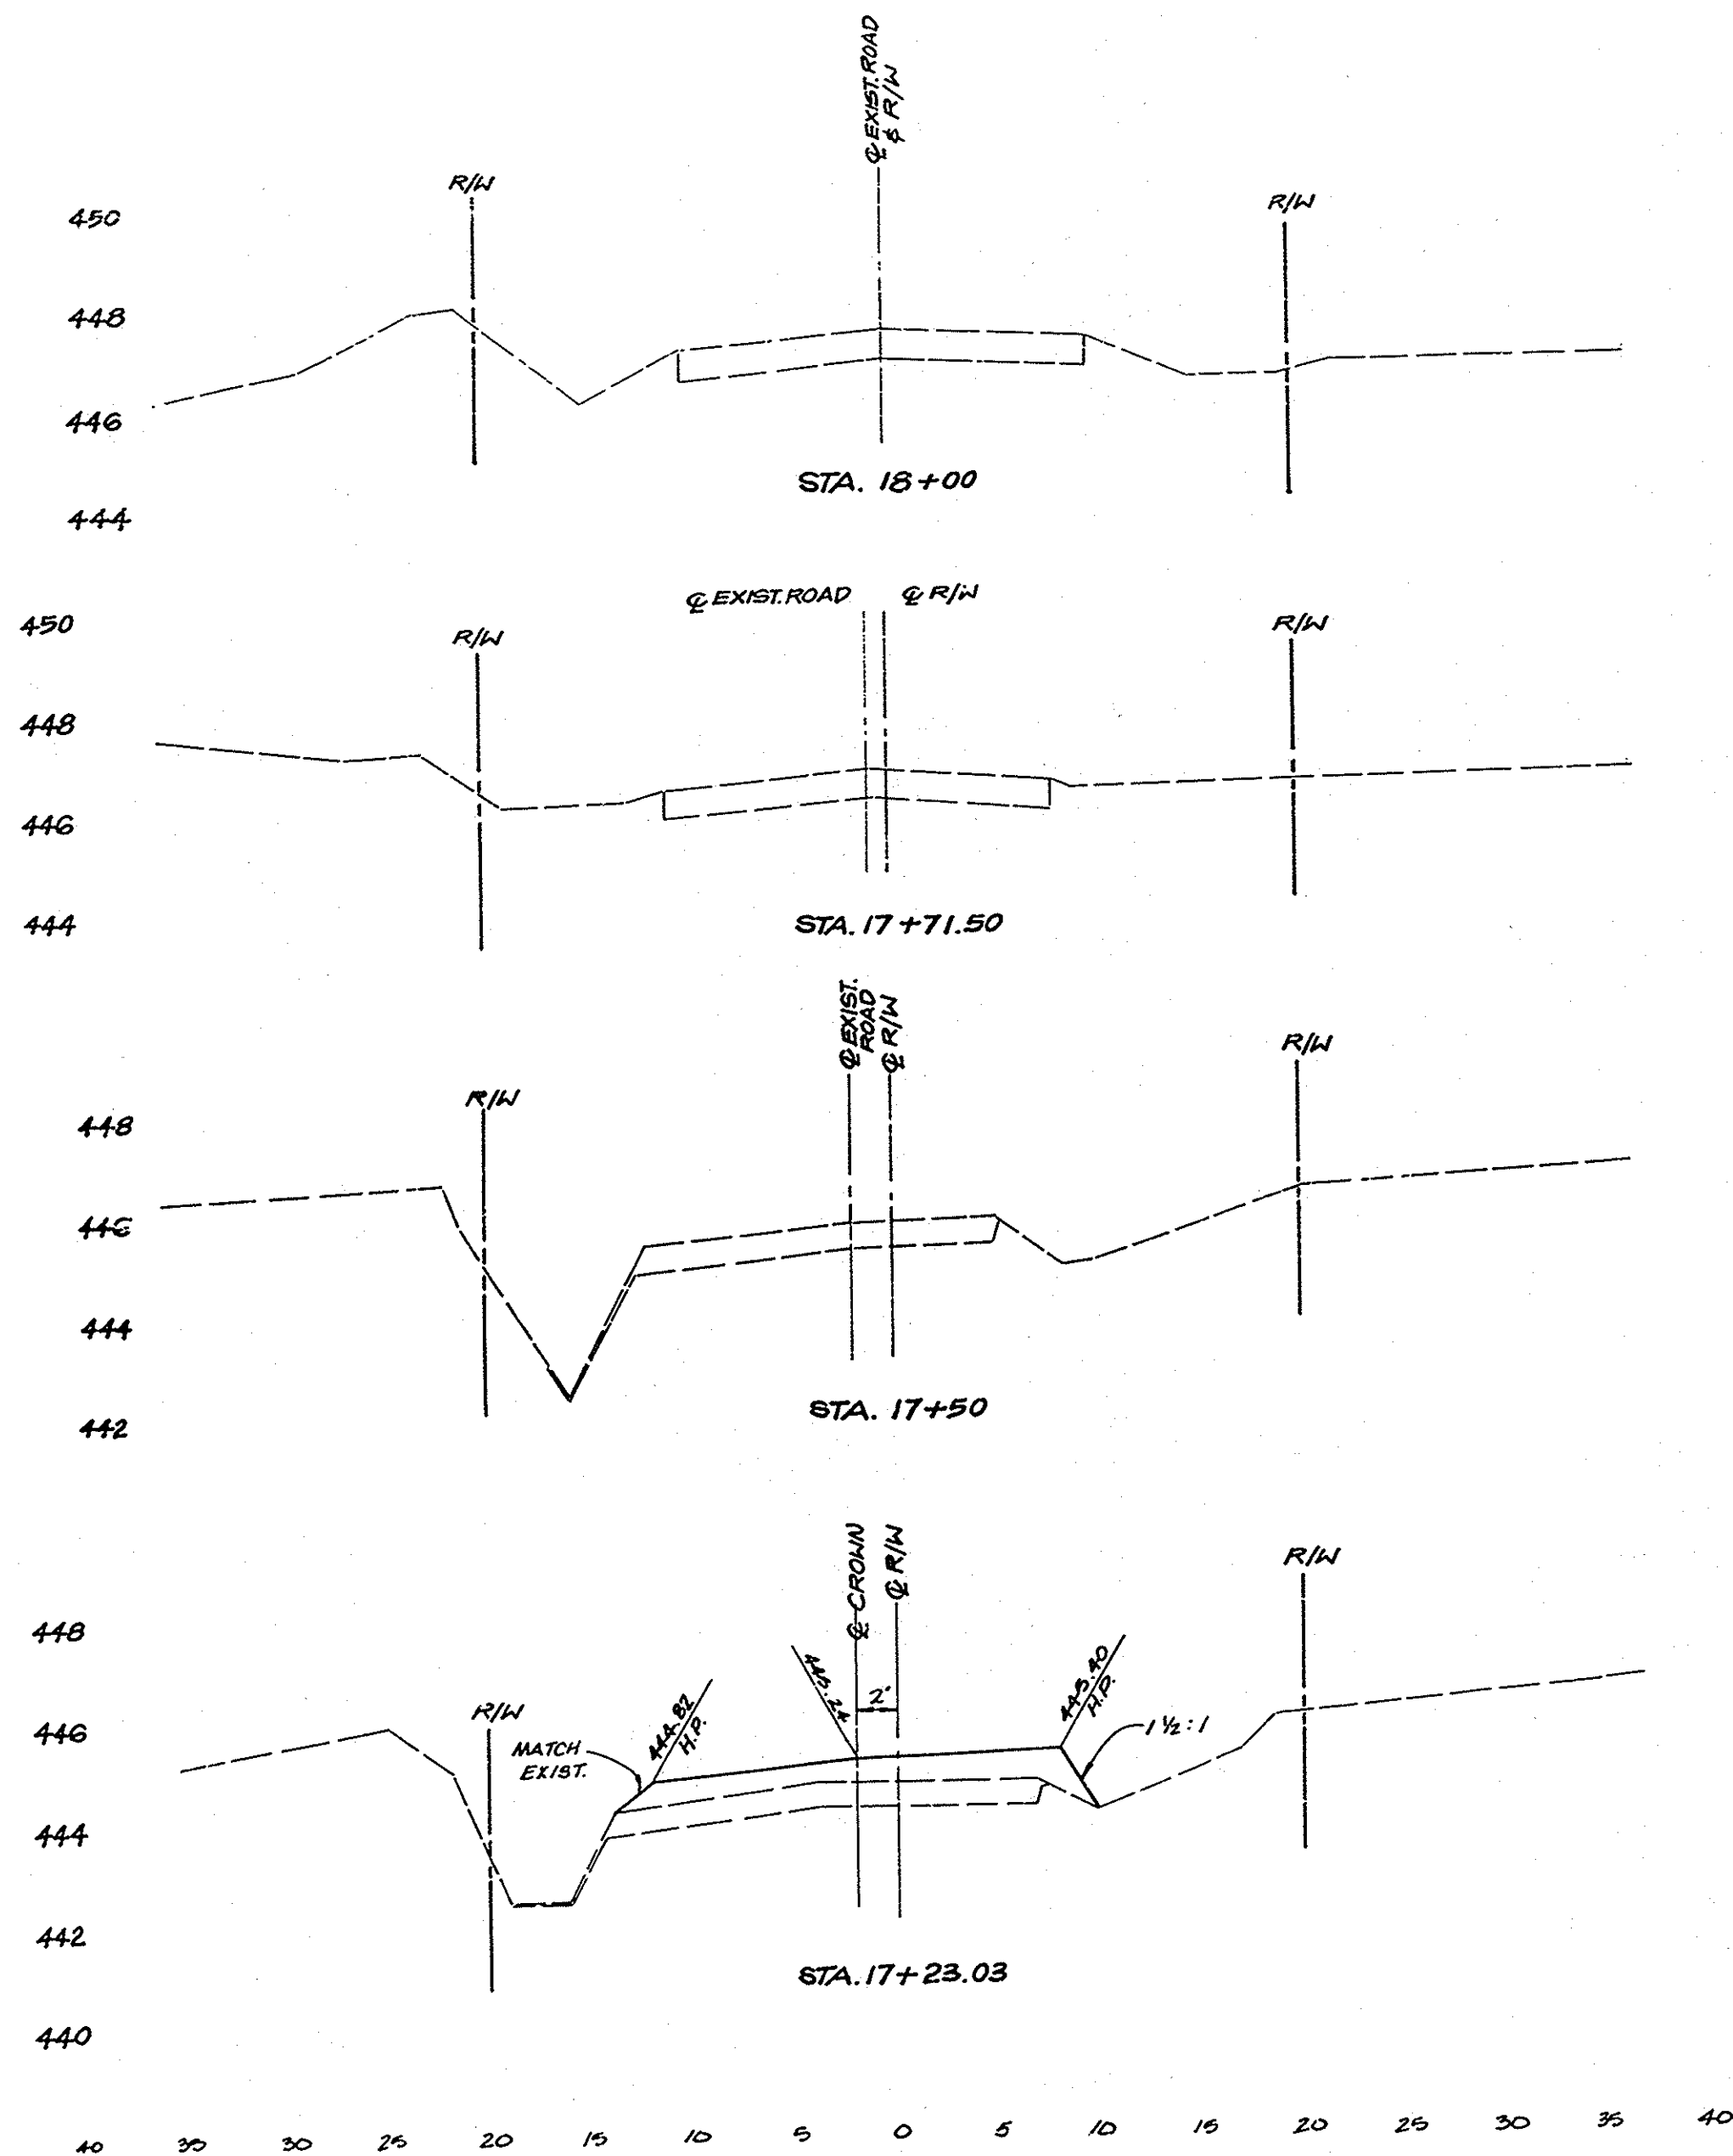

SCALE  
H: 1" = 5'  
V: 1" = 2'

MEADS AVENUE BRIDGE  
ACROSS  
HANDY CREEK CHANNEL (E08S06)  
**X - SECTION**  
STA. 17+23.03 TO STA. 18+00

J.D.S.  
HP, TCR.

V.P.R.

R.C.E. 30829

9  
OF 9

DR. 12 (15007)