



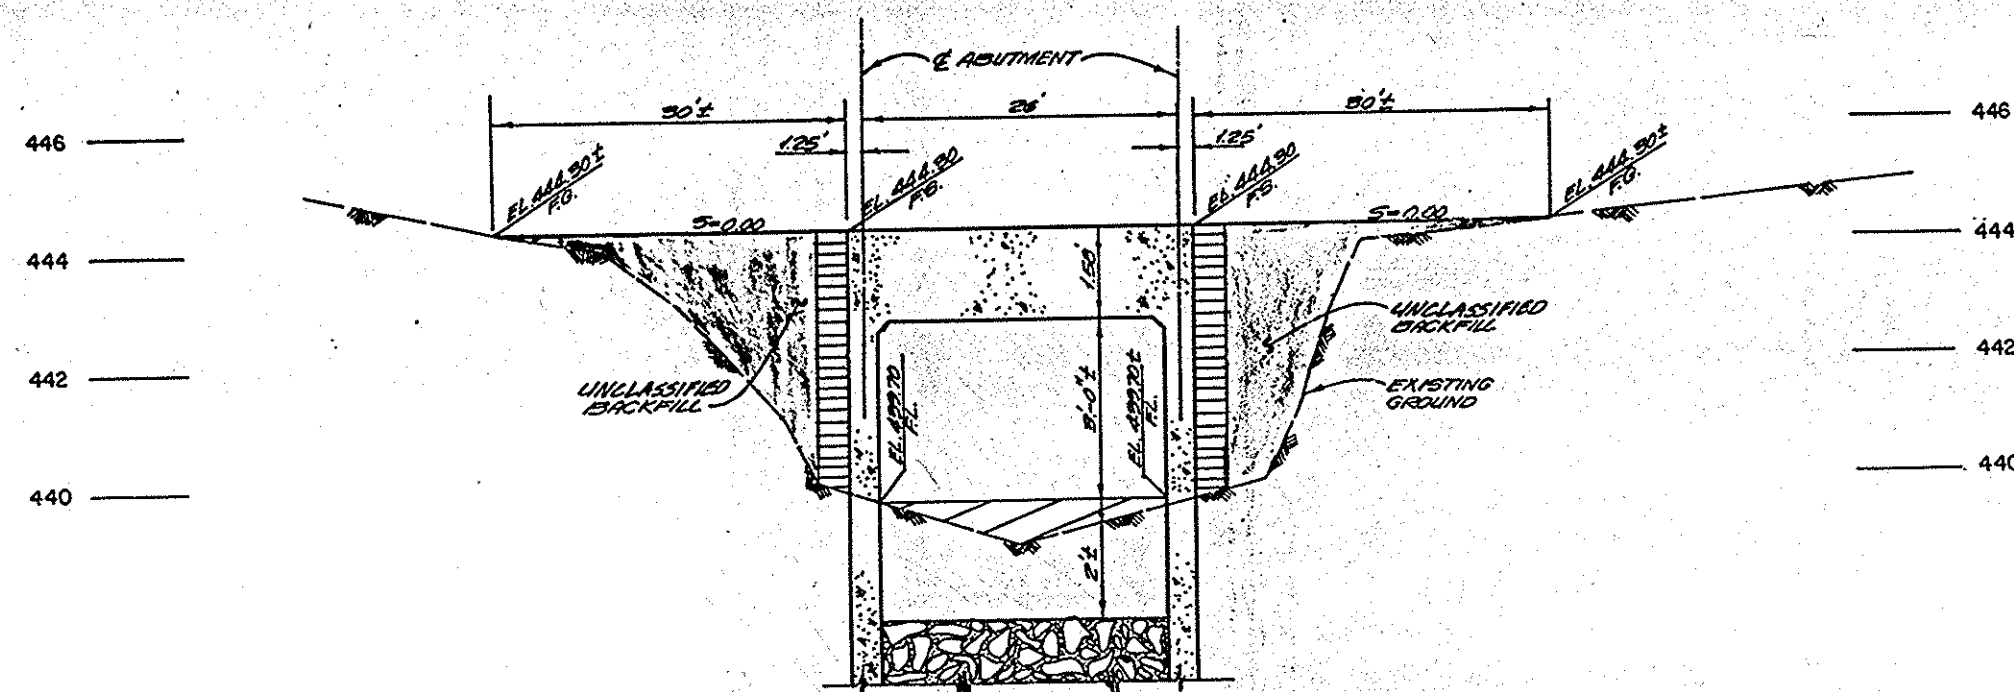

SECTION A-A
SCALE: HORIZ. 1" = 10'
VERT. 1" = 2'

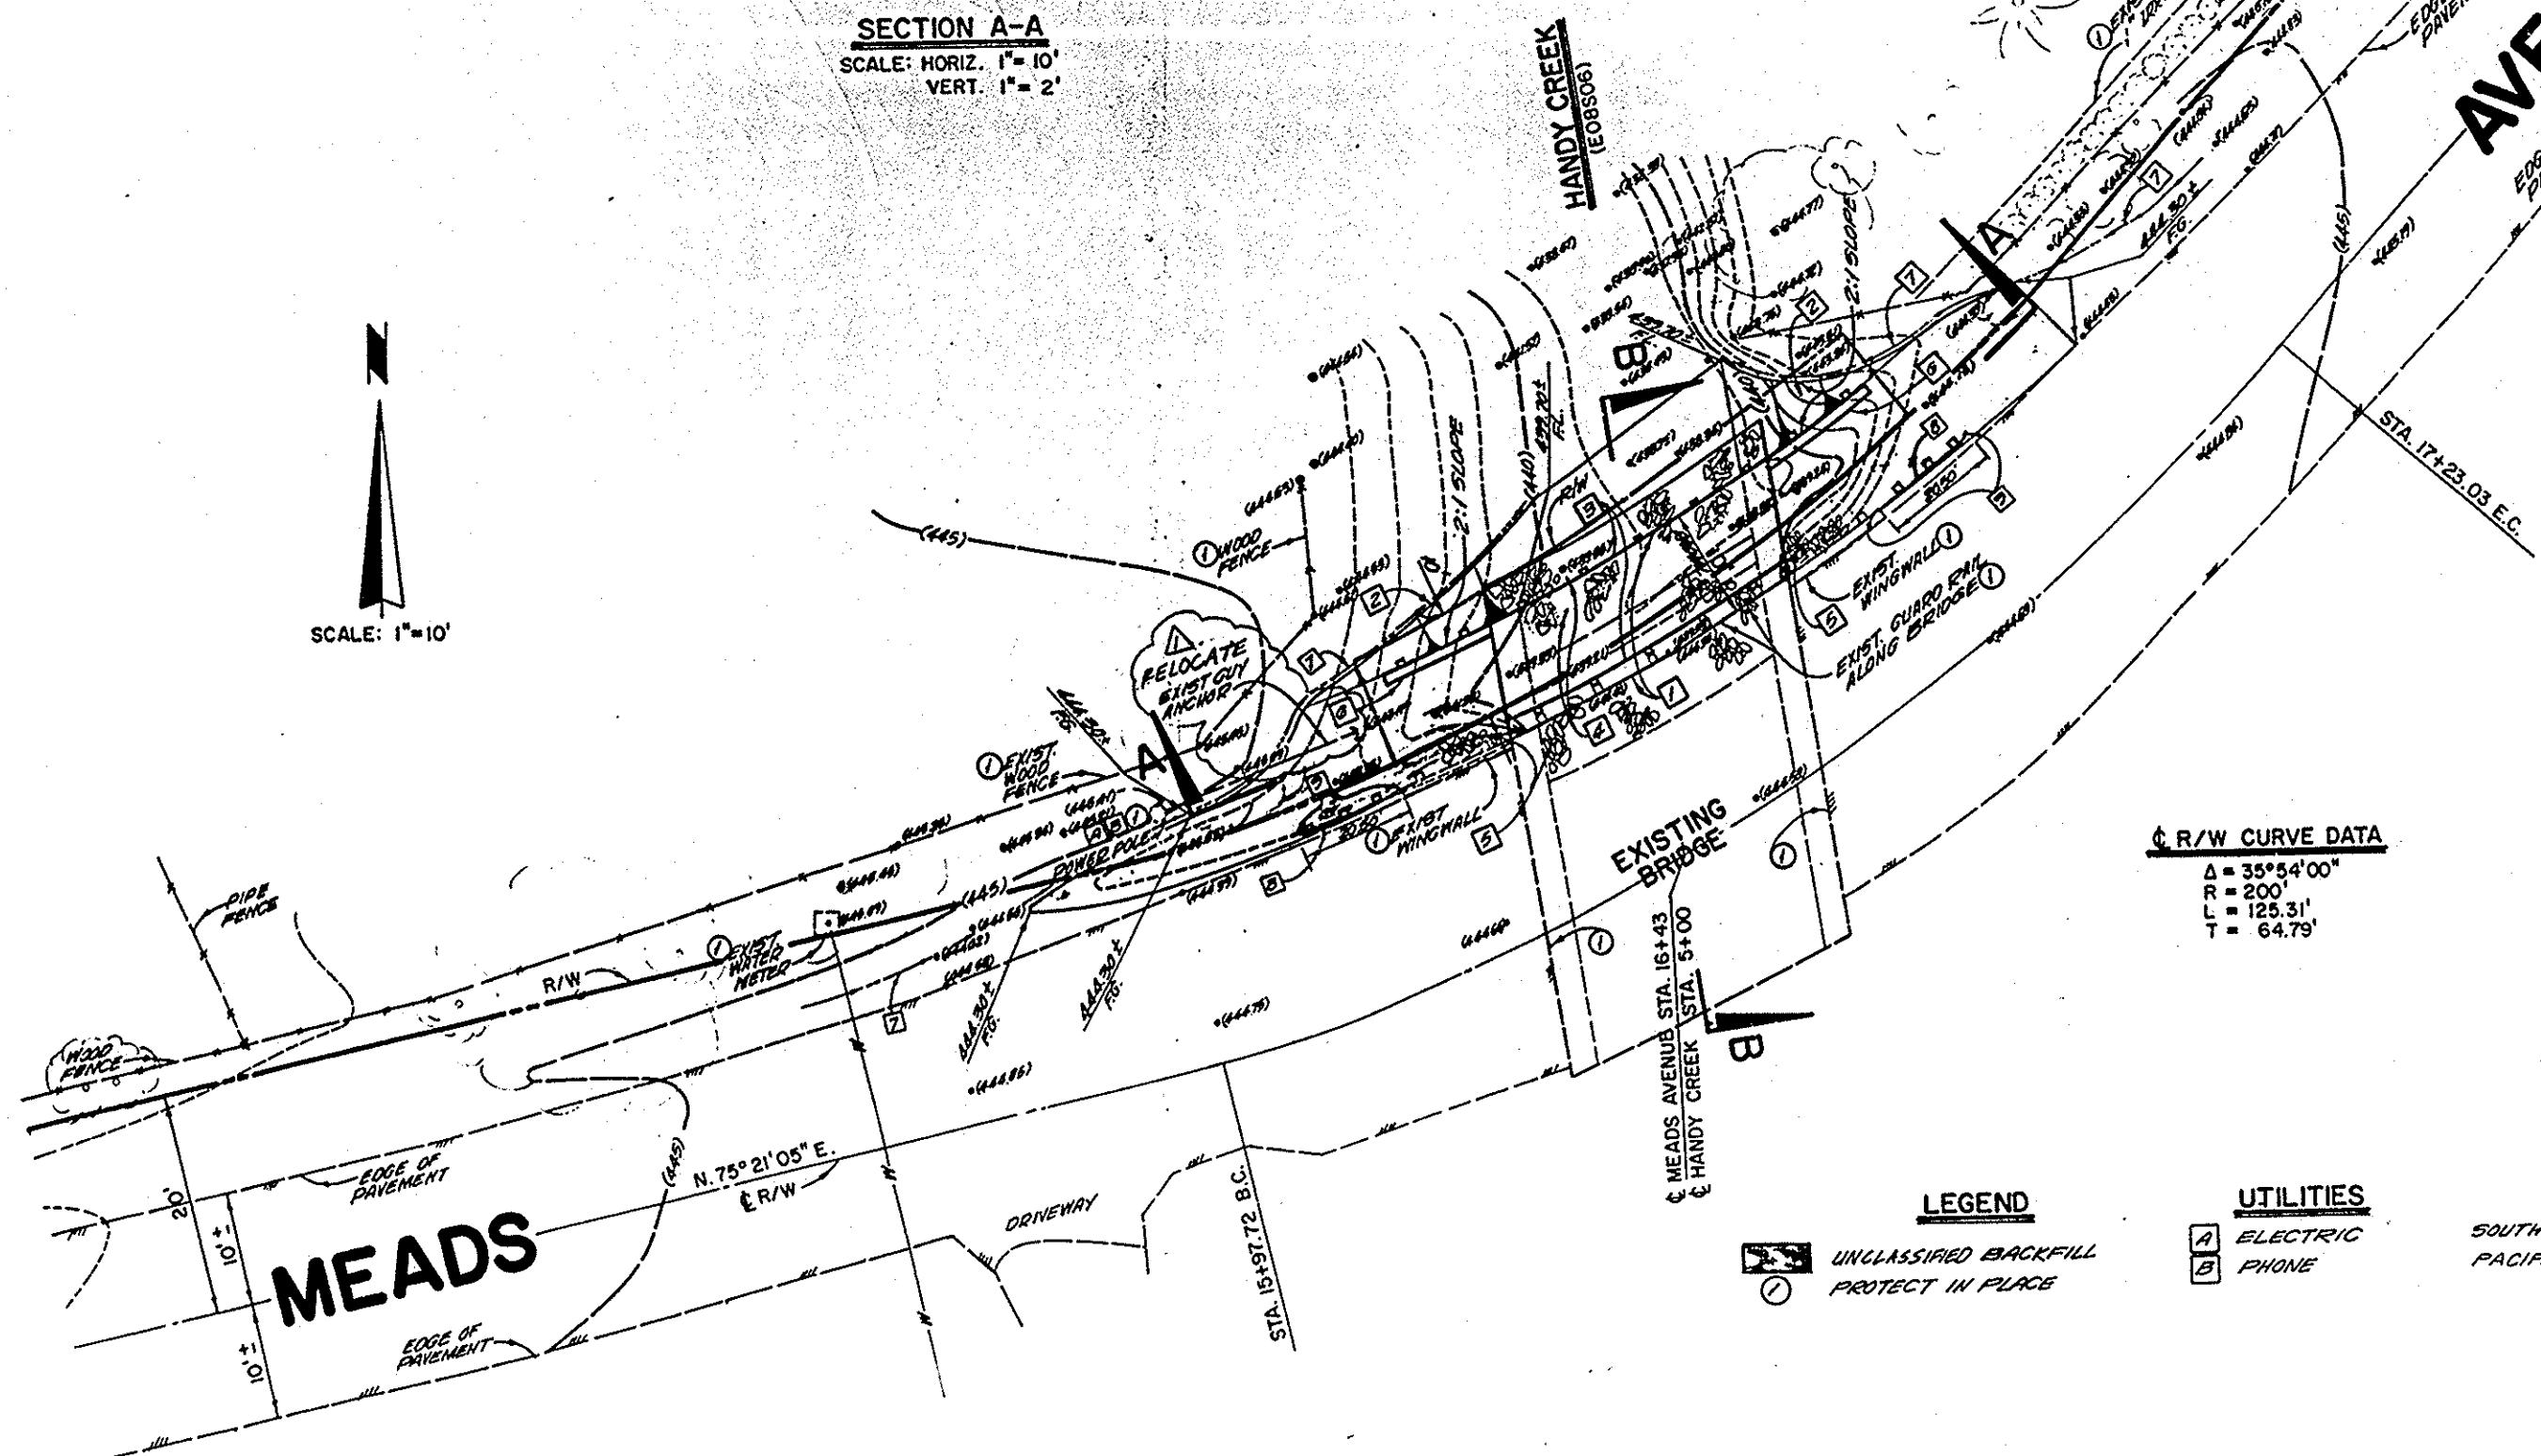

R/W CURVE DATA
Δ = 35° 54' 00"
R = 200'
L = 125.31'
T = 64.79'


LEGEND
UNCLASSIFIED BACKFILL
PROTECT IN PLACE

UTILITIES
ELECTRIC
PHONE

OWNERS
SOUTHERN CALIFORNIA EDISON CO.
PACIFIC BELL TELEPHONE CO.

CONSTRUCTION NOTES

1. CONSTRUCT R.C. SLAB BRIDGE EXTENSION PER PLAN, SECTION A-A AND DETAILS PER SHEETS 2 TO 6.
2. CONSTRUCT SIDE SLOPE PER PLAN AND SECTION A-A.
3. INSTALL RAILING PER DETAILS SHEET 6.
4. CONSTRUCT GRADE STABILIZER PER DETAIL SHEET 6.
5. REMOVE EXISTING RIP-RAP INTERFERING WITH CONSTRUCTION.
6. CONSTRUCT WINGWALLS PER DETAILS SHEET 5.
7. GRADE TO DRAIN.
8. CONSTRUCT METAL BEAM GUARD RAILING PER E.M.A. STD. 1403.
9. REMOVE, SALVAGE AND RELOCATE EXIST. TERMINAL SECTION AS SHOWN.

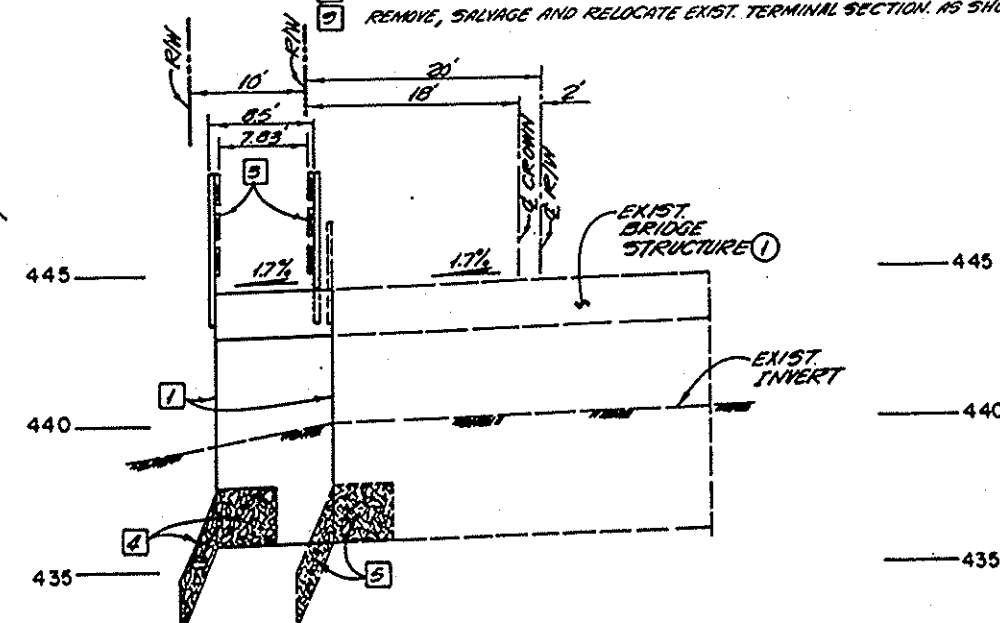

SECTION B-B
SCALE: HORIZ. 1" = 10'
VERT. 1" = 4'

1 1/2 0 1 2 3
4 INCHES ON ORIGINAL DRAWING

ORANGE COUNTY ENVIRONMENTAL MANAGEMENT AGENCY	
MEADS AVENUE BRIDGE	
AT HANDY CREEK CHANNEL (E08S06)	
PLAN	
DATE: 8/12/91	AS-BUILT R.S.
DESIGNED: J.J.B.	SCALE: AS SHOWN
DRAWN: G.T.C.	CHECKED: J.J.B.
DATE: FEB. 1993	DATE: 1-27-93
REVISIONS	DATE
1	2
2	6

DP11. 15594