



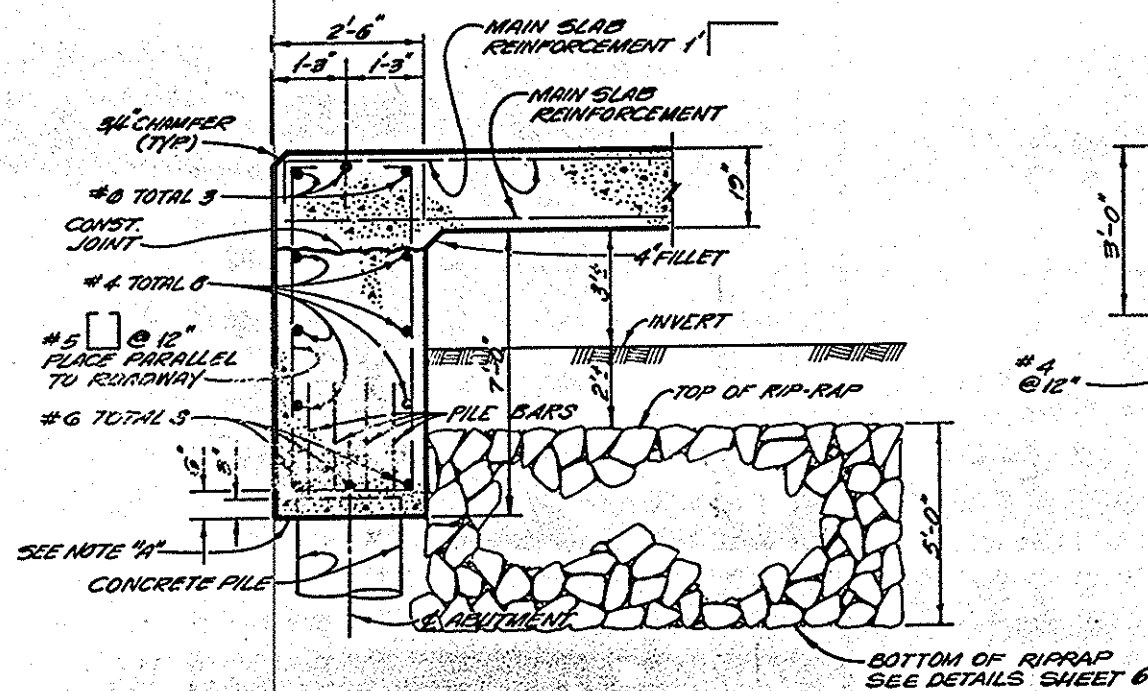


ABUTMENT SECTION

NOT TO SCALE

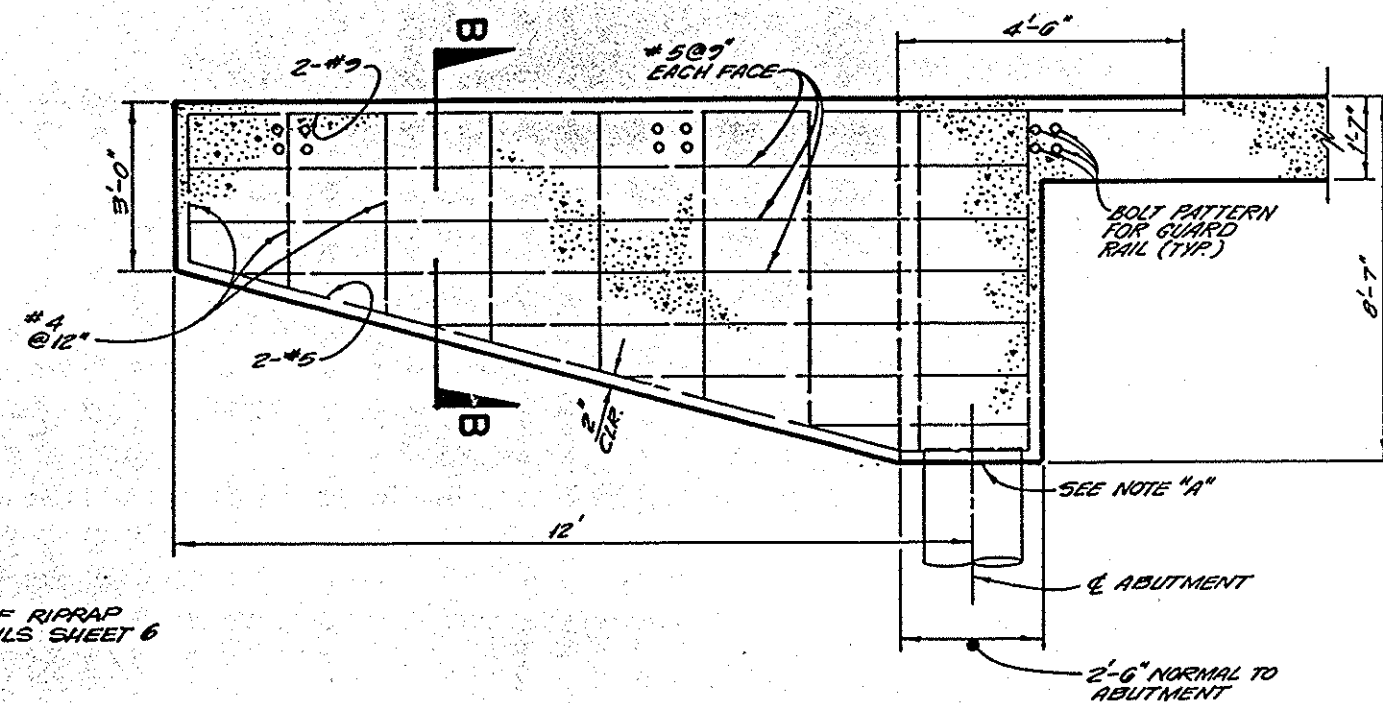

WINGWALL ELEVATION

NOT TO SCALE

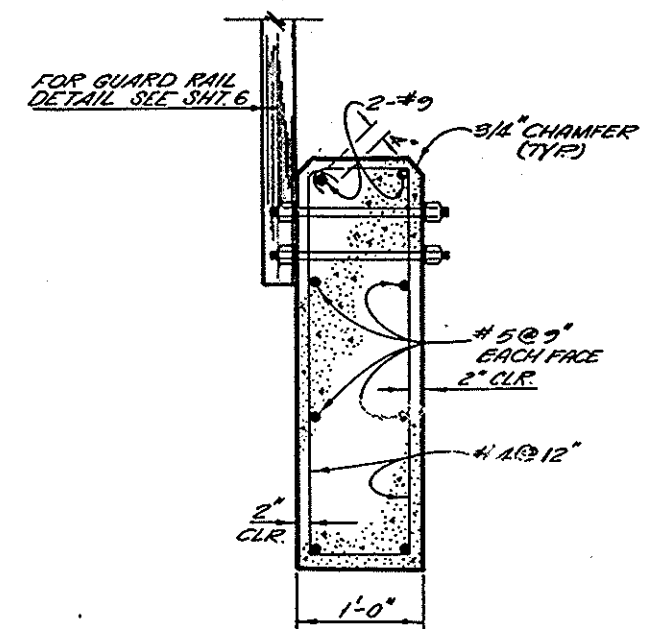


SECTION B-B

NOT TO SCALE

NOTES:


REINFORCEMENT EXTENDING INTO FOOTING SHALL BE HOOKED AS REQUIRED TO PROVIDE CLEARANCE TO TOP OF FOOTING.
PILES SHALL BE EXTENDED IN ACCORDANCE WITH DETAILS SHOWN ON THE PROJECT PLANS.

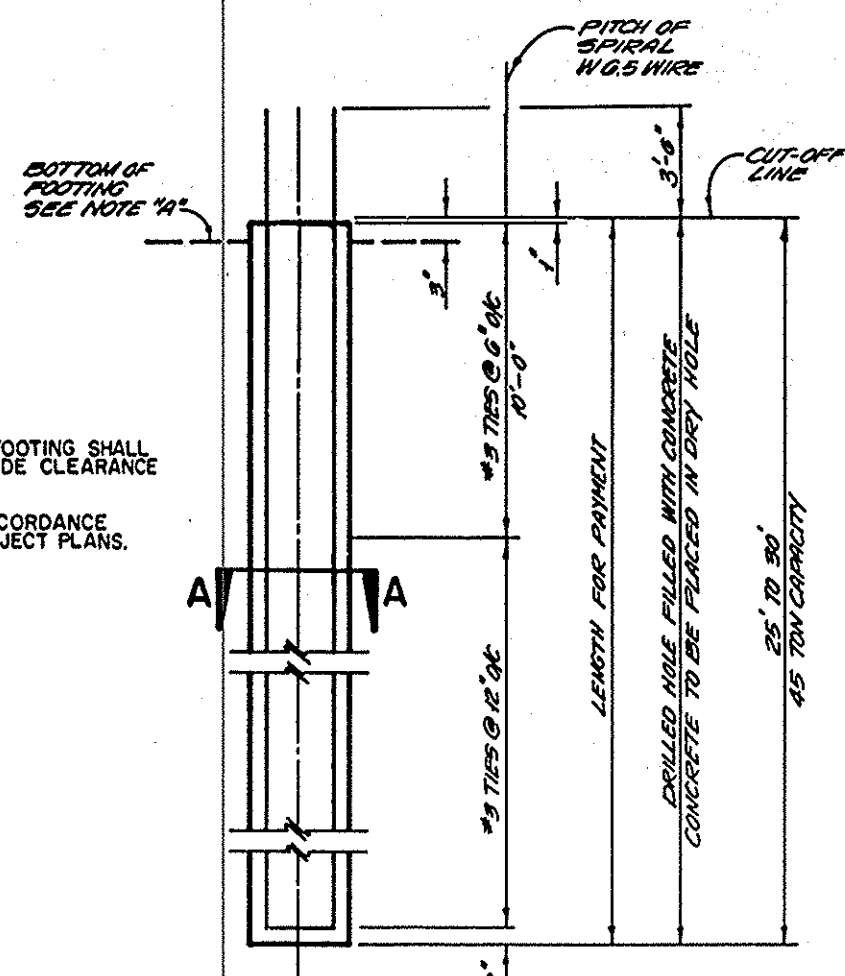


ELEVATION

16" CAST-IN-DRILLED HOLE CONCRETE PILE

NOT TO SCALE

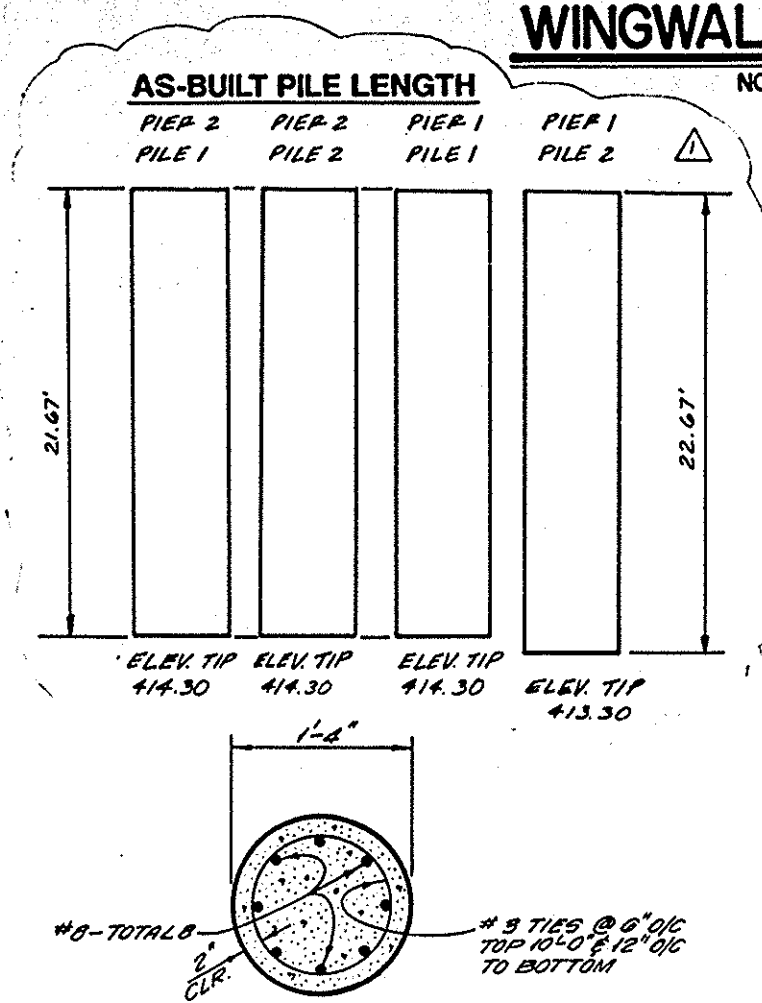

SECTION A-A

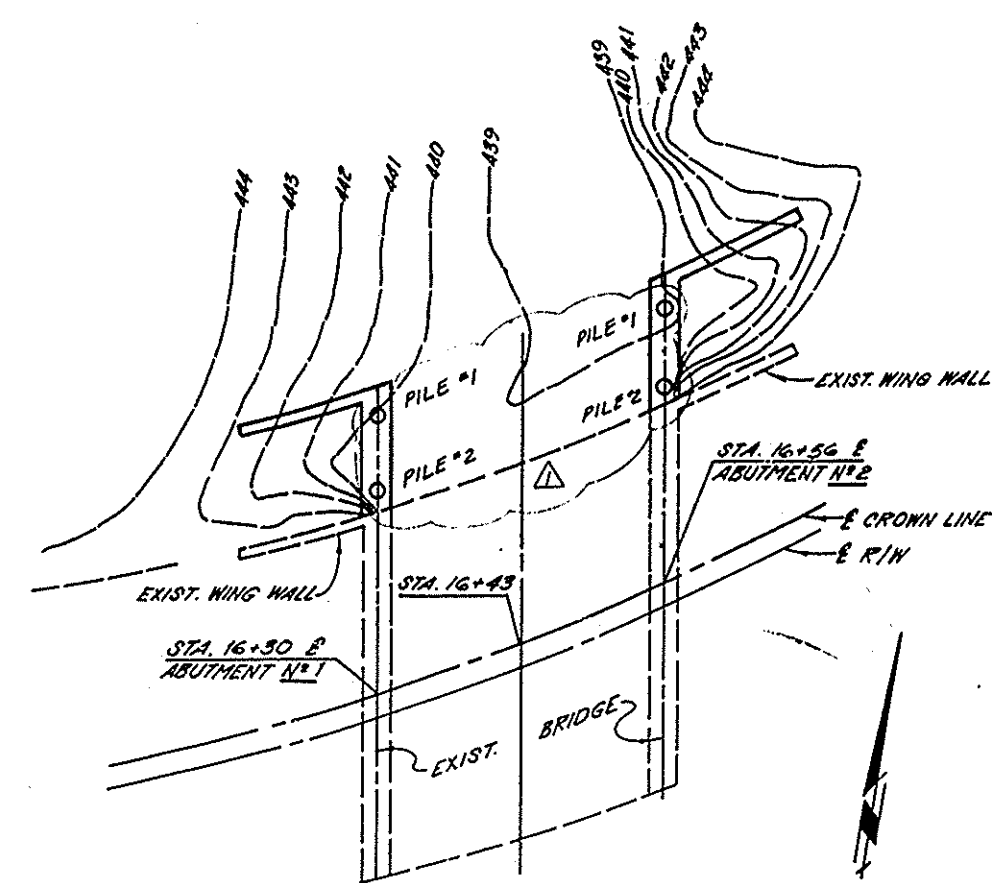

FOUNDATION PLAN

NOT TO SCALE



ORANGE COUNTY ENVIRONMENTAL MANAGEMENT AGENCY		MEADS AVENUE BRIDGE	
AT HANDY CREEK CHANNEL (E OBSO)		MISCELLANEOUS DETAILS	
DATE	DESCRIPTION	PREPARED UNDER SUPERVISION OF	DATE
DESIGNED J.J.B.	REVISIONS	SCALE	DATE
DRAWN G.T.C.	CHECKED J.J.B.	AS SHOWN	FEB. 1999
		DWG. NO.	OF
		5	6

DR:11 15594