
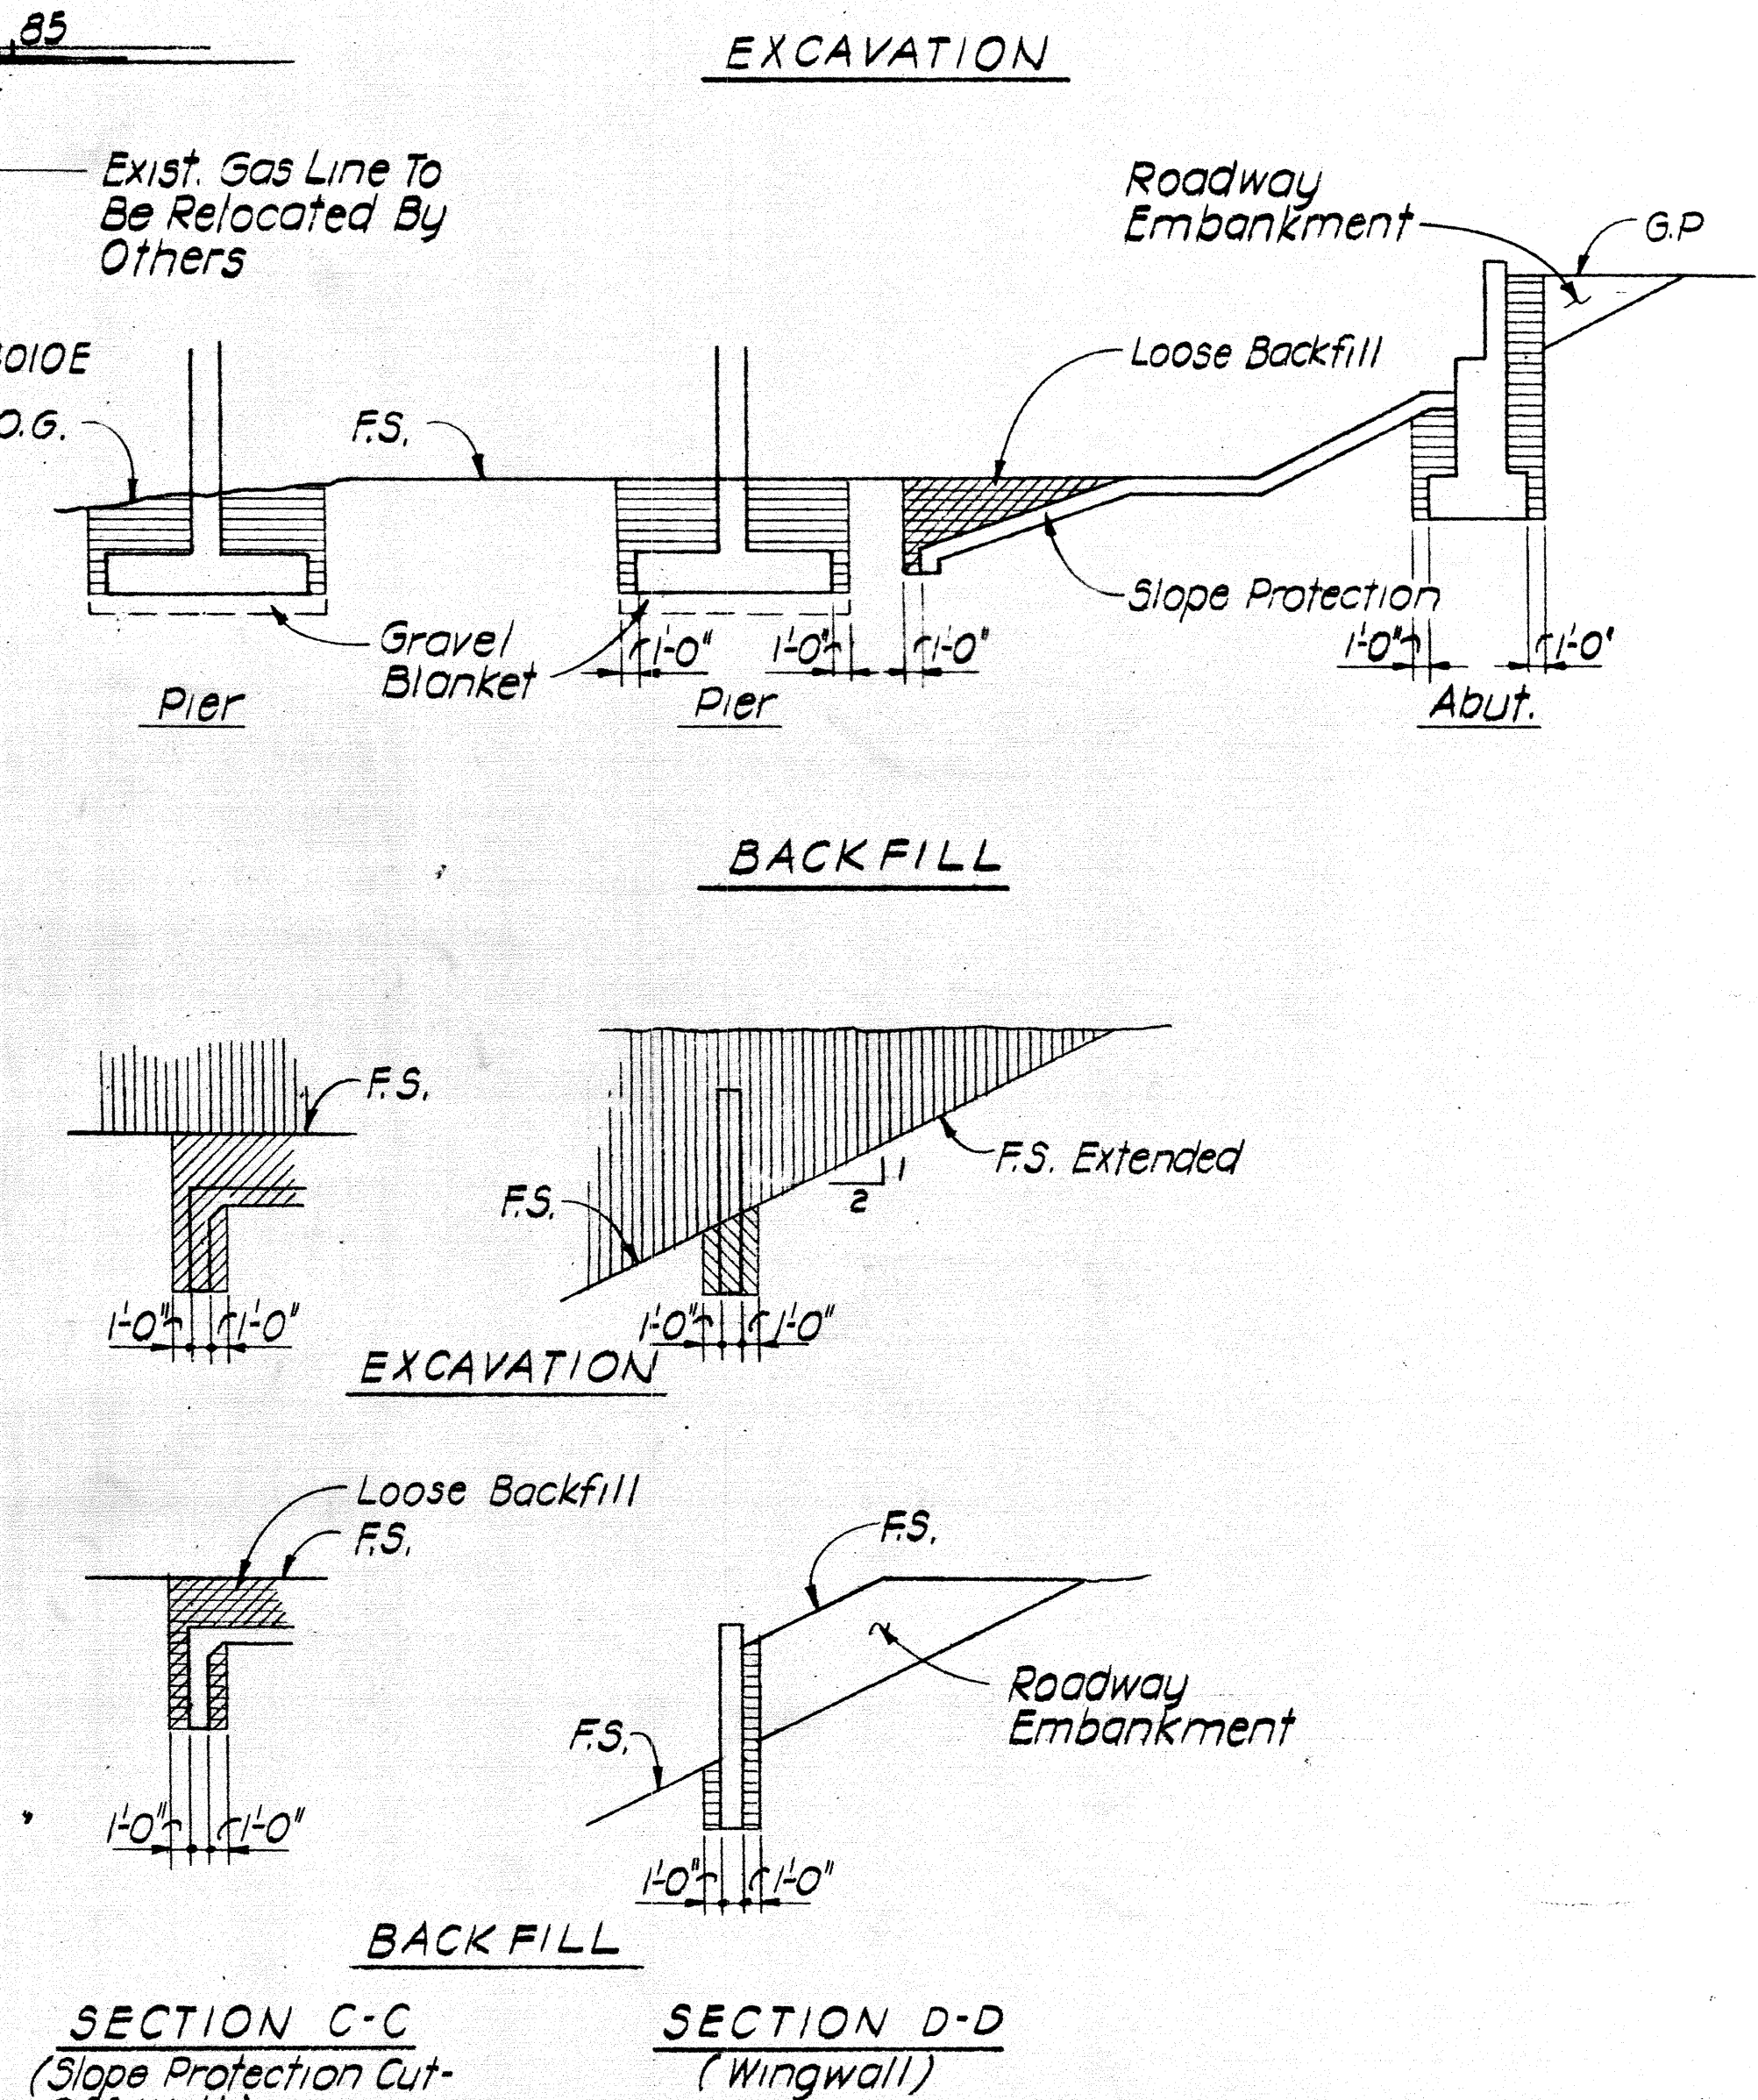
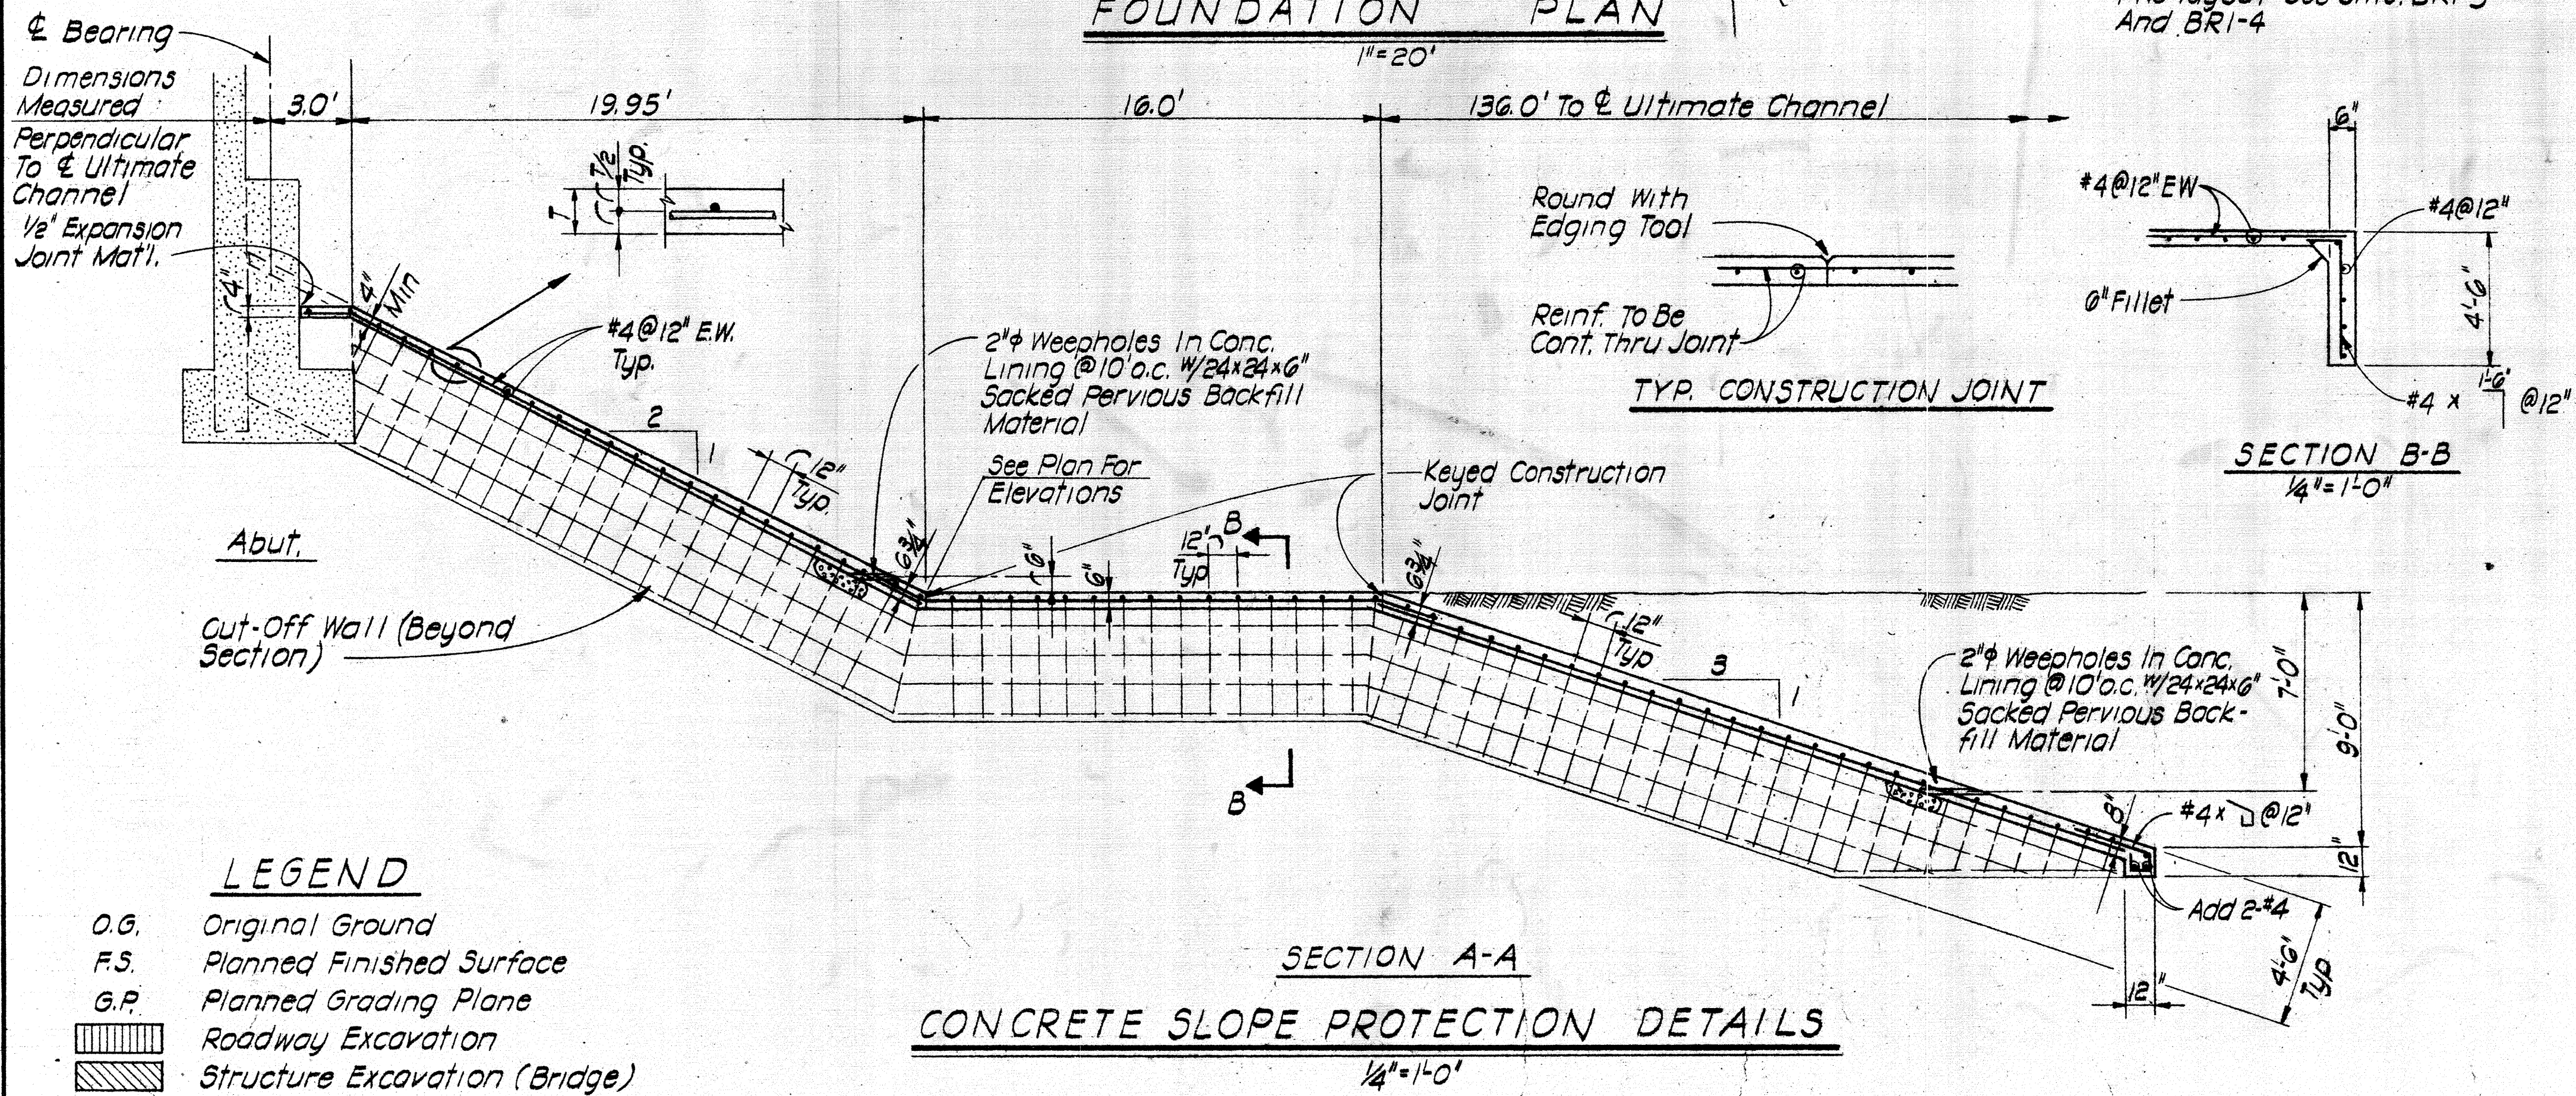


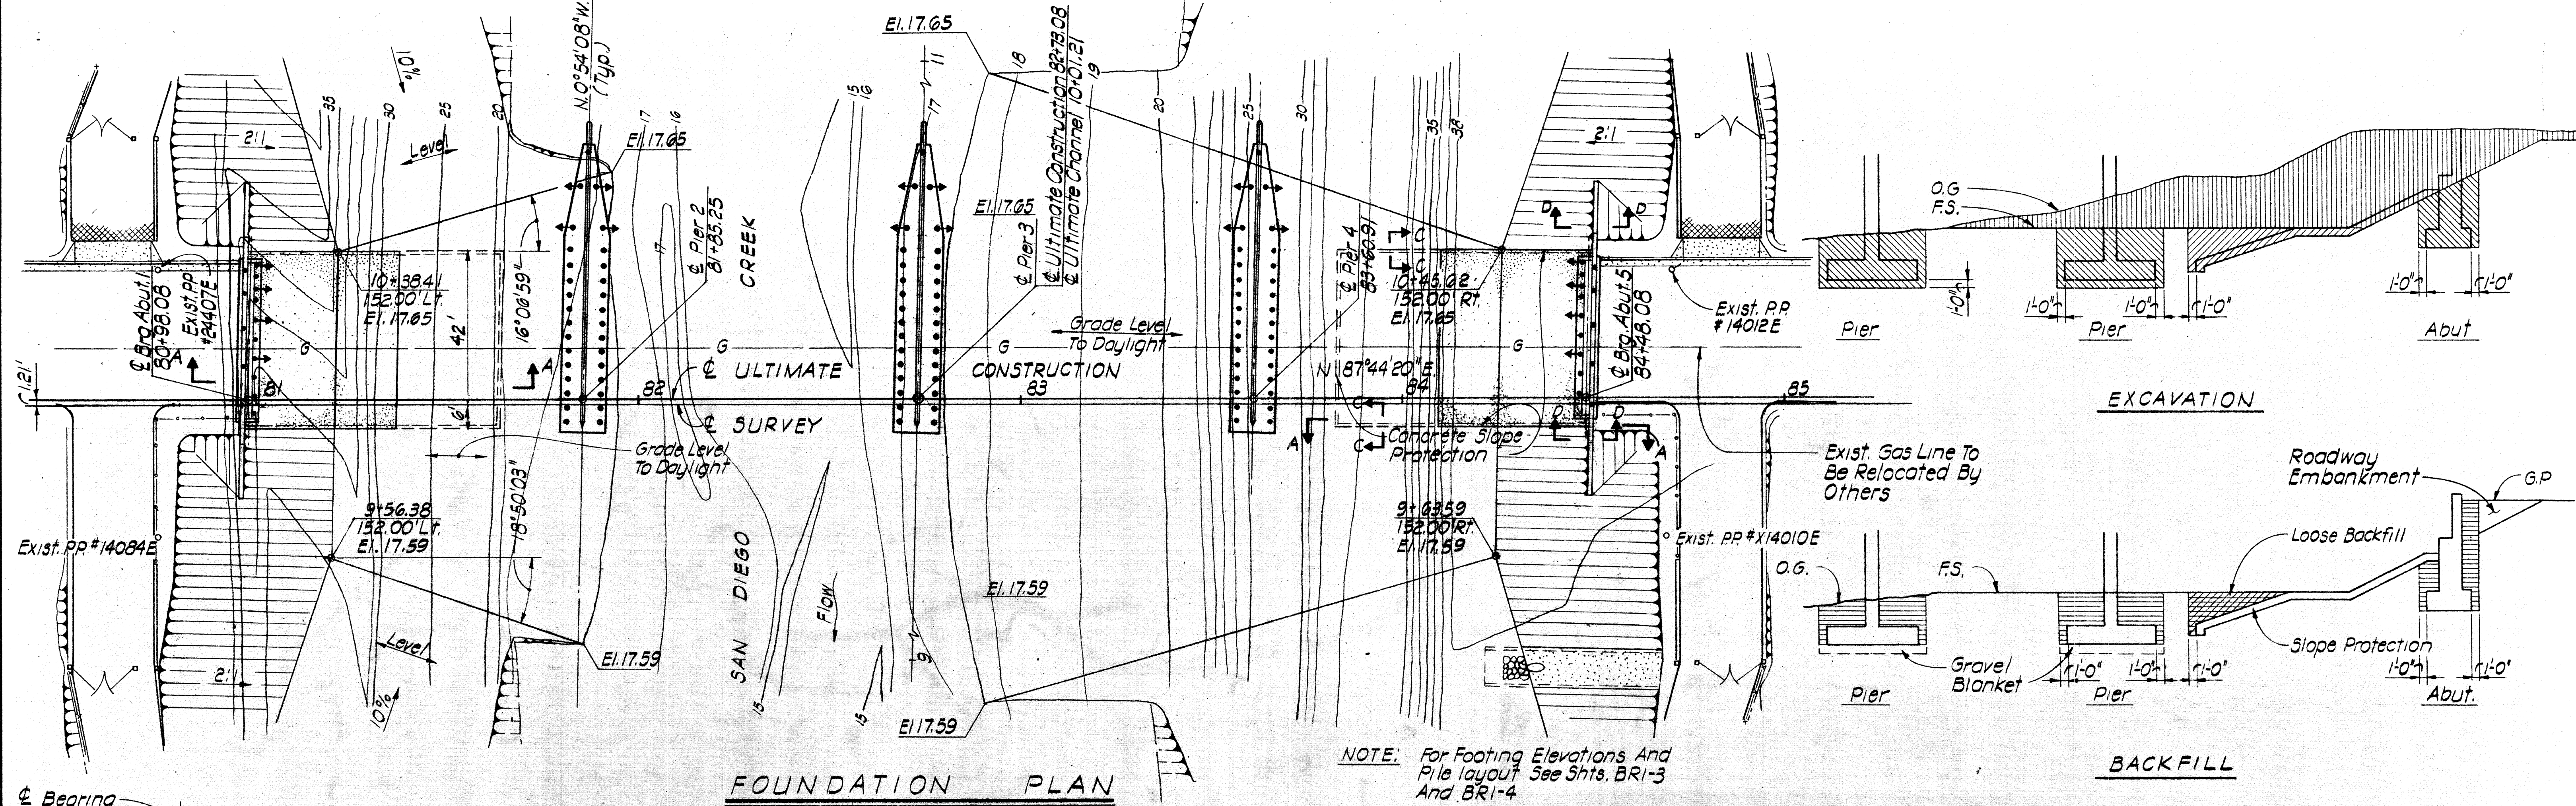

- LEGEND**
- O.G. Original Ground
 - F.S. Planned Finished Surface
 - G.P. Planned Grading Plane
 - Roadway Excavation
 - Structure Excavation (Bridge)
 - Structure Backfill (Bridge)
 - Structure Excavation (Slope Protection)
 - Structure Backfill (Slope Protection)
- This Quantity Shall Be Considered As Compensated For In Pay Item For Structure Excavation (Slope Protection).